
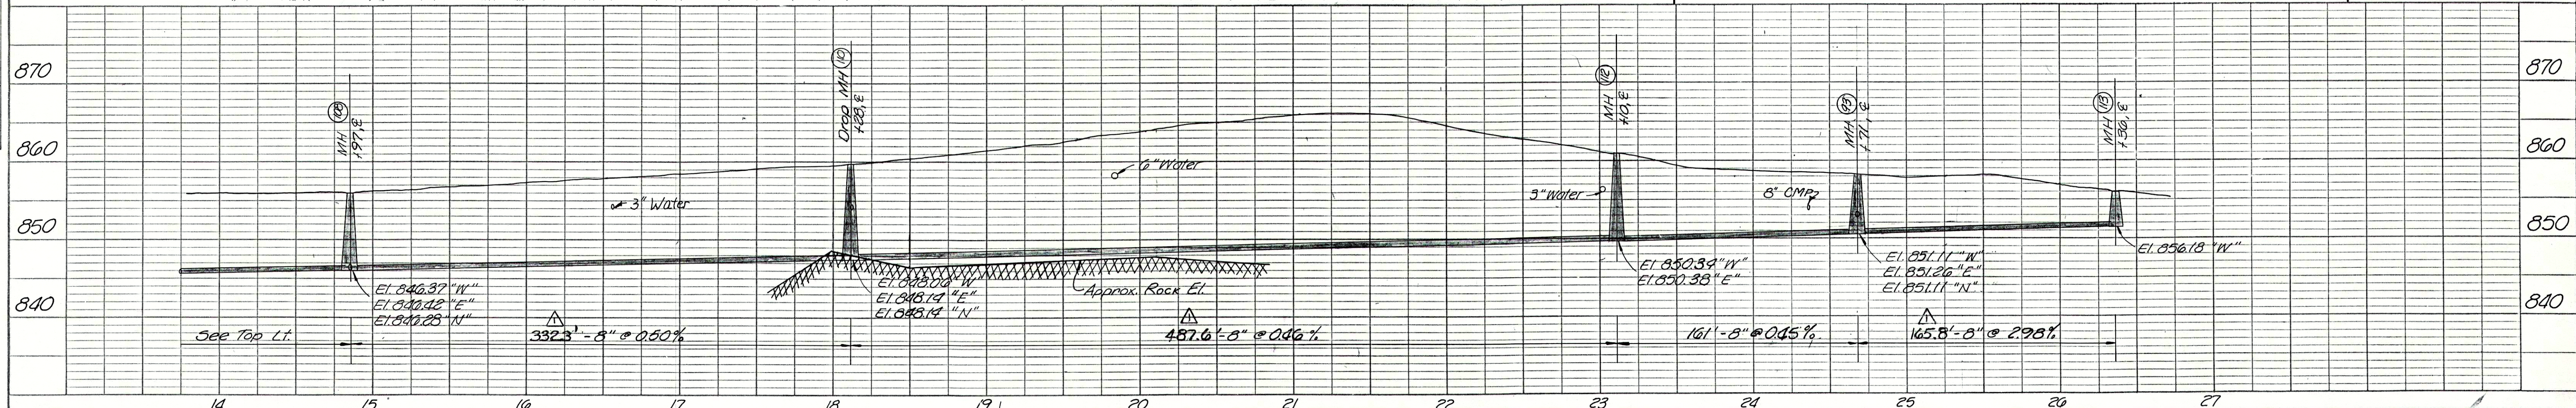
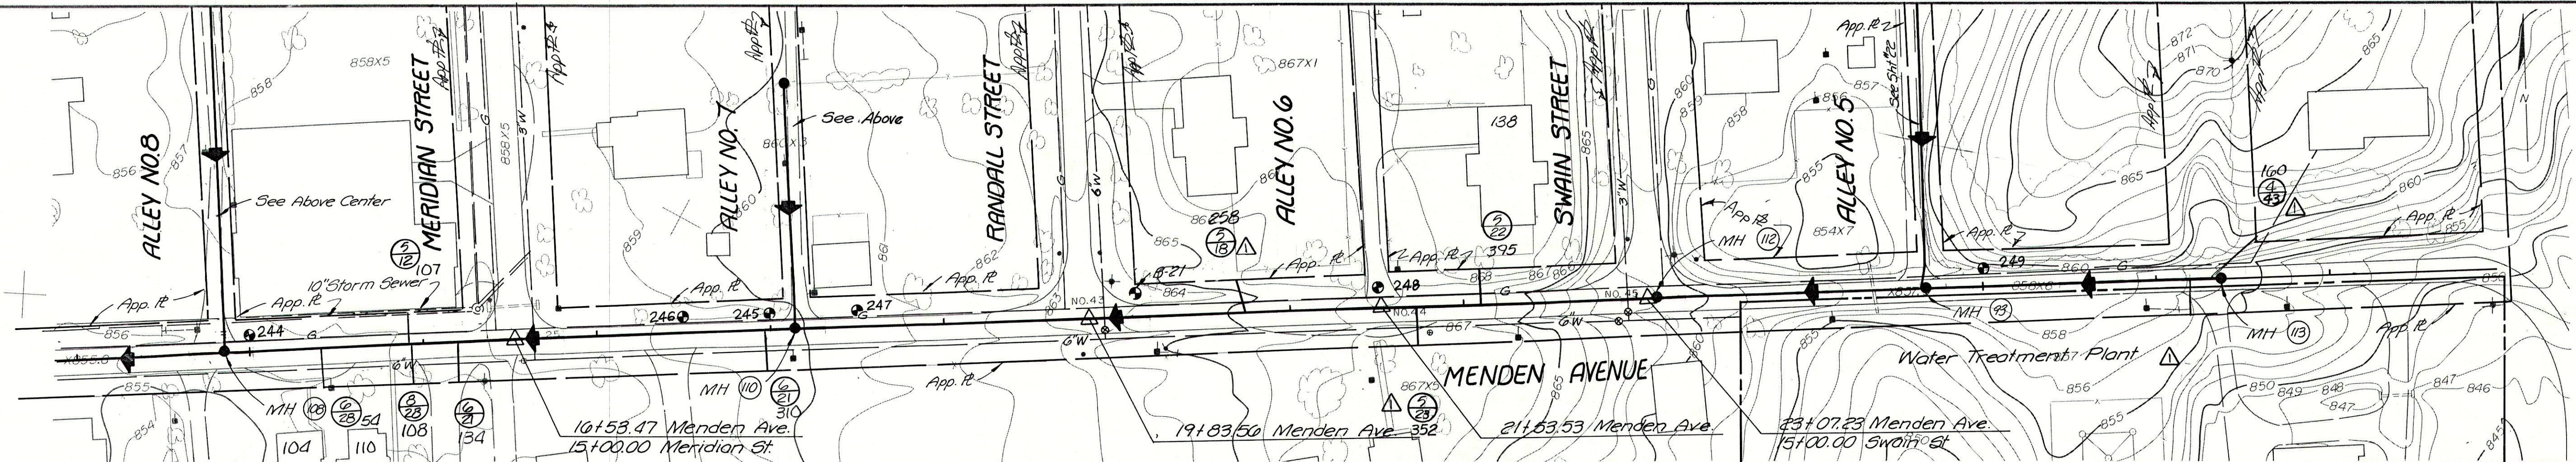
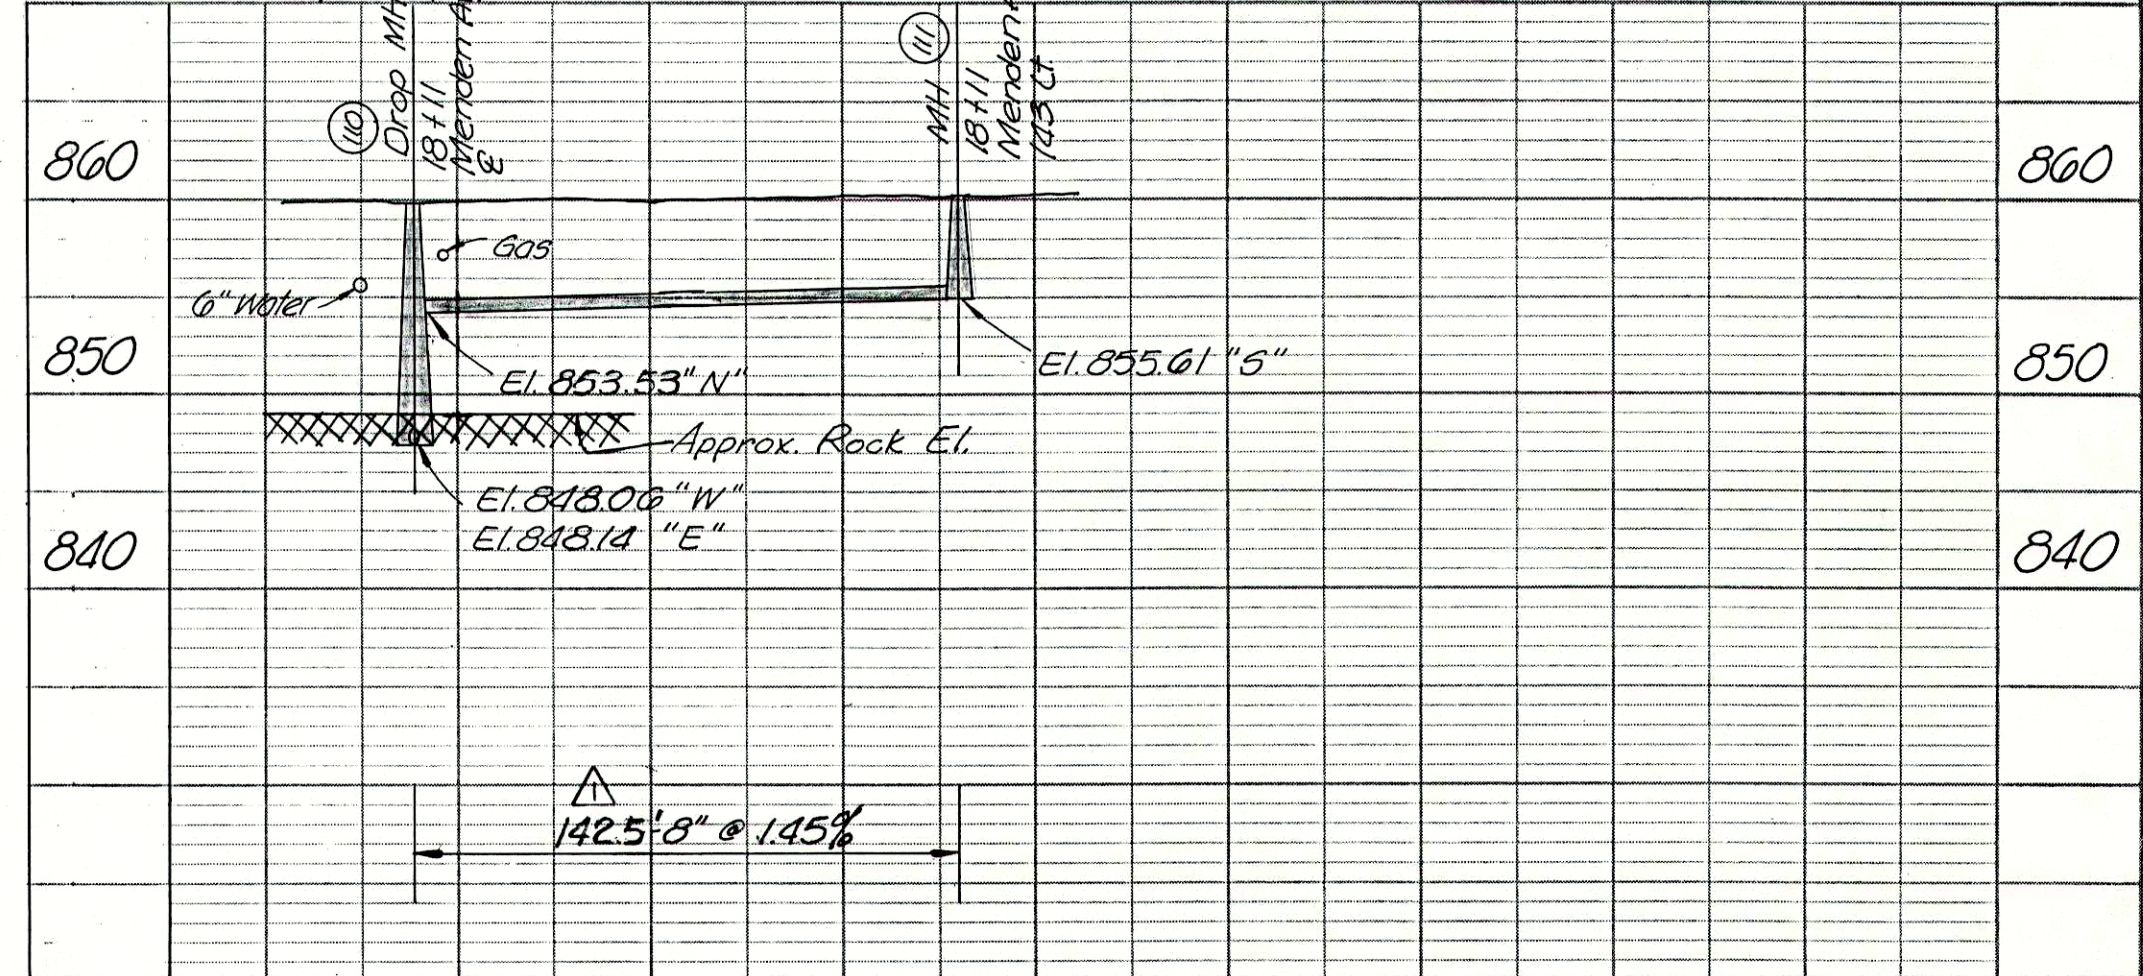
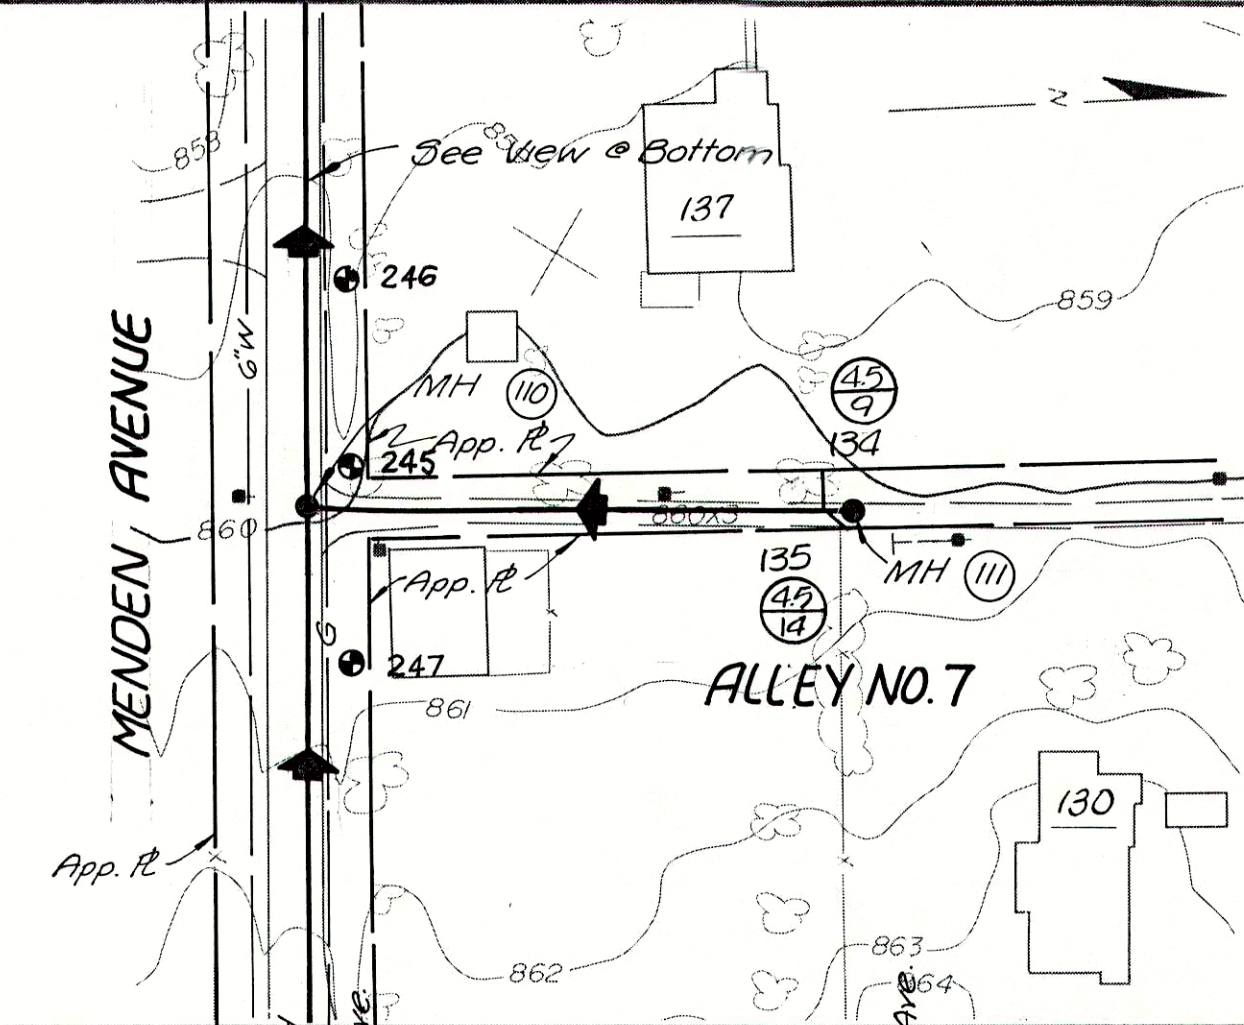
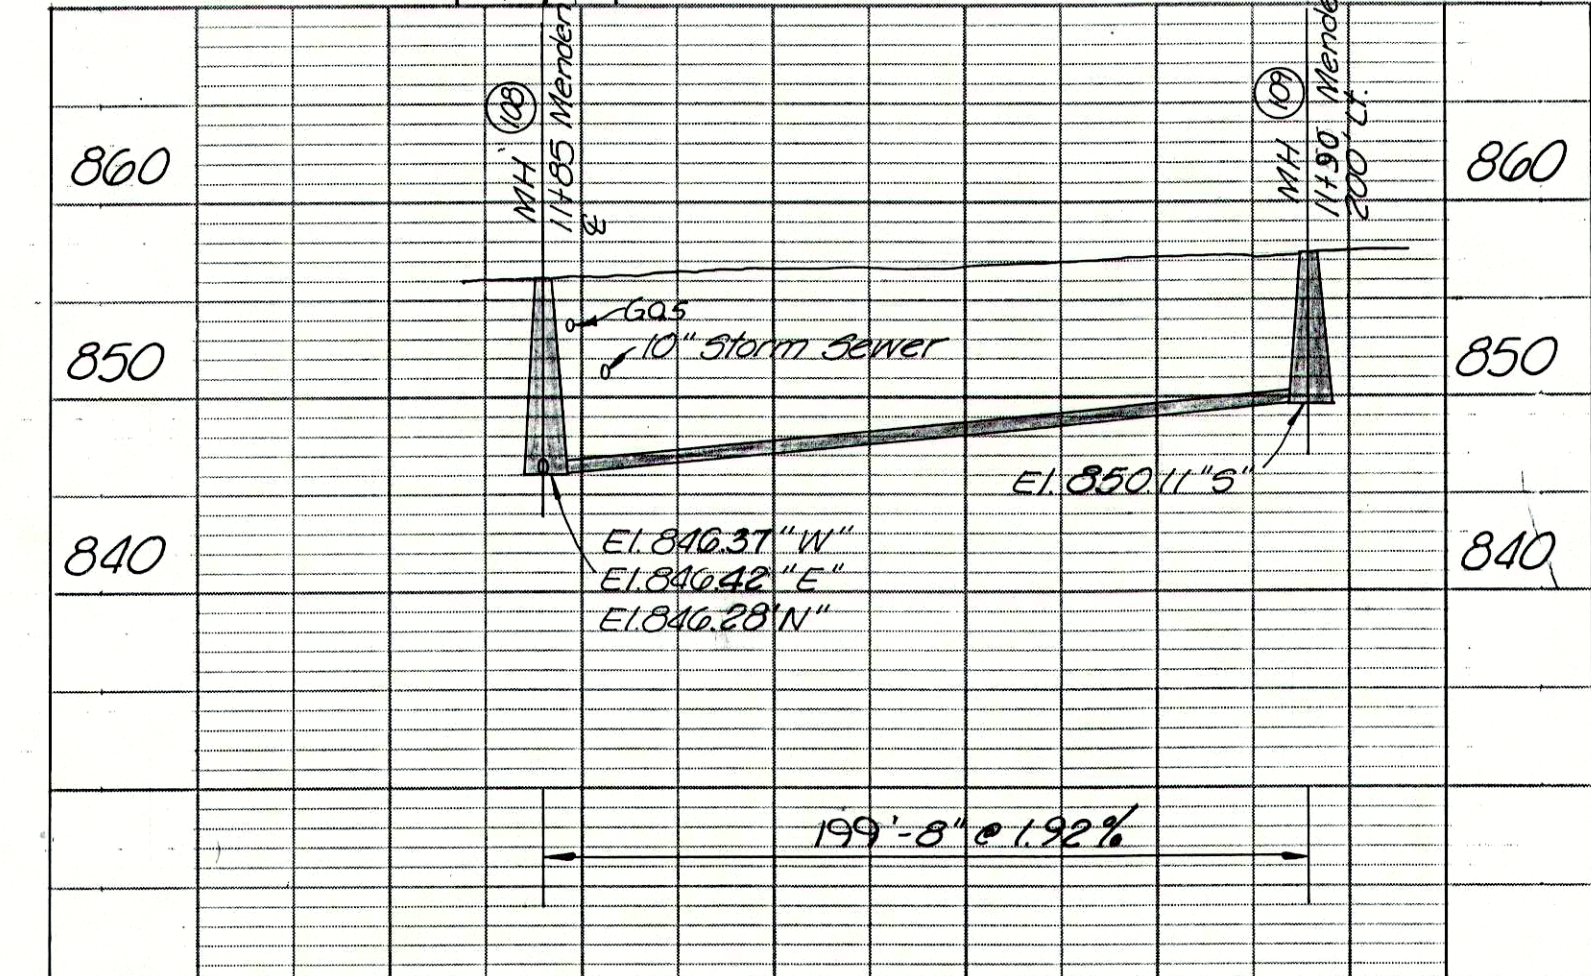
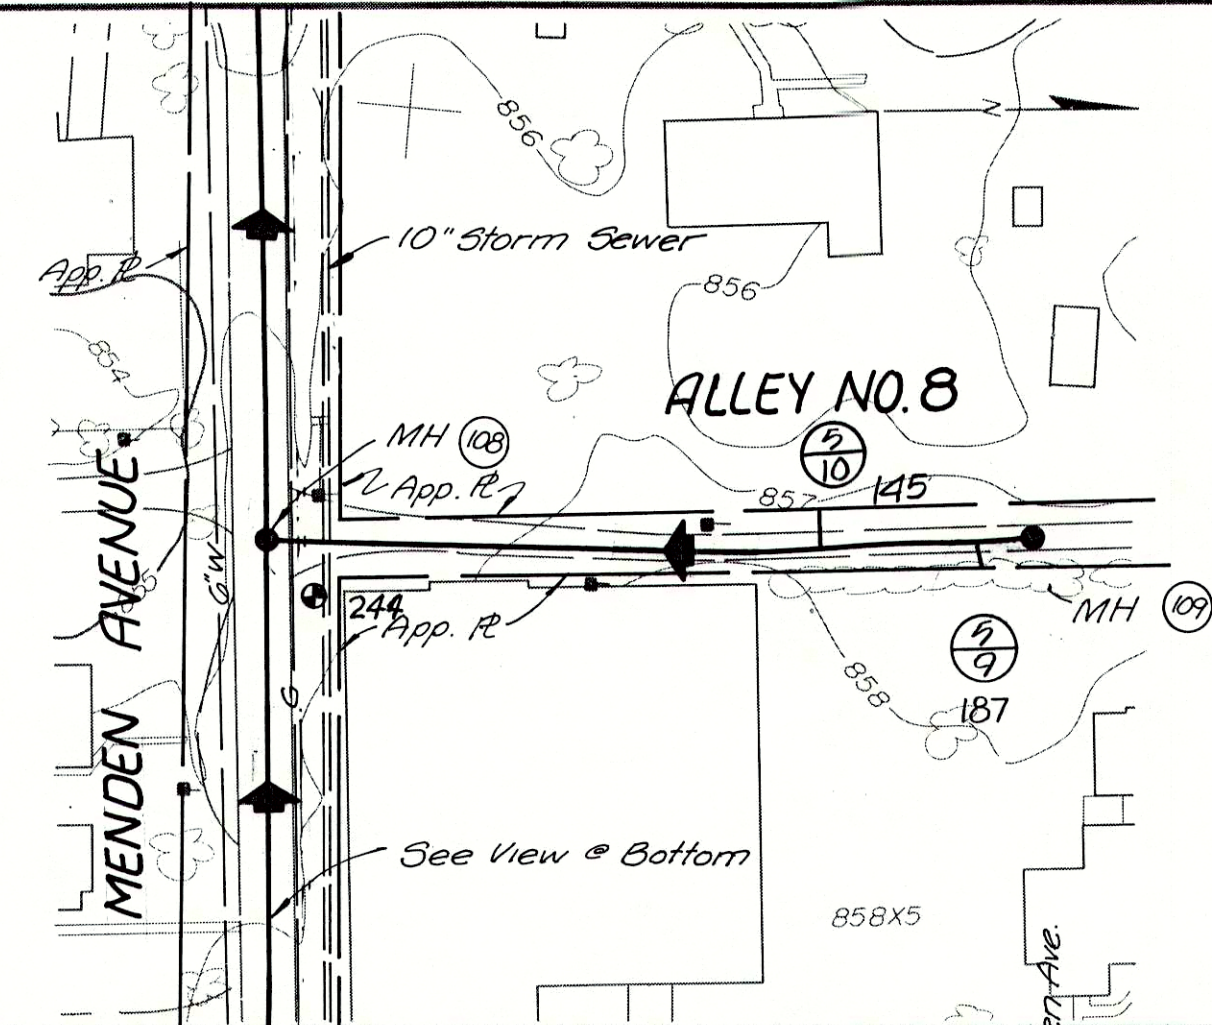
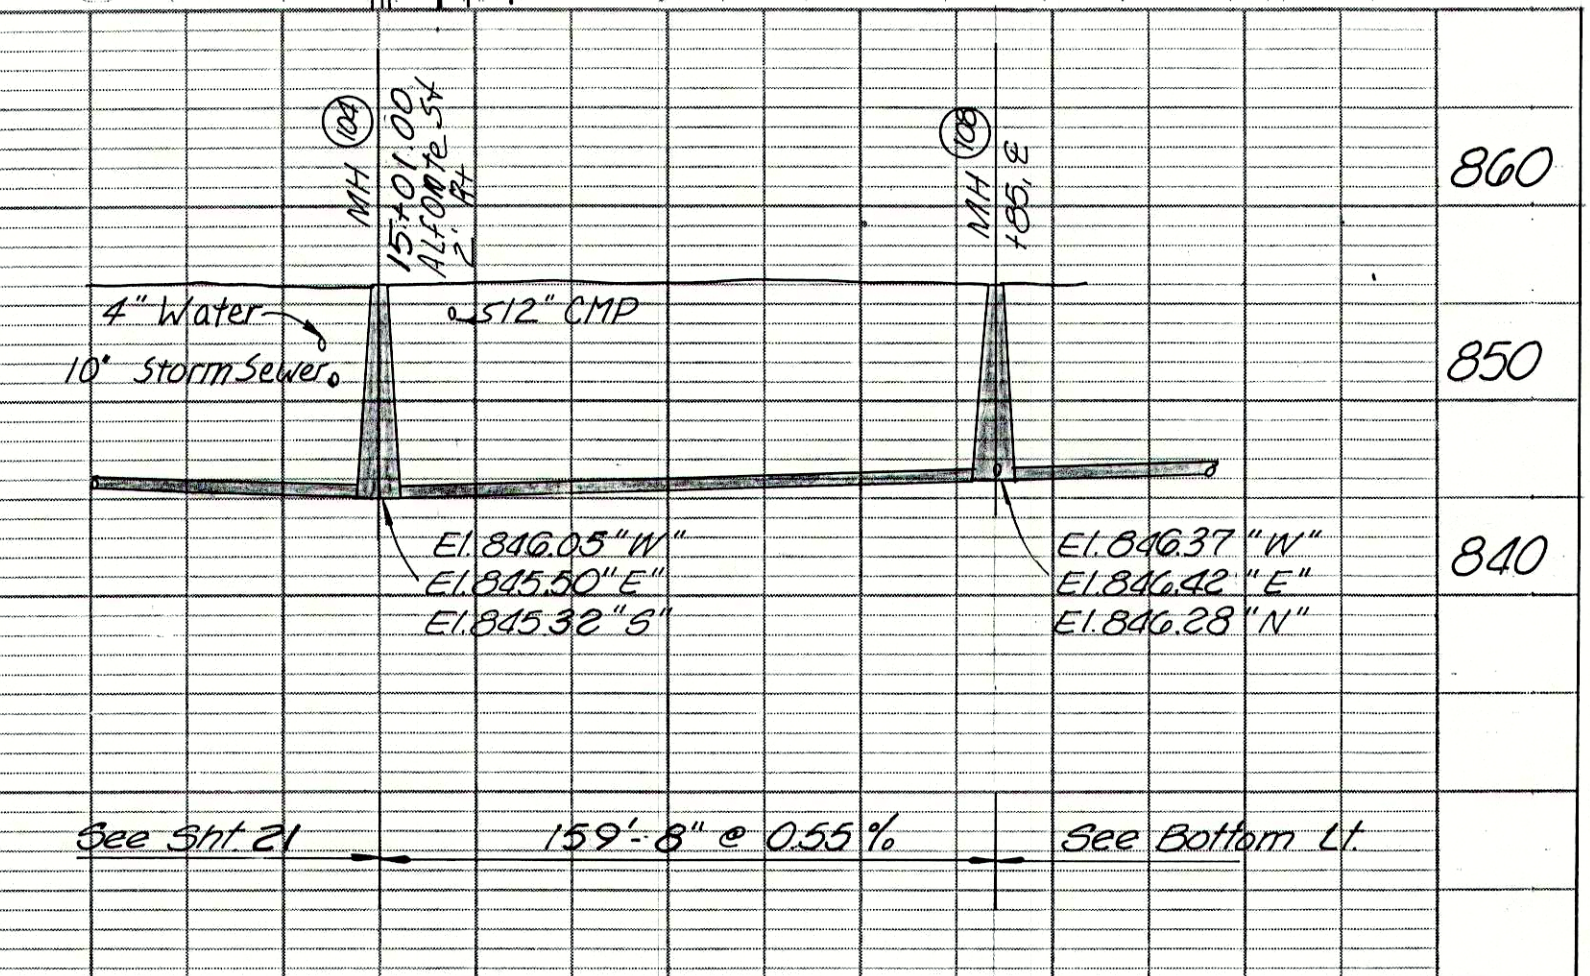


1-15

PLAN	SURVEYED	DATE
NOTE BOOK	ALIGNED	BY
NO.	RT. OF WAY CHECKED	

PROFILE	SURVEYED	DATE
NOTE BOOK	GRADES CHECKED	BY
NO.	STRUCTURE NOTATIONS CHECKED	

13+23.48 Menden Ave.
15+00.00 ALFONTE ST.

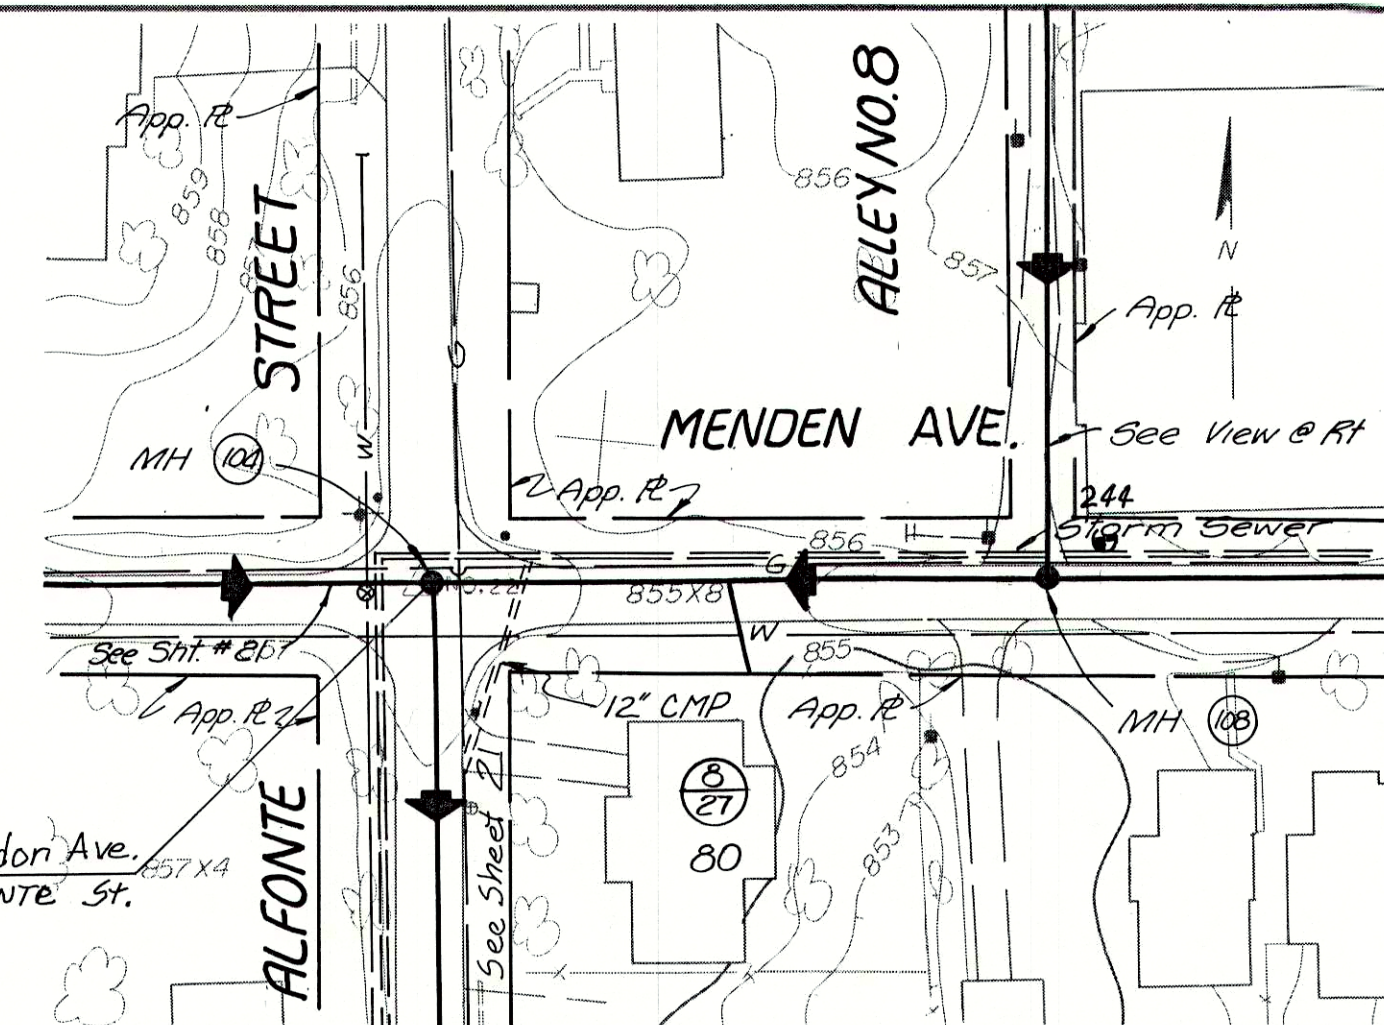

RECORD DRAWING

REVISED 4-17-86



ALLEY #7 & 8		MENDEN AVE.	
FALL CREEK R.W.D. PLAN & PROFILE		SHEET	
HORIZ. 1"=50'		VERT. 1"=10'	
BEAM, LONGEST & NEFF, INC.		CONSULTING ENGINEERS	
INDIANAPOLIS, INDIANA		23	