

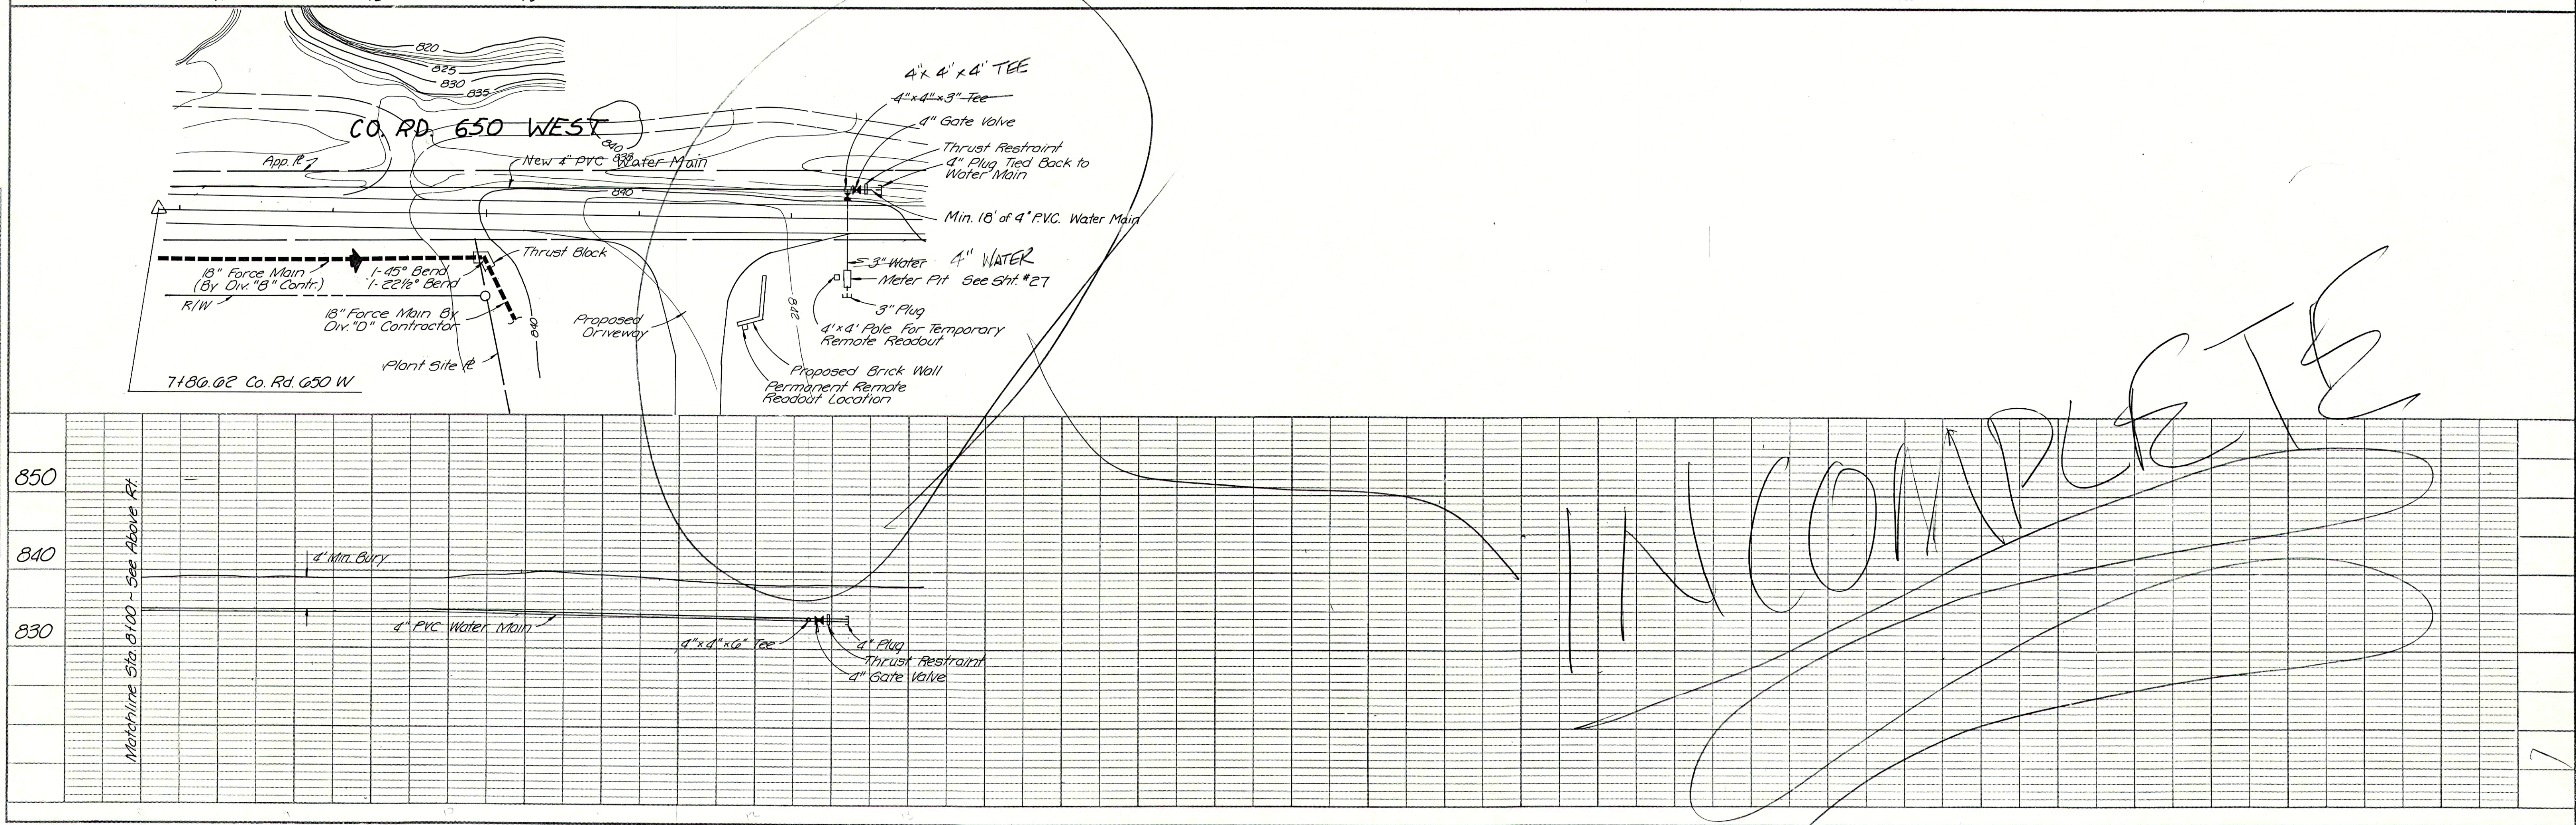


PLAN	DATE	BY
	REVISION	BY
	NO.	BY
	NO.	BY

PROFILE	DATE	BY
	REVISION	BY
	NO.	BY
	NO.	BY

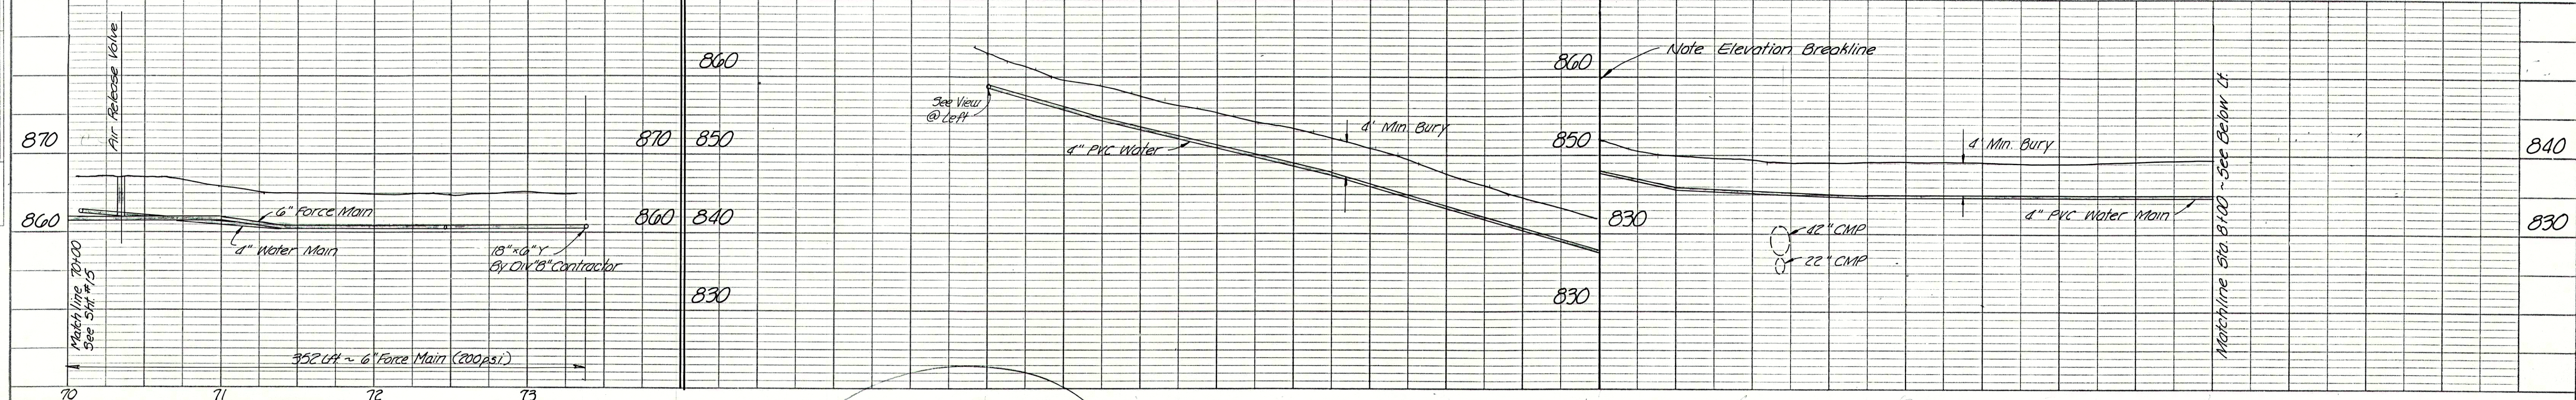

RECORD DRAWING

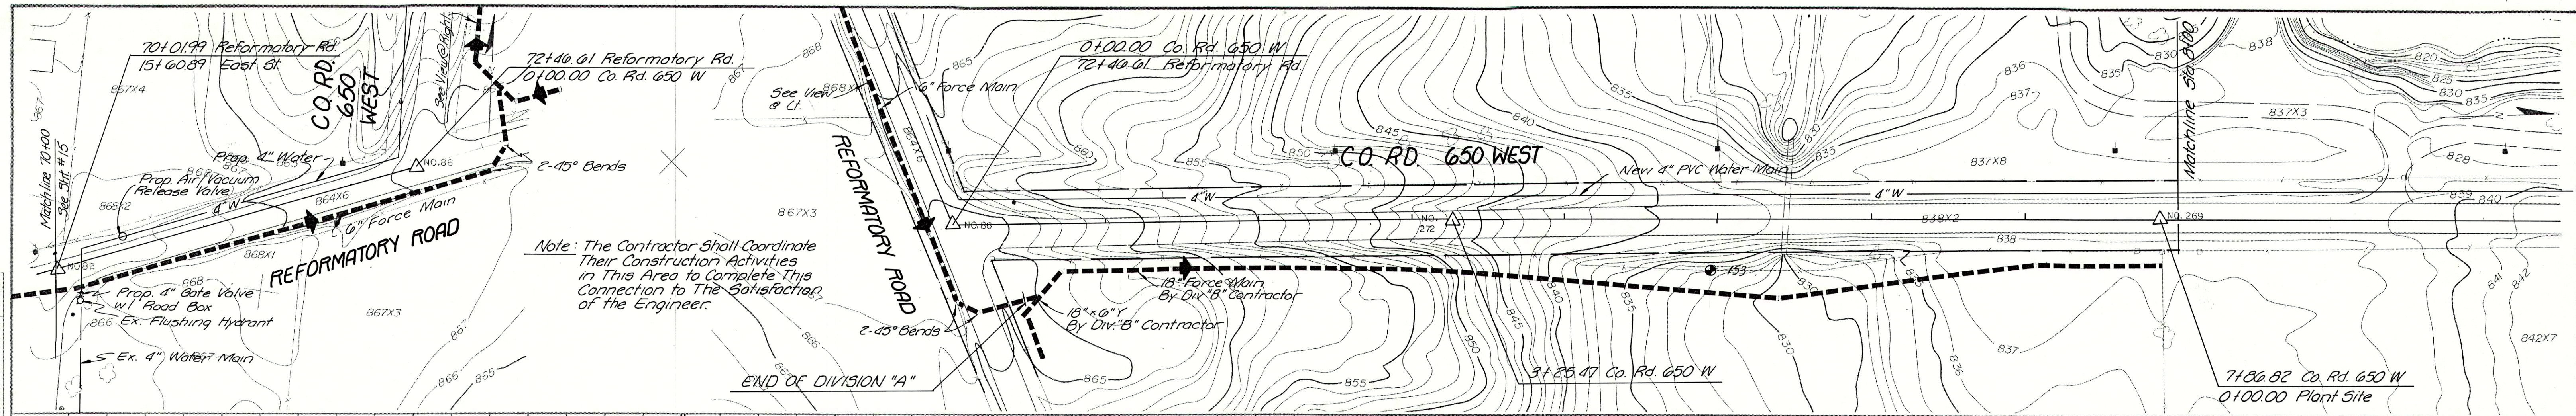

REFORMATORY RD/Co. Rd 650 W	
FALL CREEK R.W.D. PLAN & PROFILE SHEET	
HORIZ. 1"=50'	BEAM, LONGEST & NEFF, INC.
VERT. 1"=10'	CONSULTING ENGINEERS
	INDIANAPOLIS, INDIANA
	25