




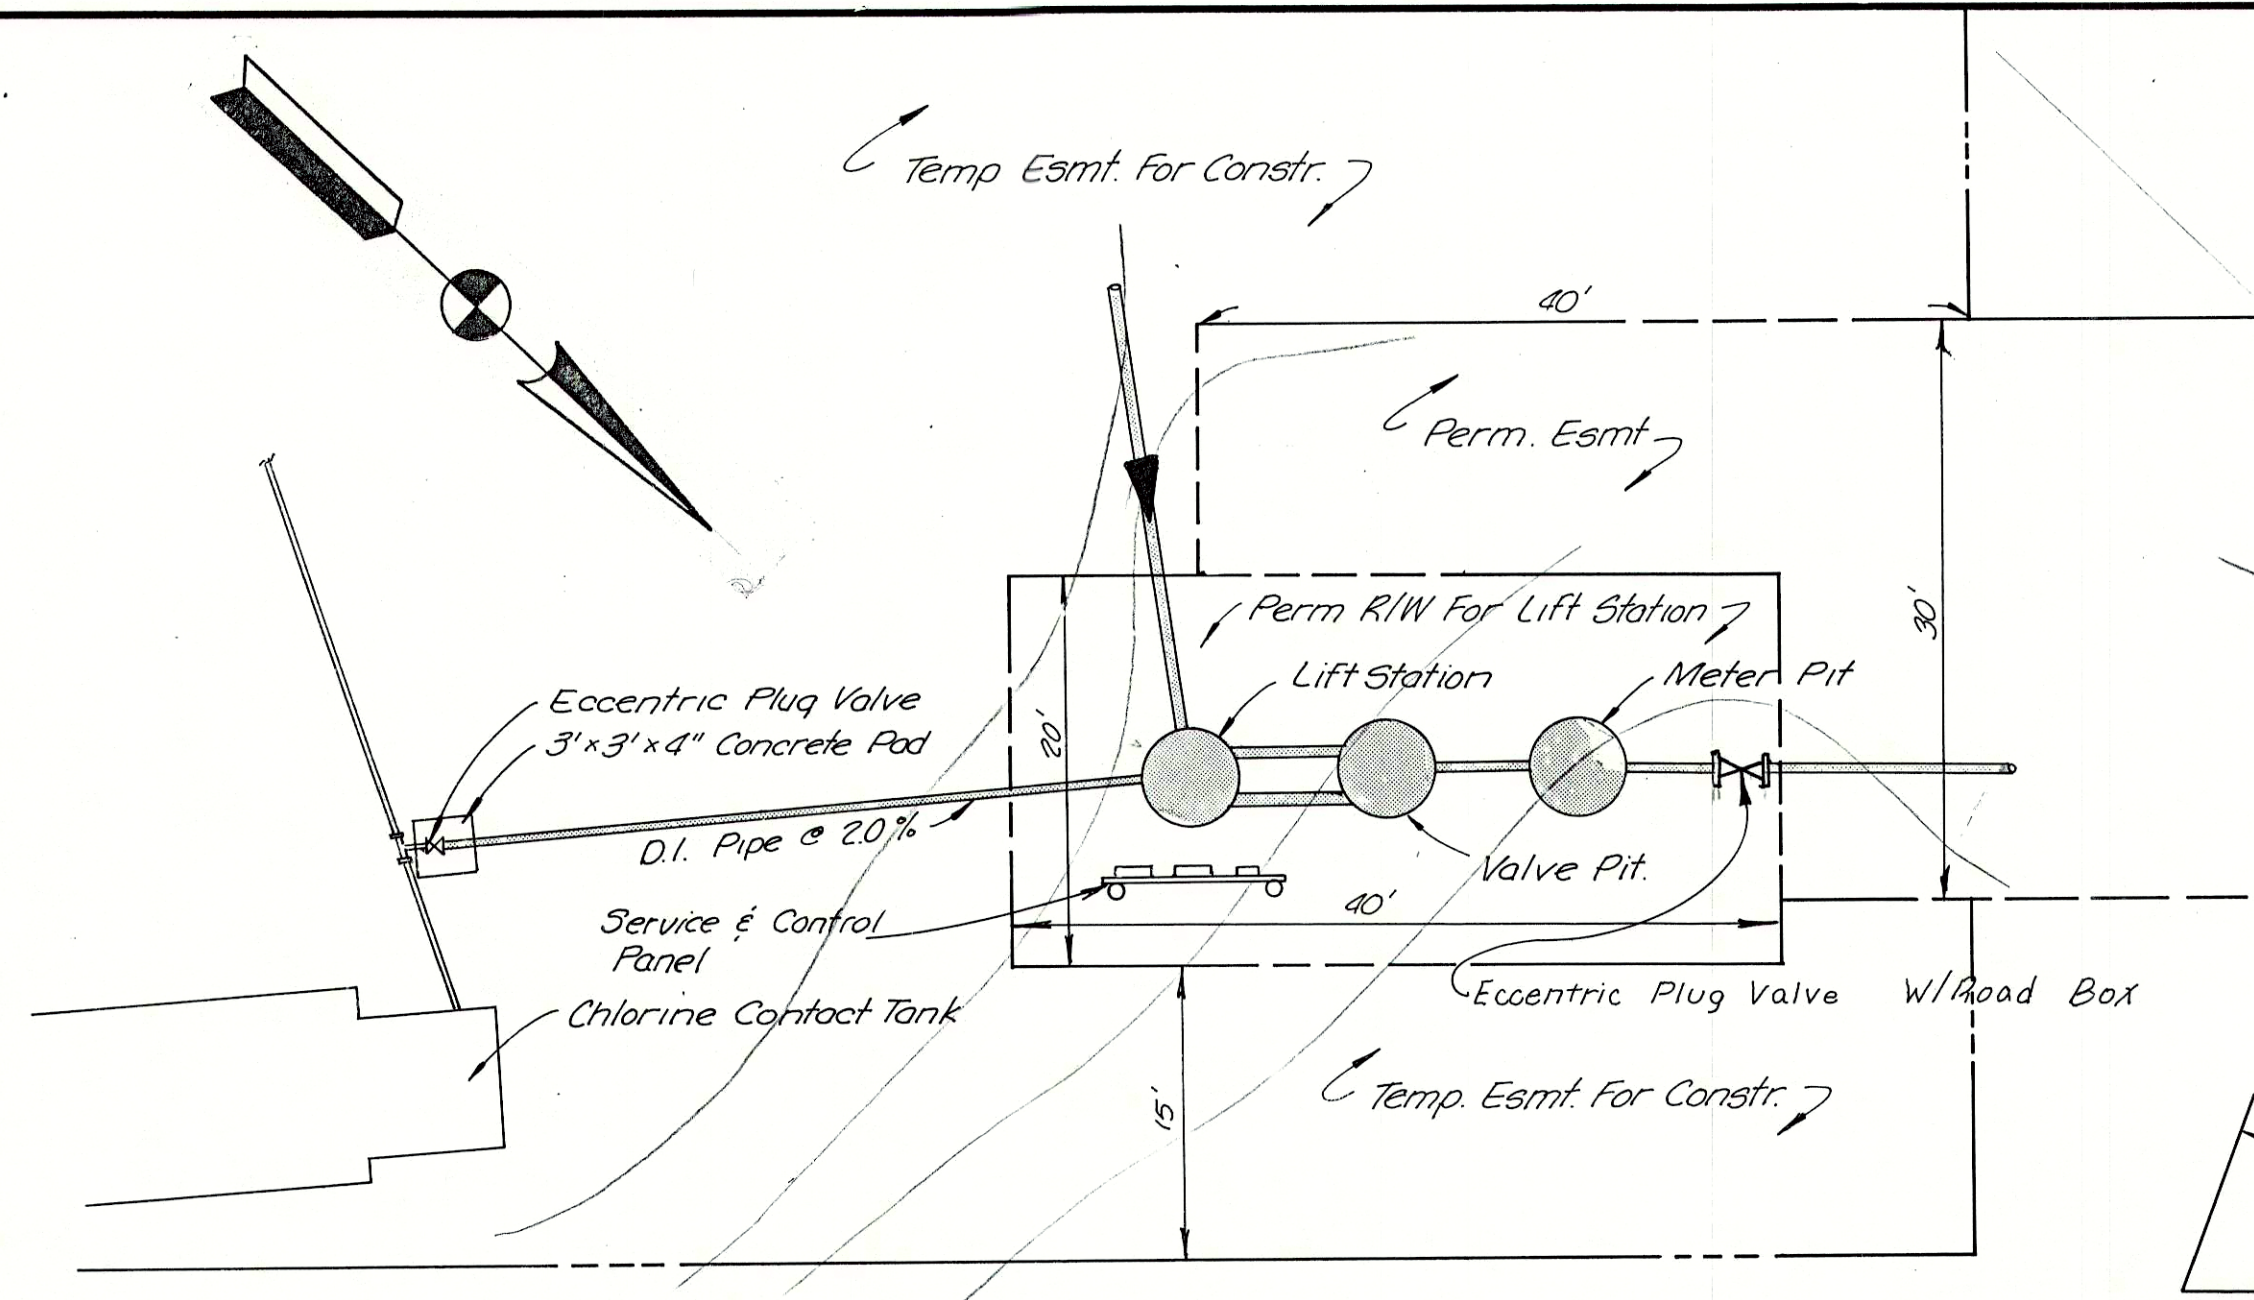


PENTECOSTAL CAMP LIFT STATION
Scale 1"=10'

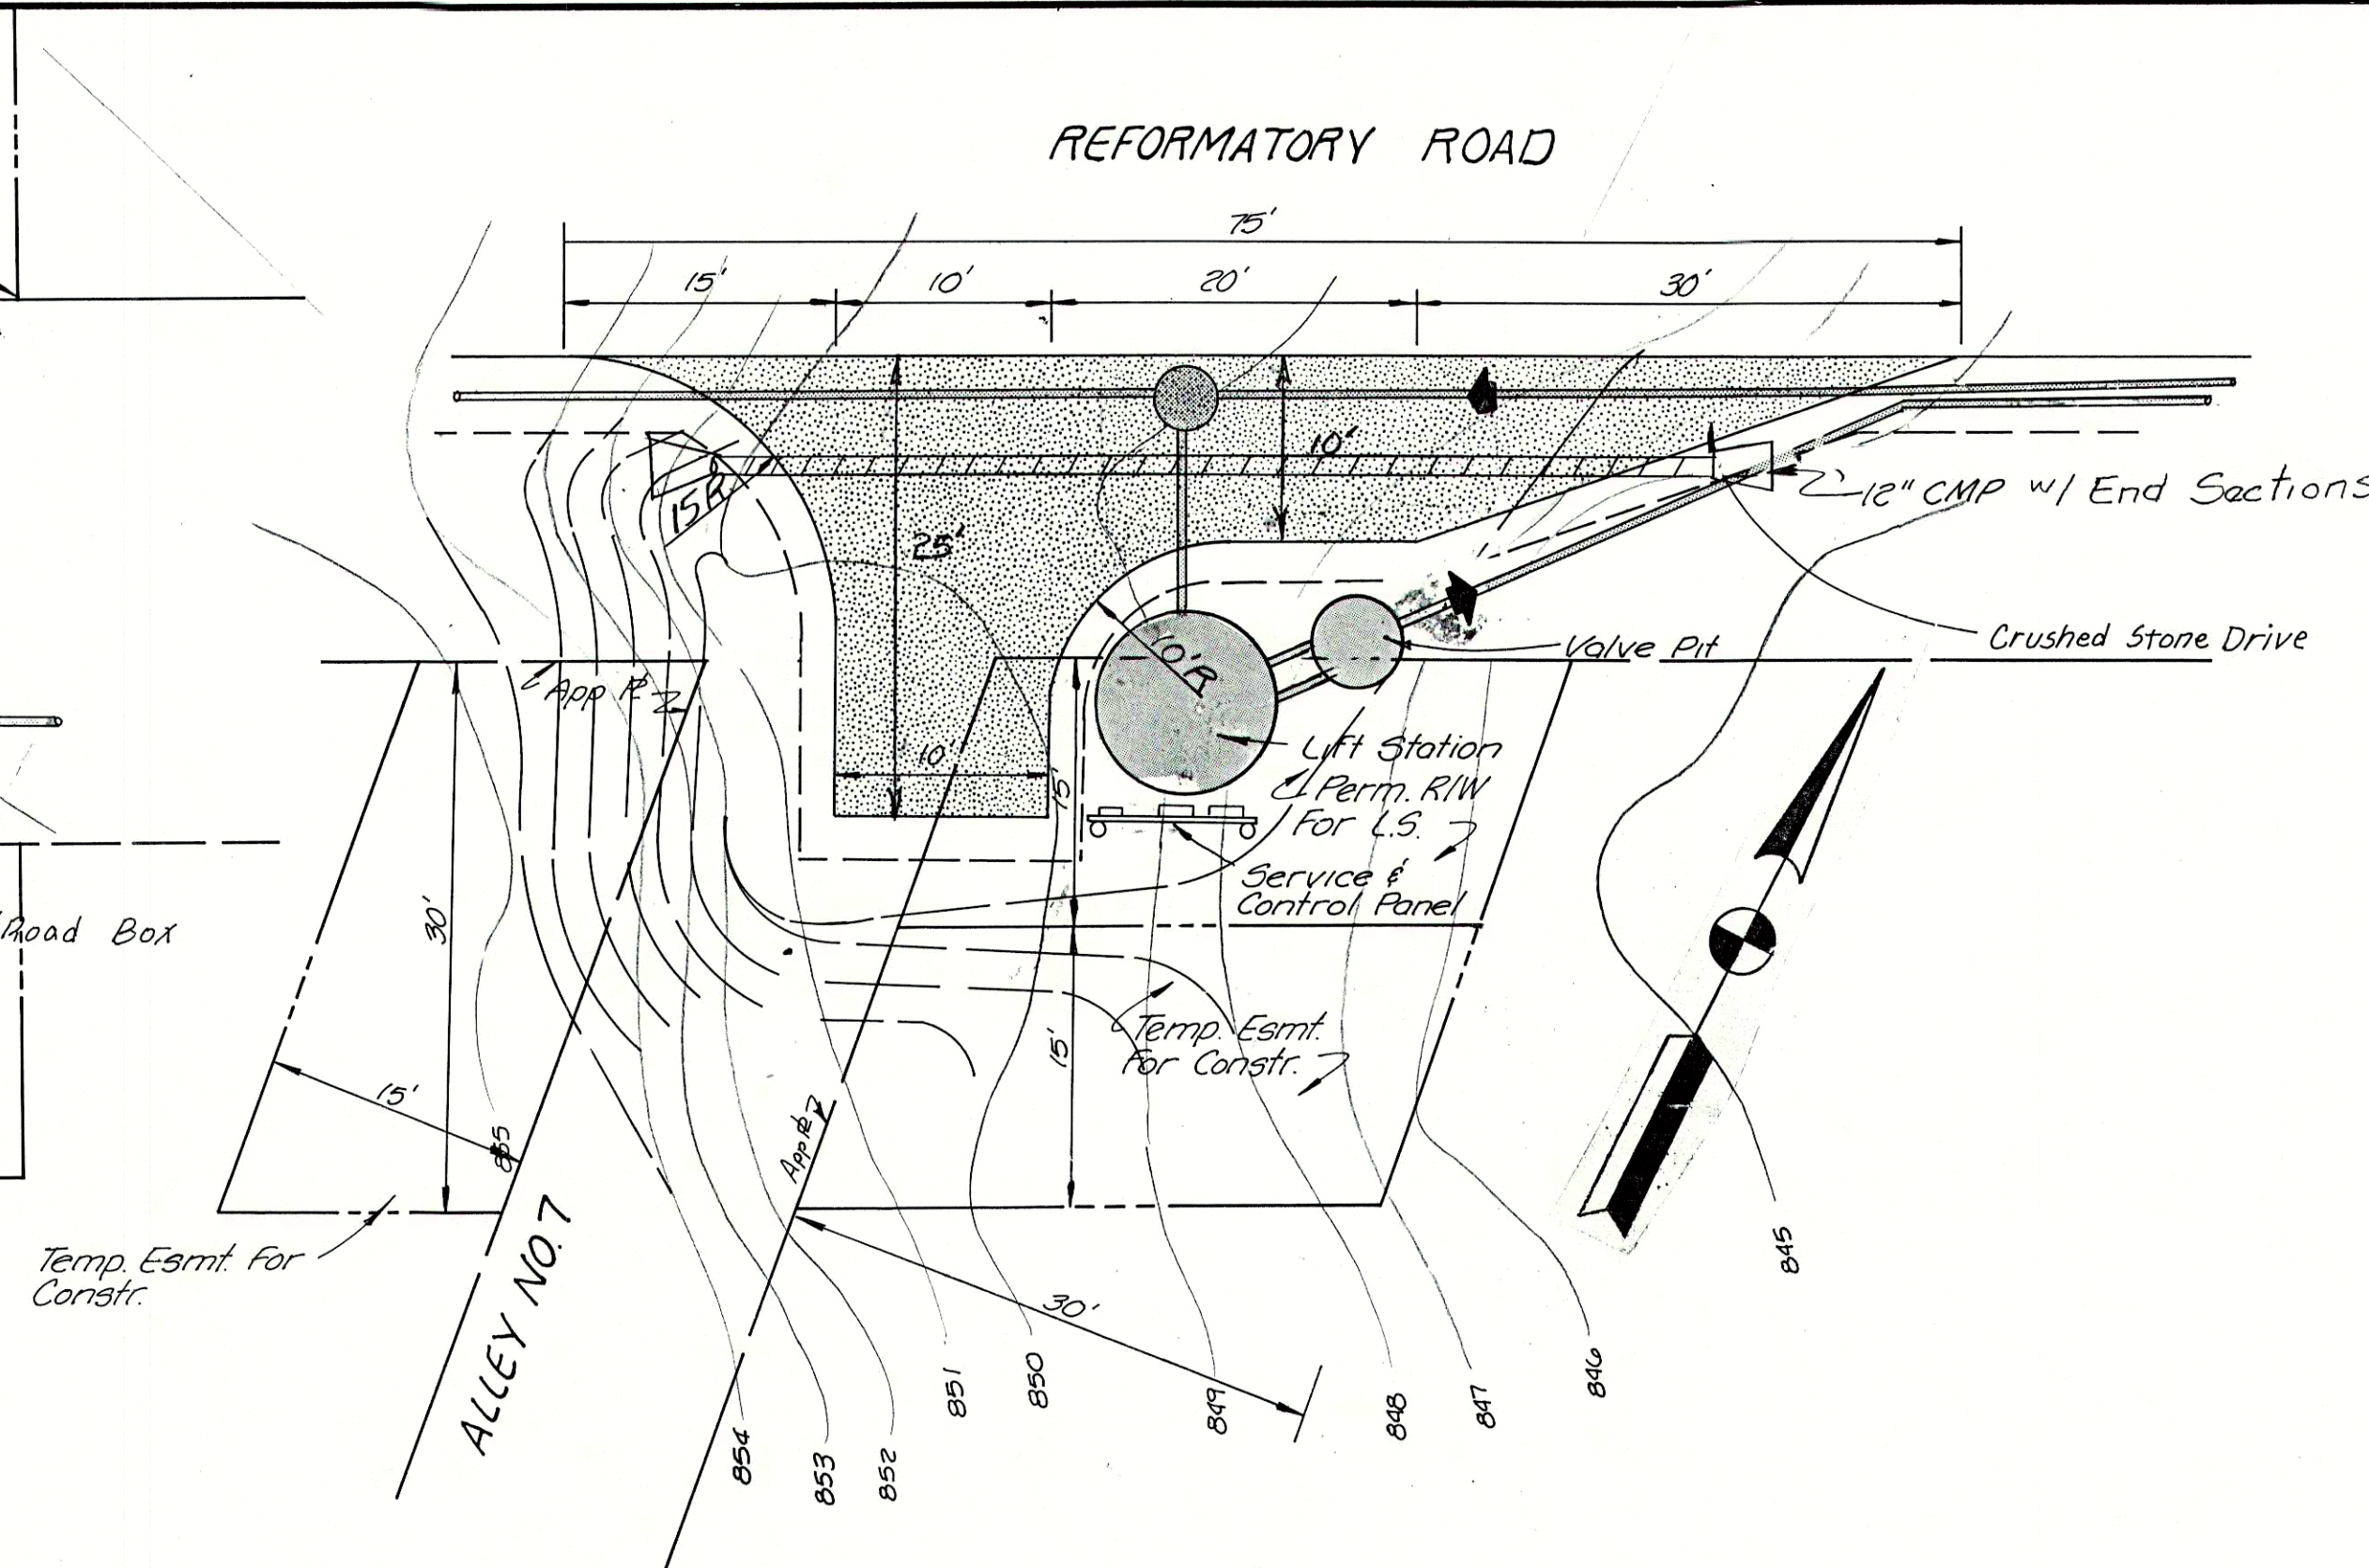

MAIN LIFT STATION
Scale 1"=10'

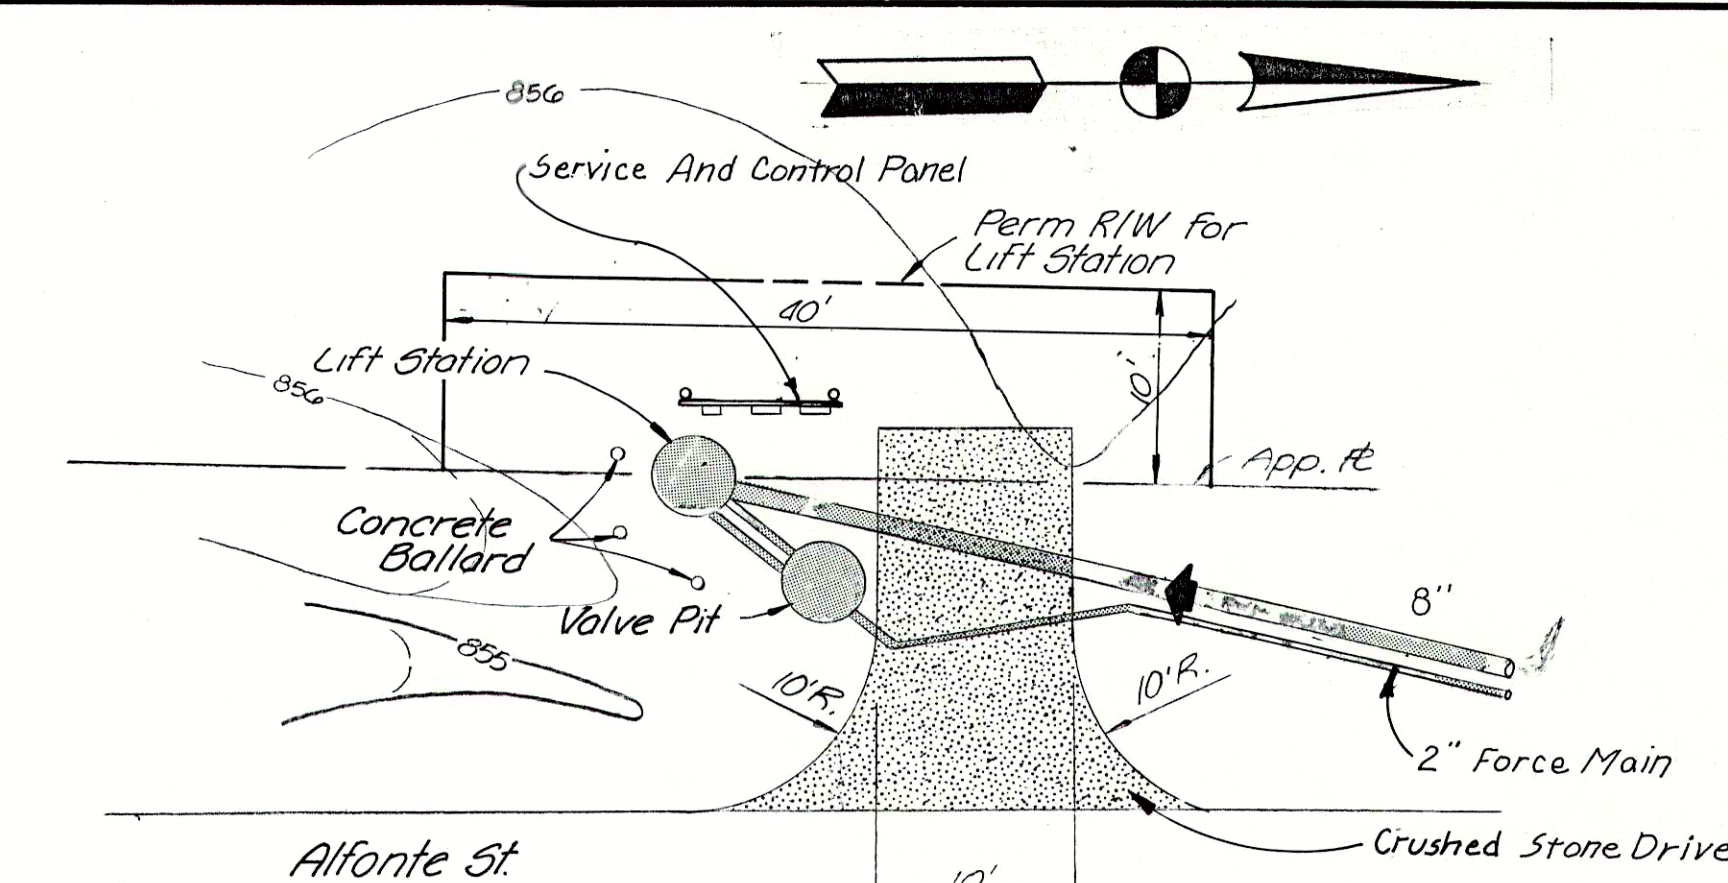



SOUTH LIFT STATION
Scale 1"=10'

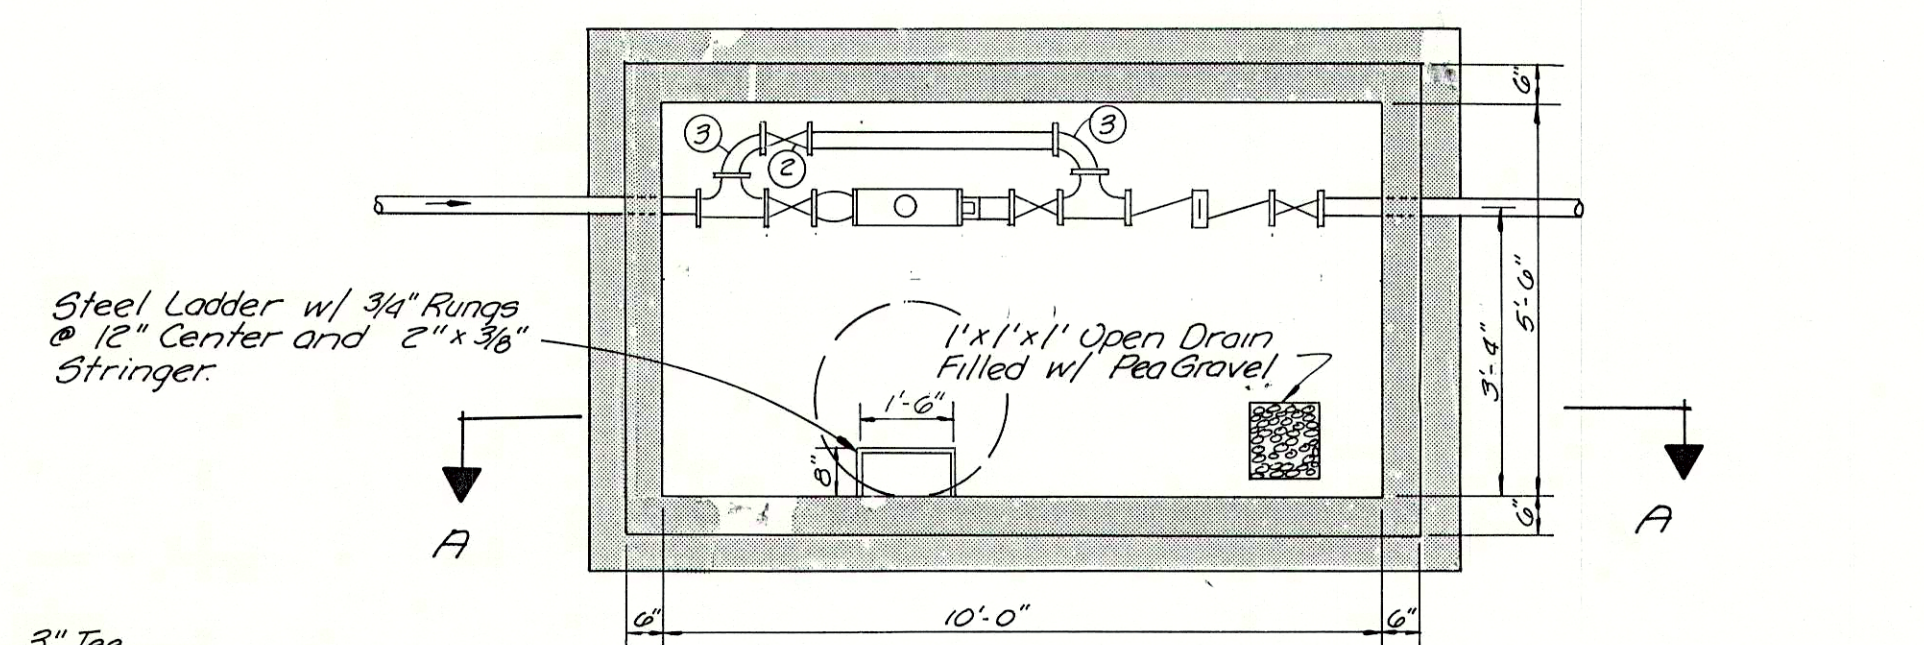


SECTION A-A

WATER METER PIT
Scale 3/8"=1'-0"


- 1 3" Tee
- 2 3" Gate Valve
- 3 3" 90° Bend
- 4 3" Compound Meter
- 5 3" Strainer
- 6 Coupling Adapters
- 7 3" Reduced Pressure Backflow Preventer

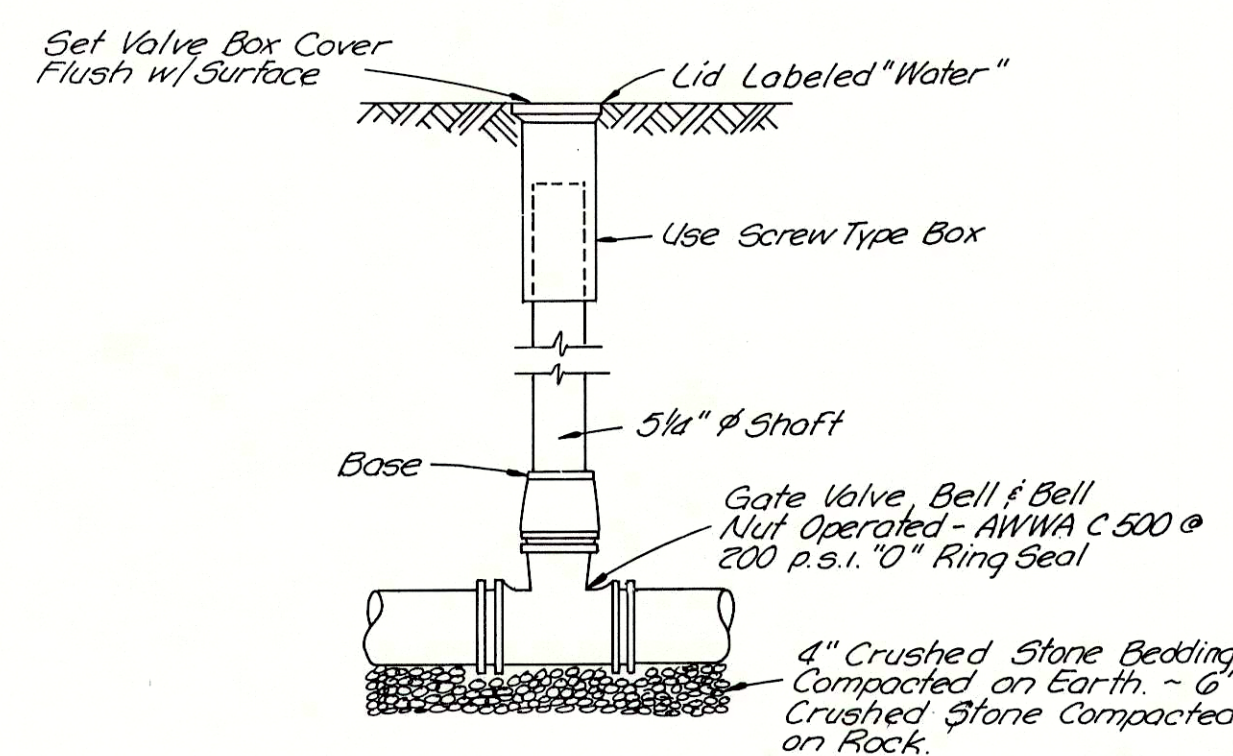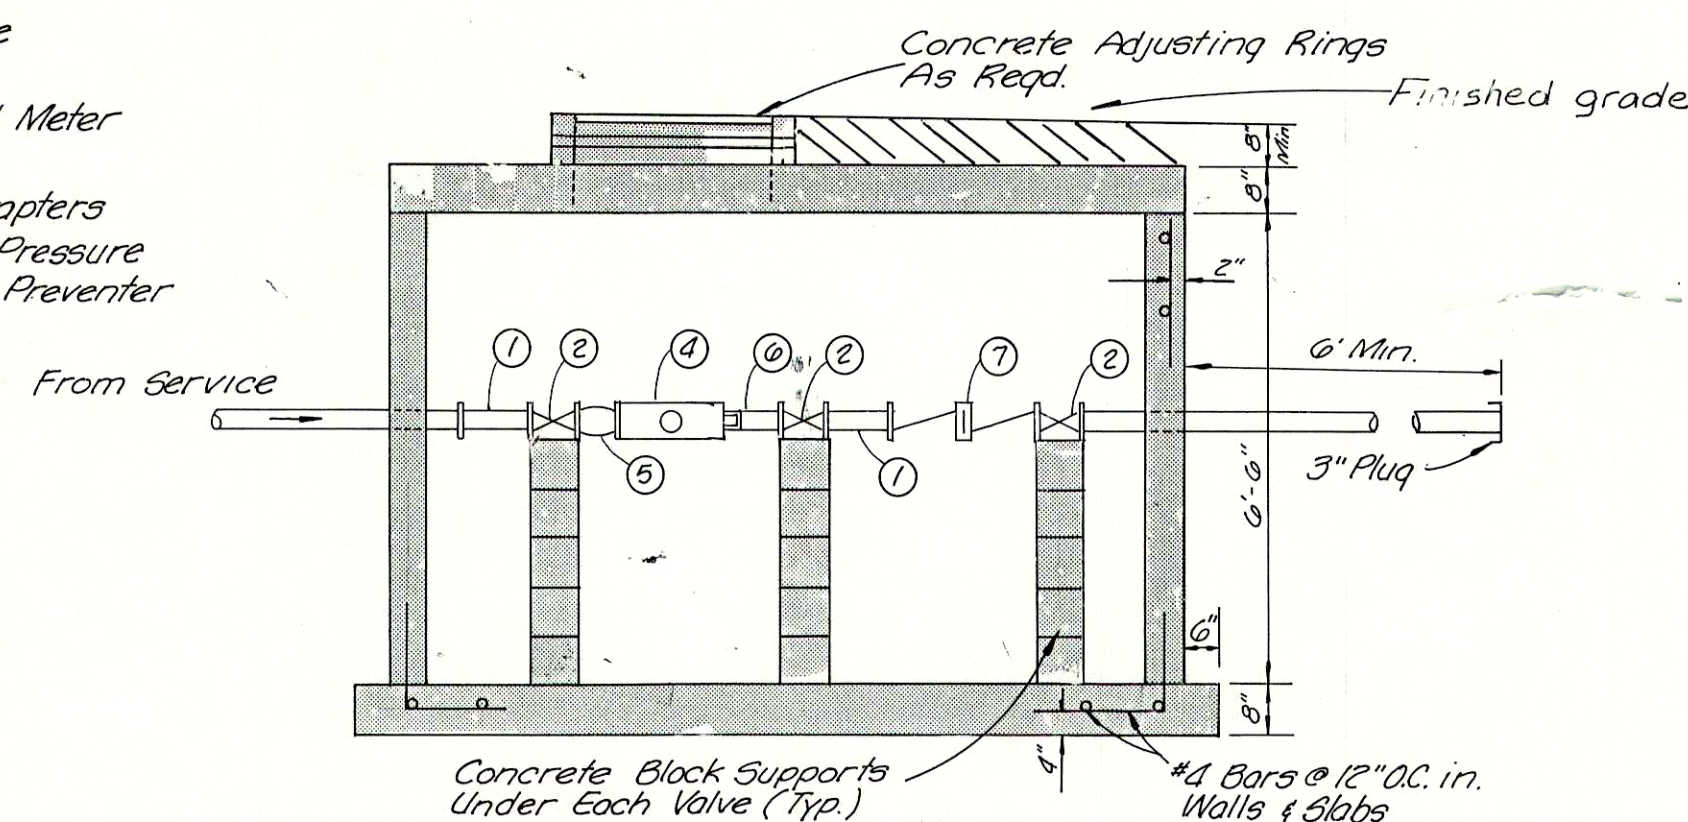

GATE VALVE & VALVE BOX
No Scale

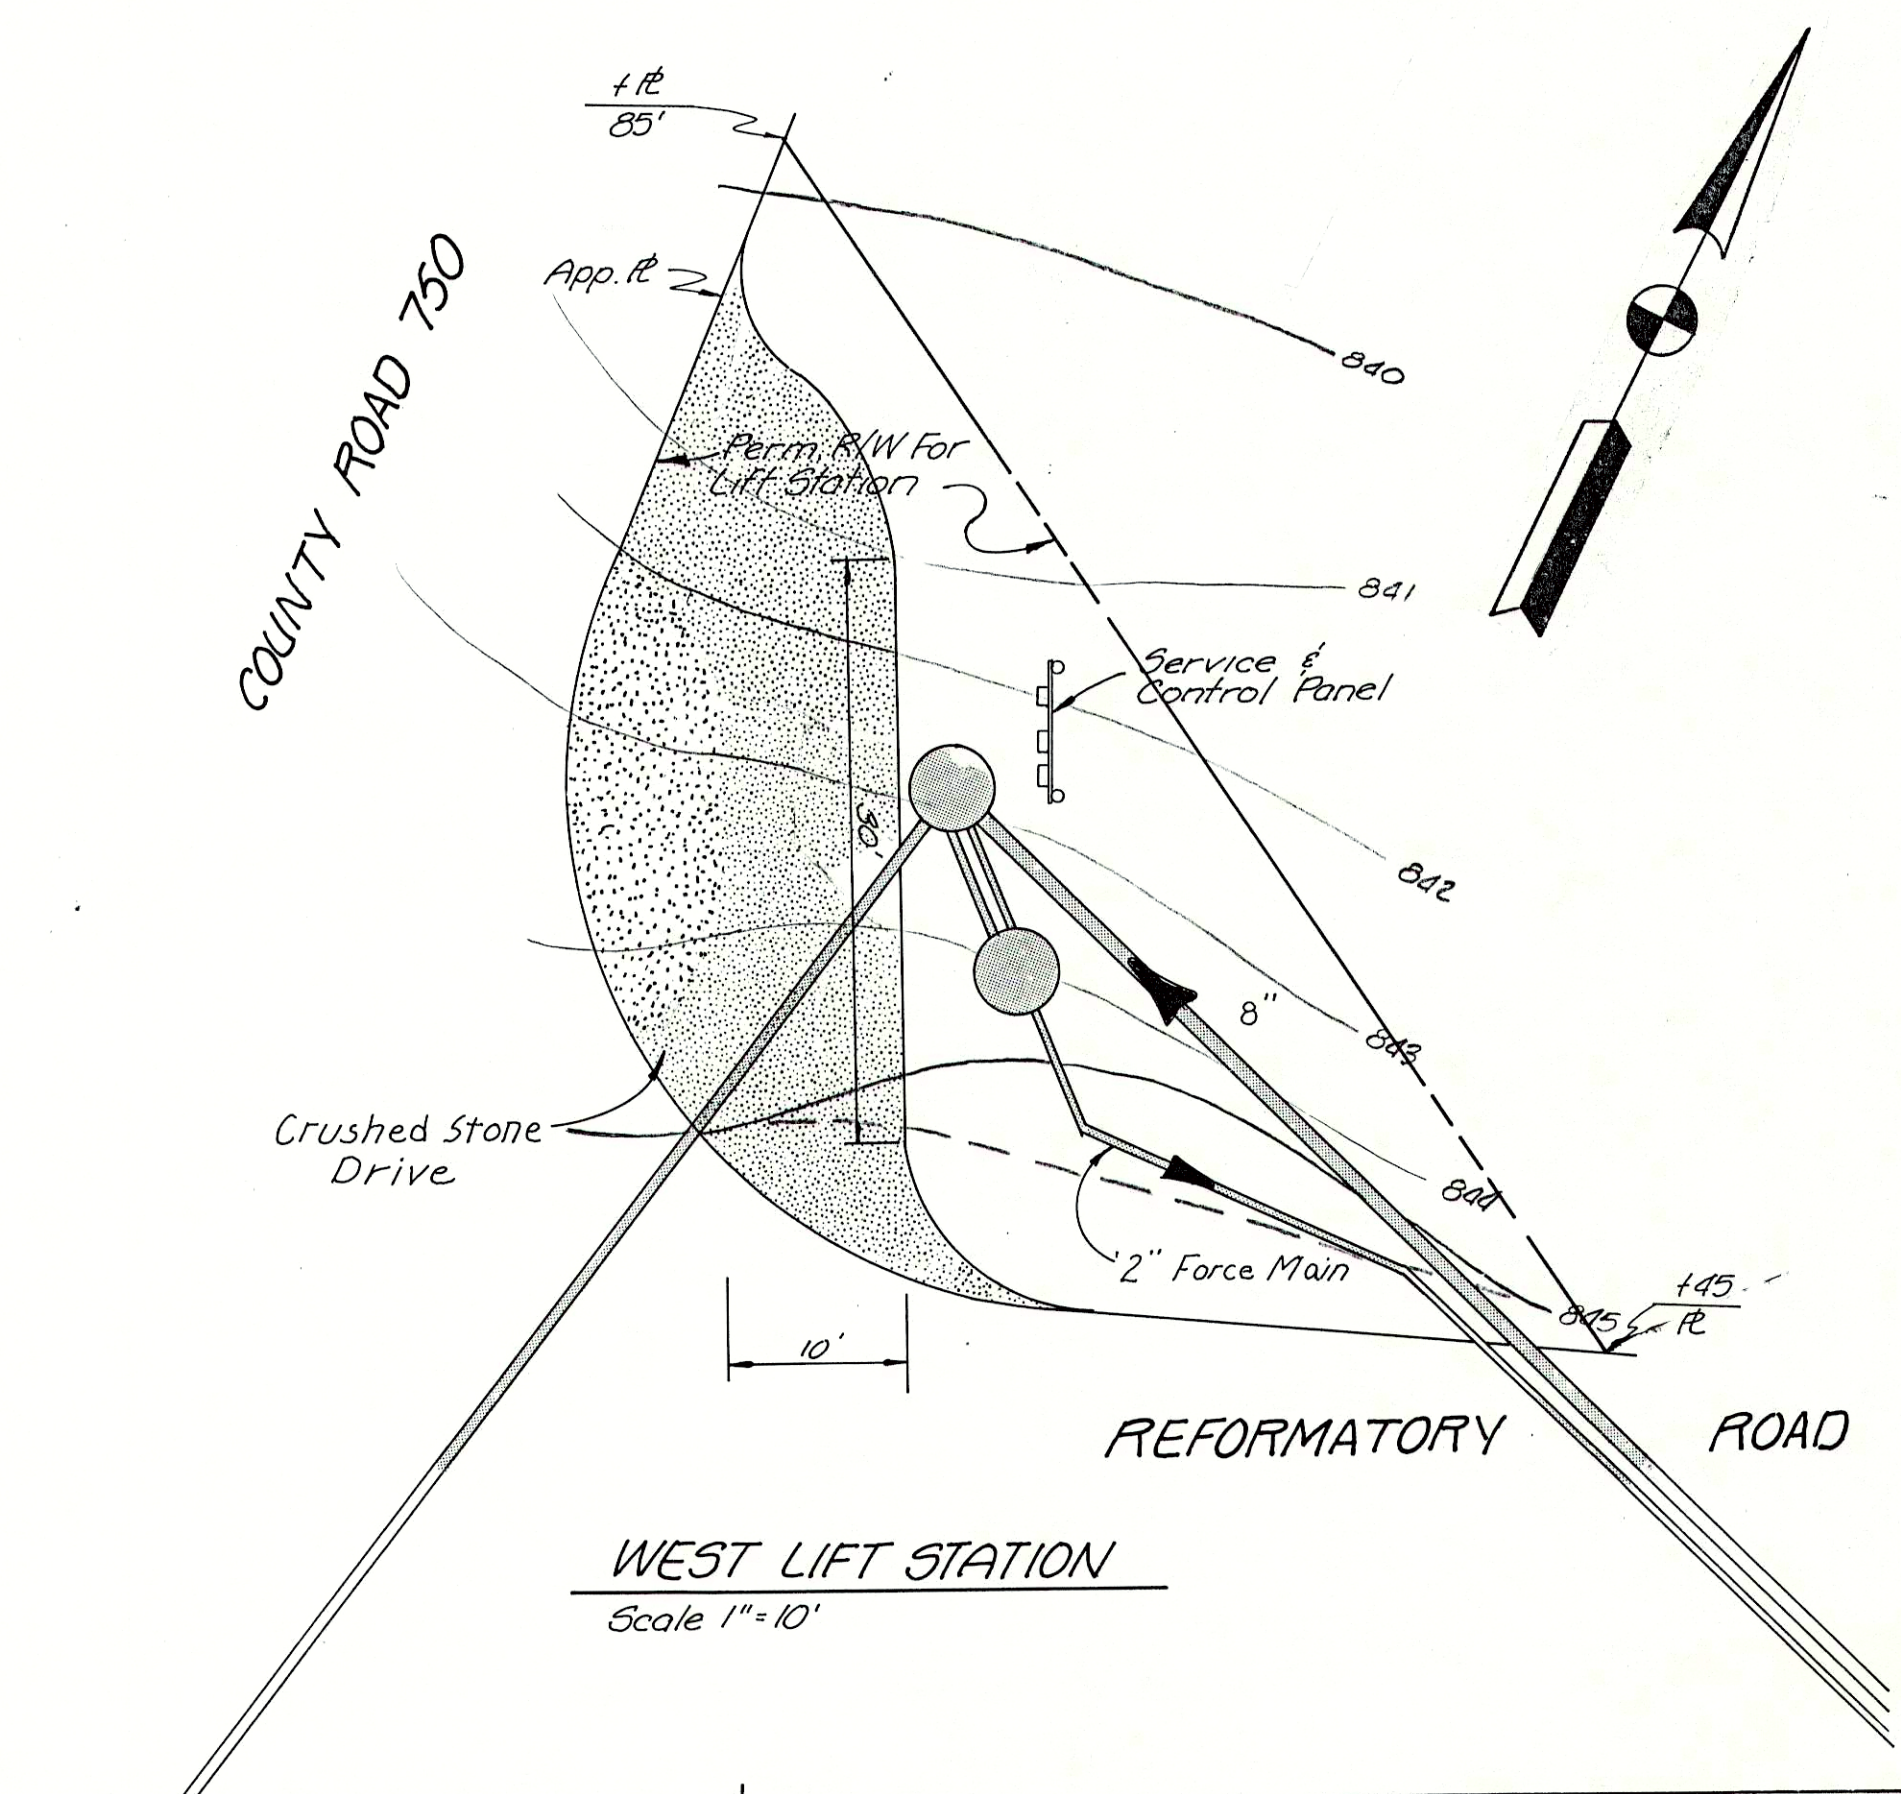

WEST LIFT STATION
Scale 1"=10'

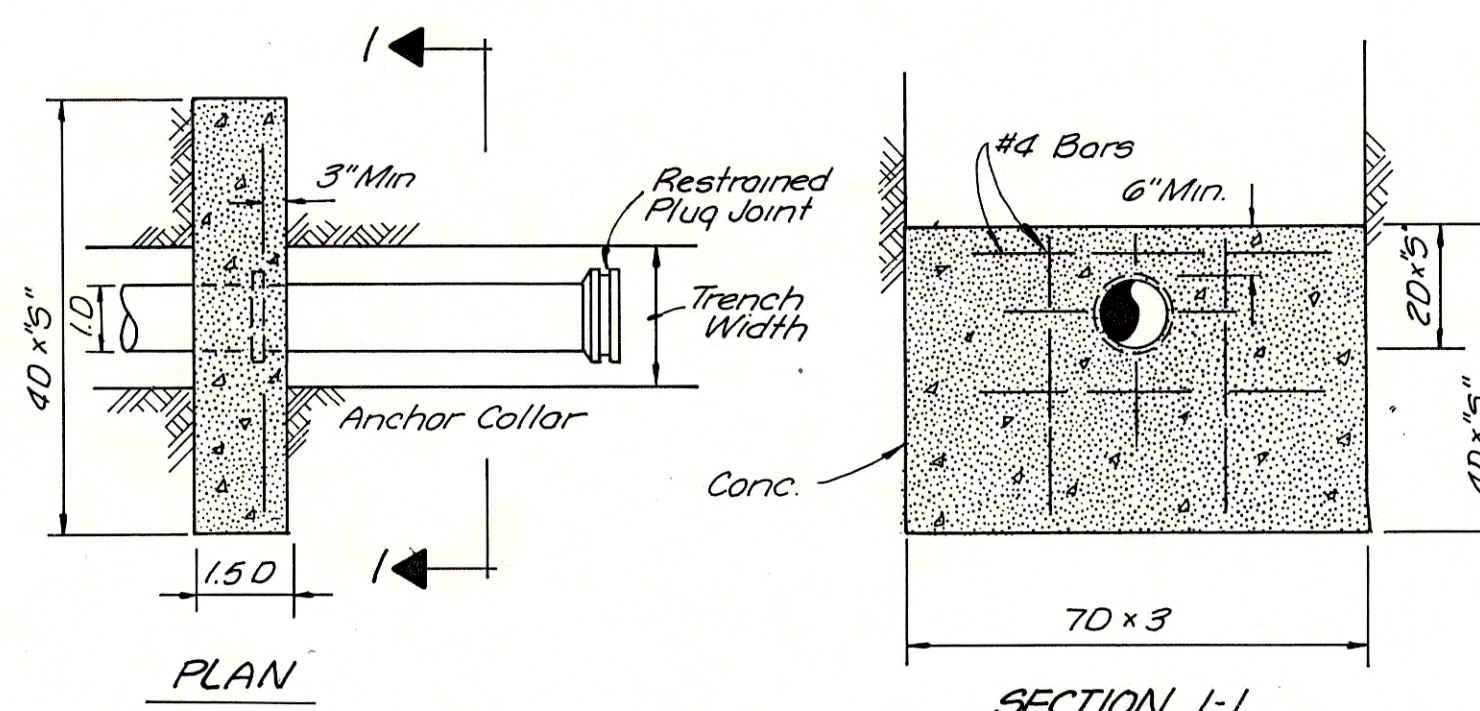

PLAN

SECTION I-I

"S" FACTORS

Soft Clay	.14
Stiff Clay	.58
Hard Clay	.41
Loose Sand	.58
Medium Compacted Sand	.50
Loose Gravel, Sand Mix	.41

ANCHOR BLOCK DETAILS
No Scale

RECORD DRAWING



INGALLS LIFT STATIONS / DETAILS

Scale: As Noted
Drawn By: J.B.
Designed By: S.E.
Certified By: E.R.

FALL CREEK
REGIONAL WASTEWATER DIST.
BEAM, LONGEST & NEFF
Consulting Engineers
8136 Castleton Road
Indianapolis, IN 46250

Sheet
27