


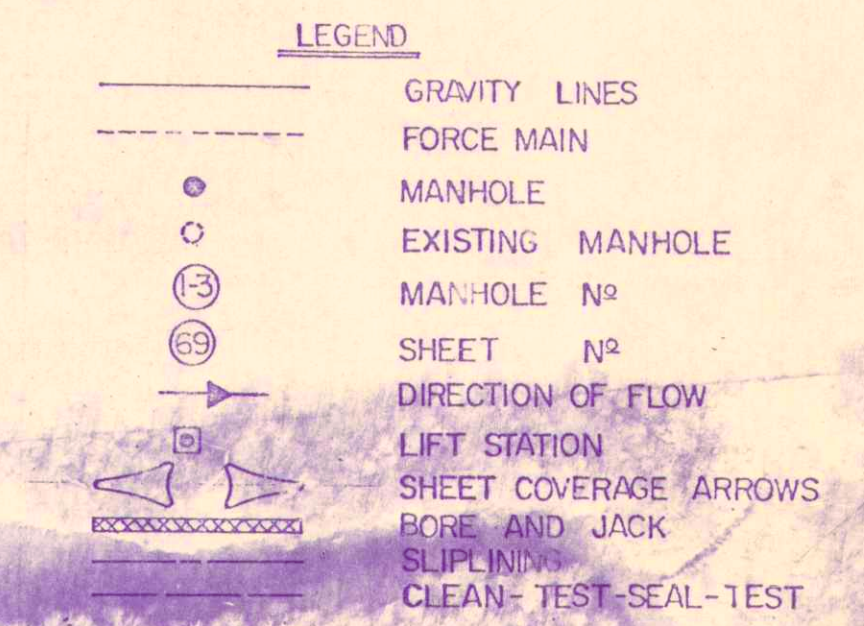

RECORD DRAWING

FALL CREEK WASTEWATER FACILITIES		
Scale: 1"=200'	SEWER SYSTEM LAYOUT	Sheet
Drawn By: GAY	BEAM, LONGEST & NEFF Consulting Engineers 8136 Castleton Road Indianapolis, In. 46250	299
Designed By: GDL		
Certified By: EA		