


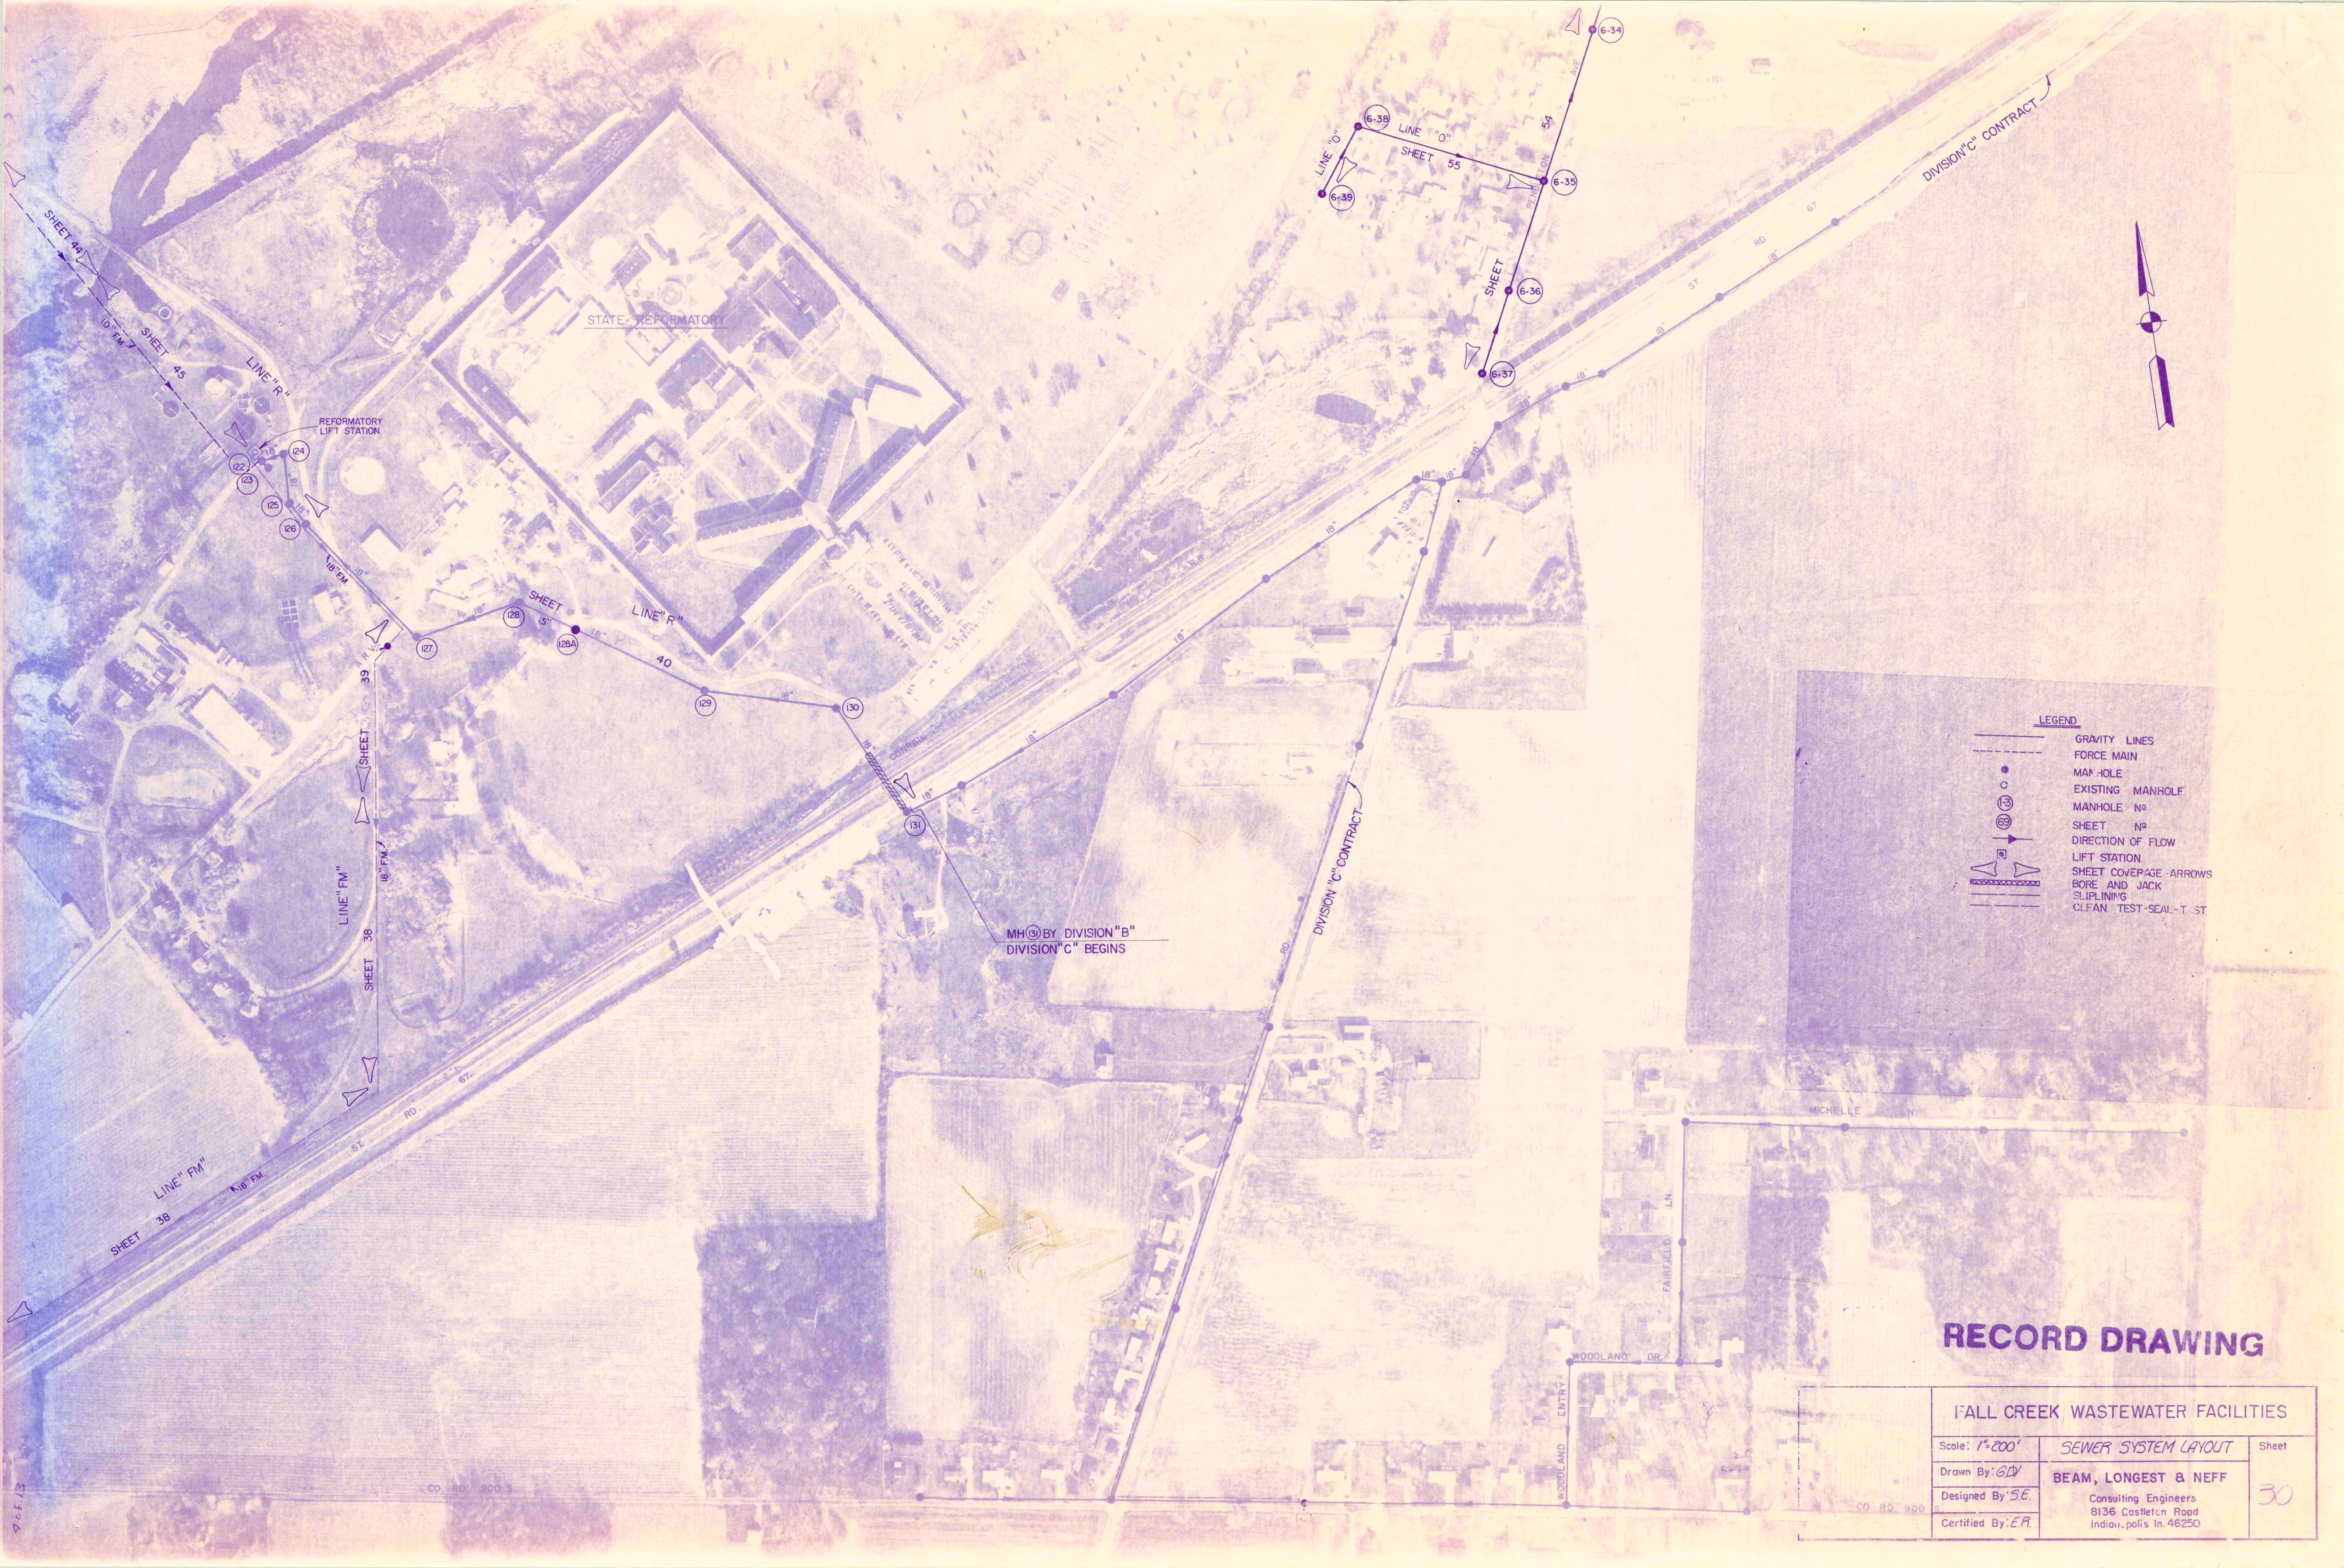

RECORD DRAWING

FALL CREEK WASTEWATER FACILITIES		
Scale: 1"=200'	SEWER SYSTEM LAYOUT	Sheet
Drawn By: G.D.V.	BEAM, LONGEST & NEFF Consulting Engineers 8136 Castleten Road Indianapolis, IN 46250	30
Designed By: S.E.		
Certified By: E.R.		