


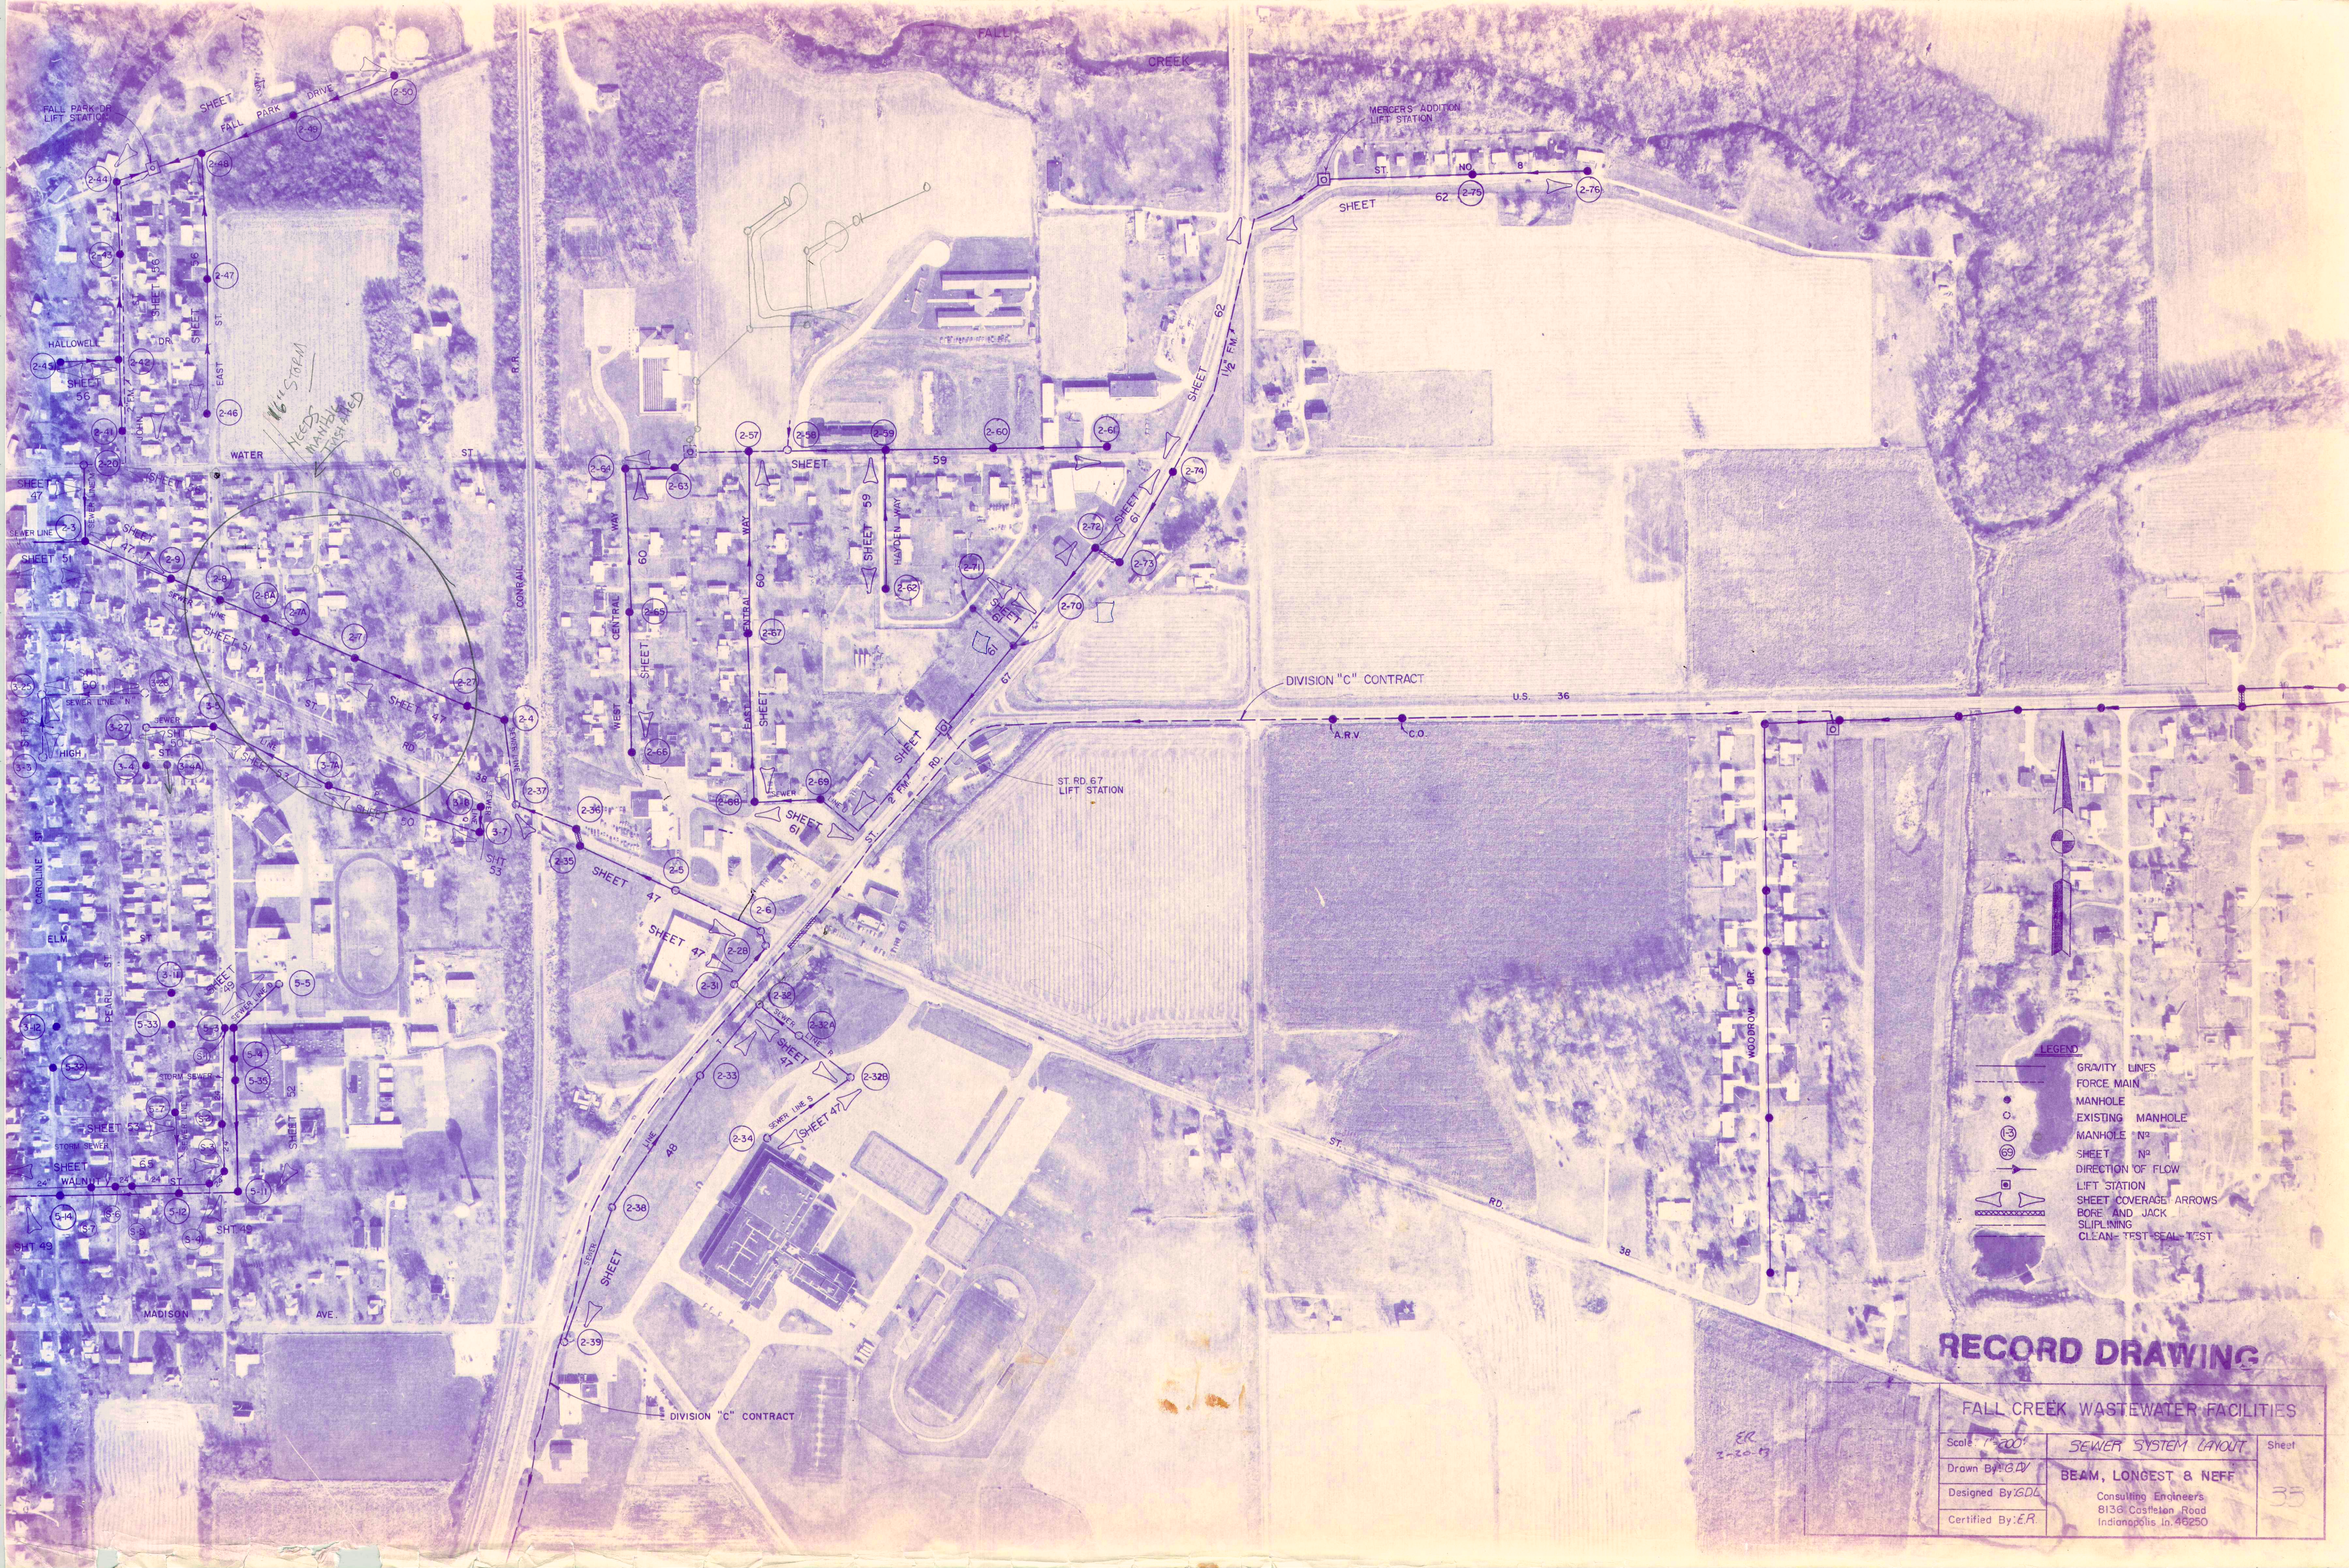

RECORD DRAWING

FALL CREEK WASTEWATER FACILITIES

Scale: 1"=200'	SEWER SYSTEM LAYOUT	Sheet
Drawn By: G.D.V.	BEAM, LONGEST & NEFF	35
Designed By: G.D.V.	Consulting Engineers	
Certified By: E.R.	8136 Casselman Road Indianapolis, IN 46250	