


| PLAN     | DATE | BY | CHKD |
|----------|------|----|------|
| DESIGNED |      |    |      |
| PLOTTED  |      |    |      |
| CHECKED  |      |    |      |
| NOTED    |      |    |      |
| NO.      |      |    |      |

| PROFILE  | DATE | BY | CHKD |
|----------|------|----|------|
| DESIGNED |      |    |      |
| PLOTTED  |      |    |      |
| CHECKED  |      |    |      |
| NOTED    |      |    |      |
| NO.      |      |    |      |

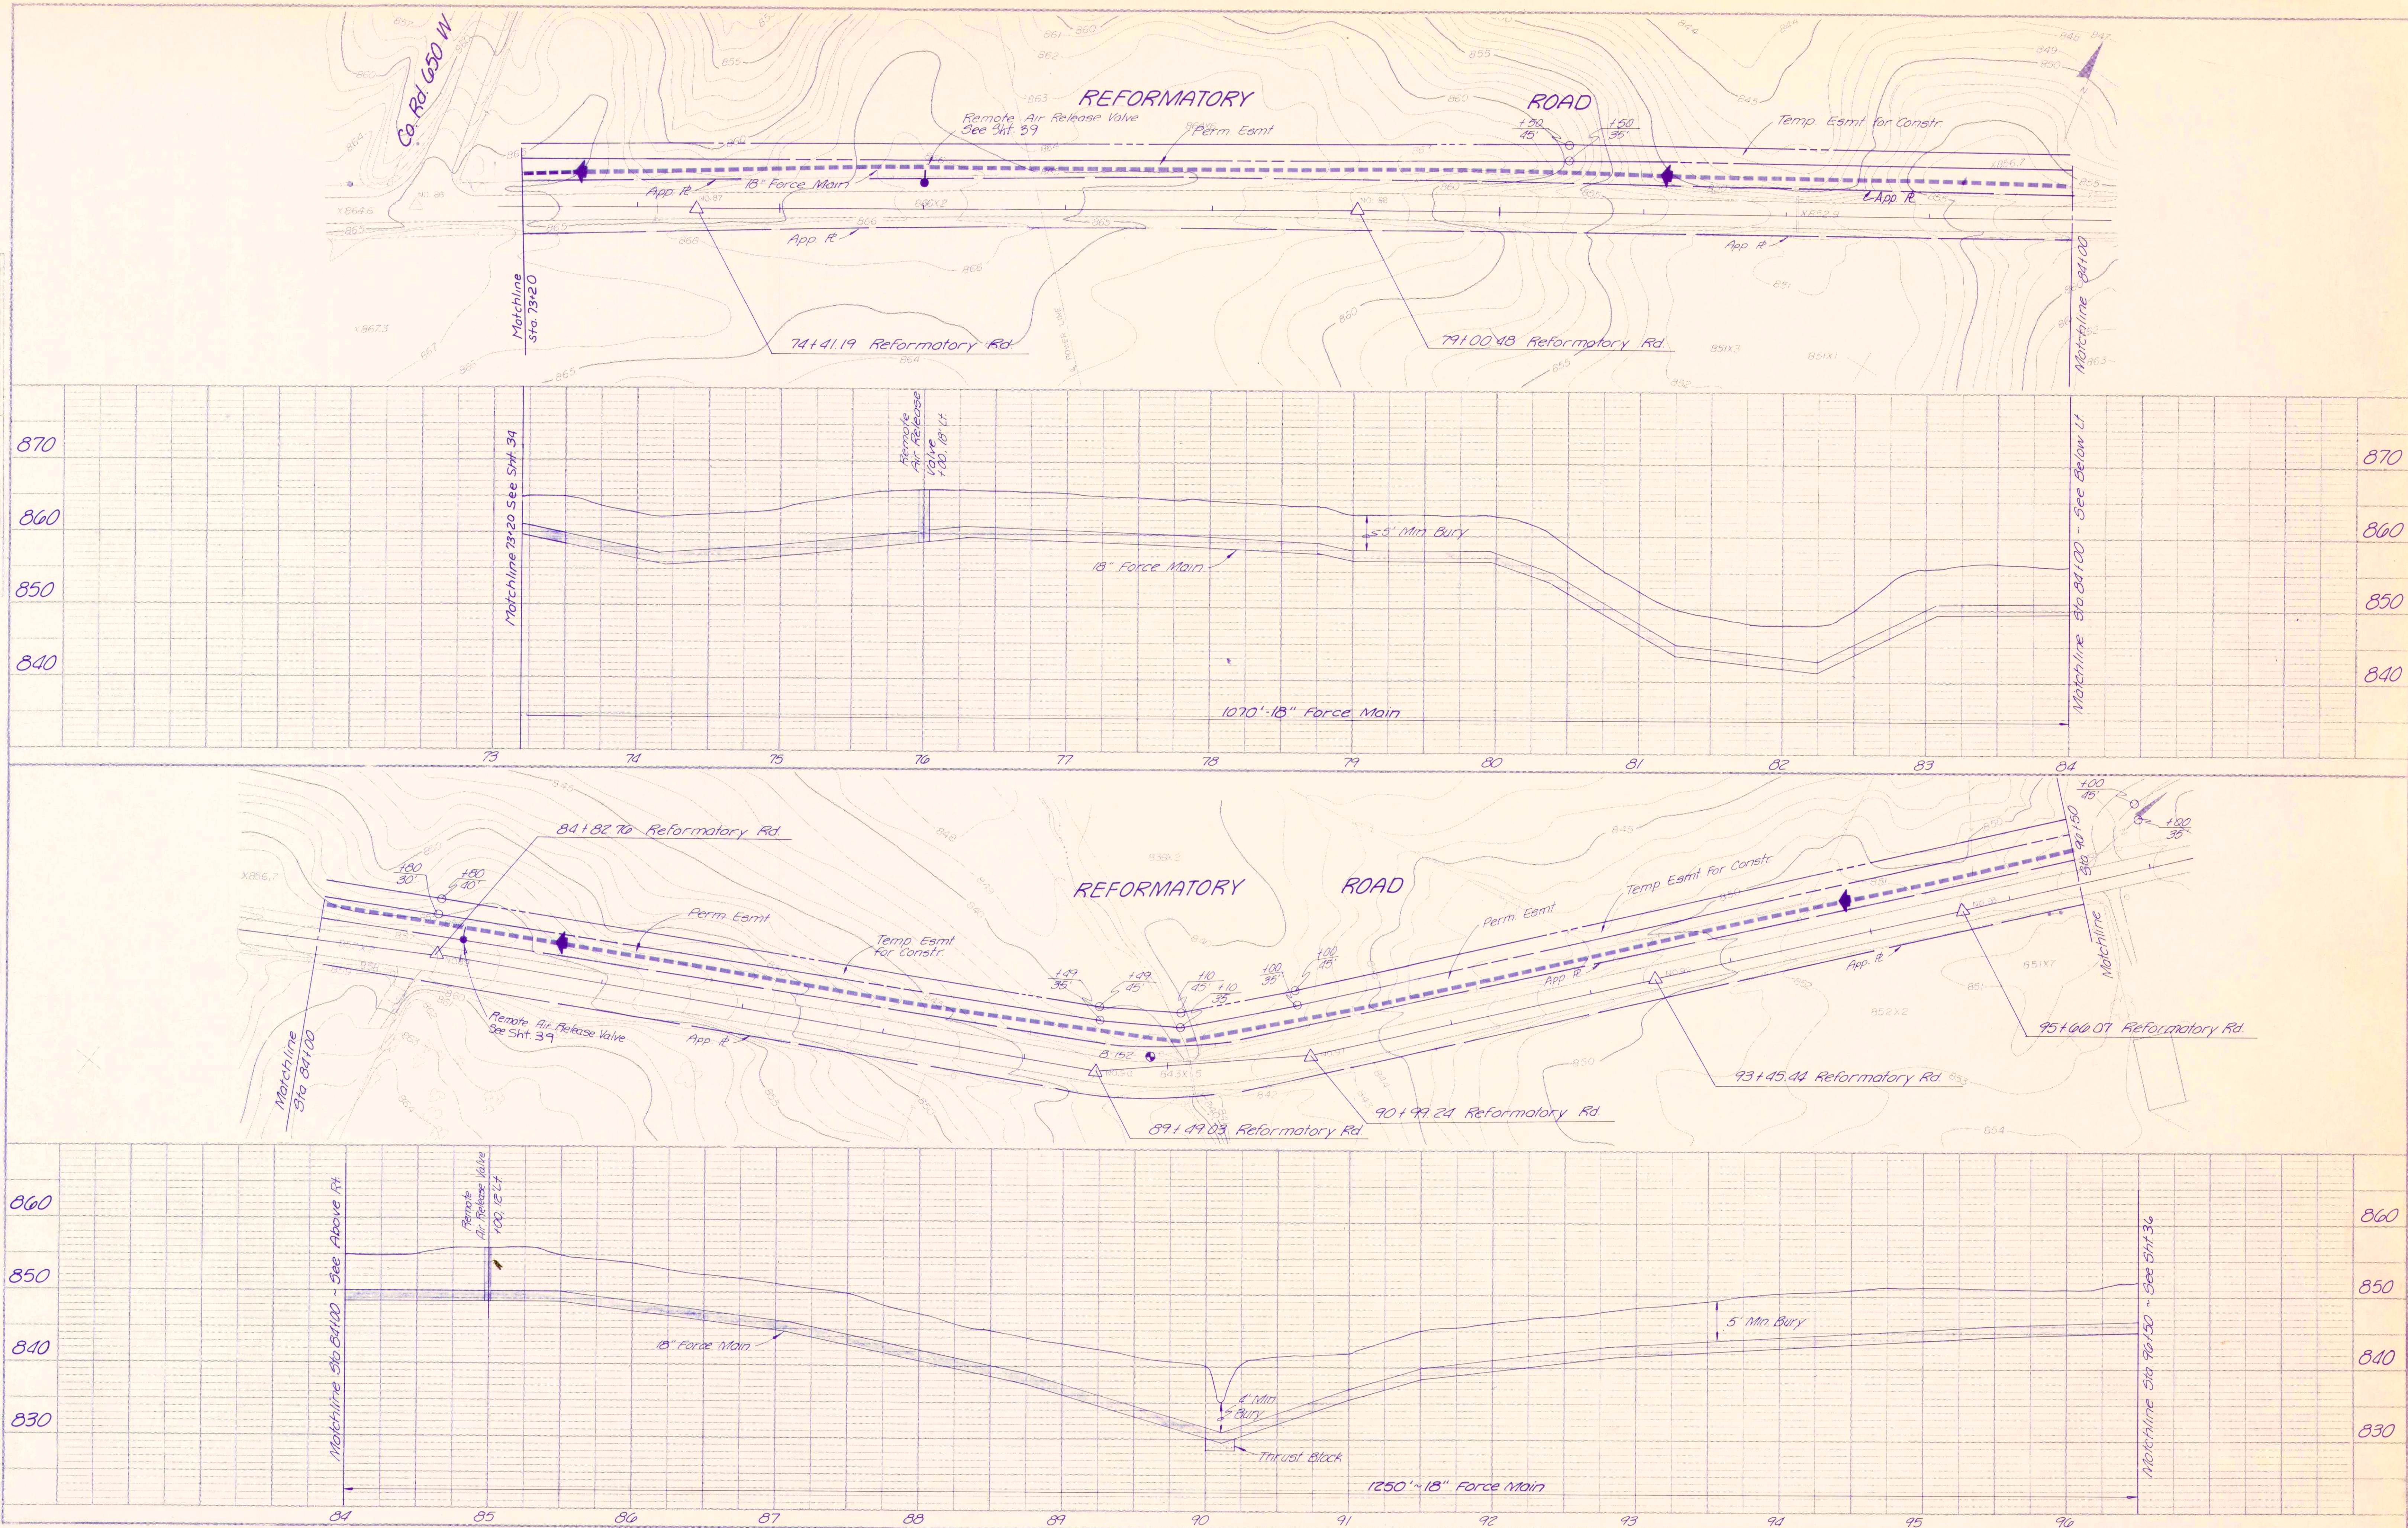

RECORD DRAWING

|                                  |                            |
|----------------------------------|----------------------------|
| 18" FORCE MAIN - REFORMATORY RD. |                            |
| FALL CREEK R.W.D. PLAN & PROFILE | SHEET                      |
| HORIZ. 1"=50'                    | BEAM, LONGEST & NEFF, INC. |
| VERT. 1"=10'                     | CONSULTING ENGINEERS       |
|                                  | INDIANAPOLIS, INDIANA      |
|                                  | 35                         |