


| PLAN      | DATE |
|-----------|------|
| REVISIONS |      |
| NO.       |      |
| DATE      |      |
| BY        |      |
| CHECKED   |      |
| APPROVED  |      |
| NO.       |      |
| DATE      |      |
| BY        |      |
| CHECKED   |      |
| APPROVED  |      |

| PROFILE   | DATE |
|-----------|------|
| REVISIONS |      |
| NO.       |      |
| DATE      |      |
| BY        |      |
| CHECKED   |      |
| APPROVED  |      |

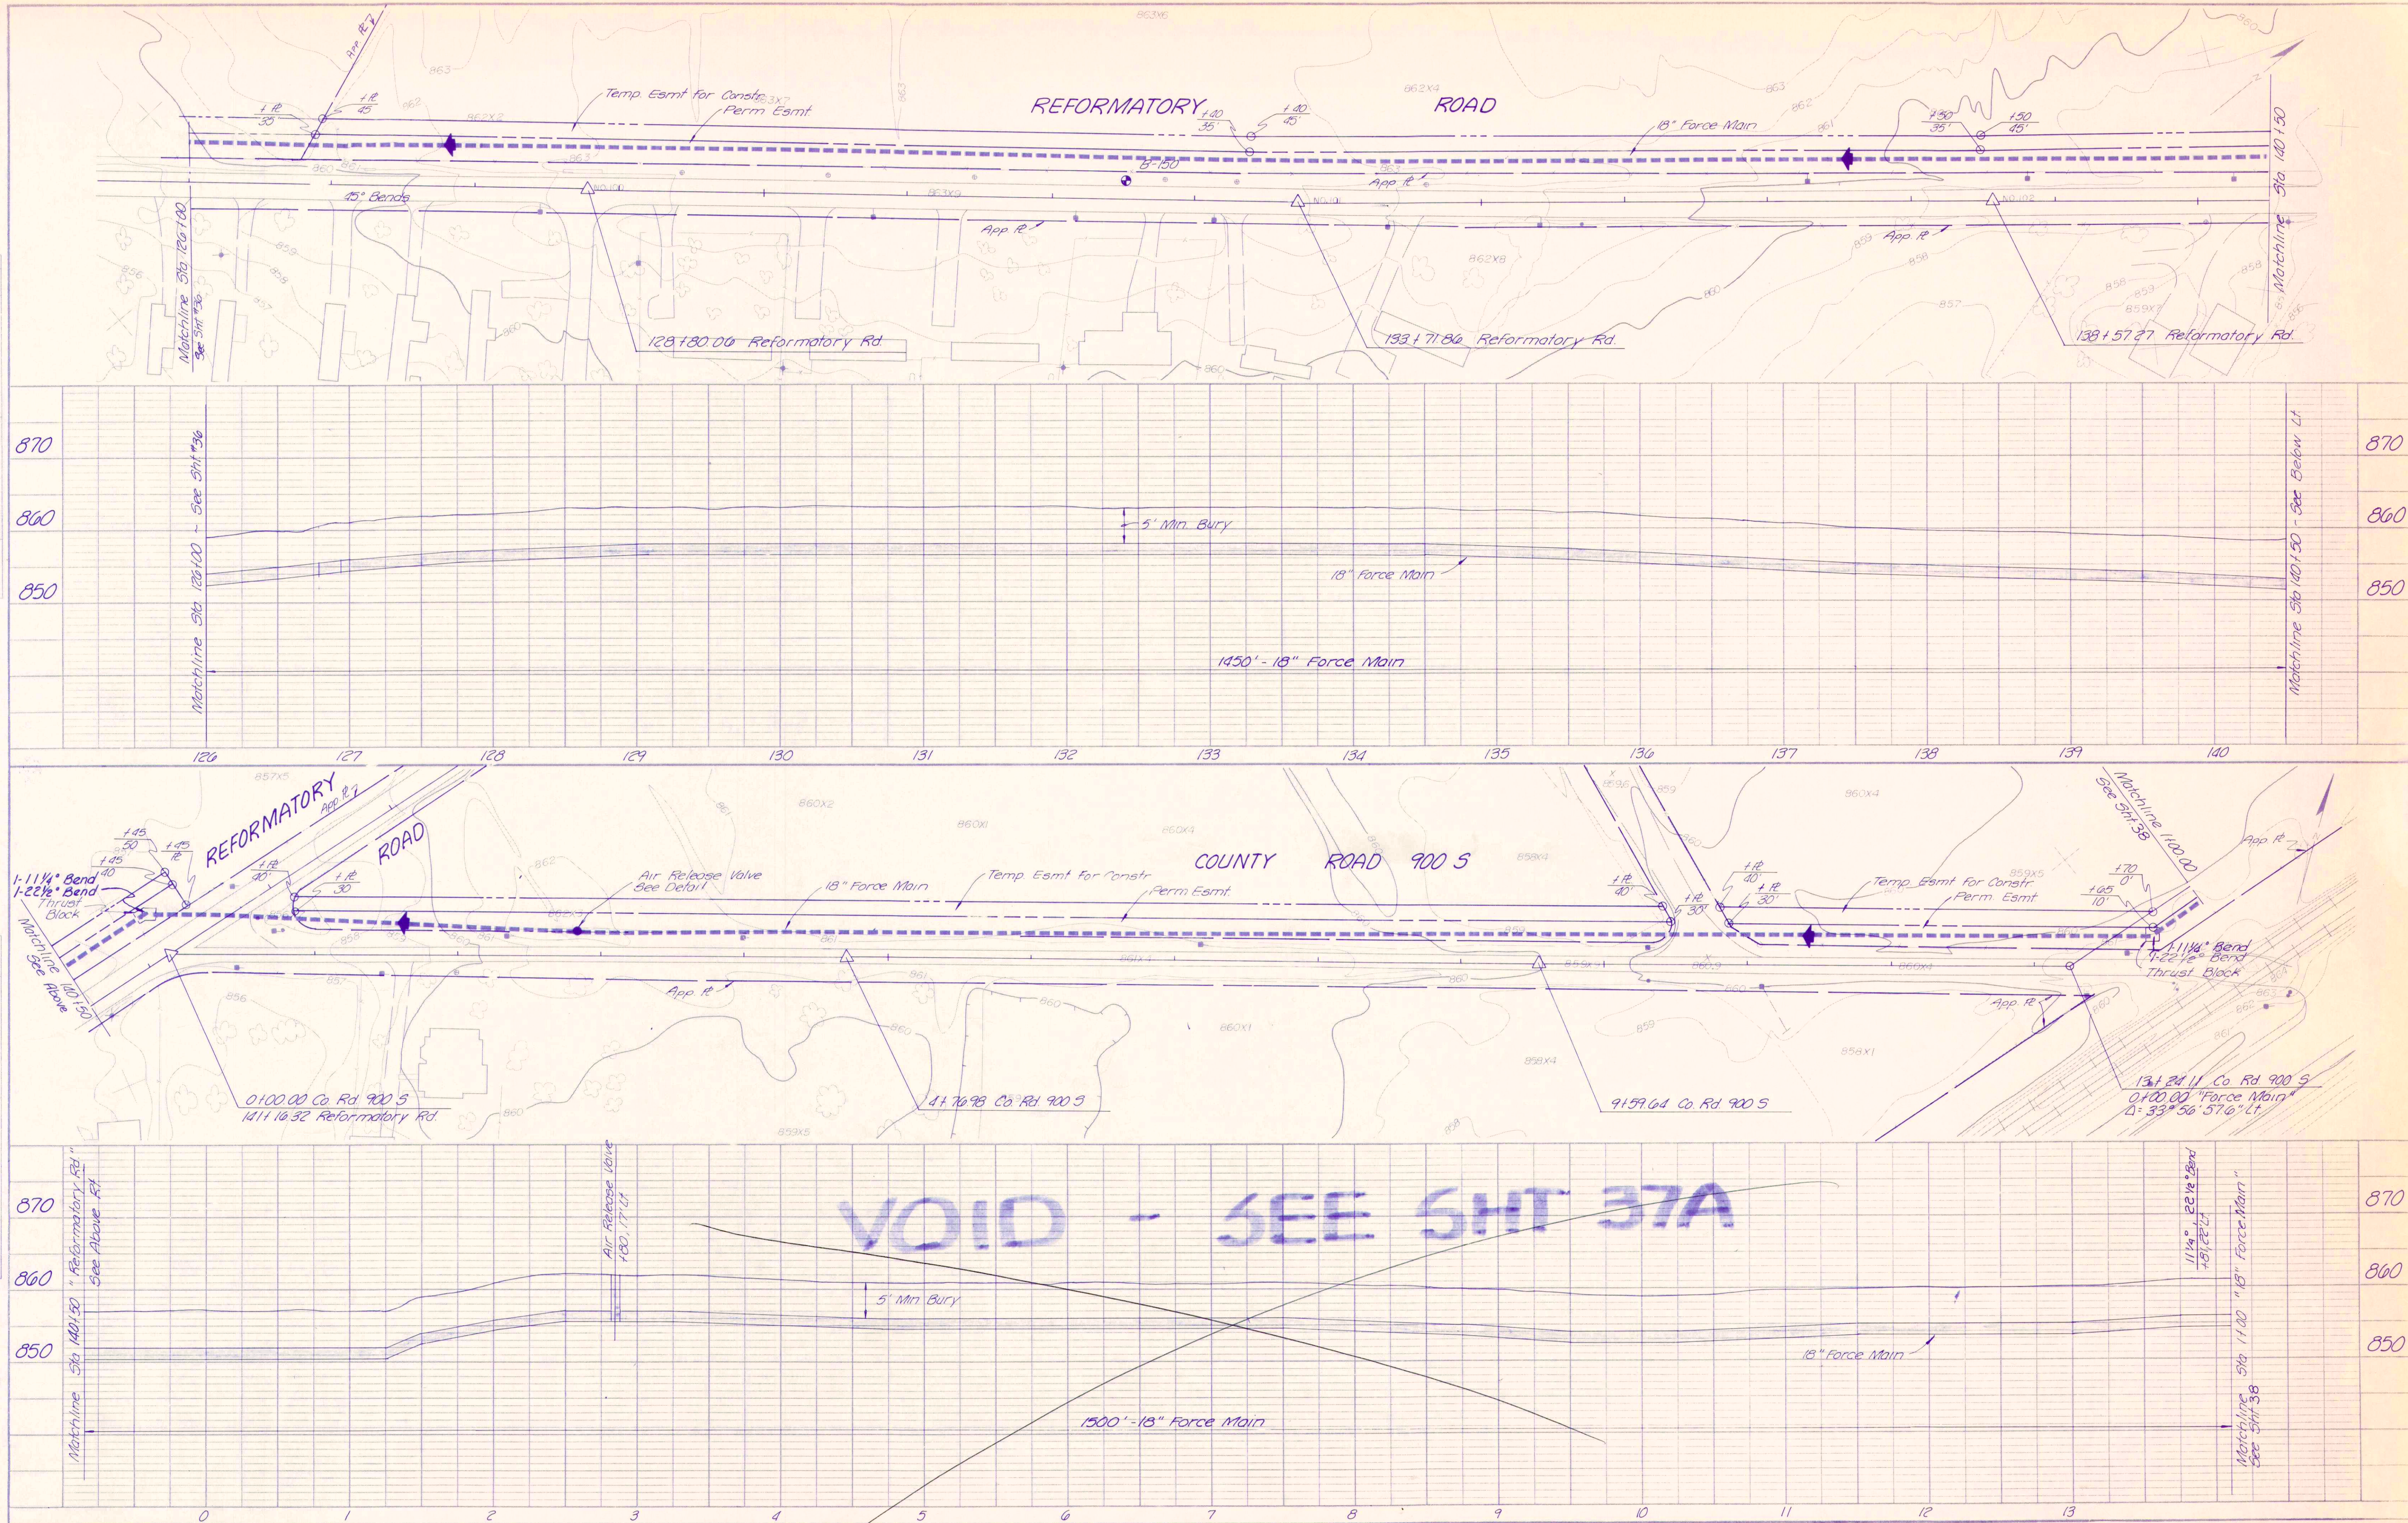

RECORD DRAWING

|                                          |                            |
|------------------------------------------|----------------------------|
| 18" FORCE MAIN - 900 S & REFORMATORY RD. |                            |
| FALL CREEK R.W.D. PLAN & PROFILE SHEET   |                            |
| HORIZ. 1"=50'                            | BEAM, LONGEST & NEFF, INC. |
| VERT. 1"=10'                             | CONSULTING ENGINEERS       |
|                                          | INDIANAPOLIS, INDIANA      |

37