


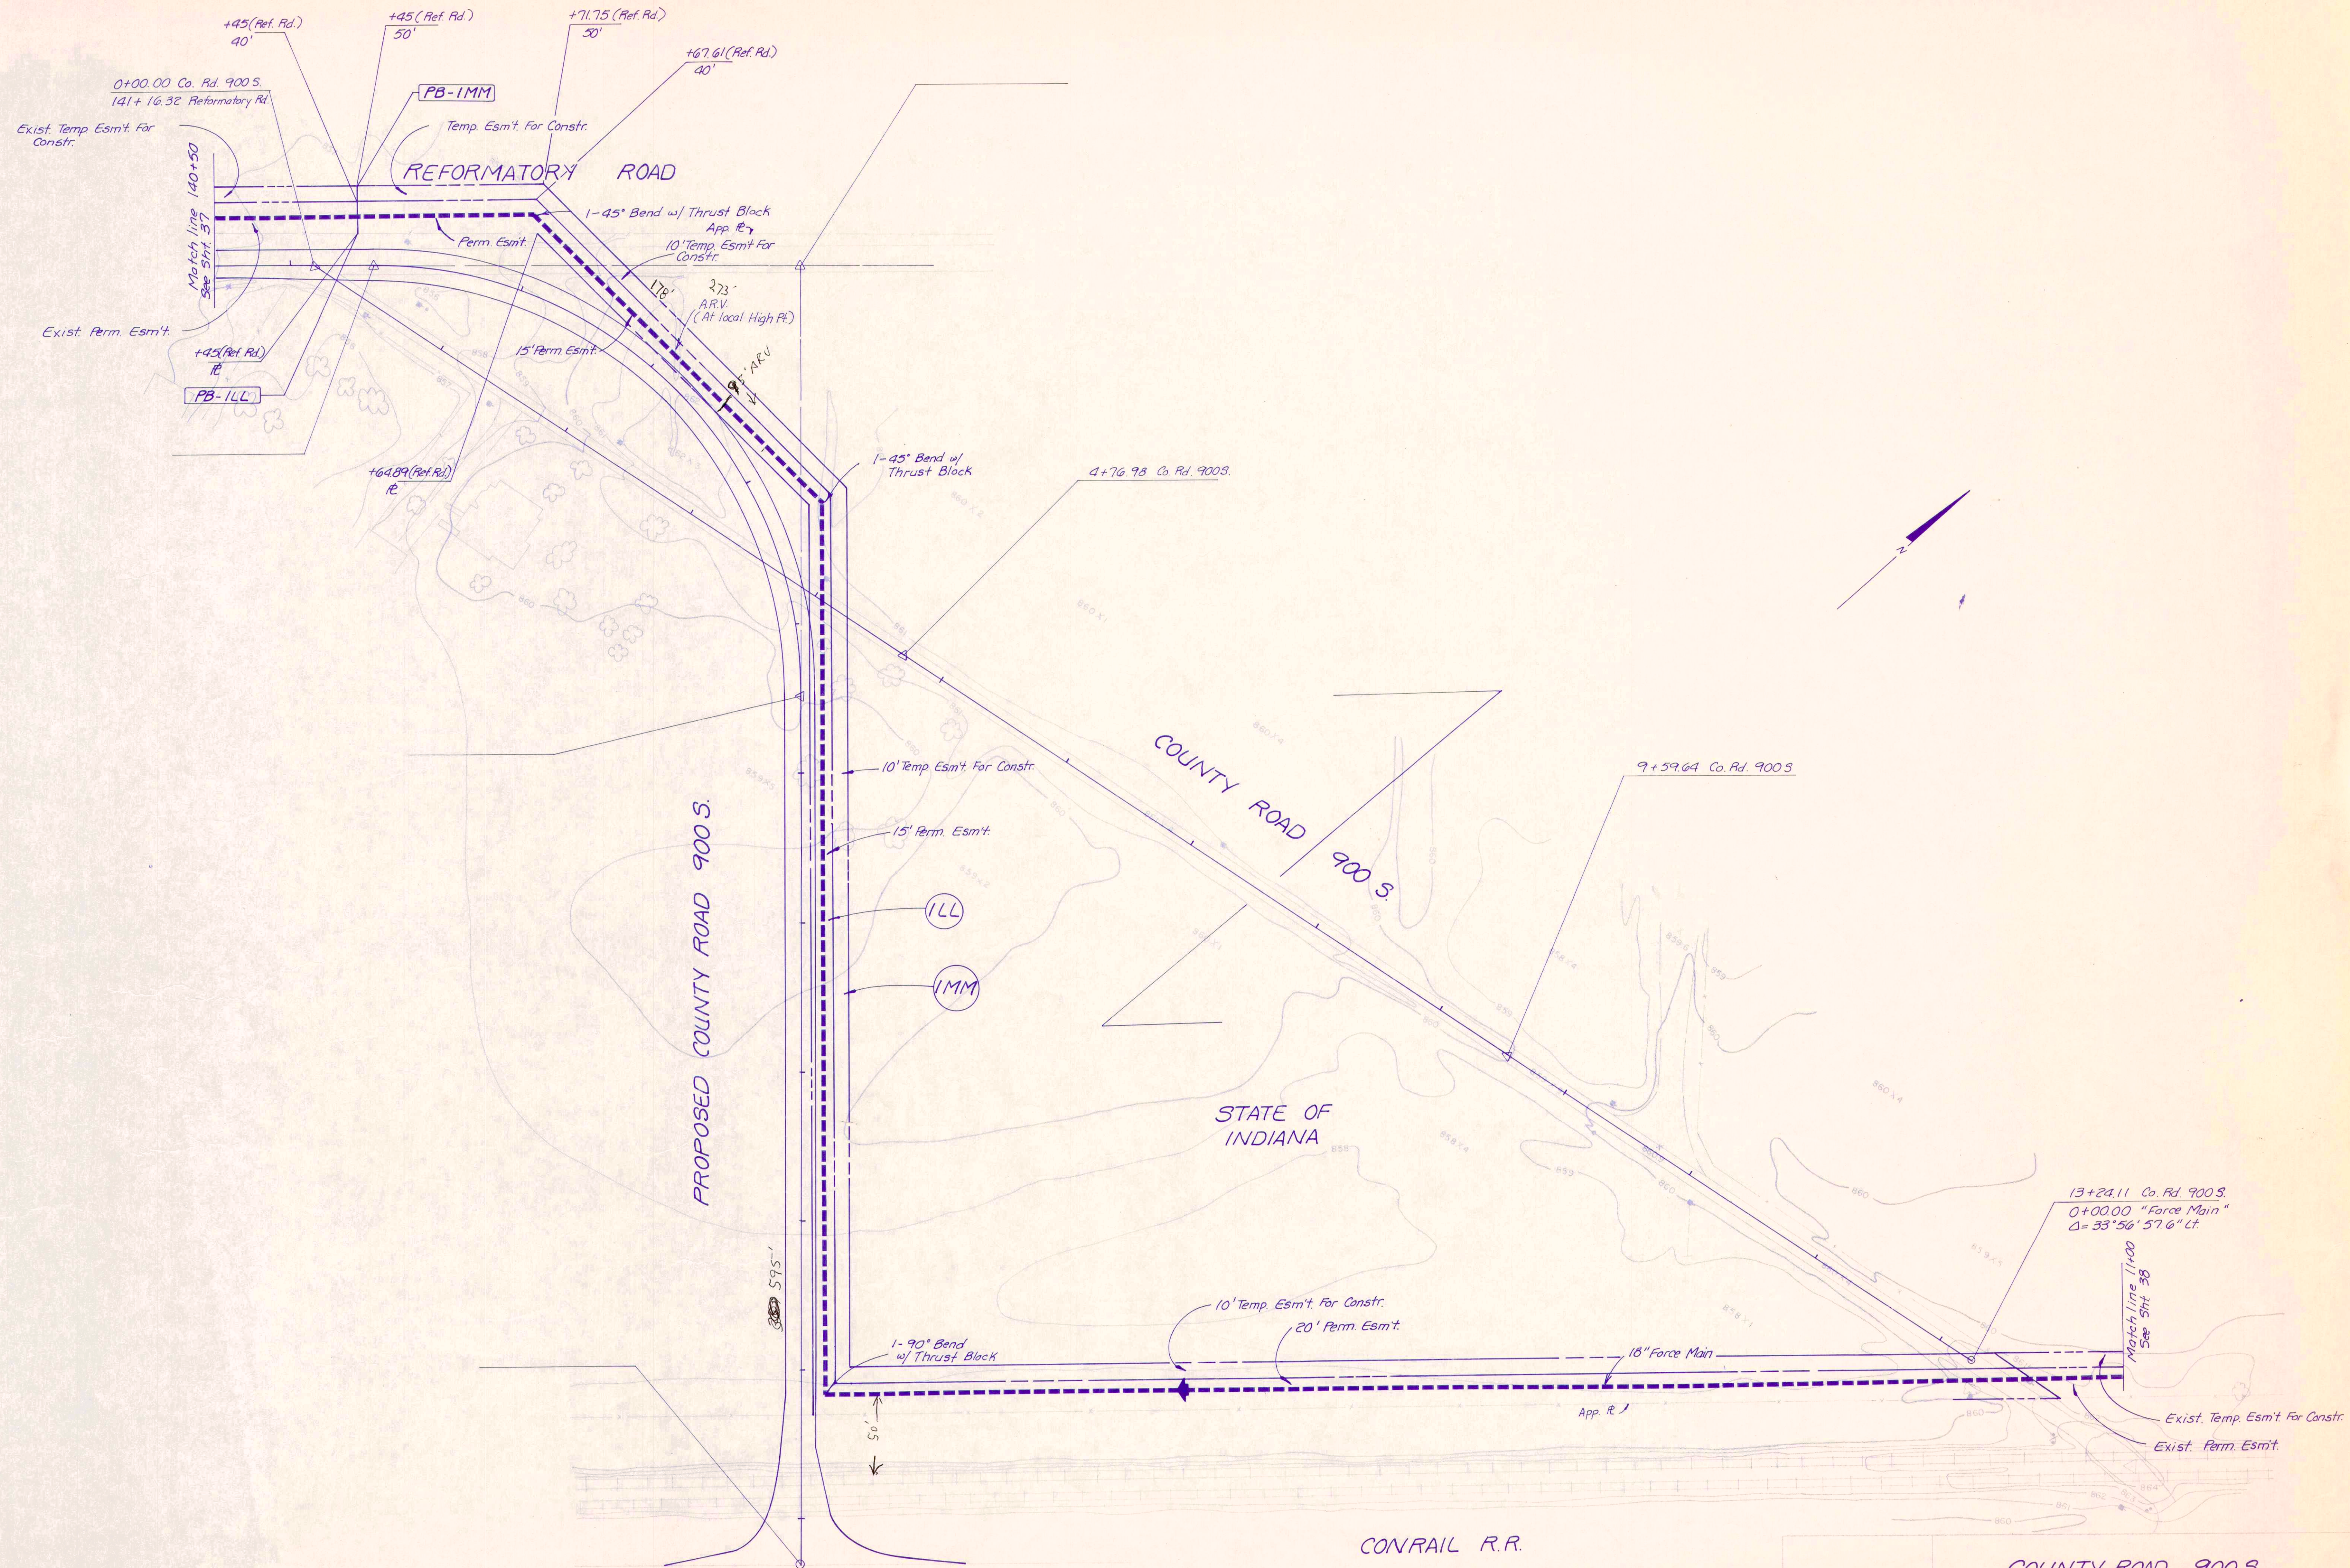

STATE ROAD 67

RECORD DRAWING

COUNTY ROAD 900 S.

Scale: 1"=50'	FALL CREEK	Sheet
Drawn By: G.D.V.	BEAM, LONGEST & NEFF	37A
Designed By: D.N.	Consulting Engineers	
Reviewed By: E.R.	8126 Casselton Road Indianapolis, IN 46250	