


PLAN	DATE
SURVEYED	
PLOTTED	
NOTED	
NO.	

PROFILE	DATE
SURVEYED	
PLOTTED	
NOTED	
NO.	

Panhandle Eastern Pipeline Gas Lines
Contractor to Use Extreme Caution in This Area
Lines Are in Their Approximate Location
Contractor Must Verify Depth & Location with
Gas Corp. Before Construction.

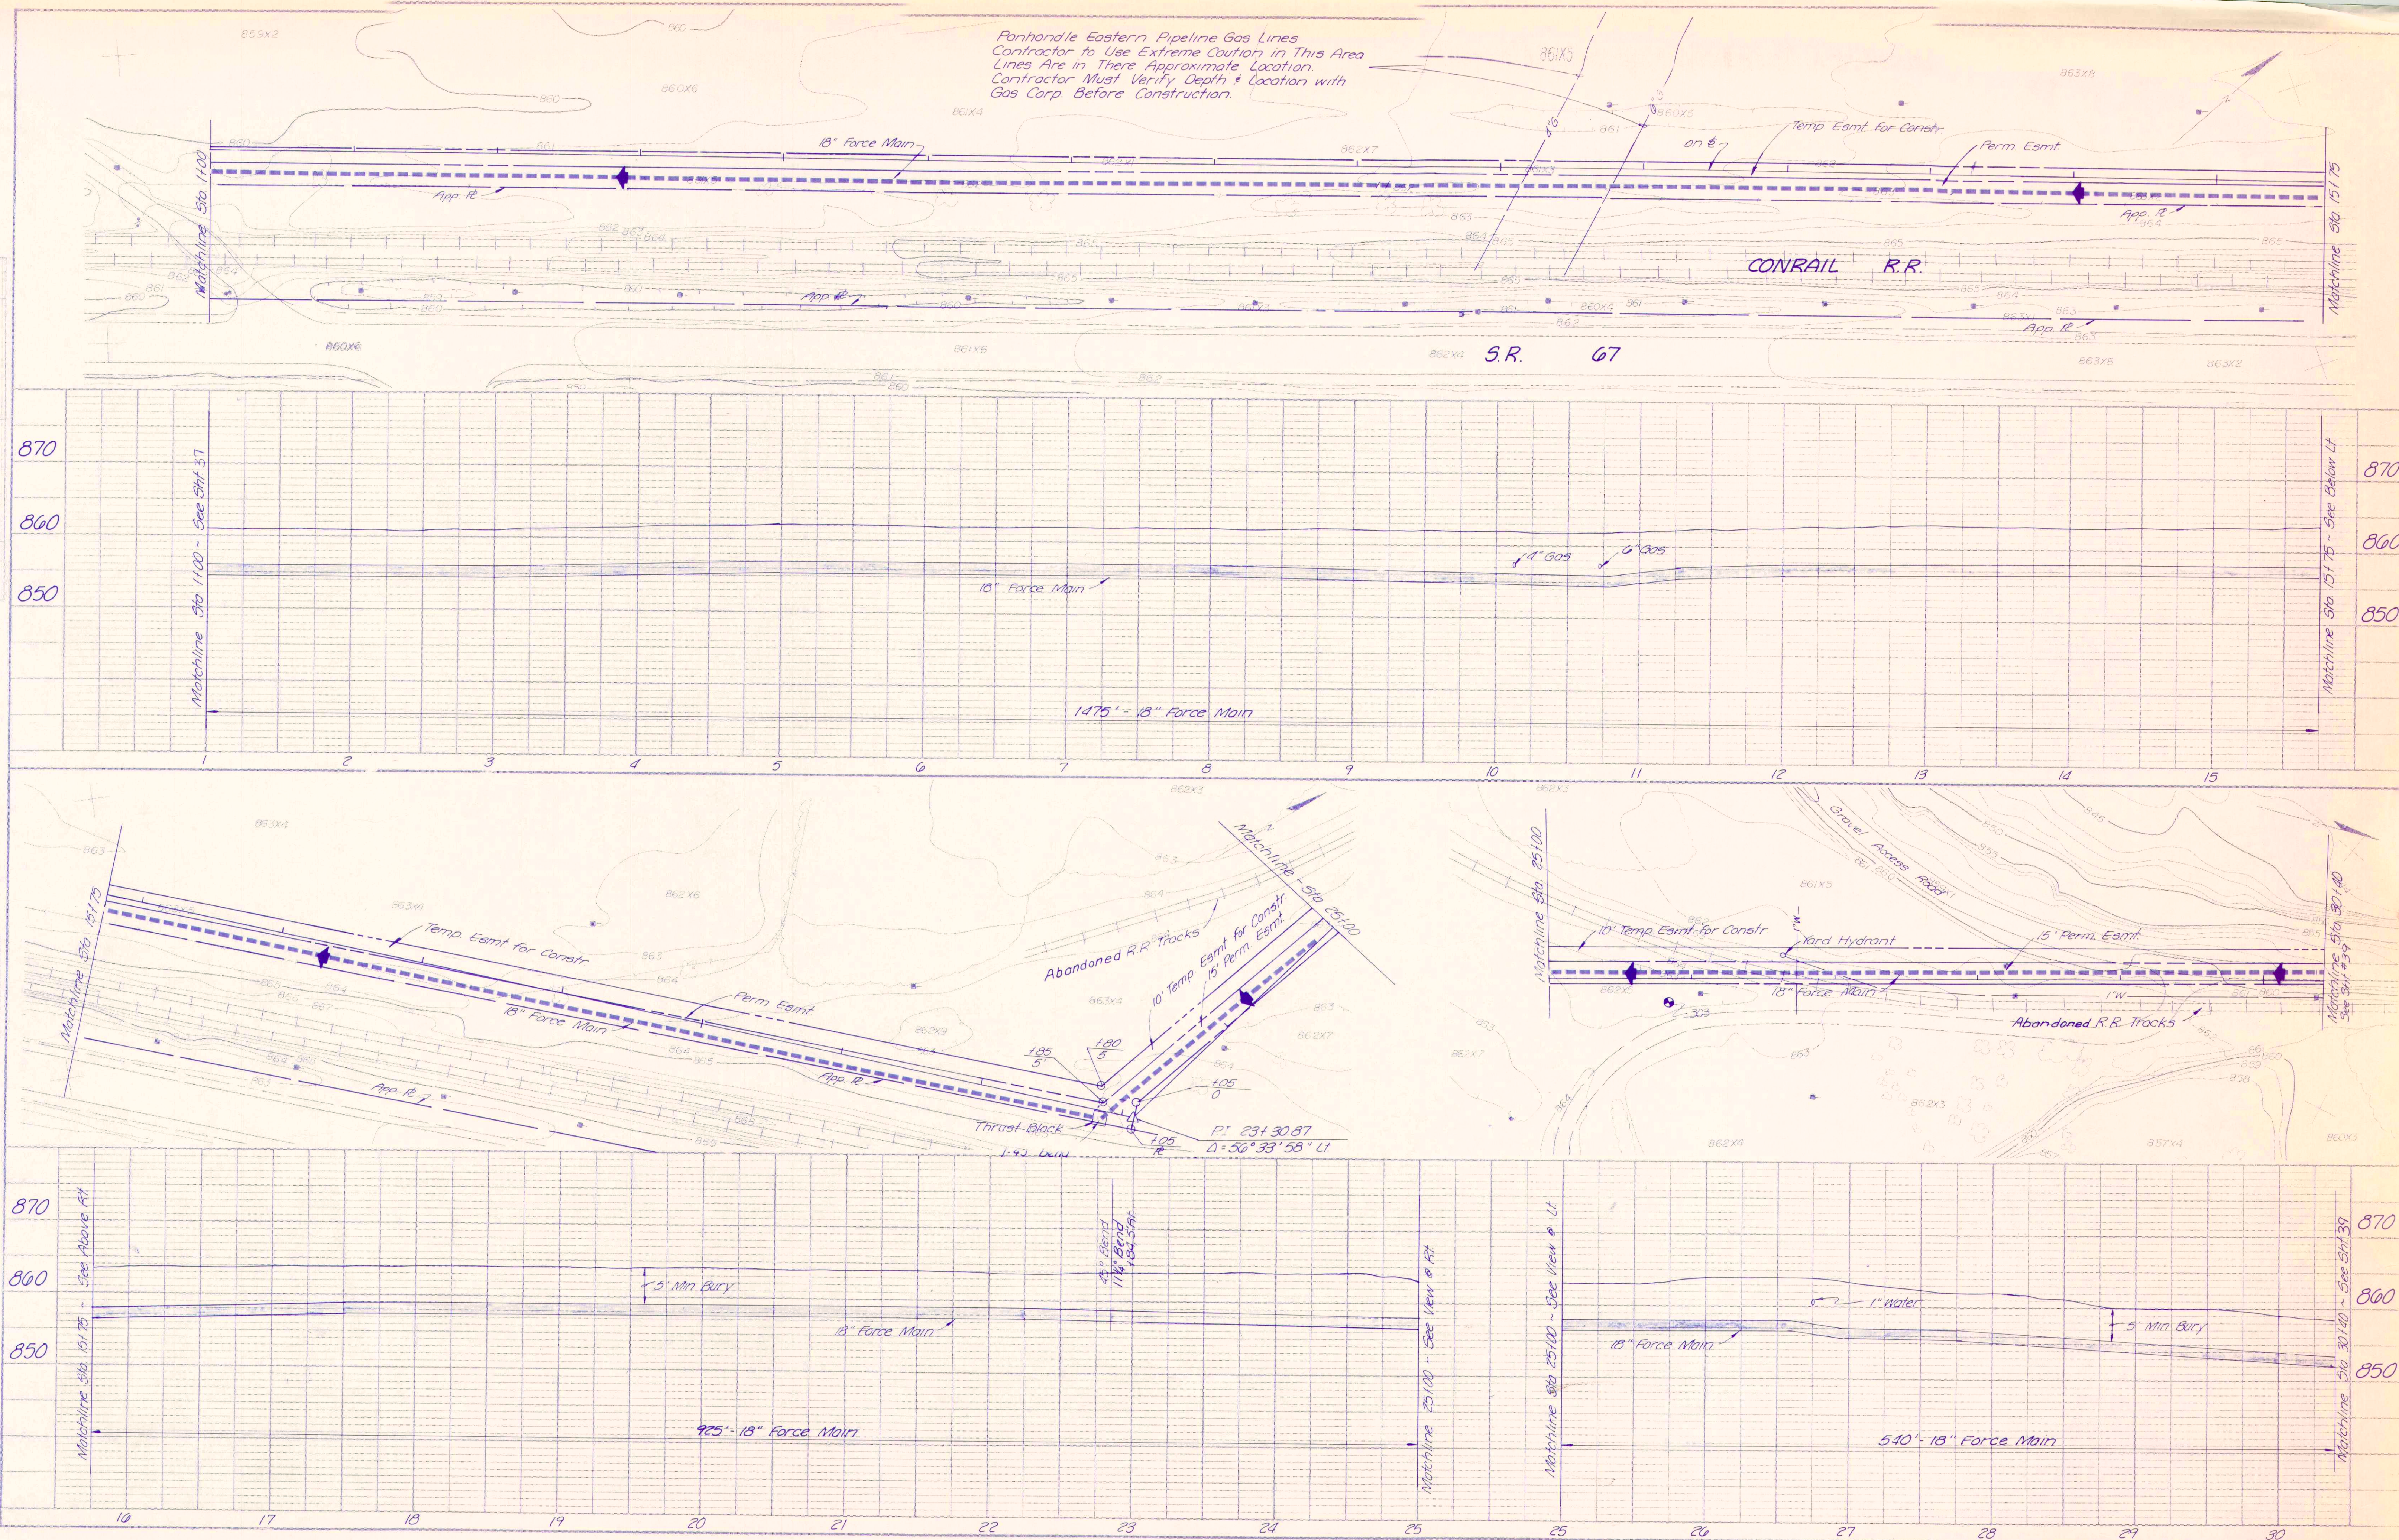

RECORD DRAWING

18" FORCE MAIN	
FALL CREEK R.W.D. PLAN & PROFILE SHEET	
HORIZ. 1"=50'	BEAM, LONGEST & NEFF, INC.
VERT. 1"=10'	CONSULTING ENGINEERS
	INDIANAPOLIS, INDIANA