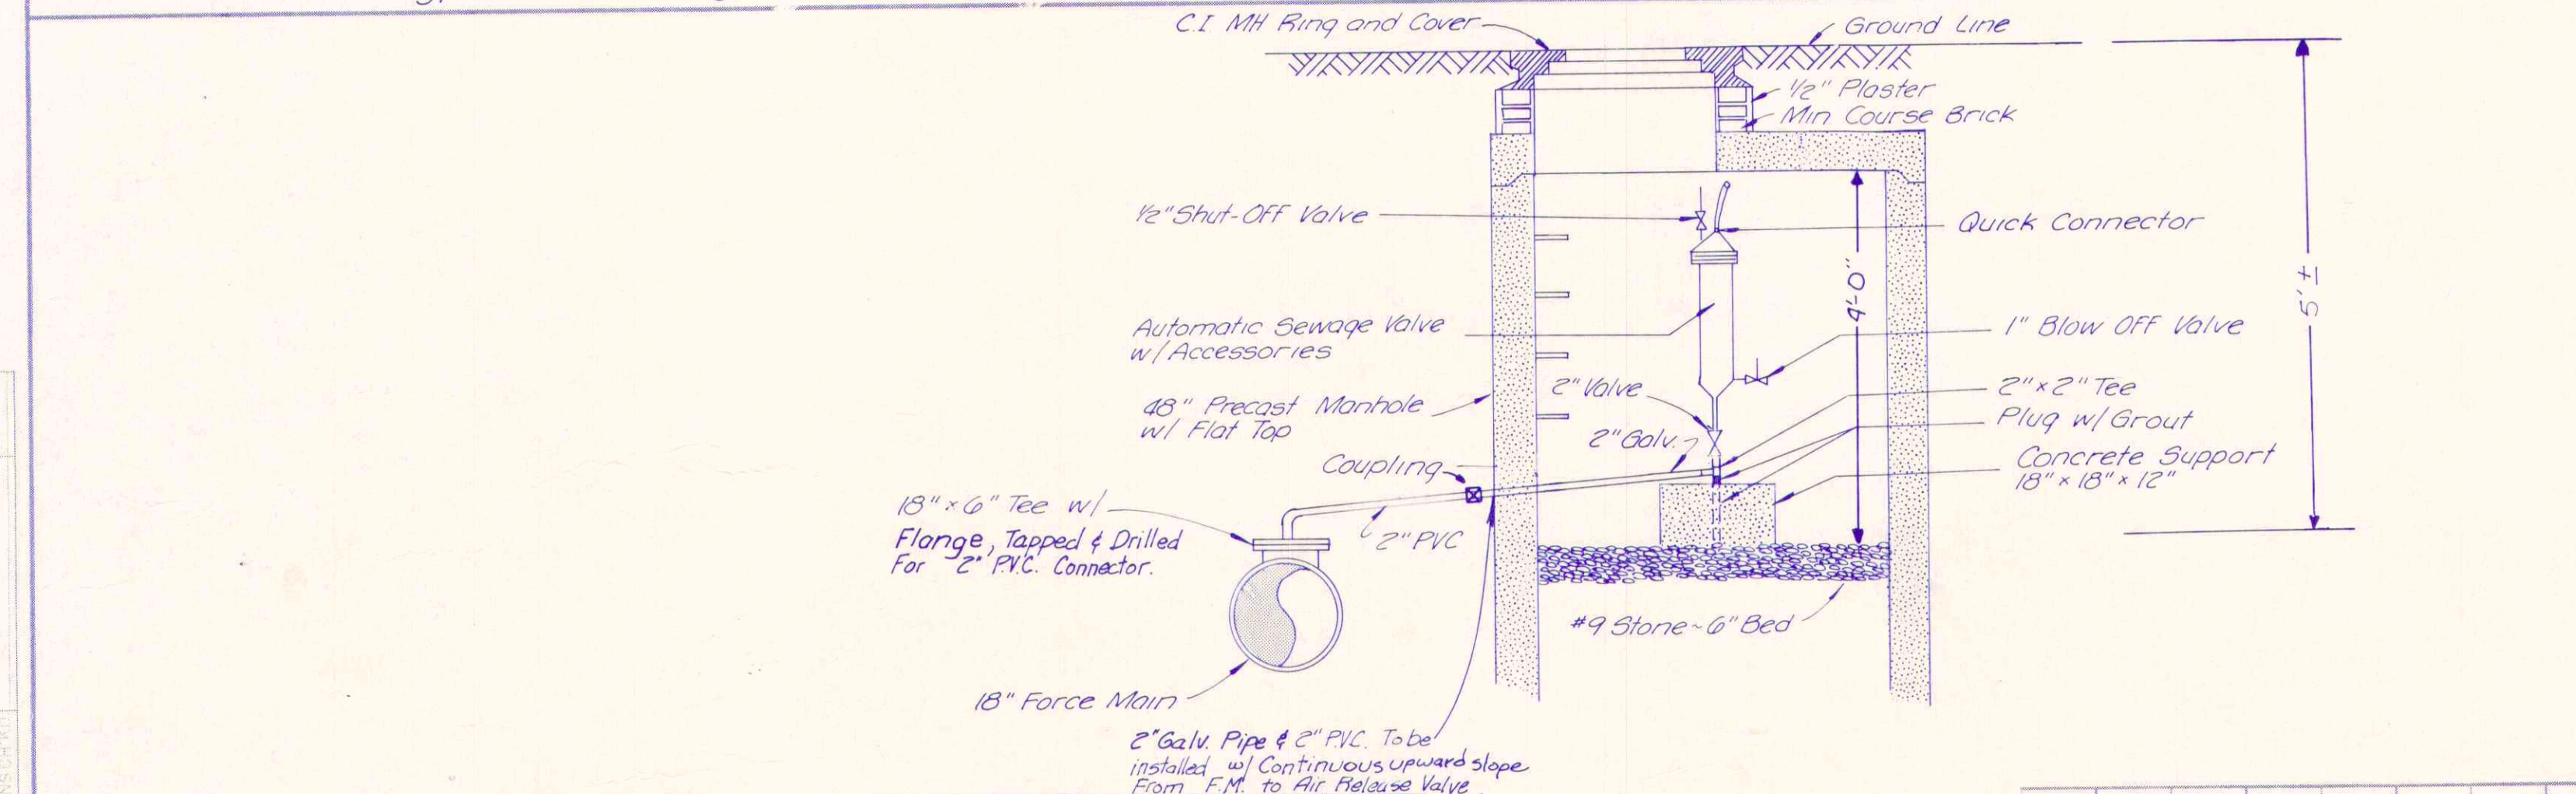
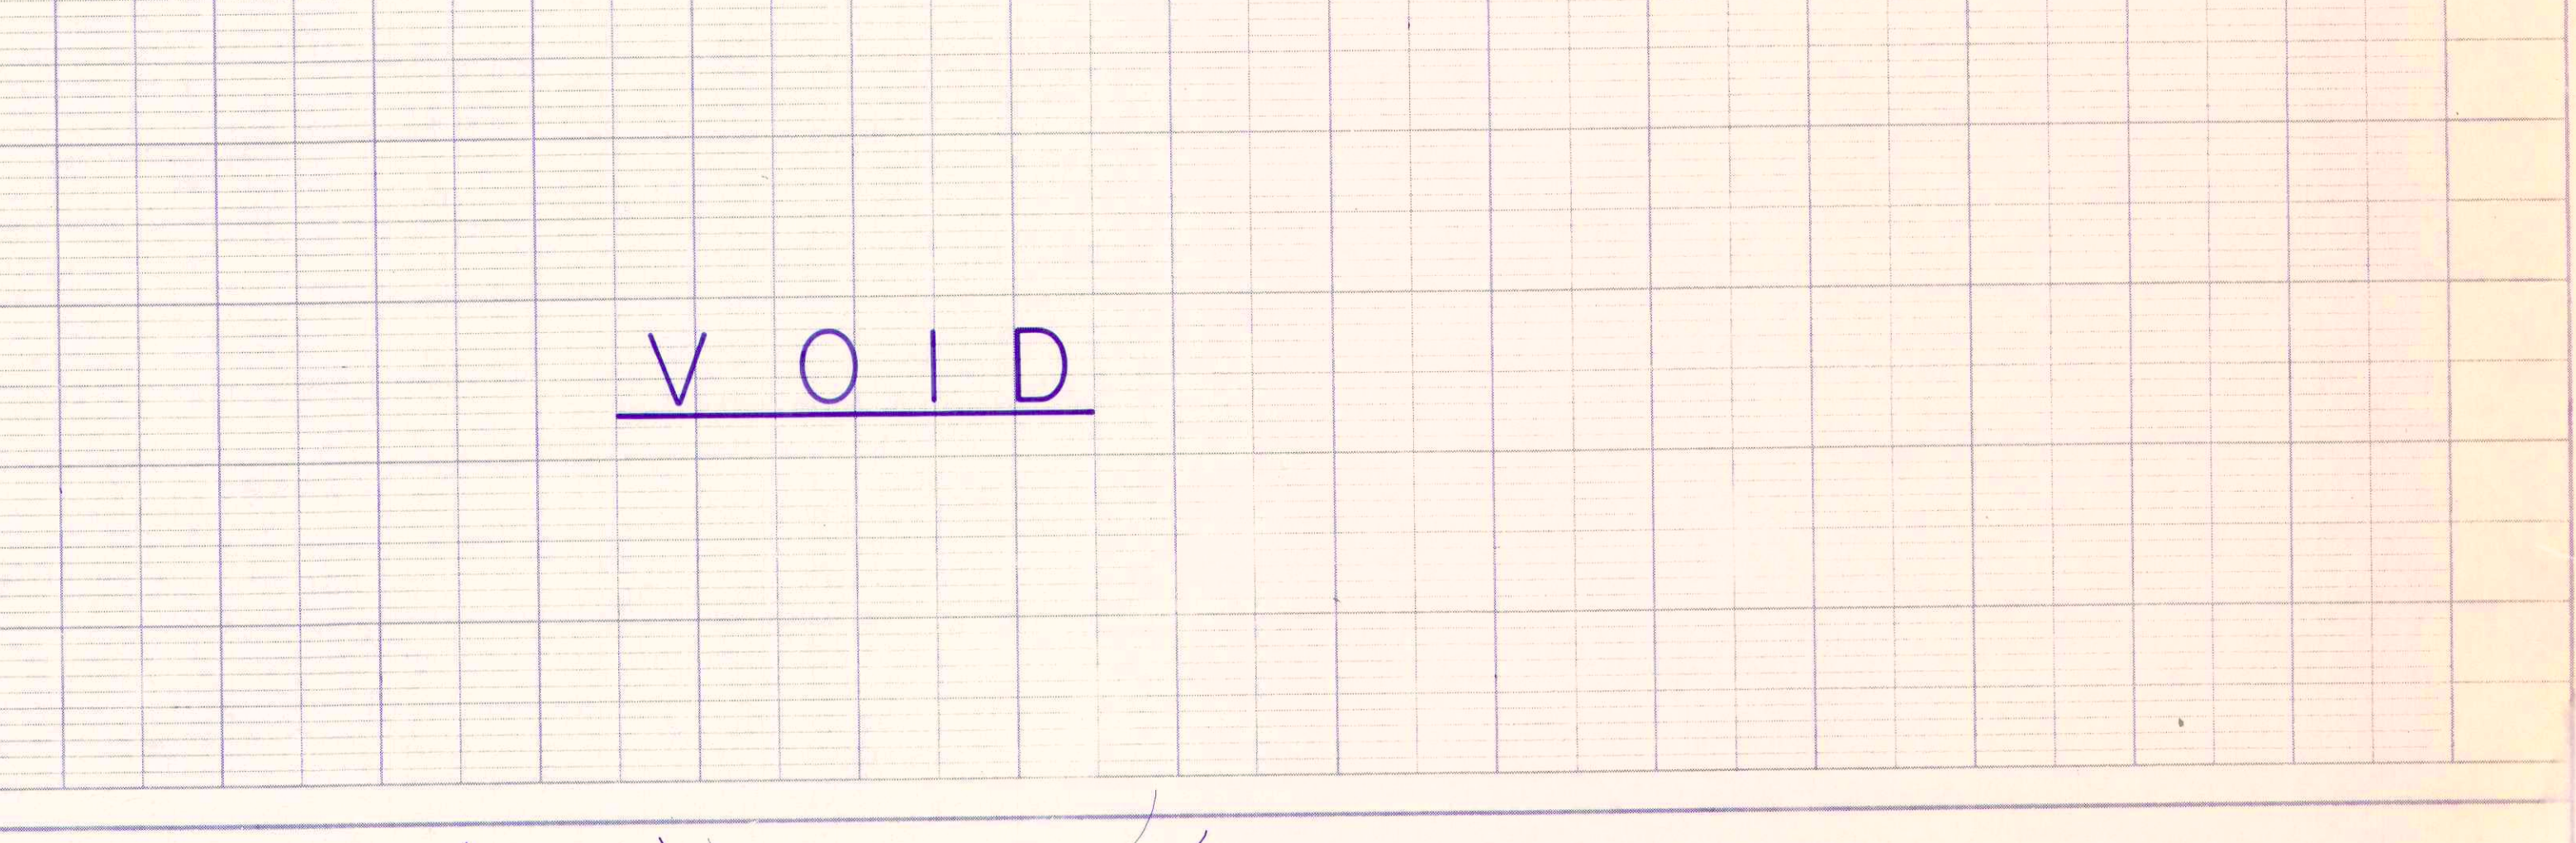
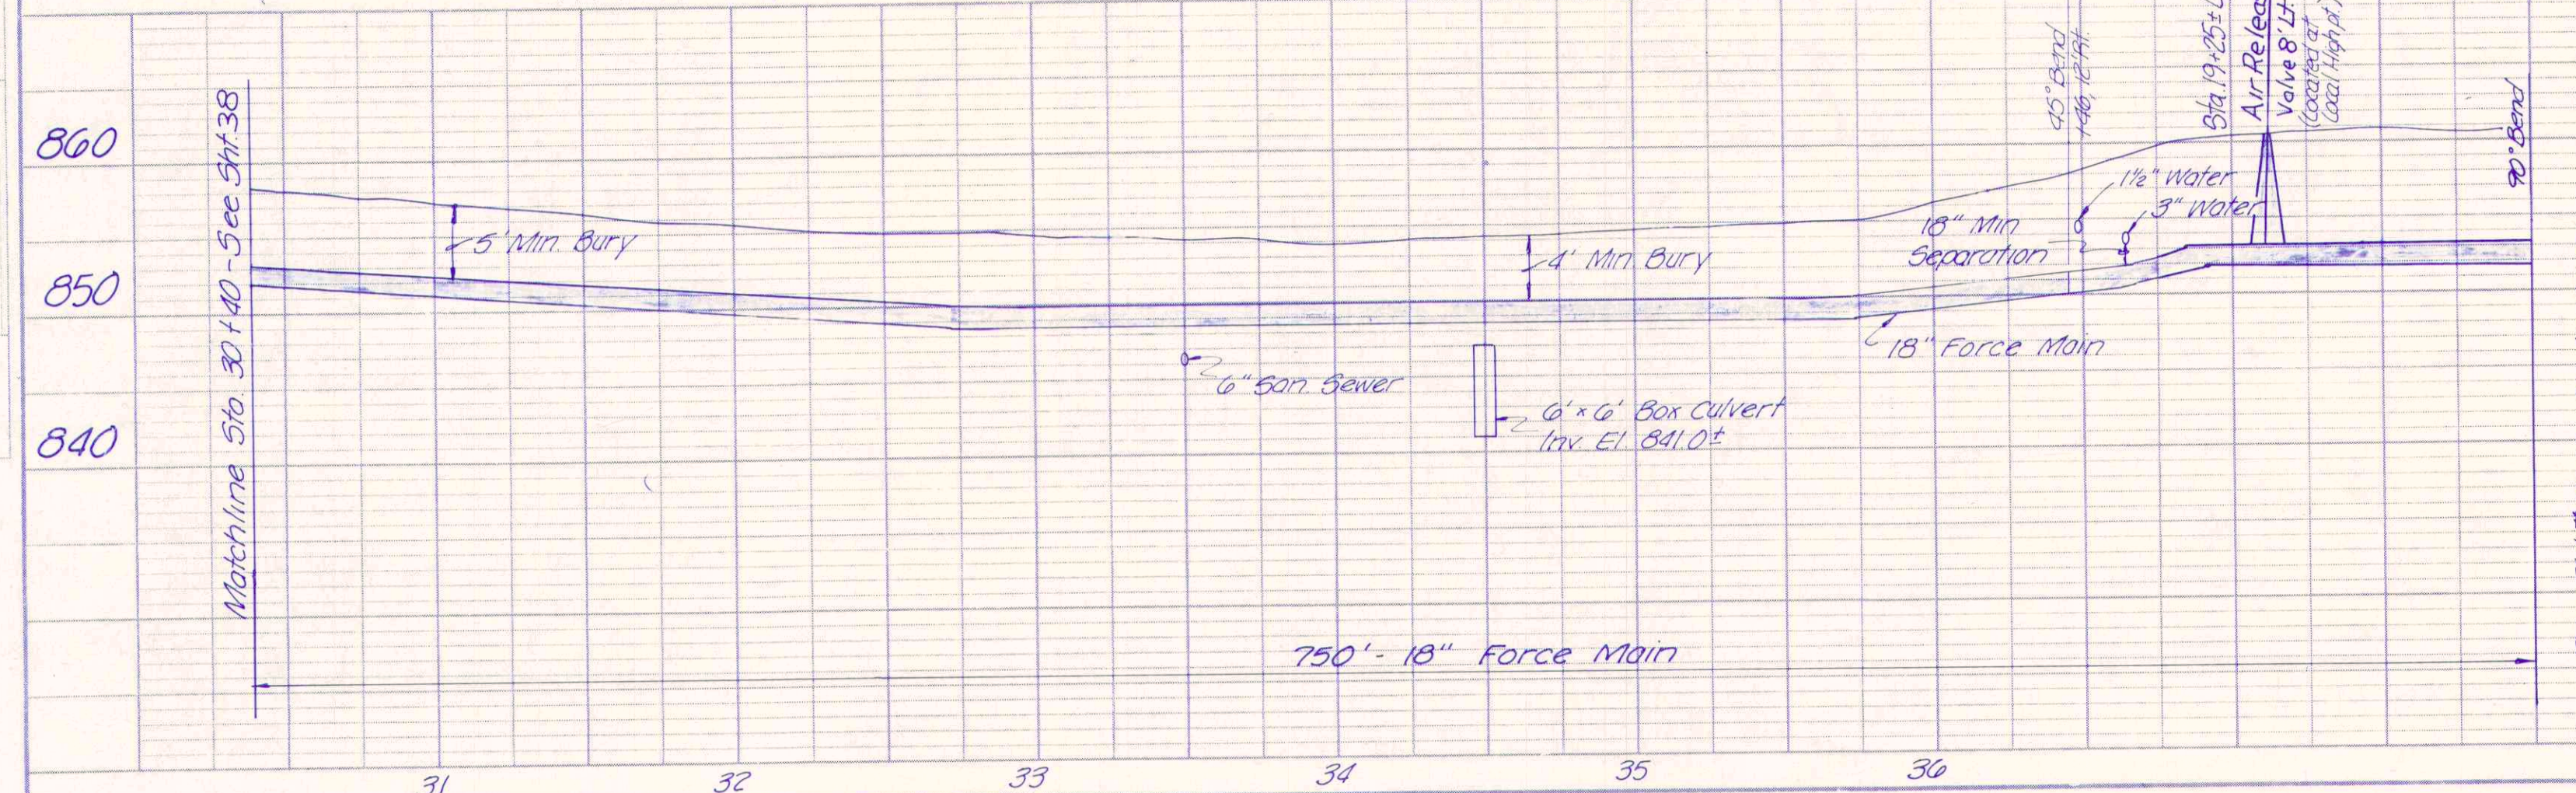
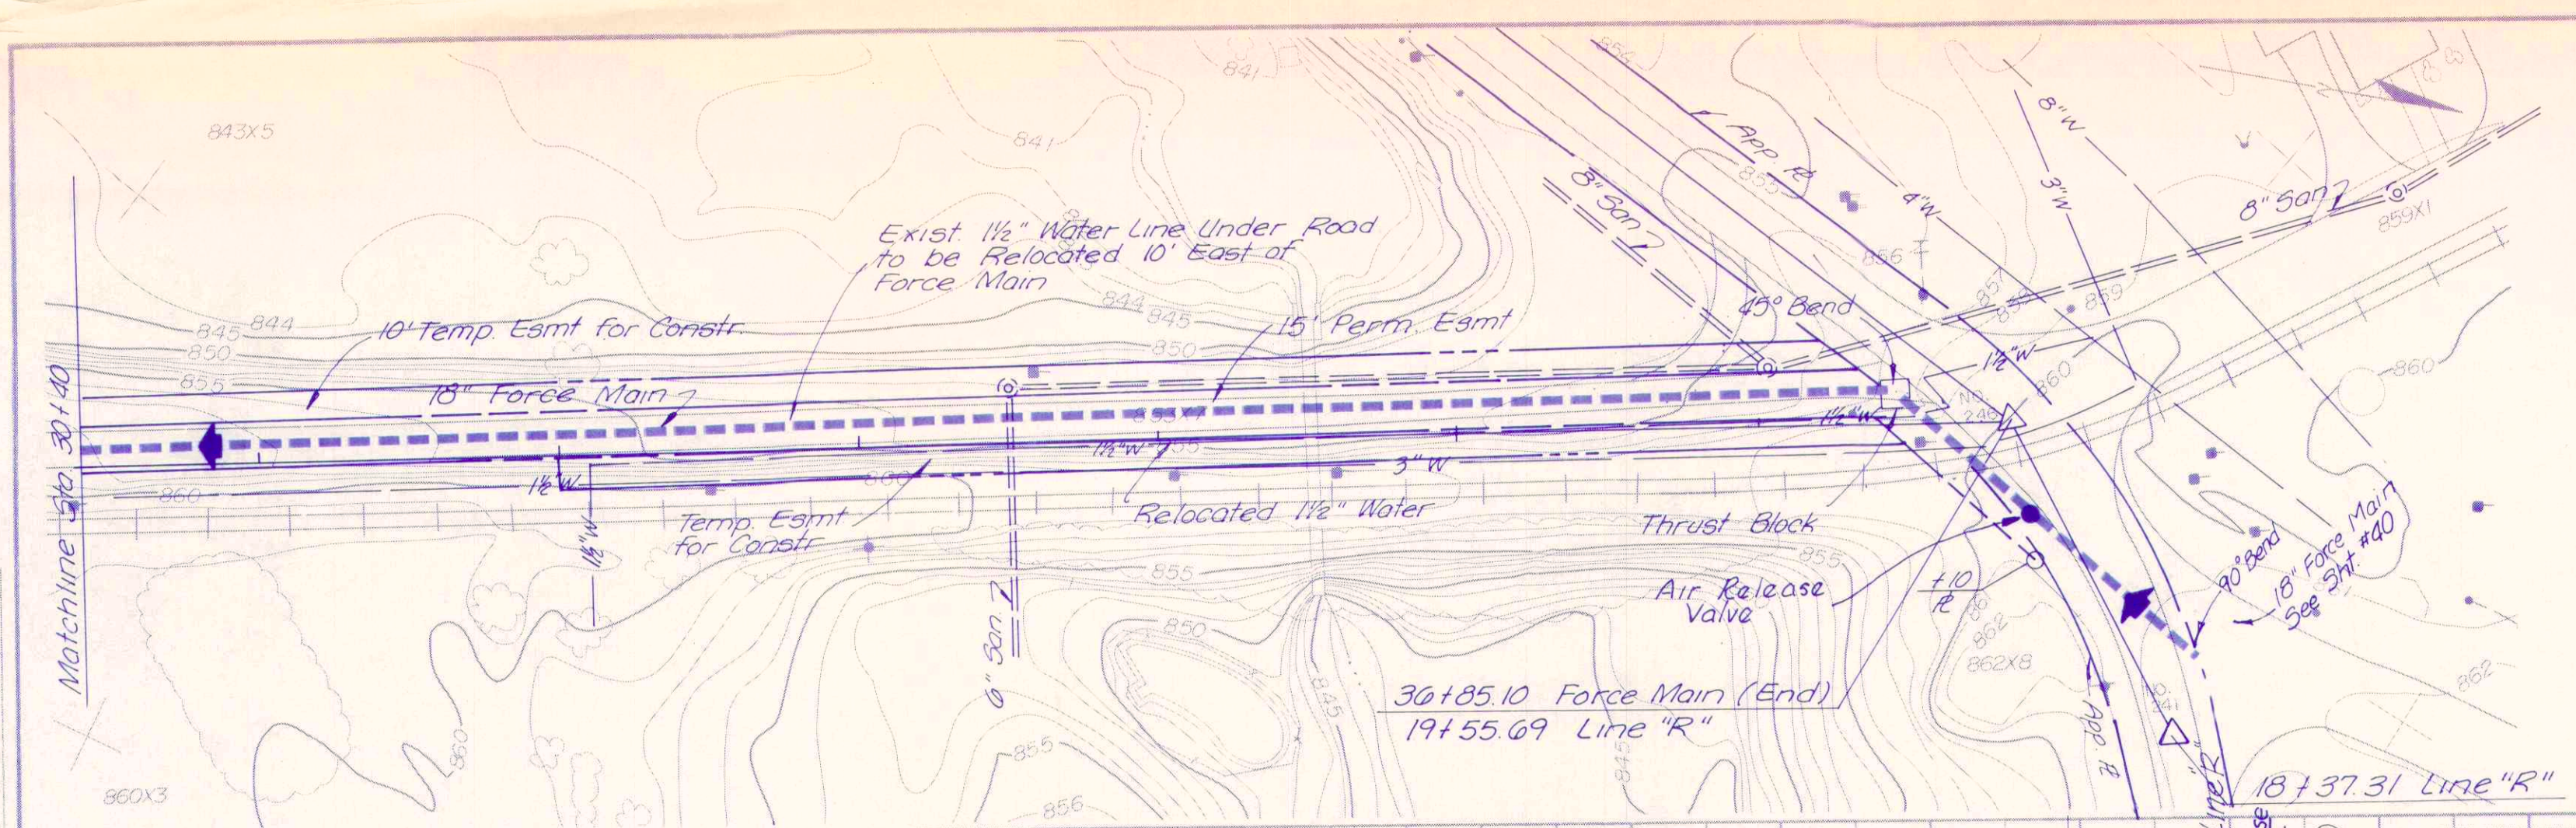
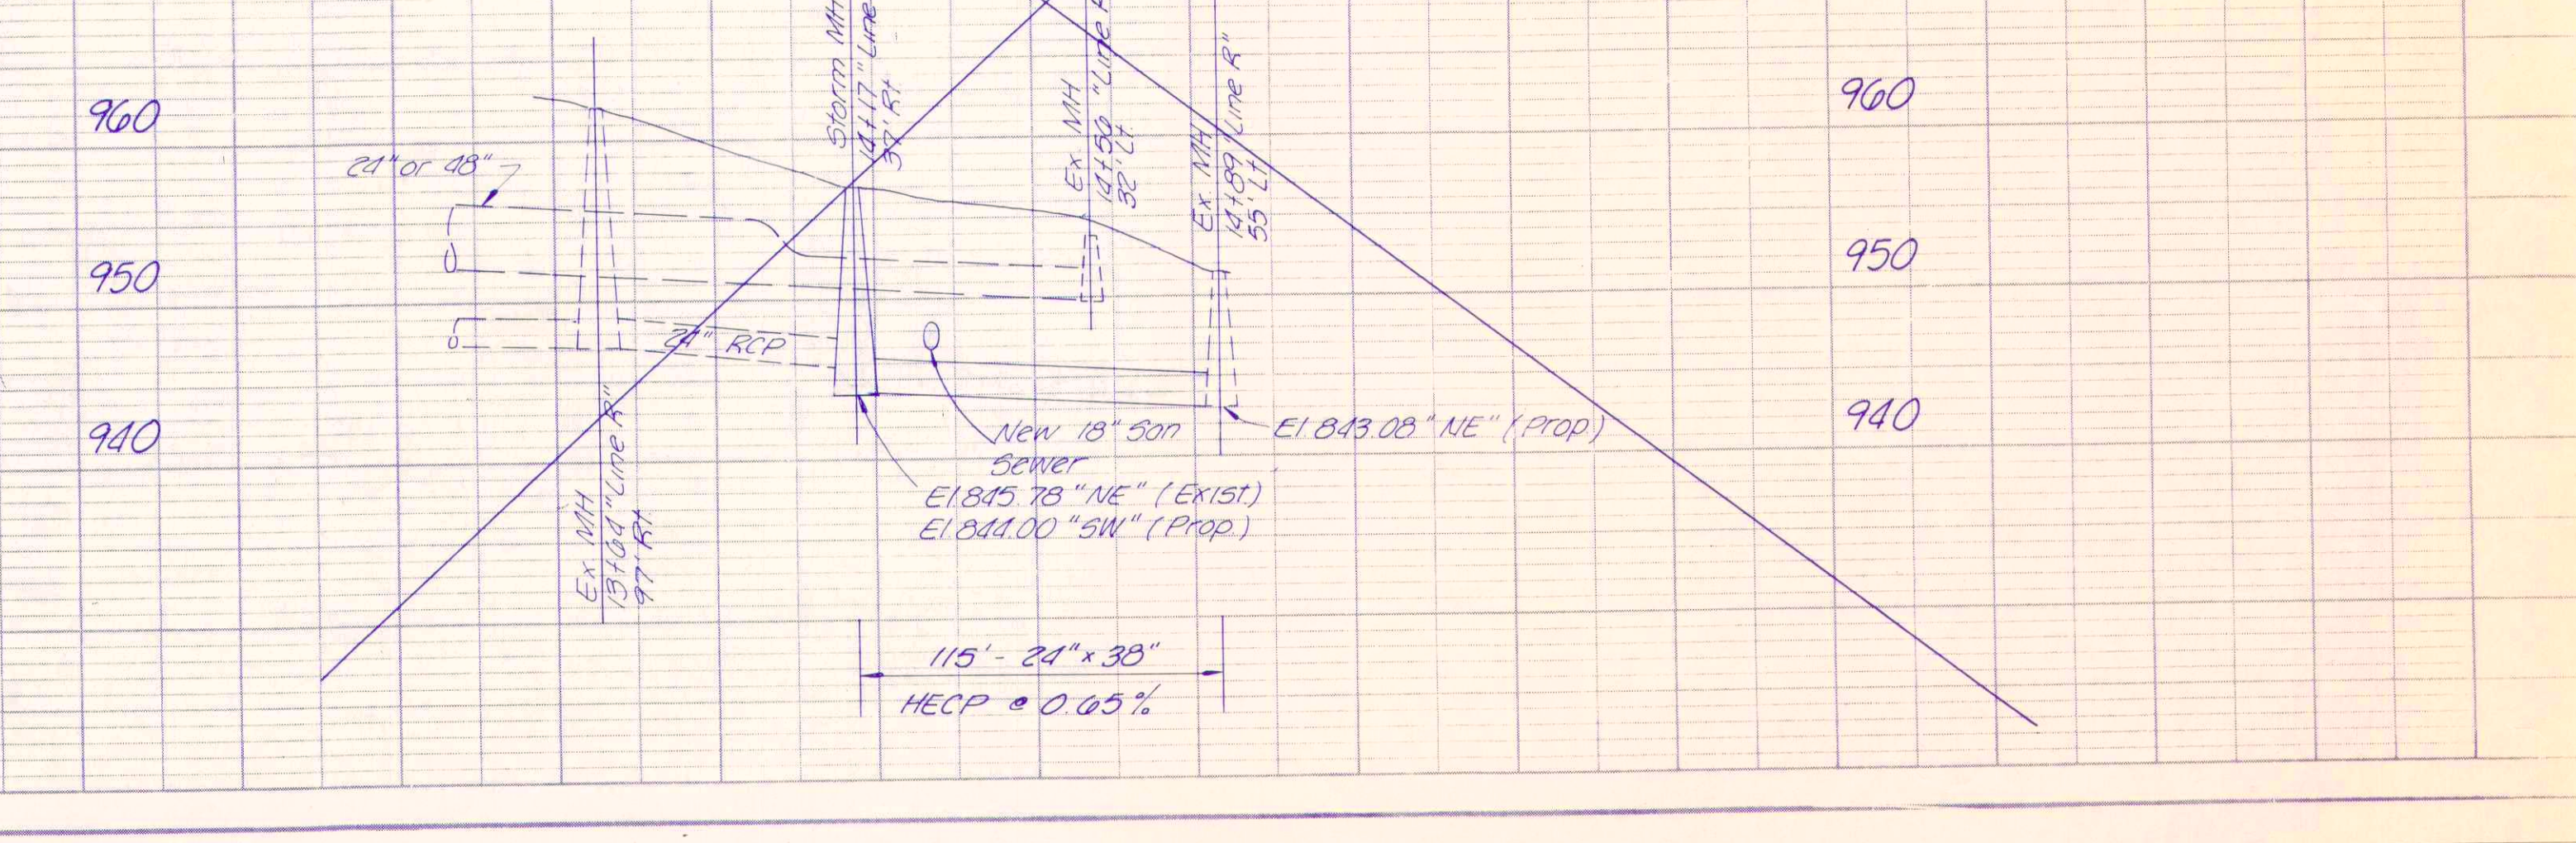
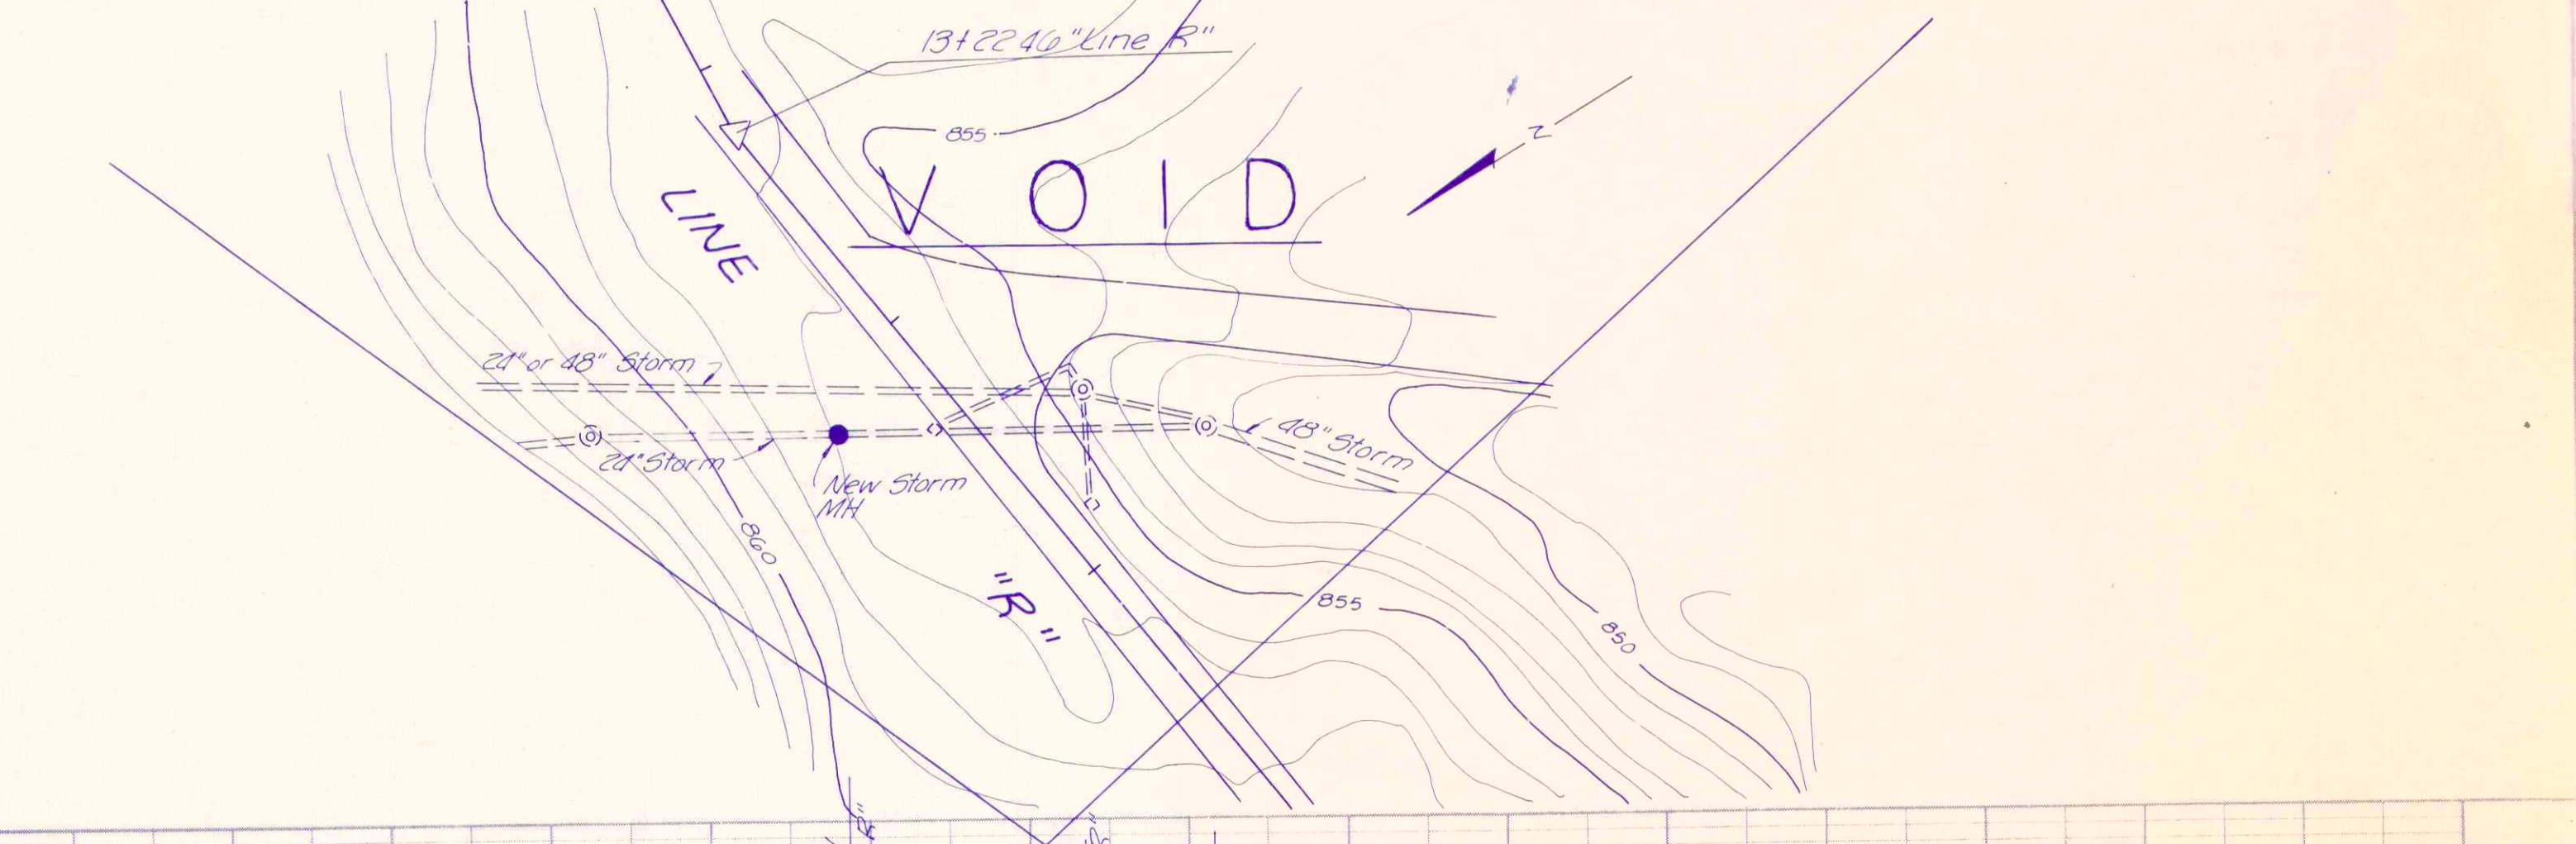


NOTE BOOK PLATTED & REVISIONS
 NO. 1 2 3 100
 NO. 1 2 3 100
 NO. 1 2 3 100



REMOTE FORCE MAIN
 AIR RELEASE
 No Scale



RECORD DRAWING