


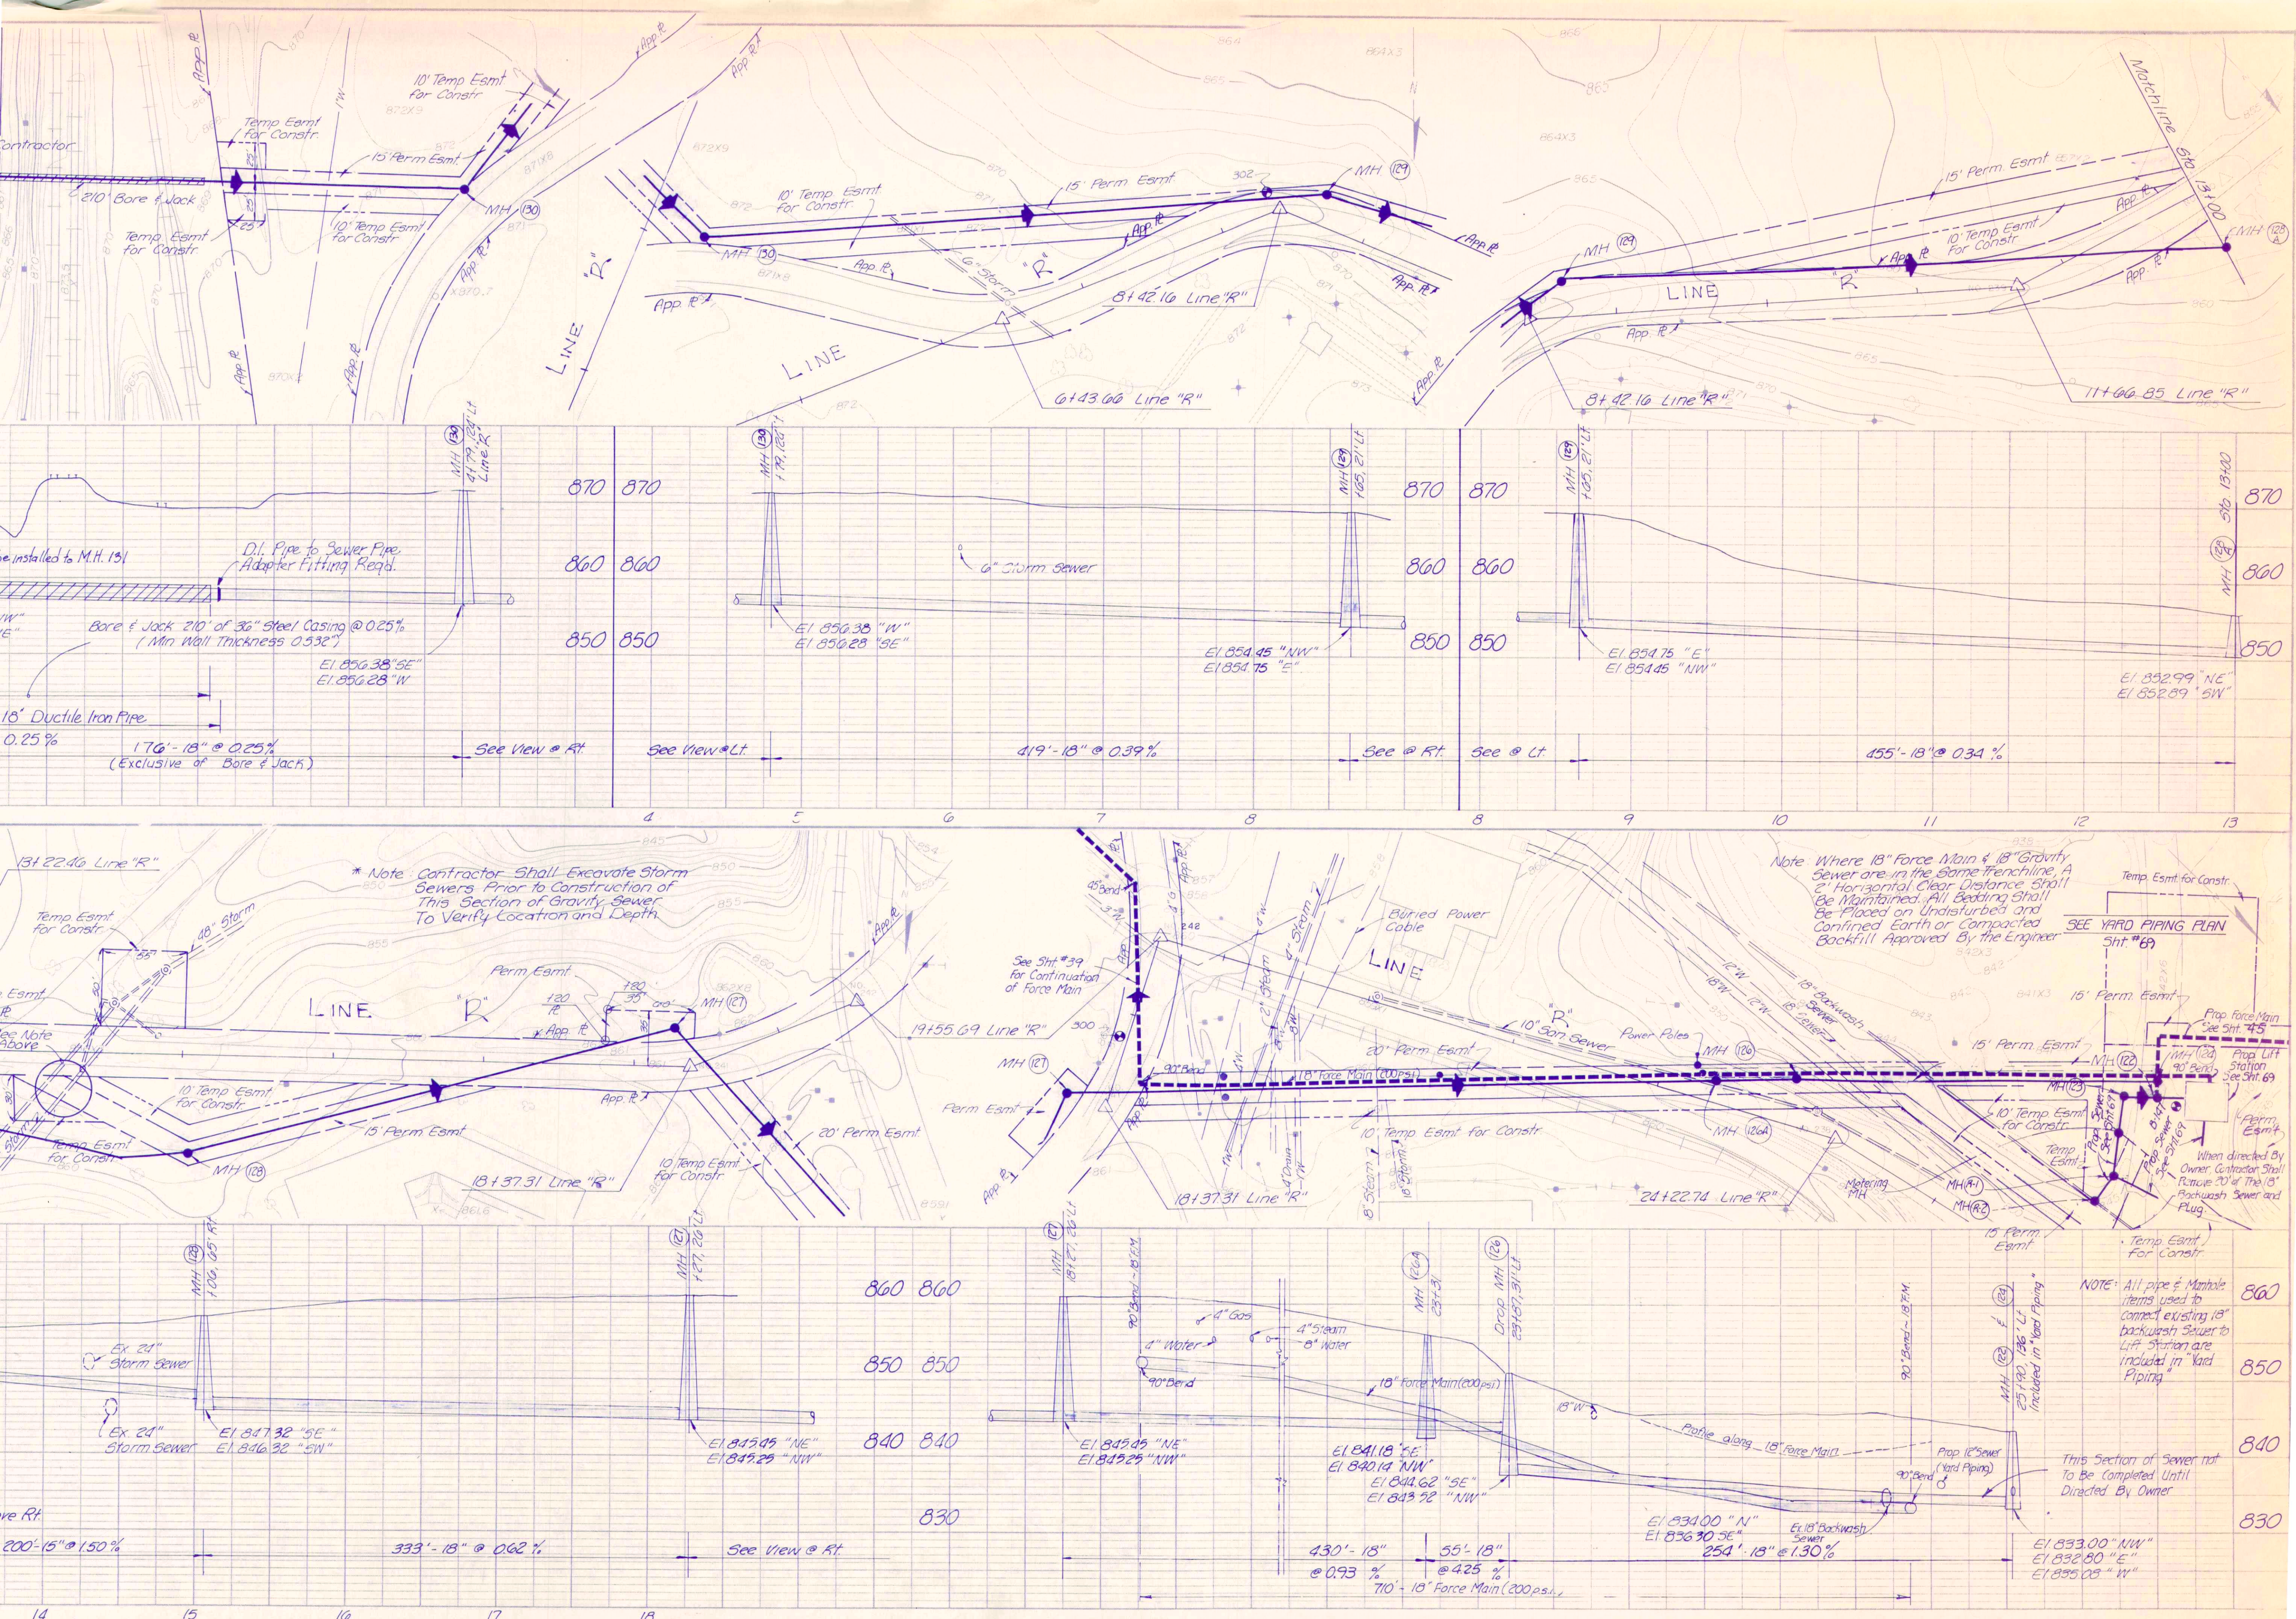

REVISED 3-19-84
CHANGED PERM. R/W TO
PERM ESMT AROUND LEFT
STATION

RECORD DRAWING

**18" GRAVITY SEWER ~ REFORMATORY INTERCEPTOR
18" FORCE MAIN ~ REFORMATORY ROAD**
FALL CREEK R.W.D. PLAN & PROFILE SHEET
HORIZ. 1"=50' BEAM, LONGEST & NEFF, INC.
VERT. 1"=10' CONSULTING ENGINEERS
INDIANAPOLIS, INDIANA