
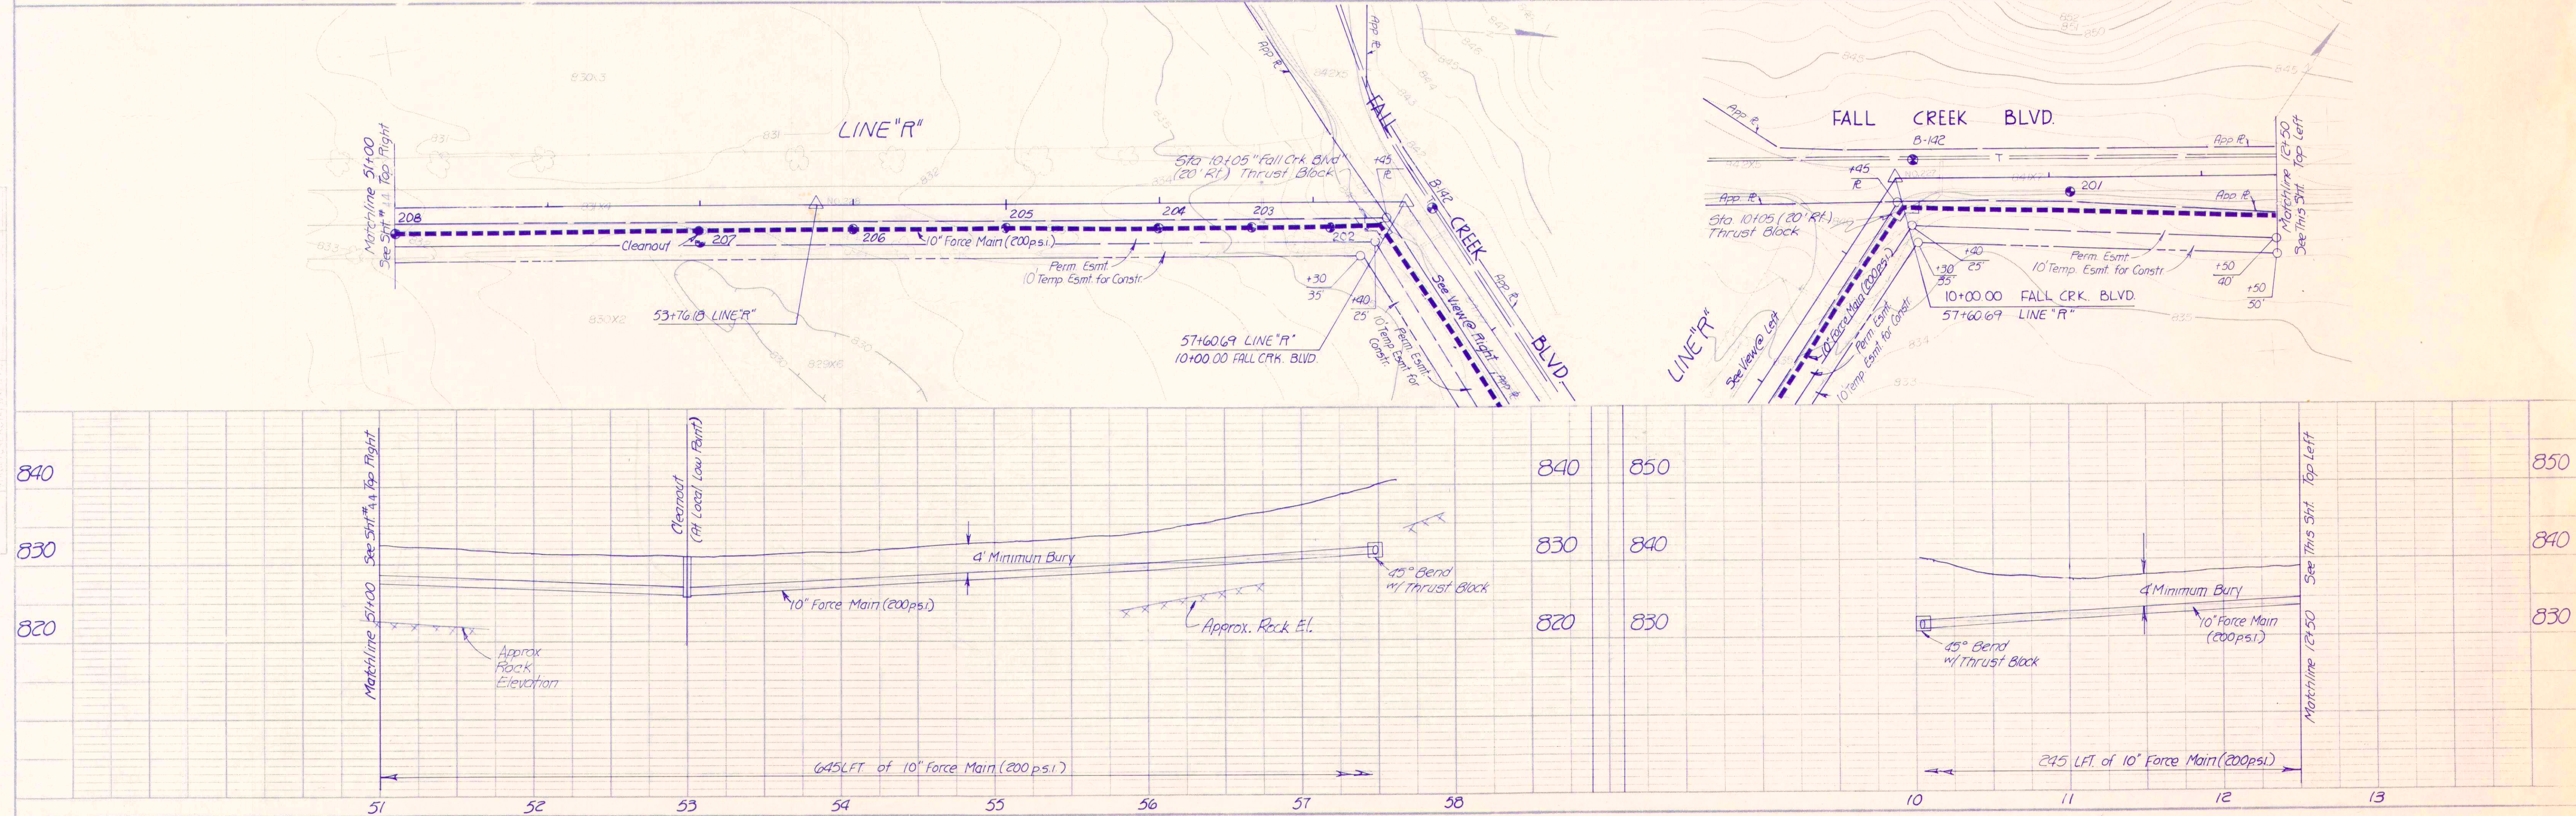


PLAN	DATE	NO.
	BY	NO.
	CHECKED	NO.
	NOTED	NO.

PROFILE	DATE	NO.
	BY	NO.
	CHECKED	NO.
	NOTED	NO.

Panhandle Eastern Pipeline Gas Lines.
Contractor to Use Extreme Caution in This Area
Lines Are in Their Approximate Location.
Contractor Must Verify Depth & Location with
Gas Corp. Before Construction.

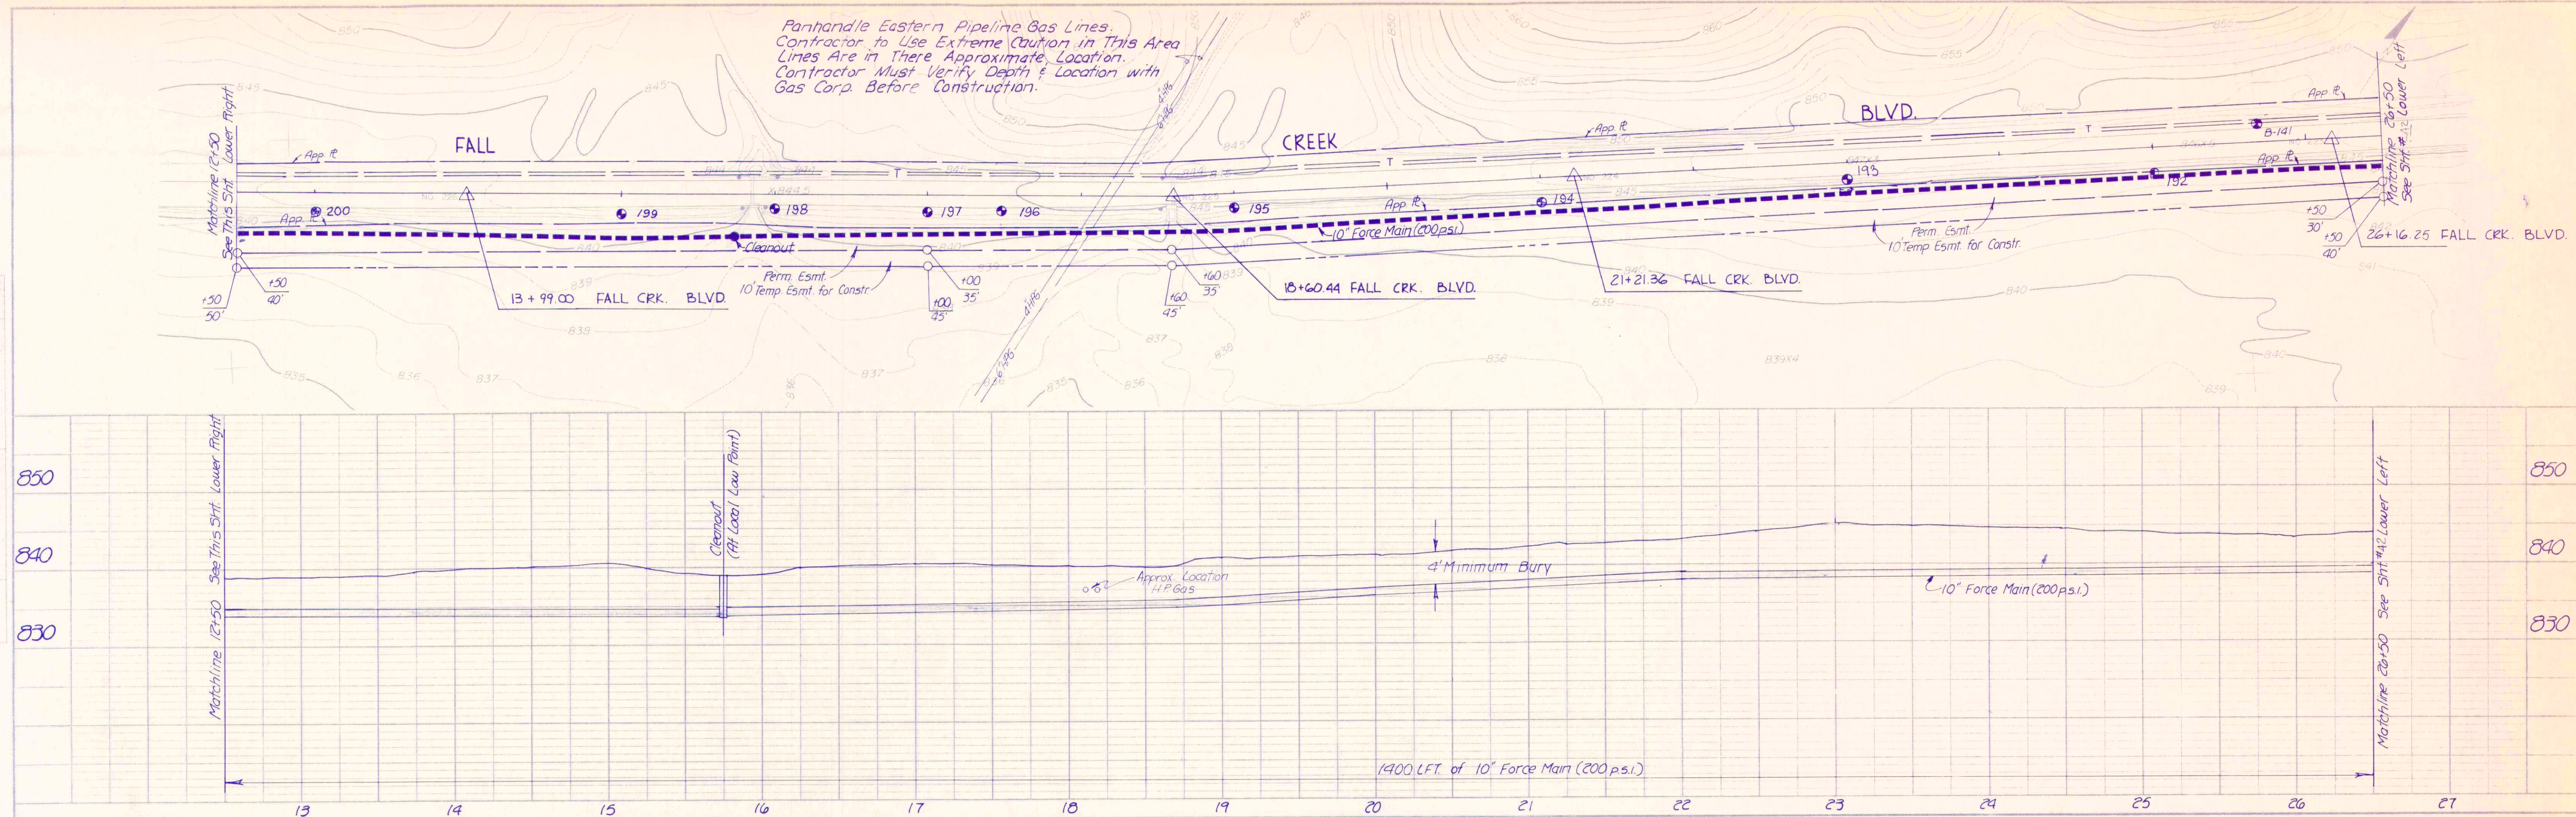

RECORD DRAWING



FALL CREEK BLVD/ LINE "R"		SHEET 43
FALL CREEK R.W.D. PLAN & PROFILE		
HORIZ. 1"=50'	BEAM, LONGEST & NEFF, INC. CONSULTING ENGINEERS INDIANAPOLIS, INDIANA	