


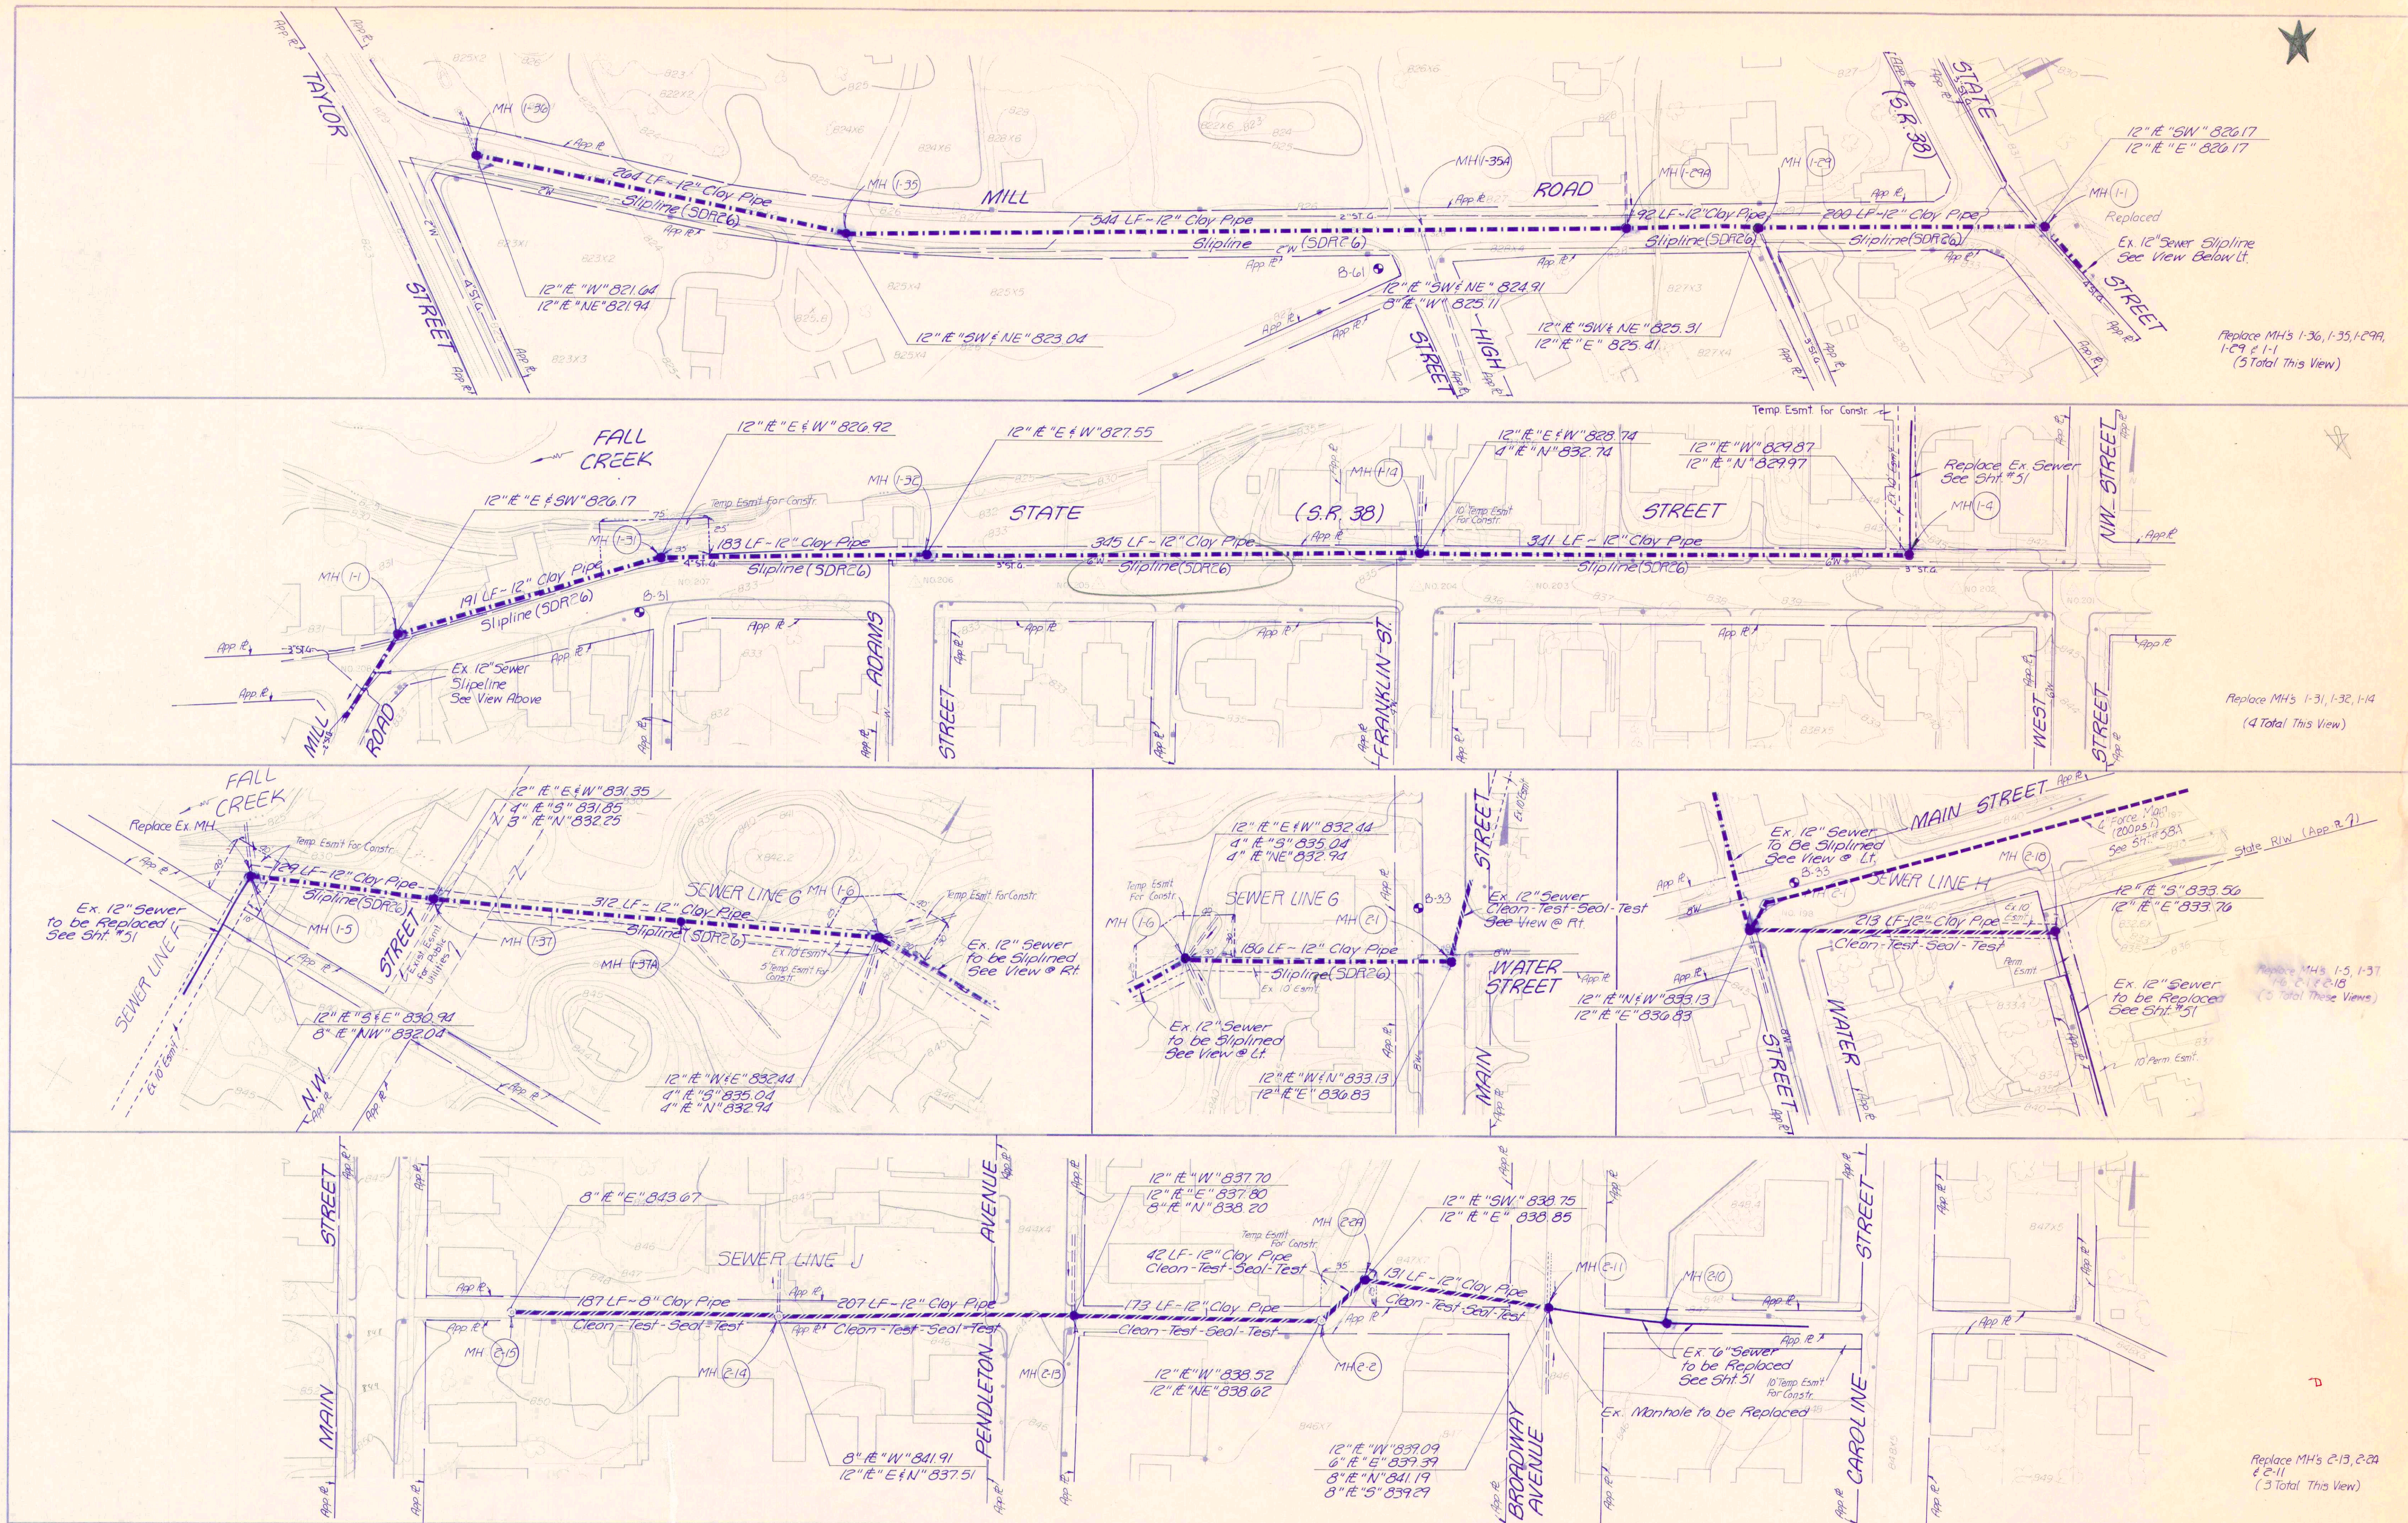

RECORD DRAWING

MILL ROAD, STATE STREET, SEWER LINE G SEWER LINE H, SEWER LINE J	
FALL CREEK R.W.D. PLAN	
HORIZ. 1"=50'	BEAM, LONGEST & NEFF, INC. CONSULTING ENGINEERS INDIANAPOLIS, INDIANA
VERT. 1"=10'	
SLOPE / CLEAN-TEST-SEAL-TEST	

SHEET

60