


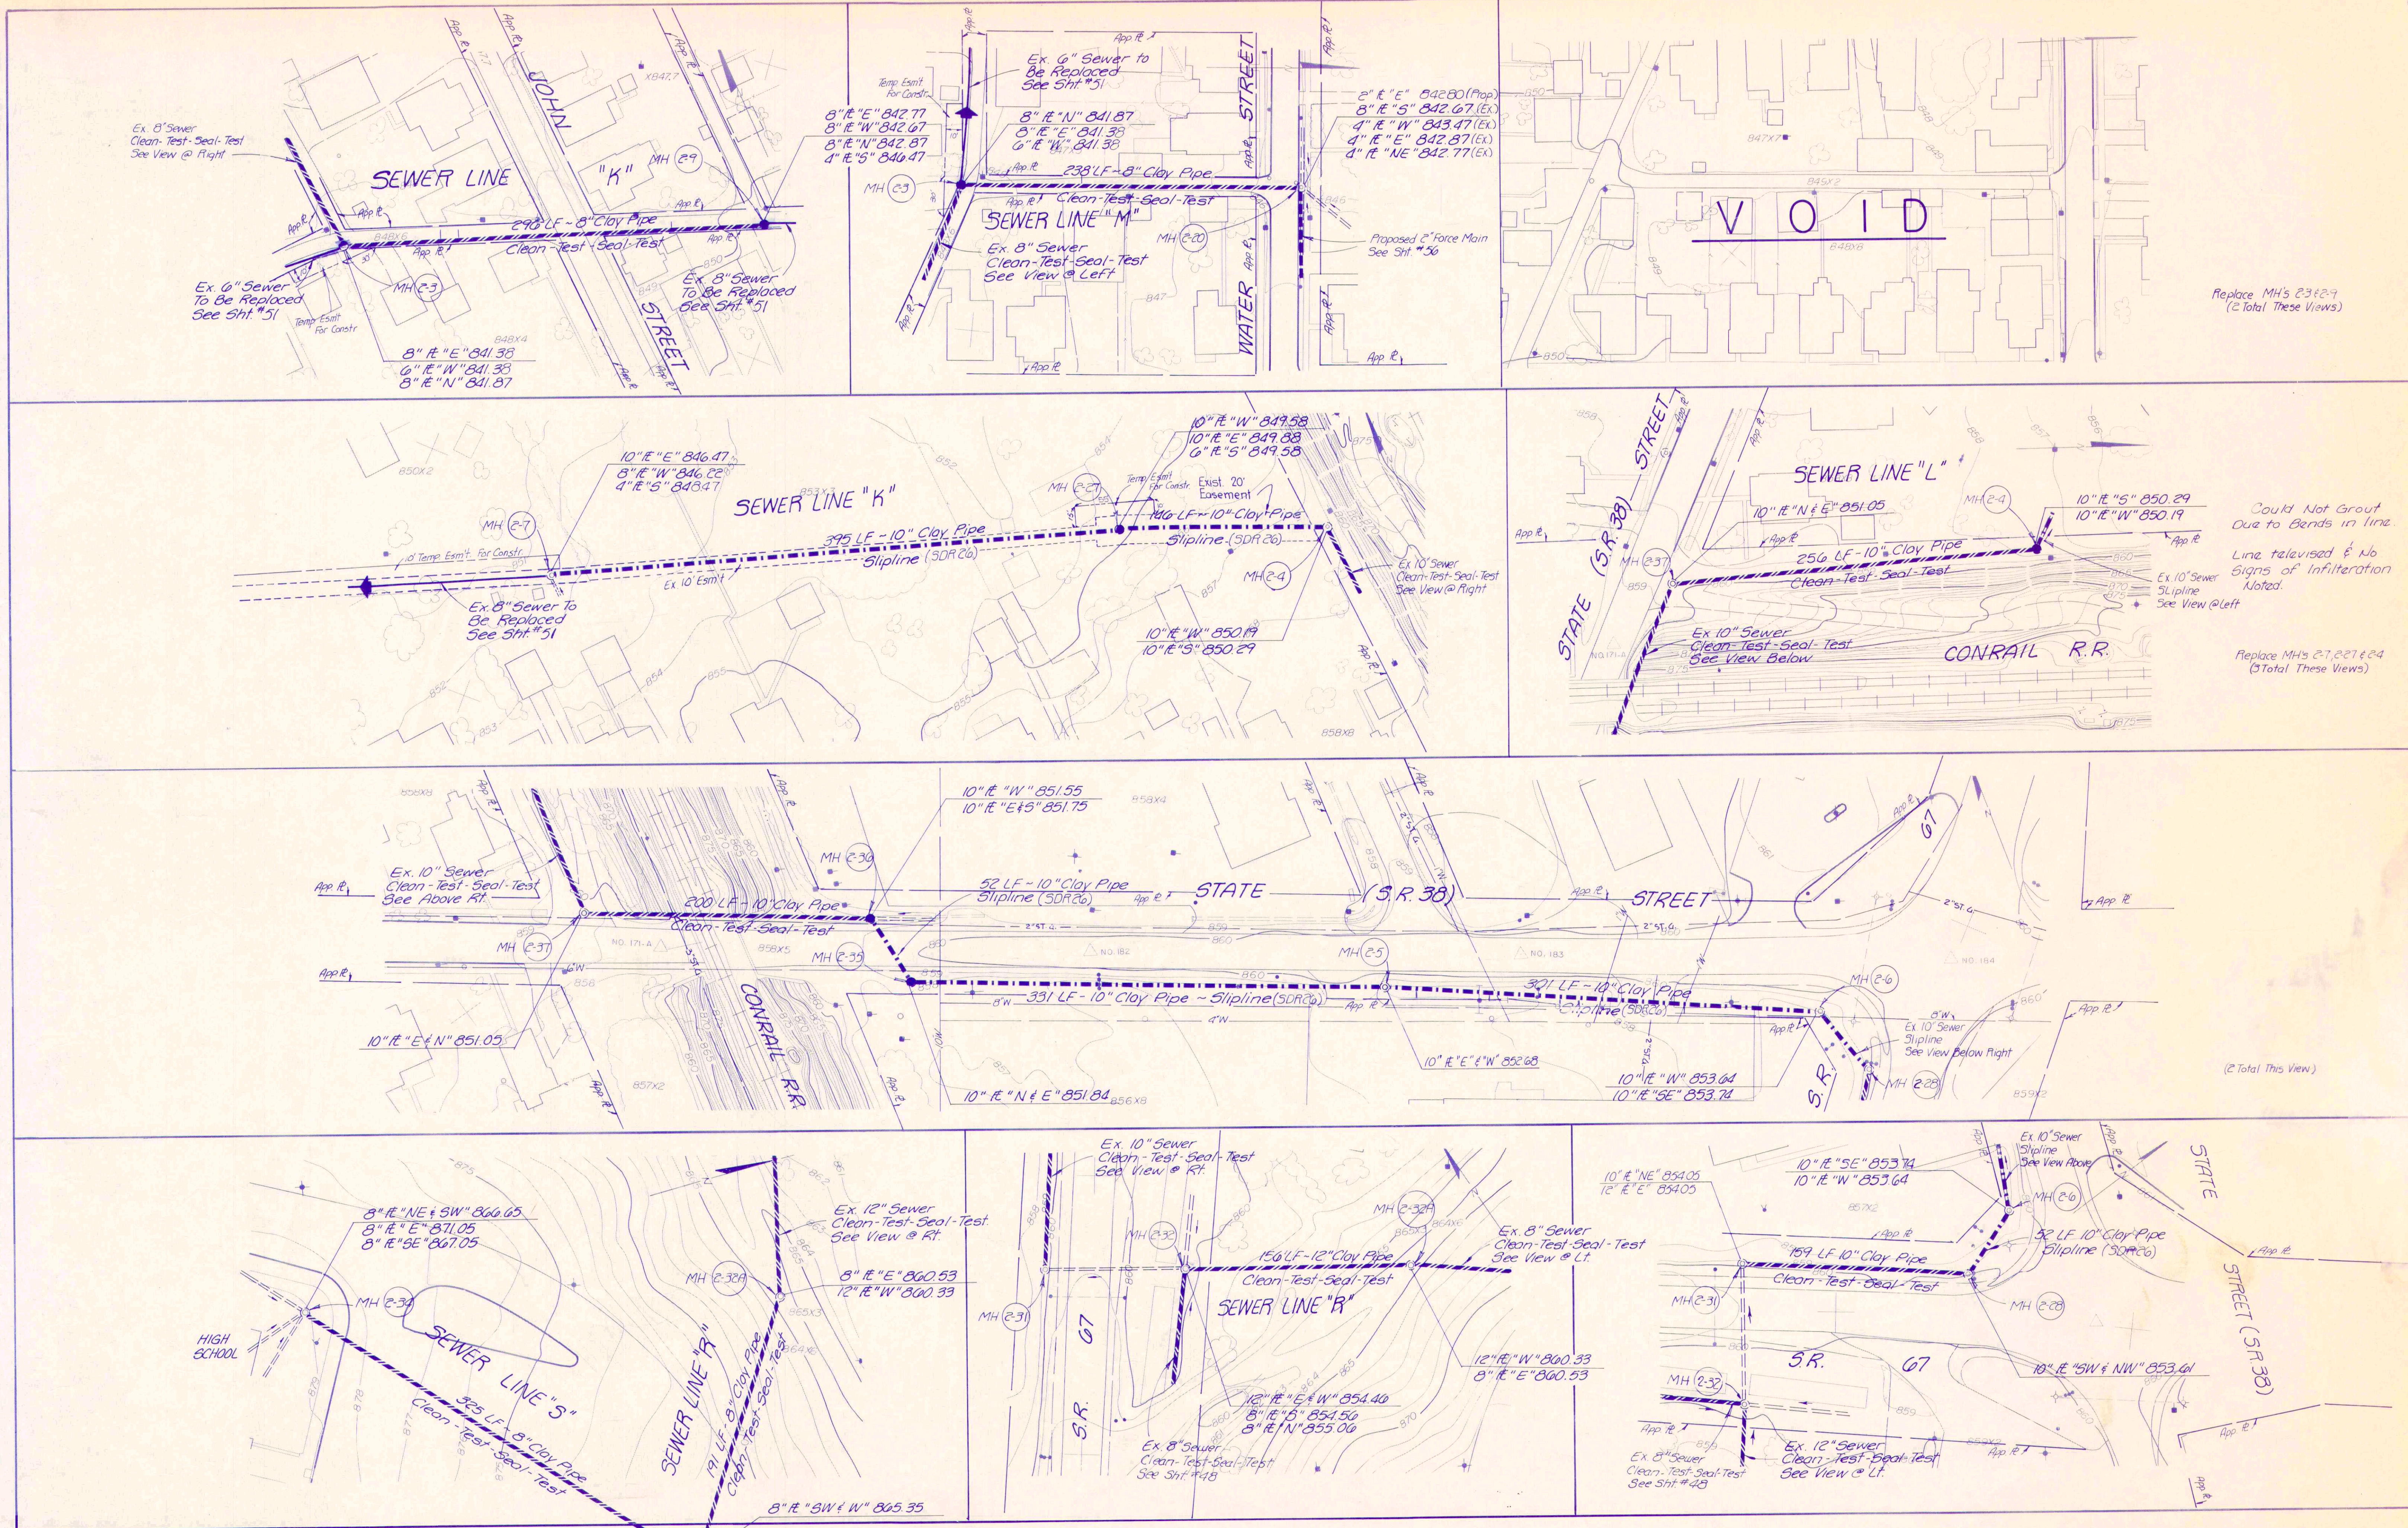

RECORD DRAWING

SEWER LINE "K", SEWER LINE "M", SEWER LINE "L", STATE ST, SEWER LINE "S", SEWER LINE "R" & SR.67 FALL CREEK R.W.D. PLAN		SHEET
HORIZ. 1"=50'	BEAM, LONGEST & NEFF, INC. CONSULTING ENGINEERS INDIANAPOLIS, INDIANA	47
VERT. 1"=10'	SLOPIELINE / CLEAN-TEST-SEAL-TEST	