




RECORD DRAWING

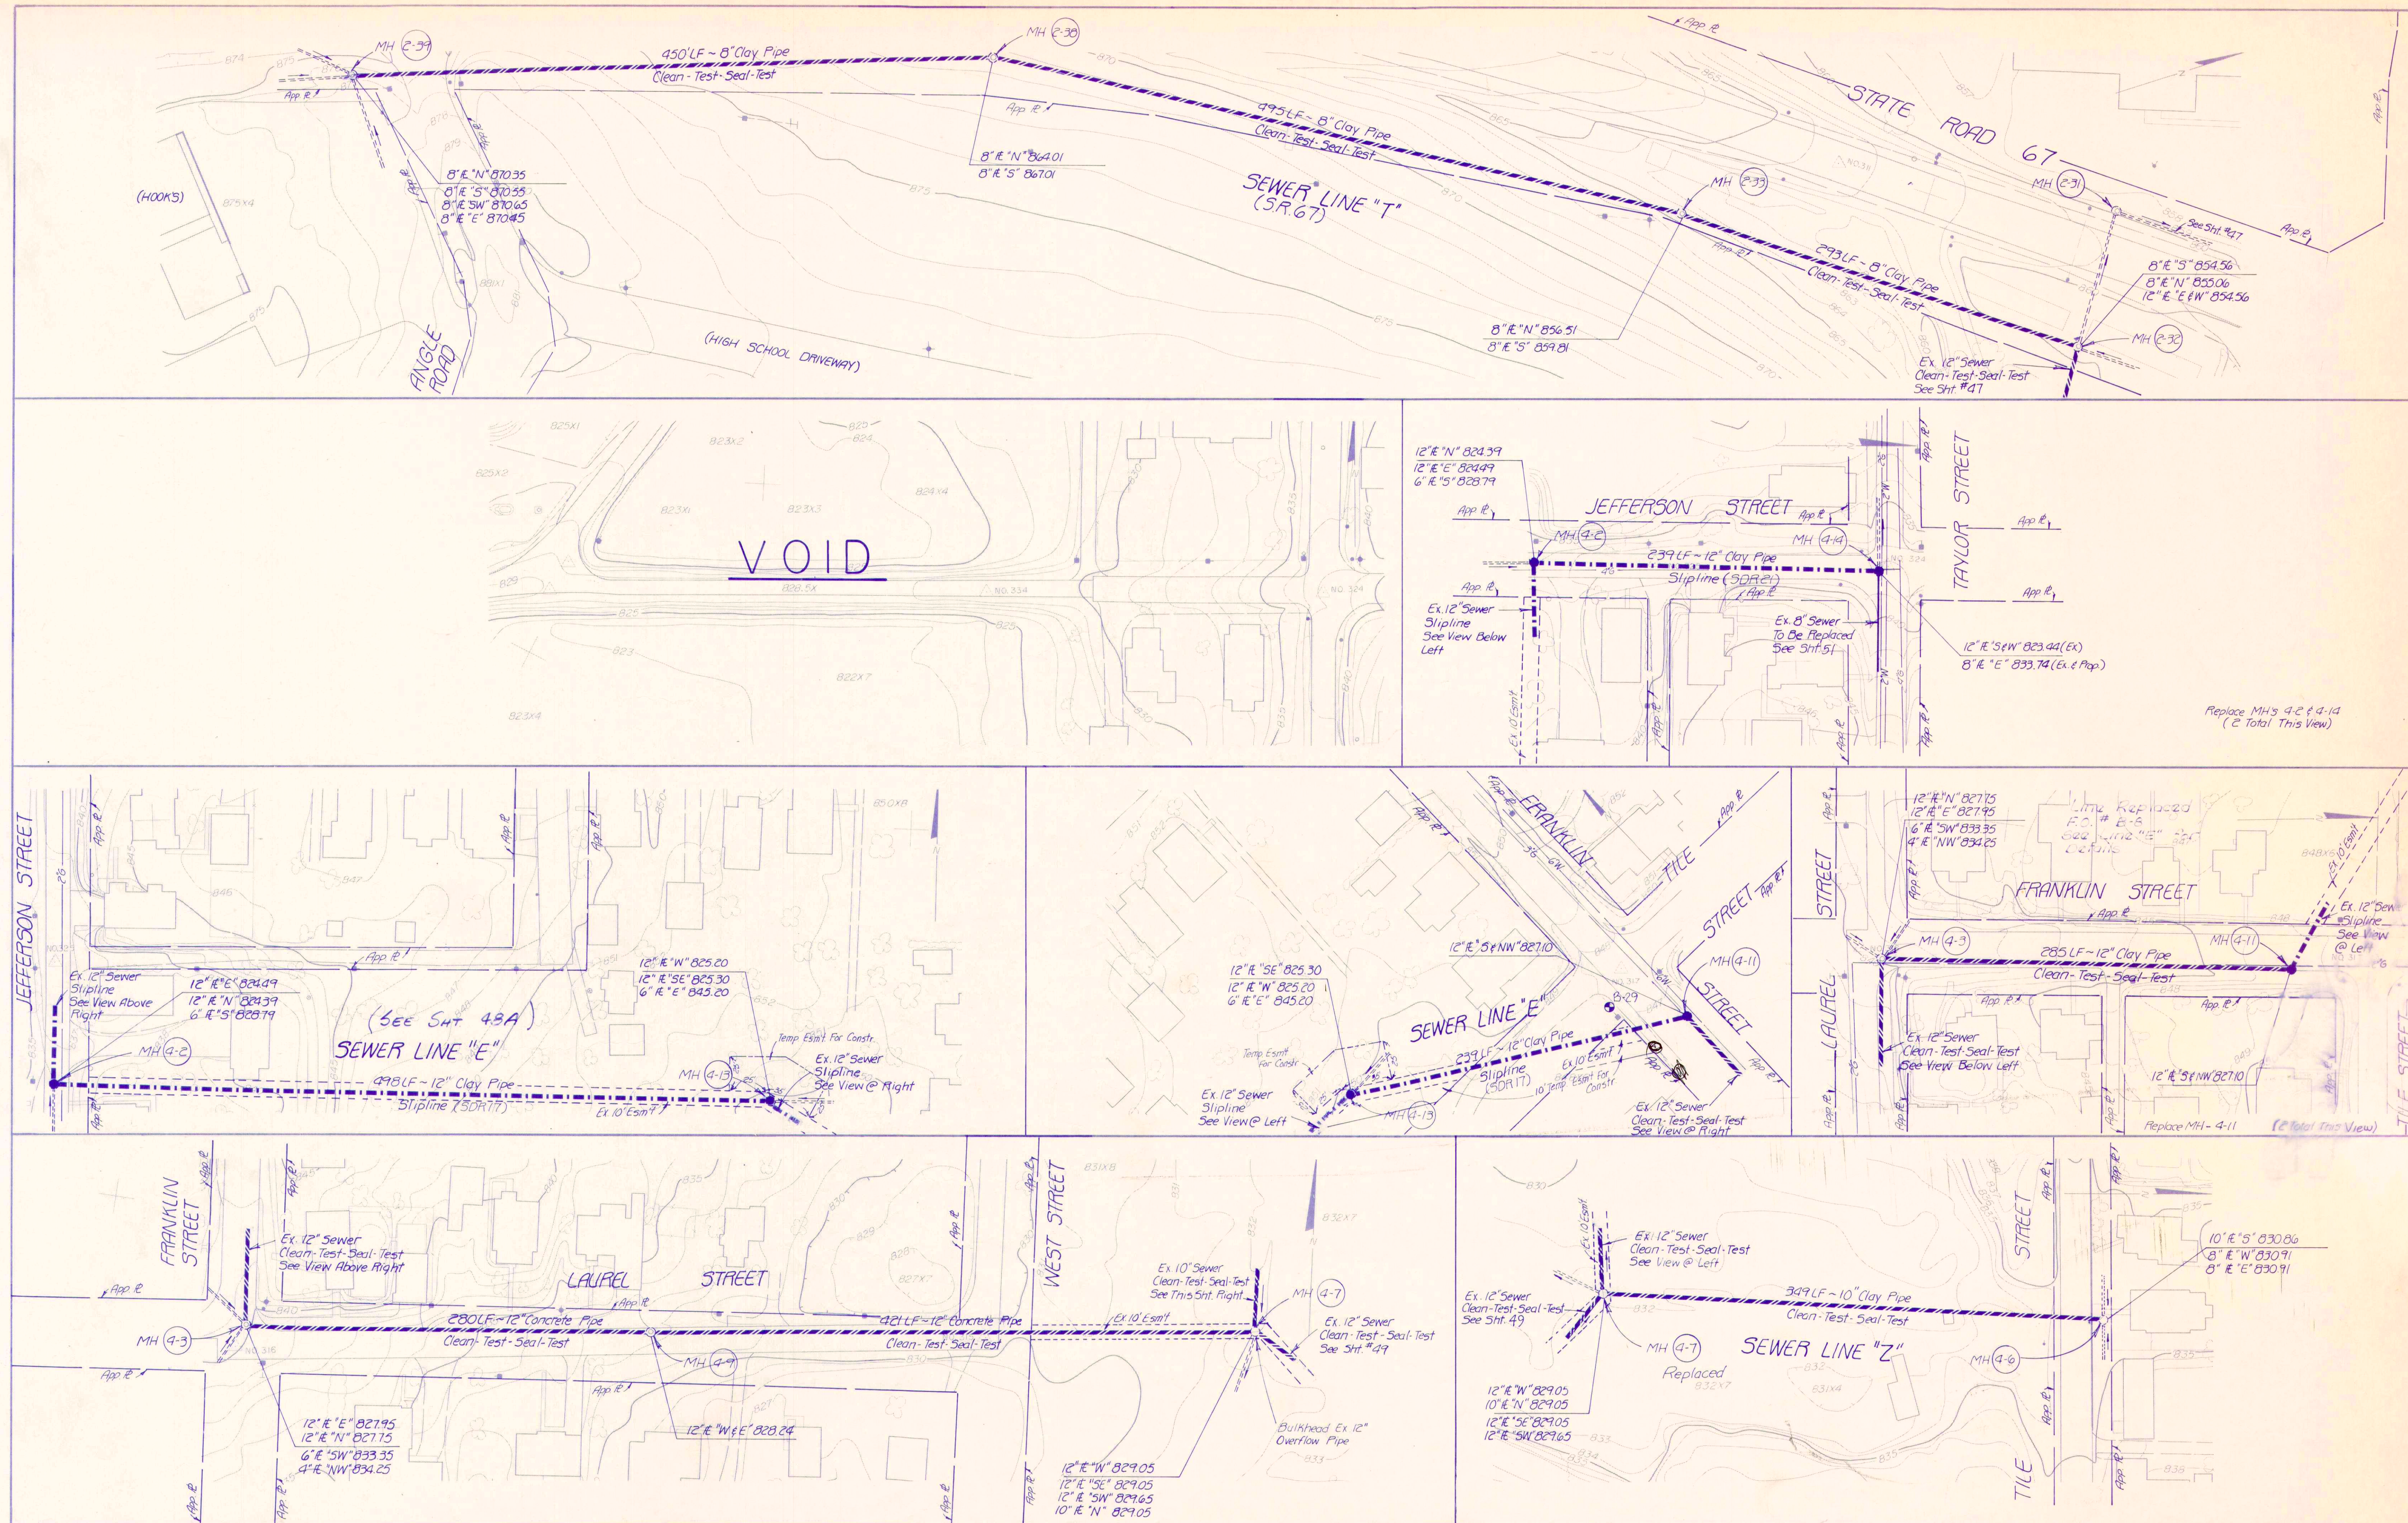

SEWER LINE "T", JEFFERSON ST., SEWER LINE "E", FRANKLIN ST., LAUREL ST., & SEWER LINE "Z"	
FALL CREEK R.W.D. PLAN	
HORIZ. 1"=50'	BEAM, LONGEST & NEFF, INC.
VERT. 1"=10'	CONSULTING ENGINEERS
	INDIANAPOLIS, INDIANA
SLOPIELINE / CLEAN-TEST-SEAL-TEST	
	SHEET 48