

PLAN	DATE	BY	CHECKED
	SURVEYED		
	NOTE BOOK		

PROFILE	DATE	BY	CHECKED
	SURVEYED		
	NOTE BOOK		

FEDERAL ROAD REGION NO.	STATE	PROJECT NO.	FISCAL YEAR	SHEET NO.	TOTAL SHEETS
5	IND.				

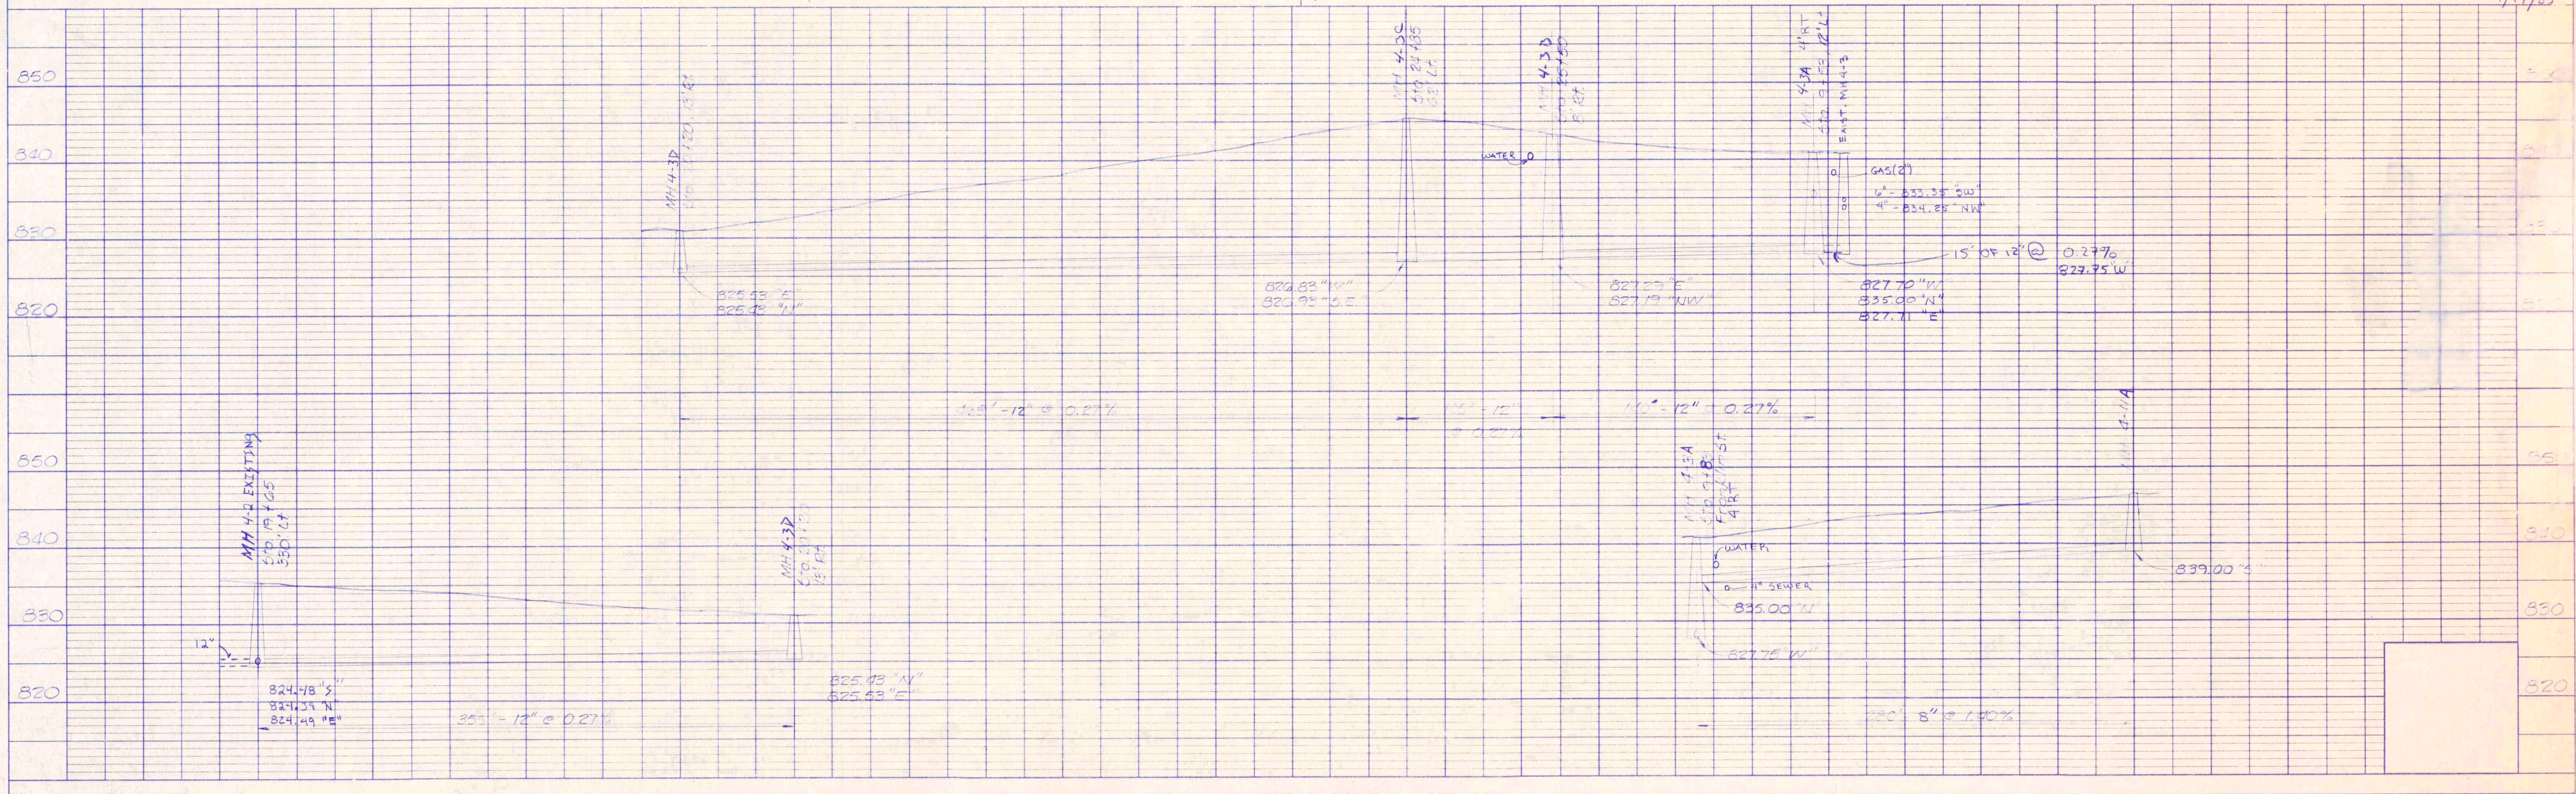
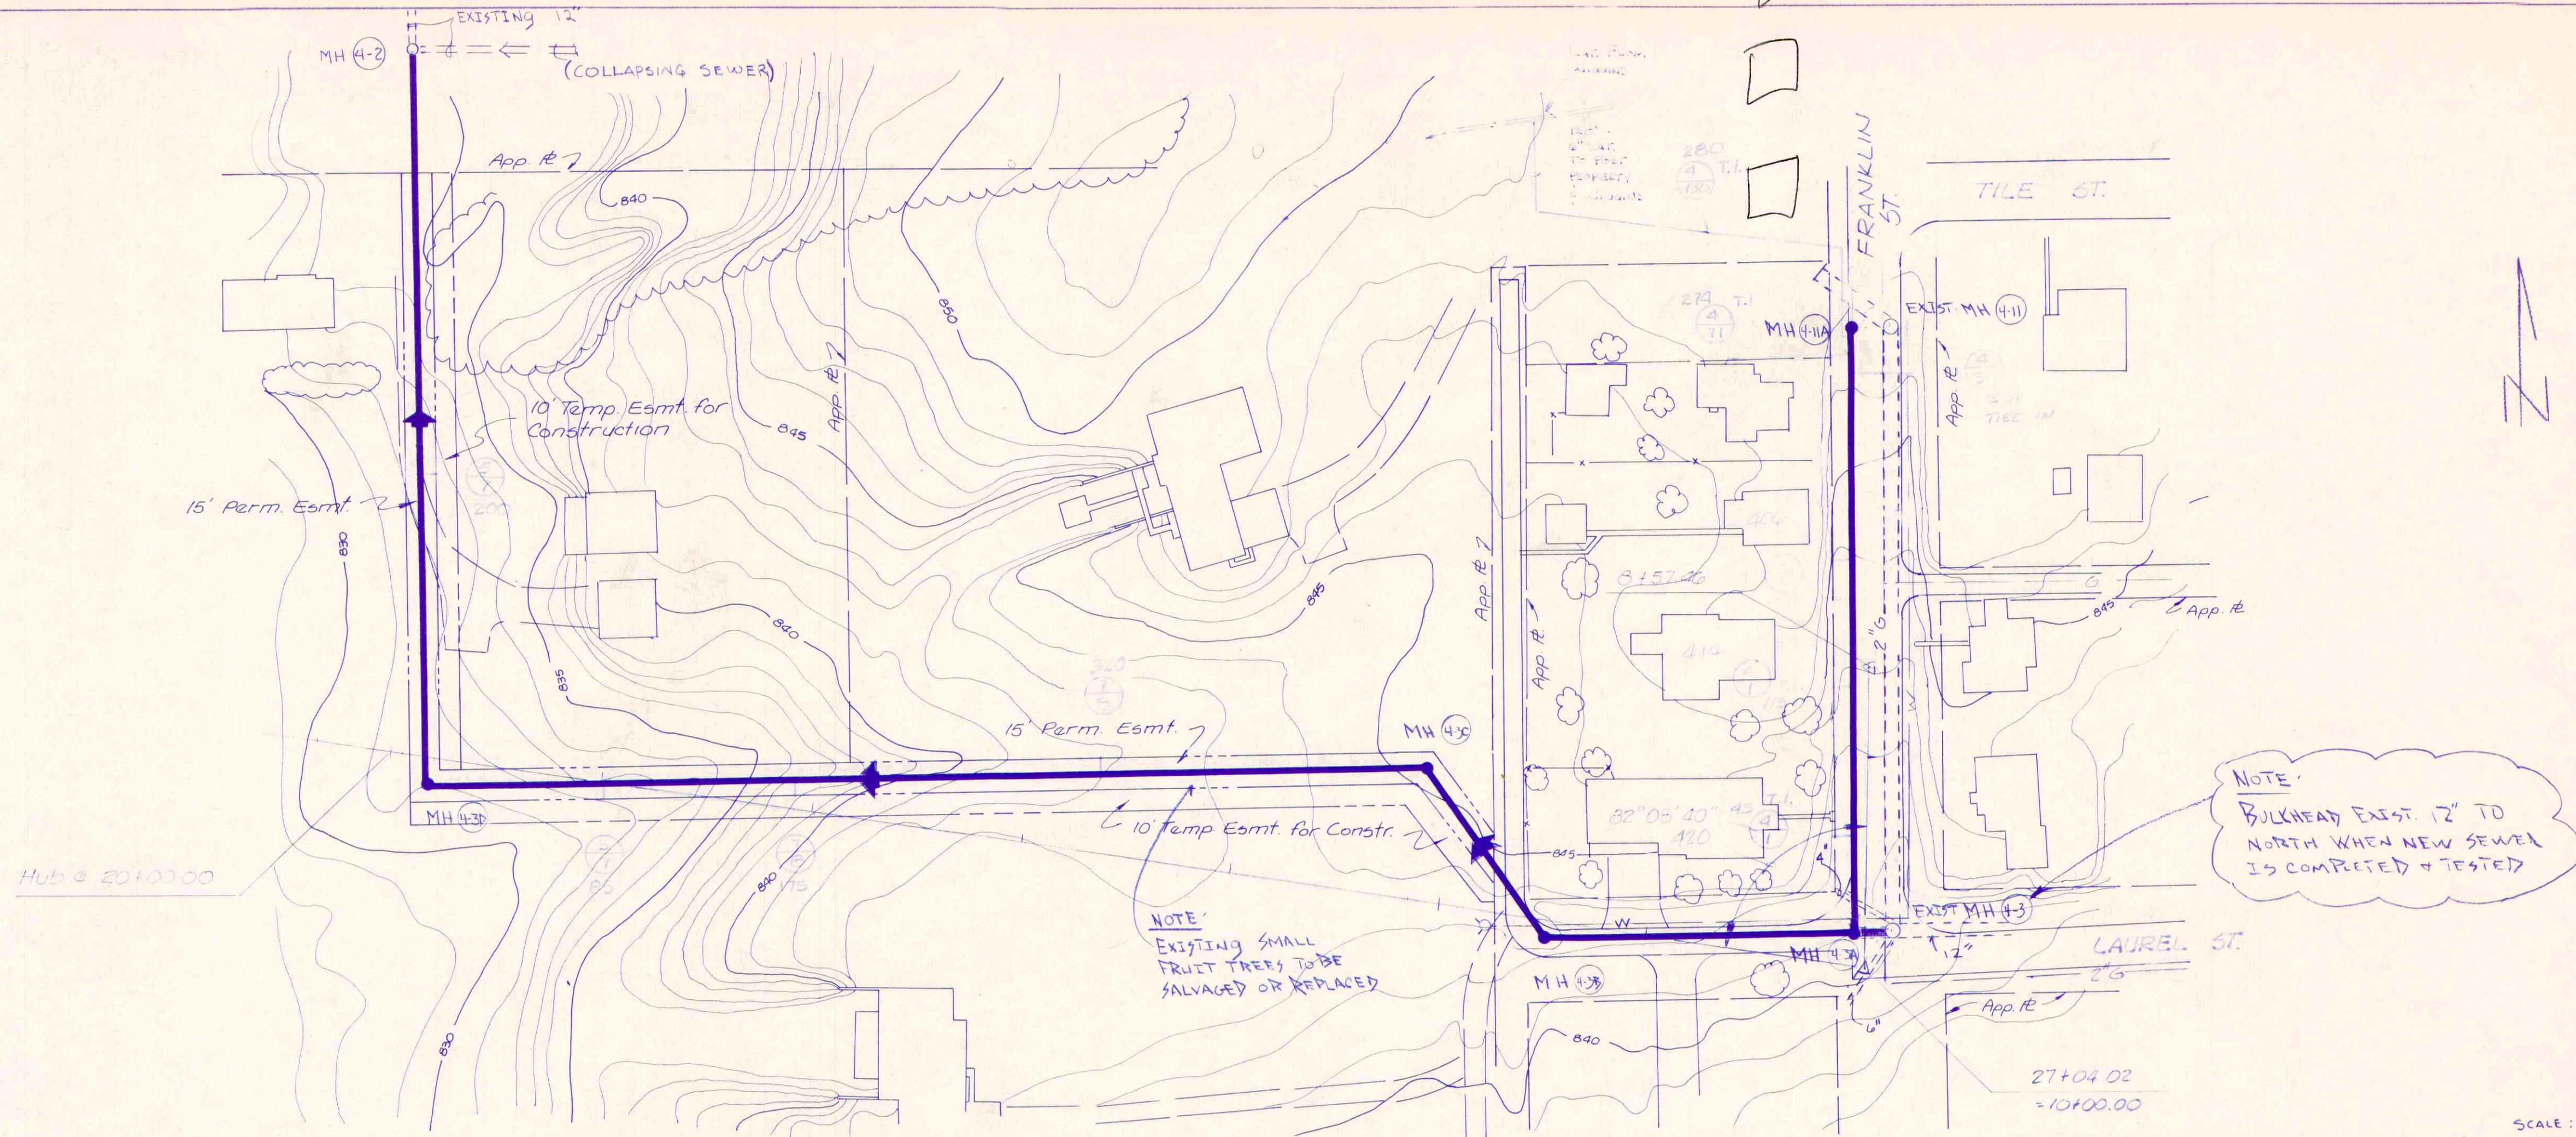


PLATE 1. PLAN - PROFILE B. R. R. STANDARD
1975

RECORD DRAWING

PROJECT NO.	LINE	SHEET NO.	TOTAL SHEETS	FILE
LINE "E"		484		