


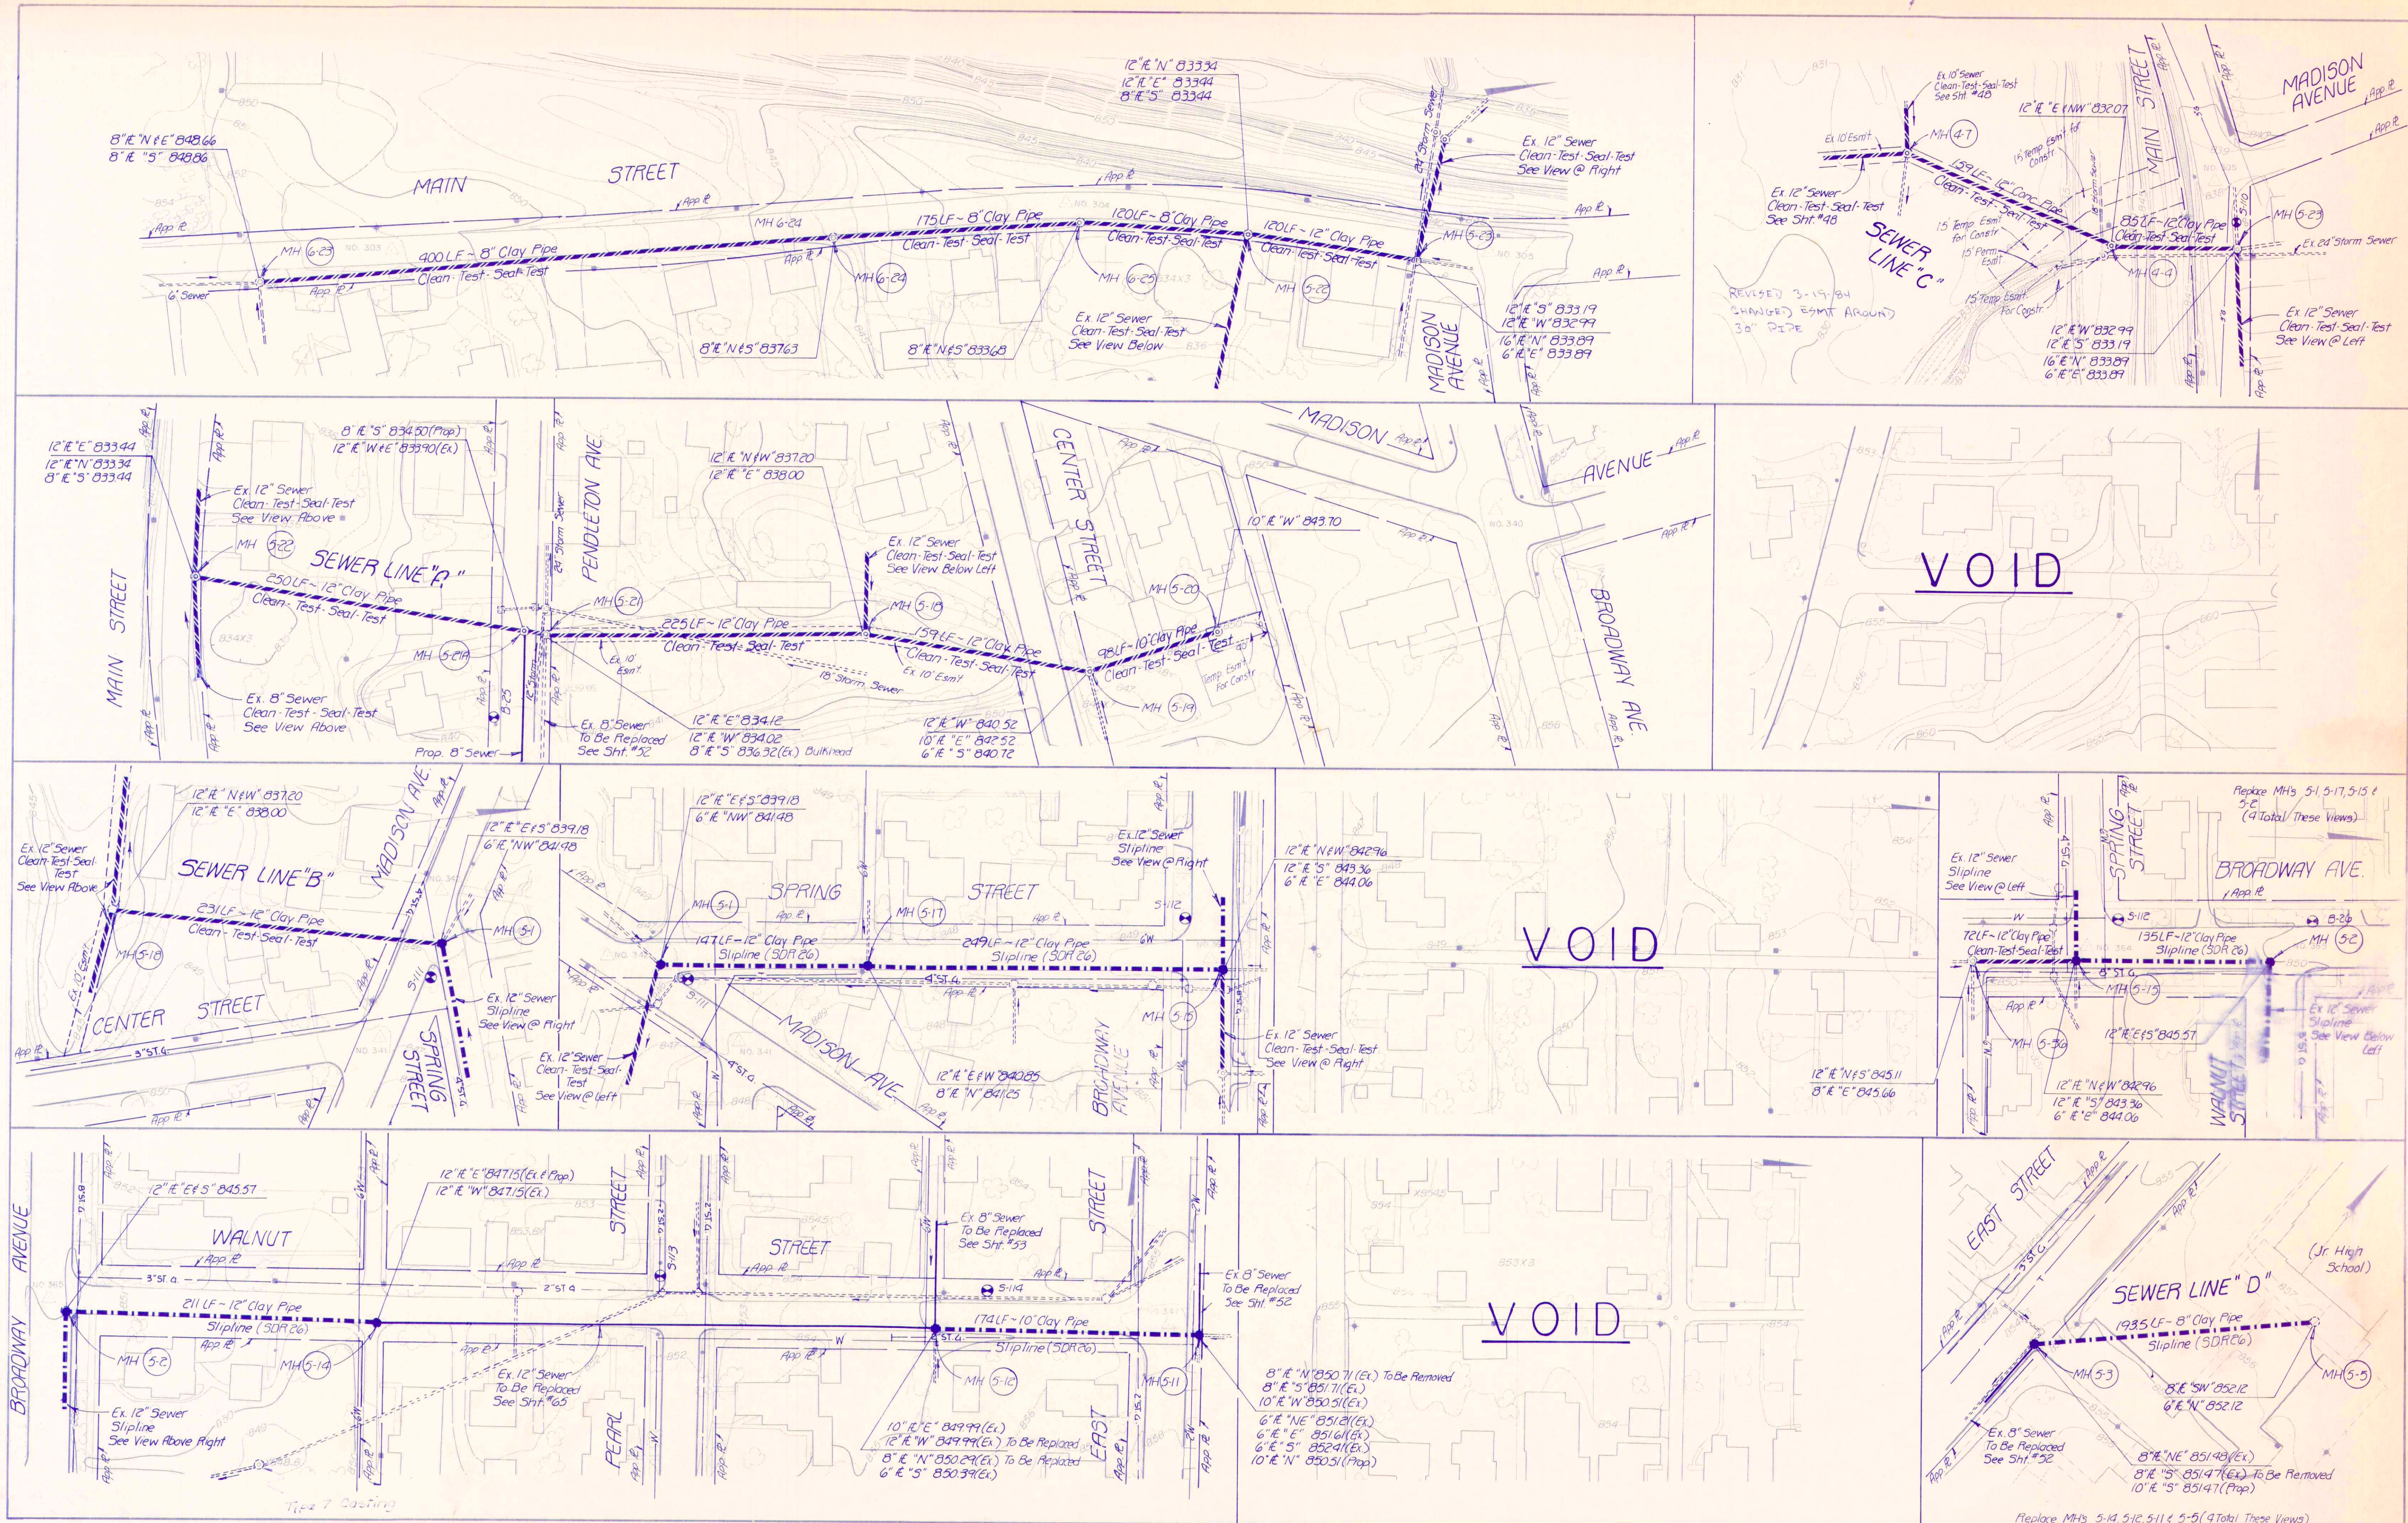

RECORD DRAWING

MAIN ST. SEWER LINE "C", SEWER LINE "A", WALNUT ST., SPRING ST., BROADWAY AVE. & SEWER LINE "B" & D	
FALL CREEK R.W.D. PLAN	
HORIZ. 1"=50'	BEAM, LONGEST & NEFF, INC.
VERT. 1"=10'	CONSULTING ENGINEERS
	INDIANAPOLIS, INDIANA
SLIPLINE (CLEAN-TEST-SEAL-TEST)	
SHEET 49	