
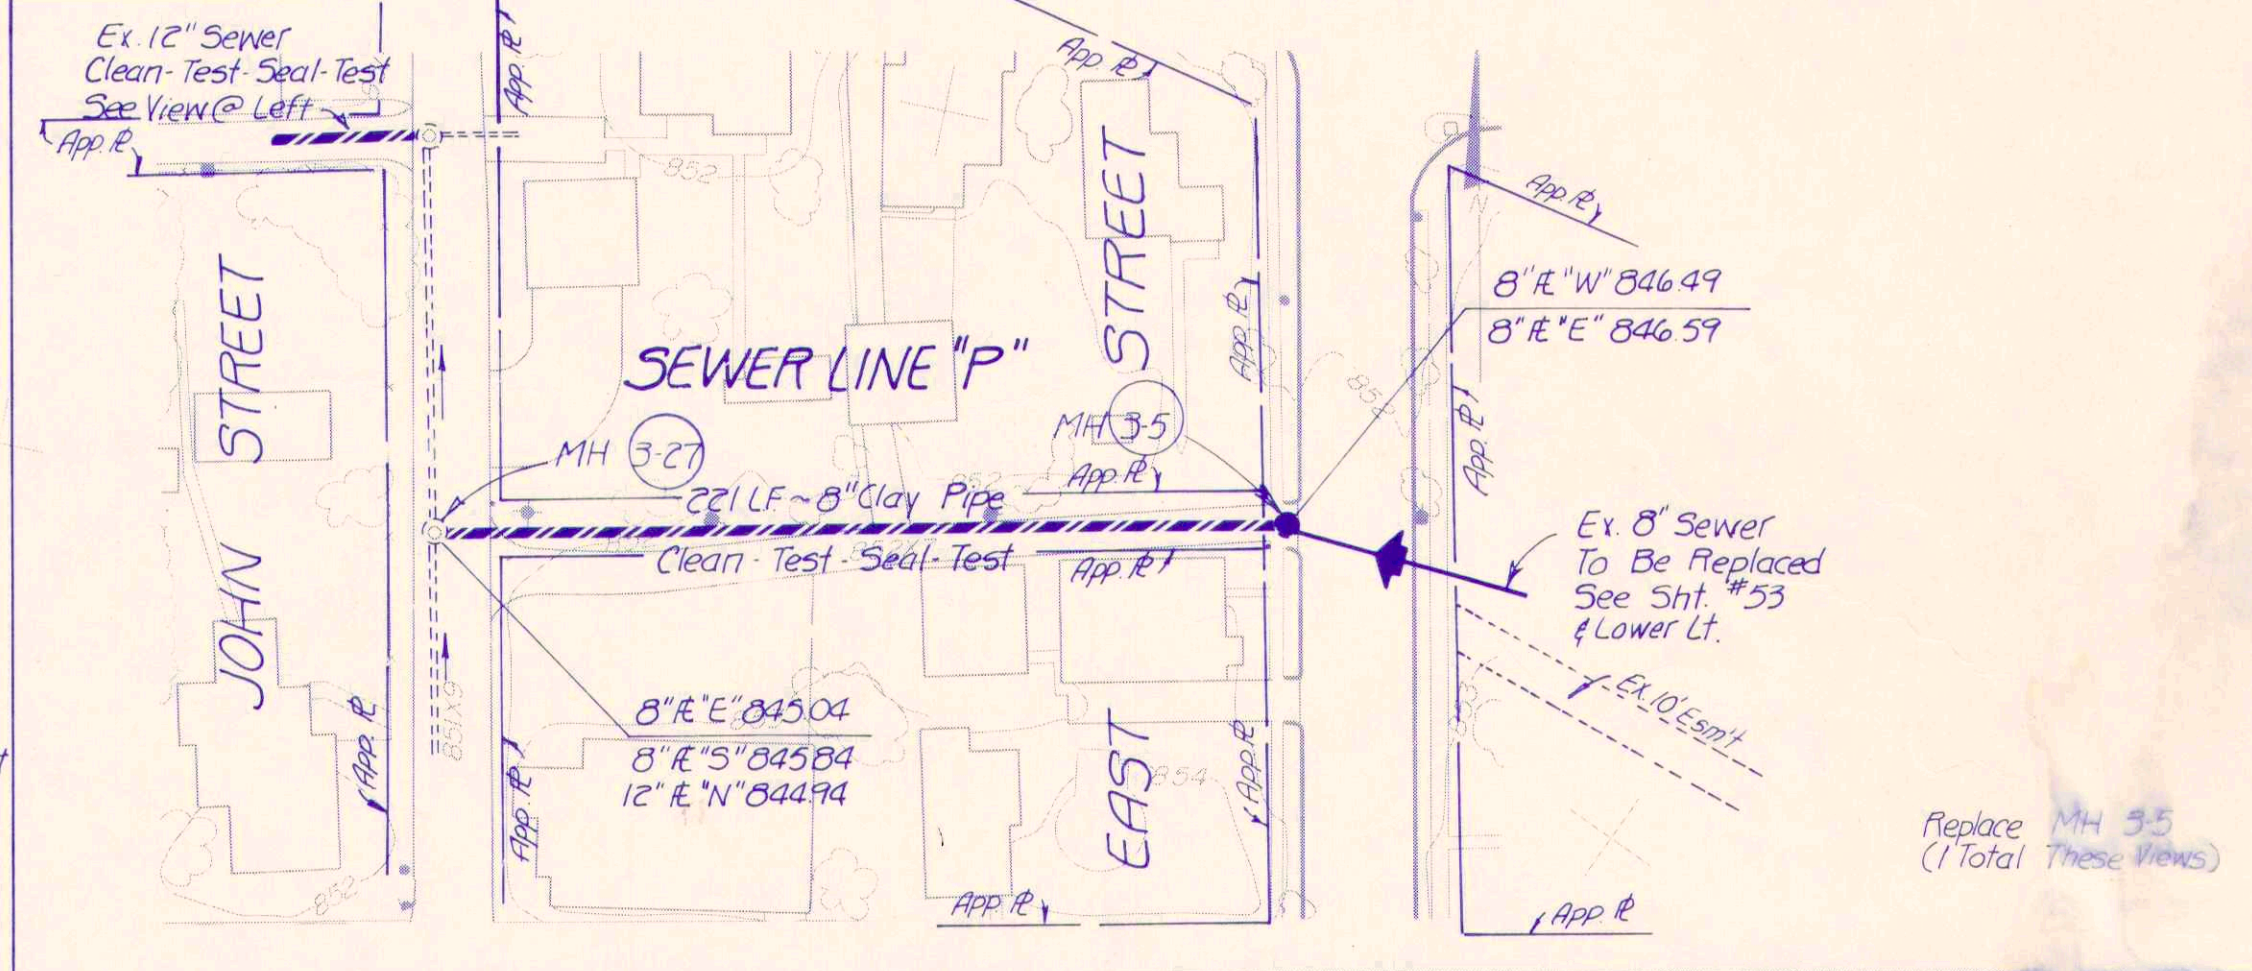
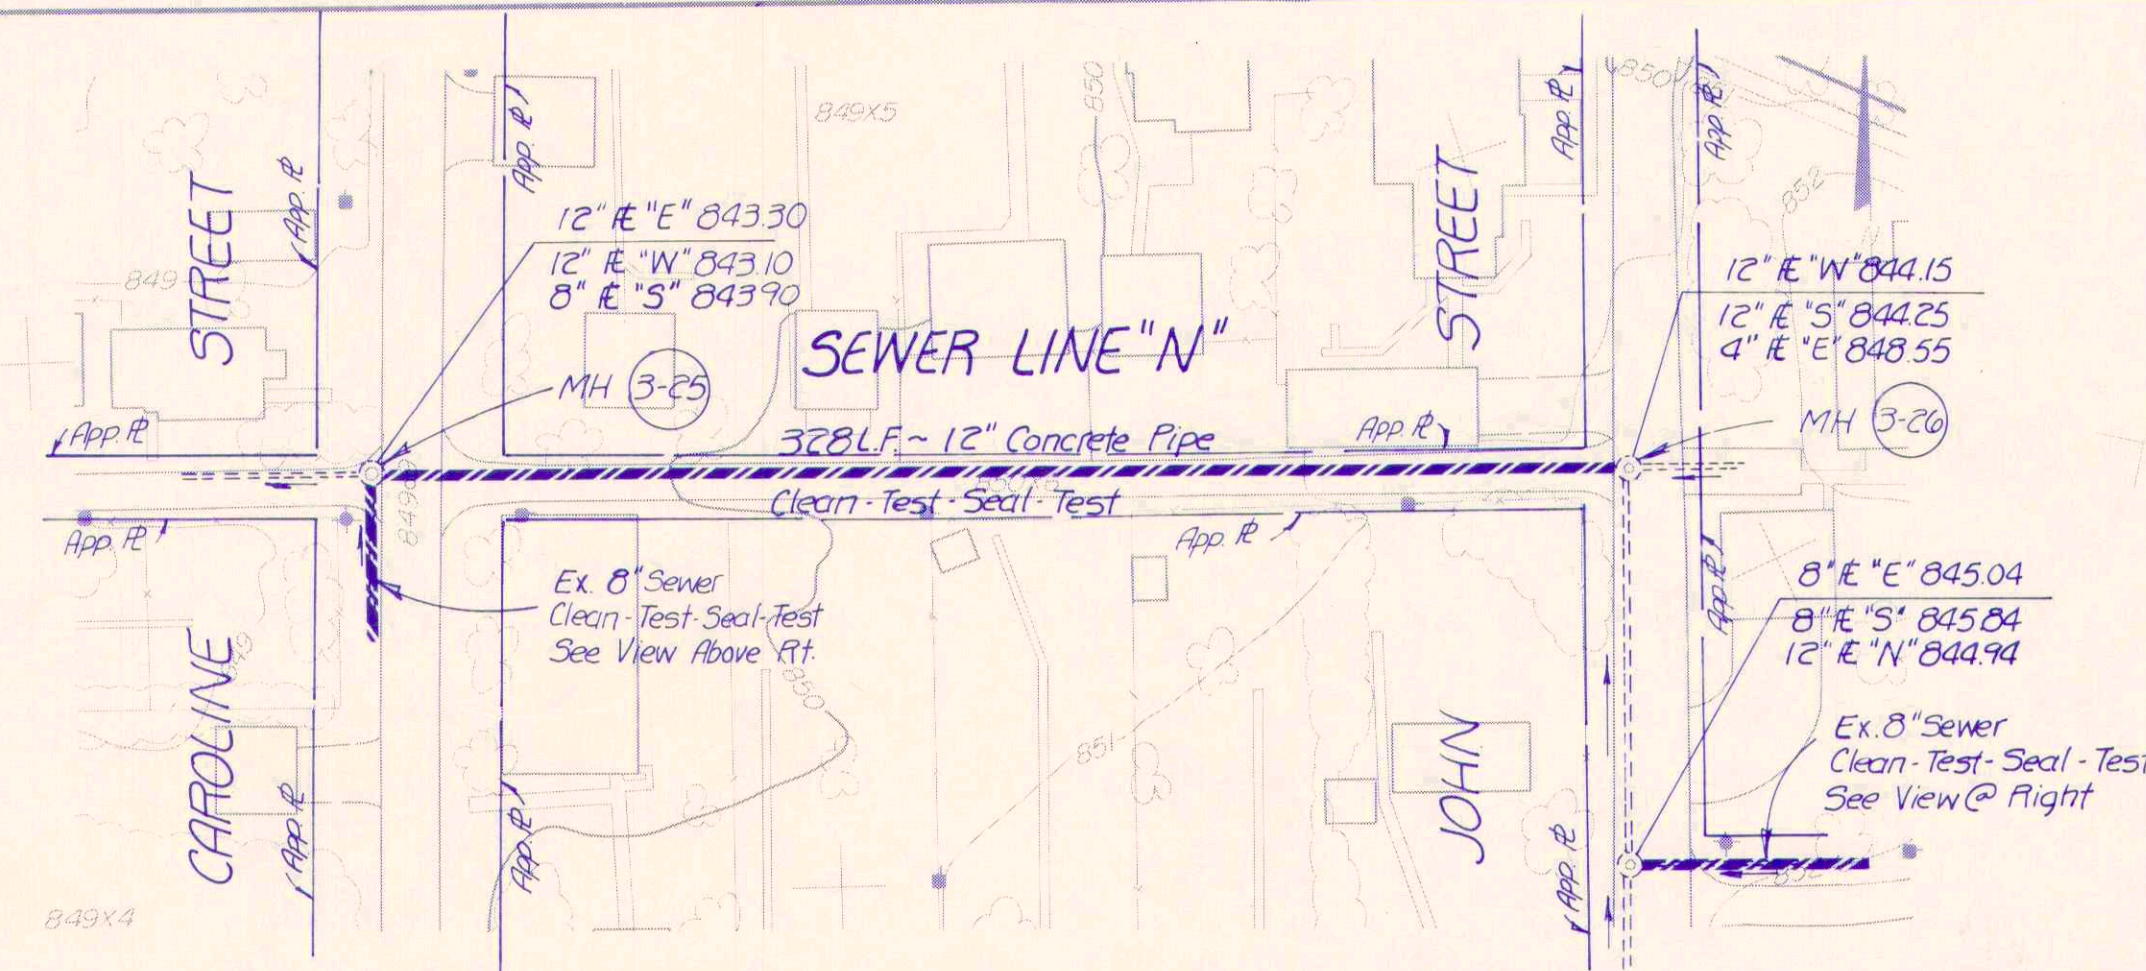
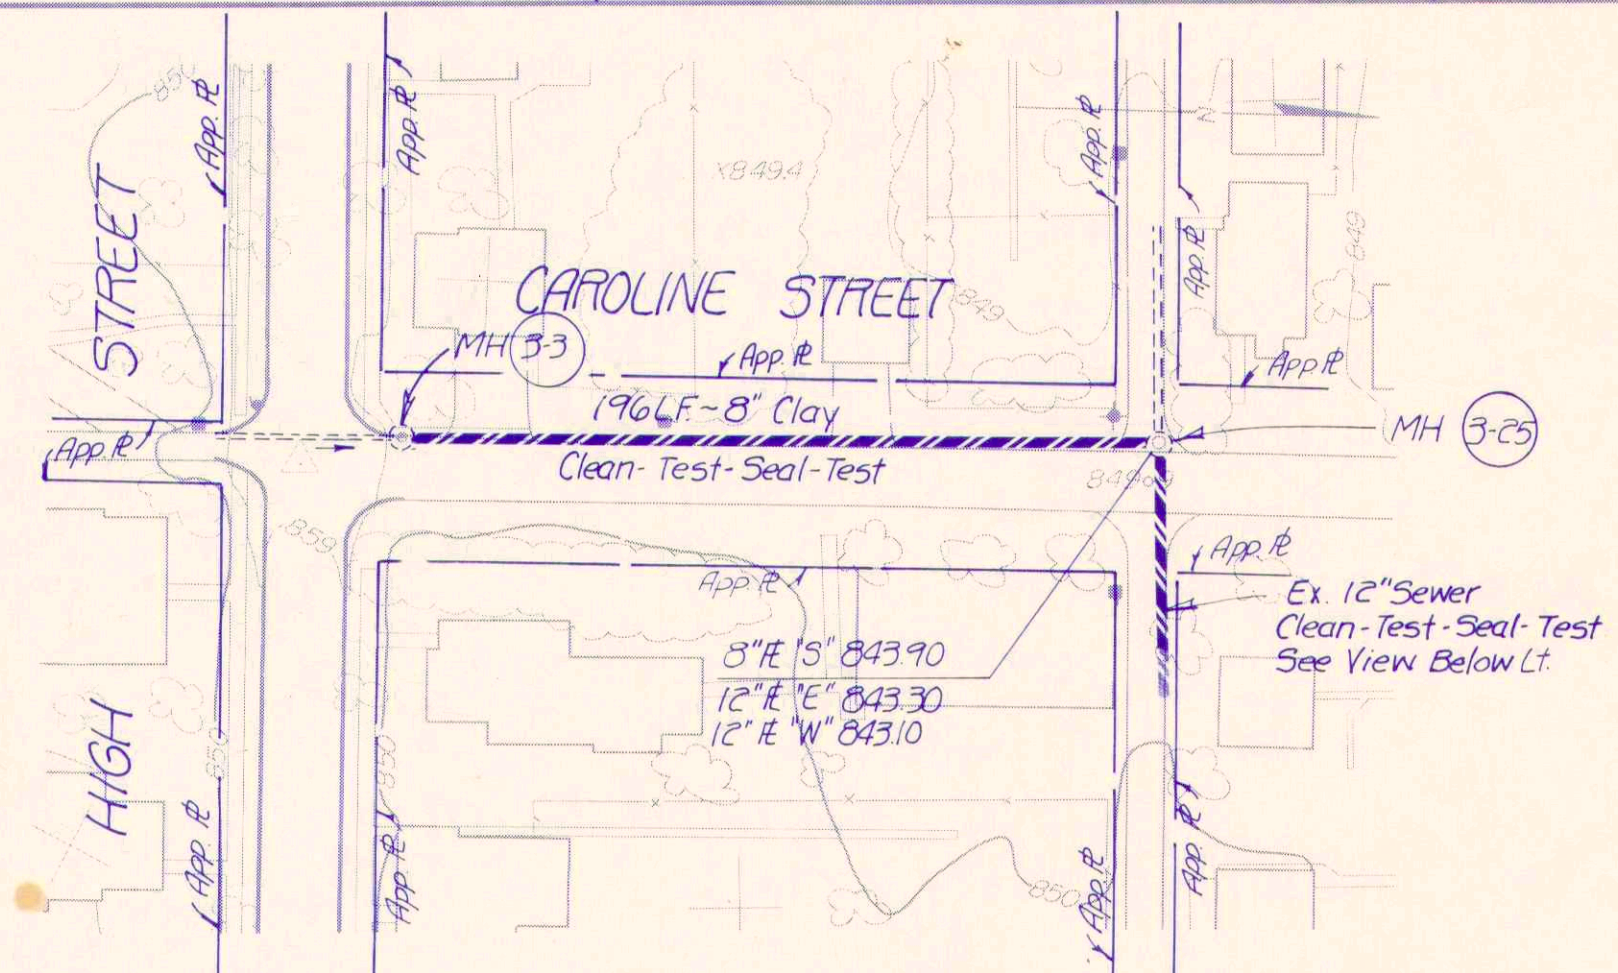
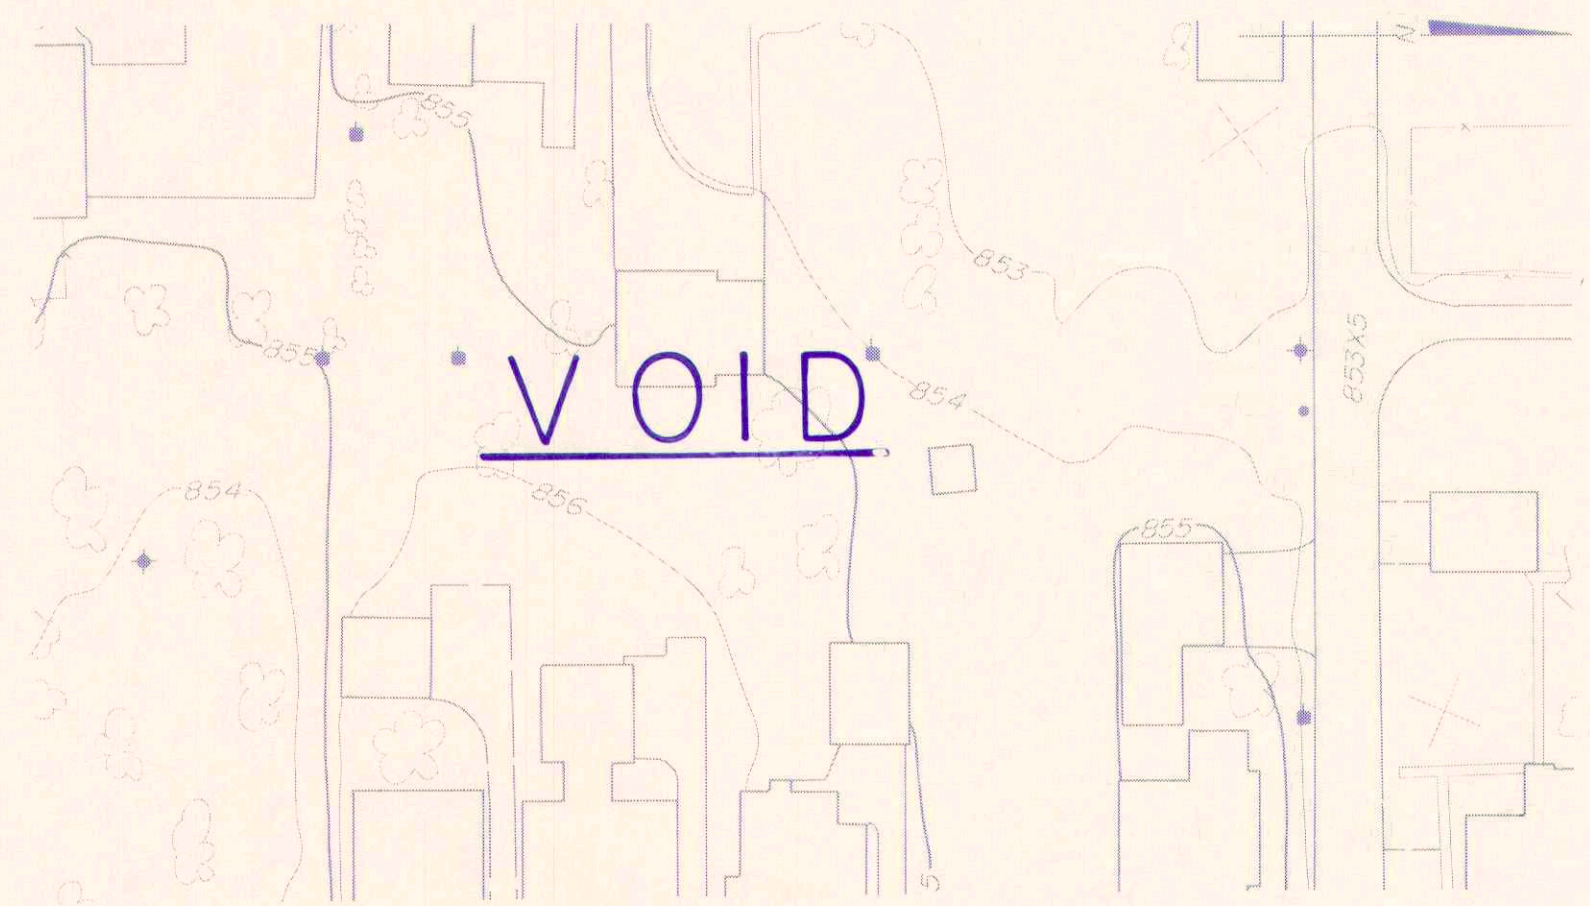
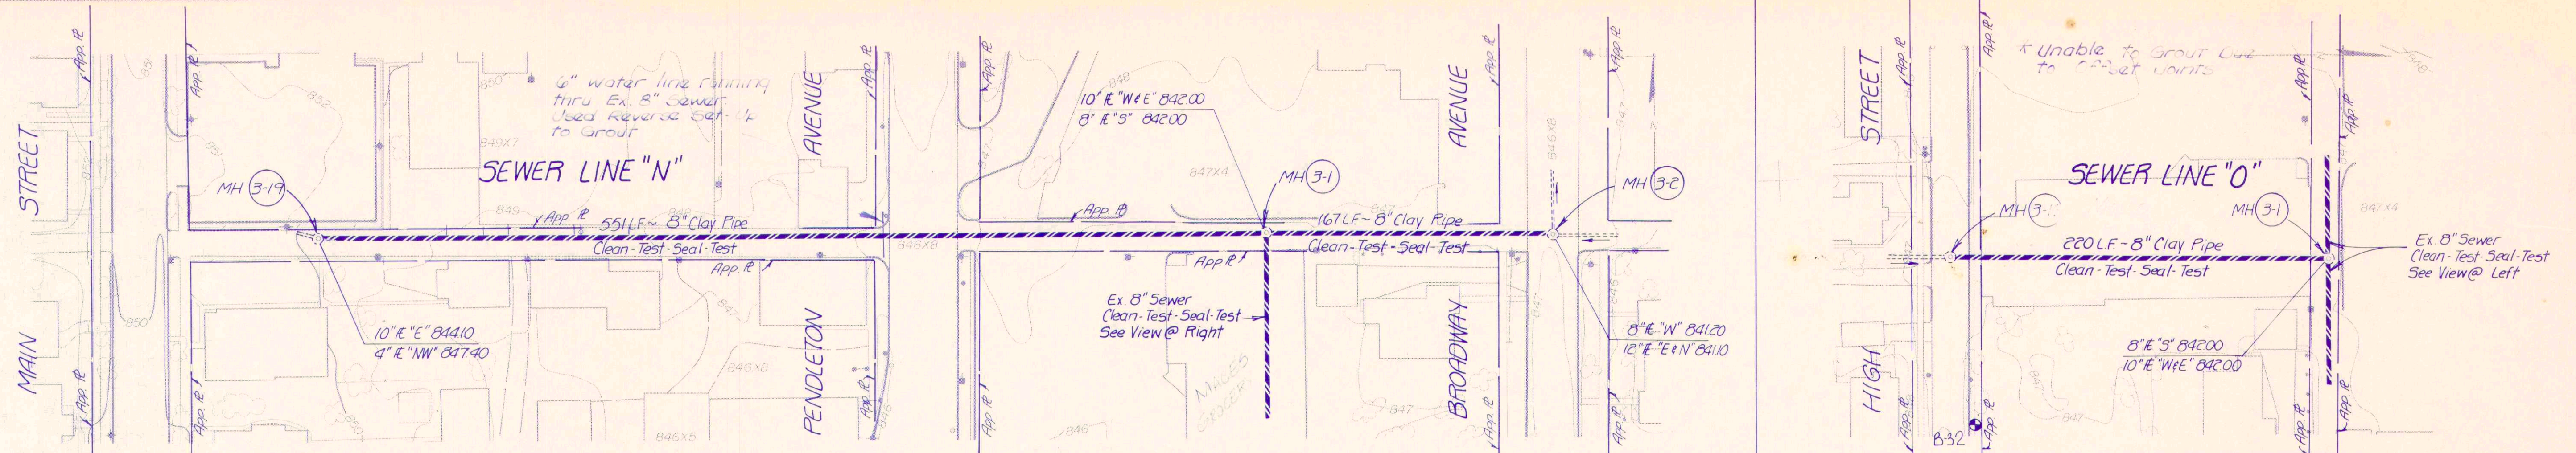


RECORD DRAWING

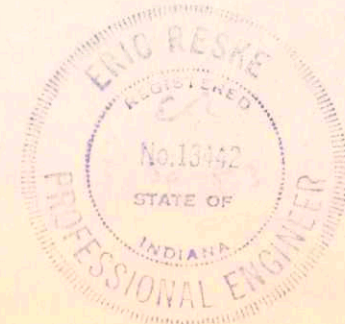

SEWER LINE "N", SEWER LINE "O", CAROLINE ST, & SEWER LINE "P"		
FALL CREEK R.W.D. PLAN		
HORIZ. 1"=50'	BEAM, LONGEST & NEFF, INC.	SHEET
VERT. 1"=10'	CONSULTING ENGINEERS INDIANAPOLIS, INDIANA	50
CLEAN-TEST-SEAL-TEST		