

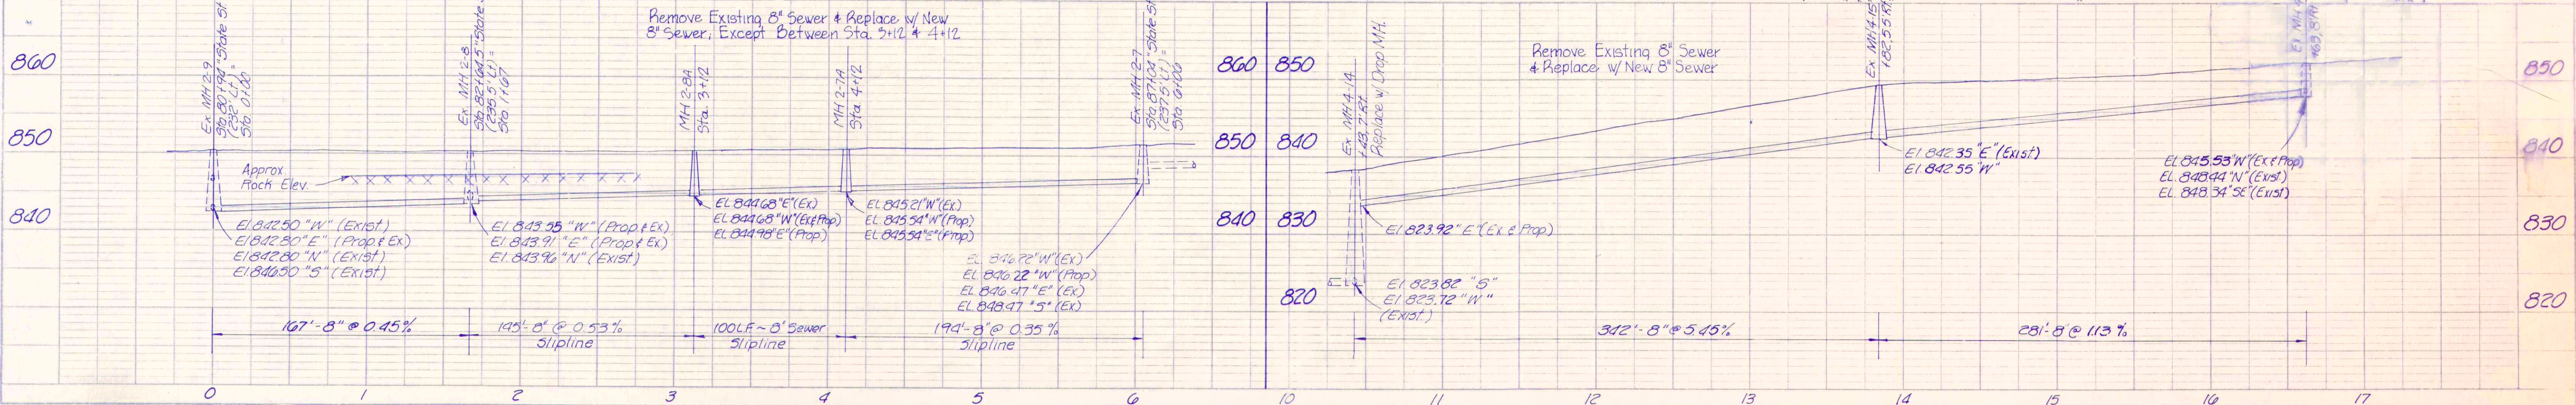
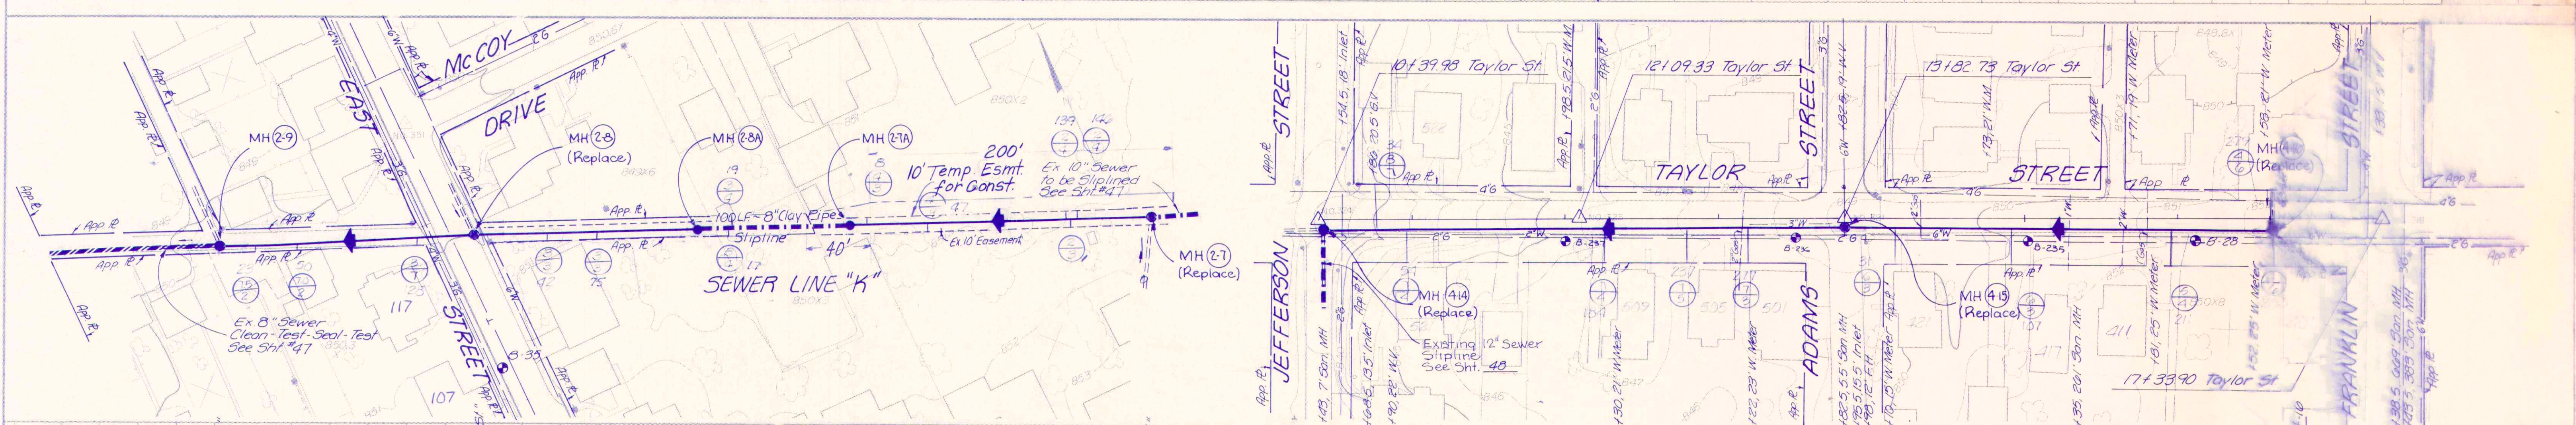


PLAN
 SHEET NO. 1
 DATE: 10/1/10
 BY: J. M. HART
 CHECKED: J. M. HART
 NO. 10/1/10

PROFILE
 SHEET NO. 2
 DATE: 10/1/10
 BY: J. M. HART
 CHECKED: J. M. HART
 NO. 10/1/10

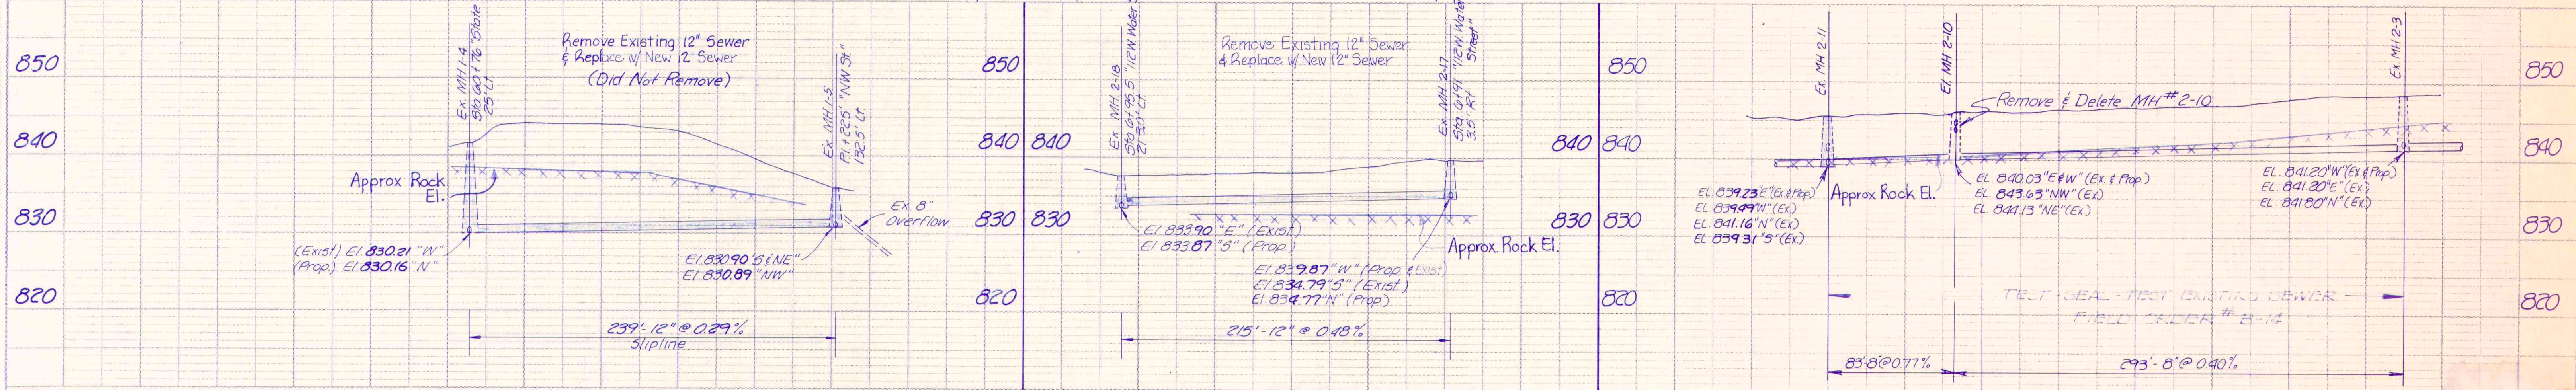

RECORD DRAWING

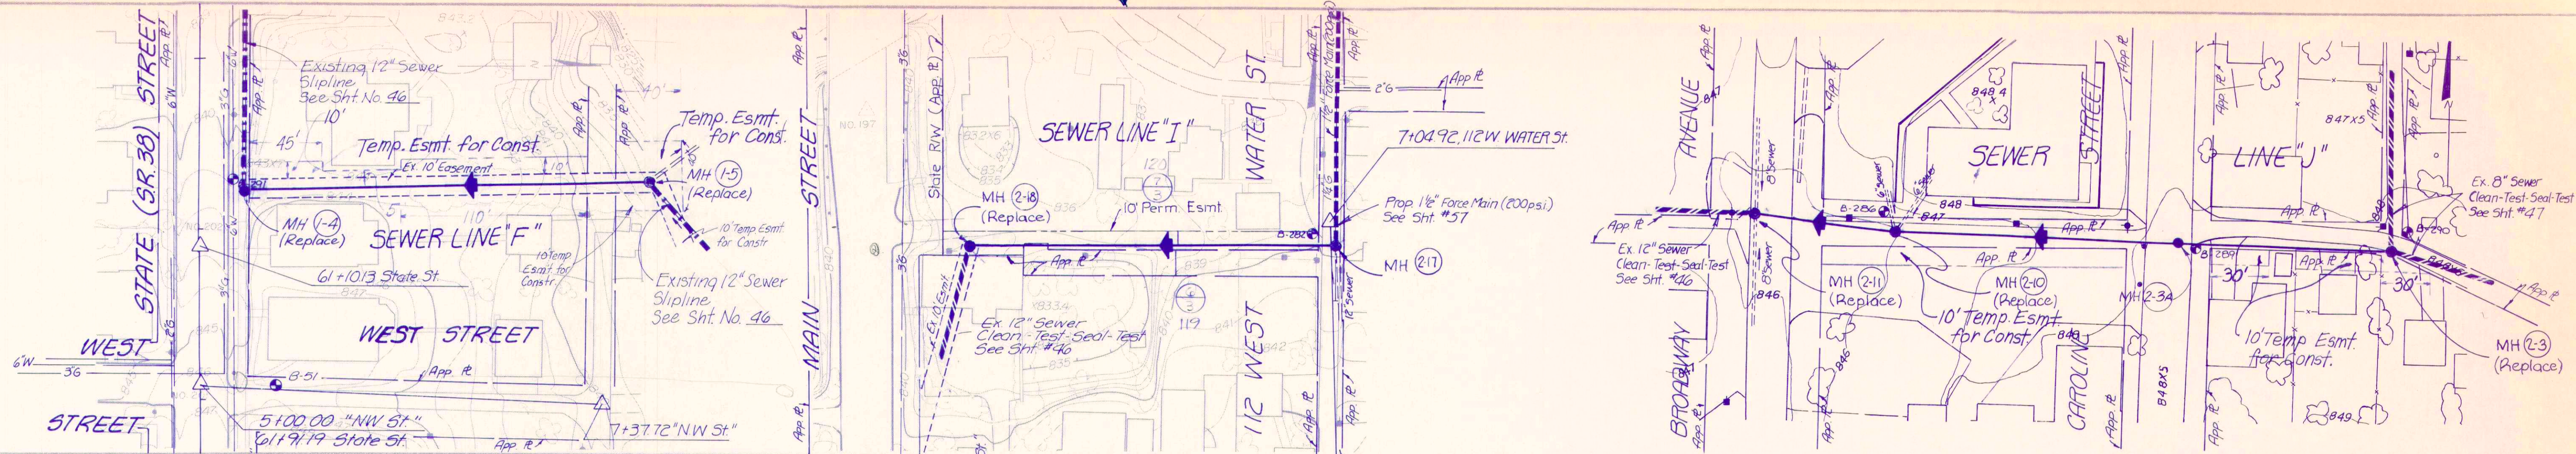

SEWER LINES "F, I, & K" / TAYLOR ST.
 FALL CREEK R.W.D. PLAN & PROFILE SHEET
 HORIZ. 1"=50'
 VERT. 1"=10'
 BEAM, LONGST & NEFF, INC.
 CONSULTING ENGINEERS
 INDIANAPOLIS, INDIANA
 51