
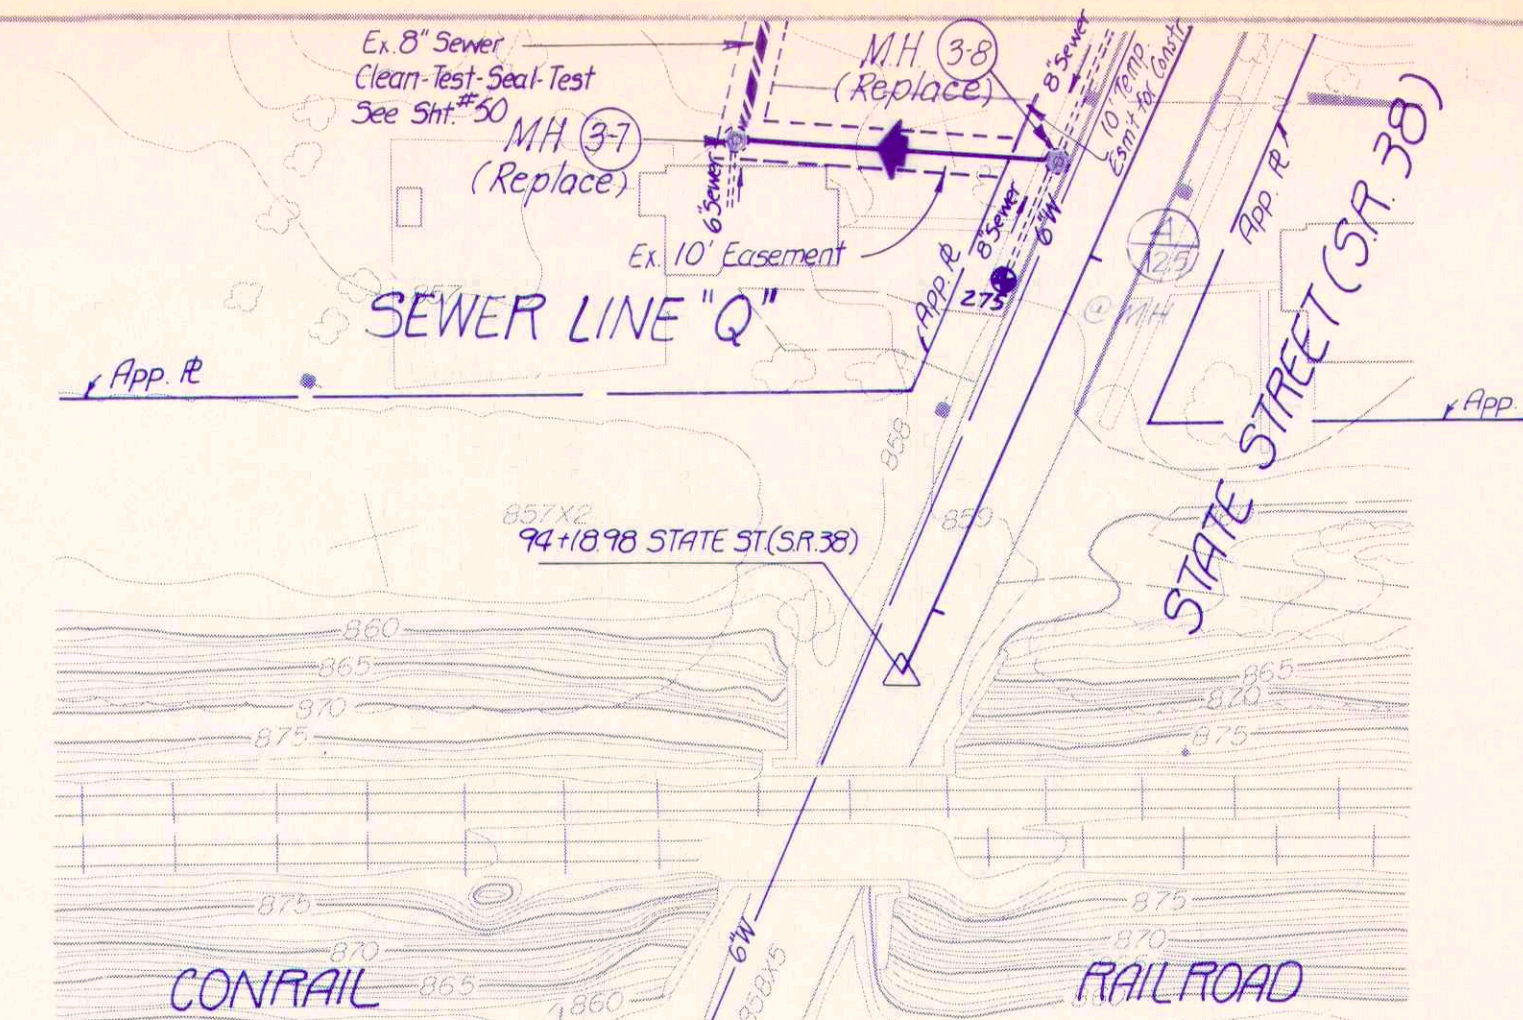





PLAN
NOTE BOOK
NO.

PROFILE
NOTE BOOK
NO.


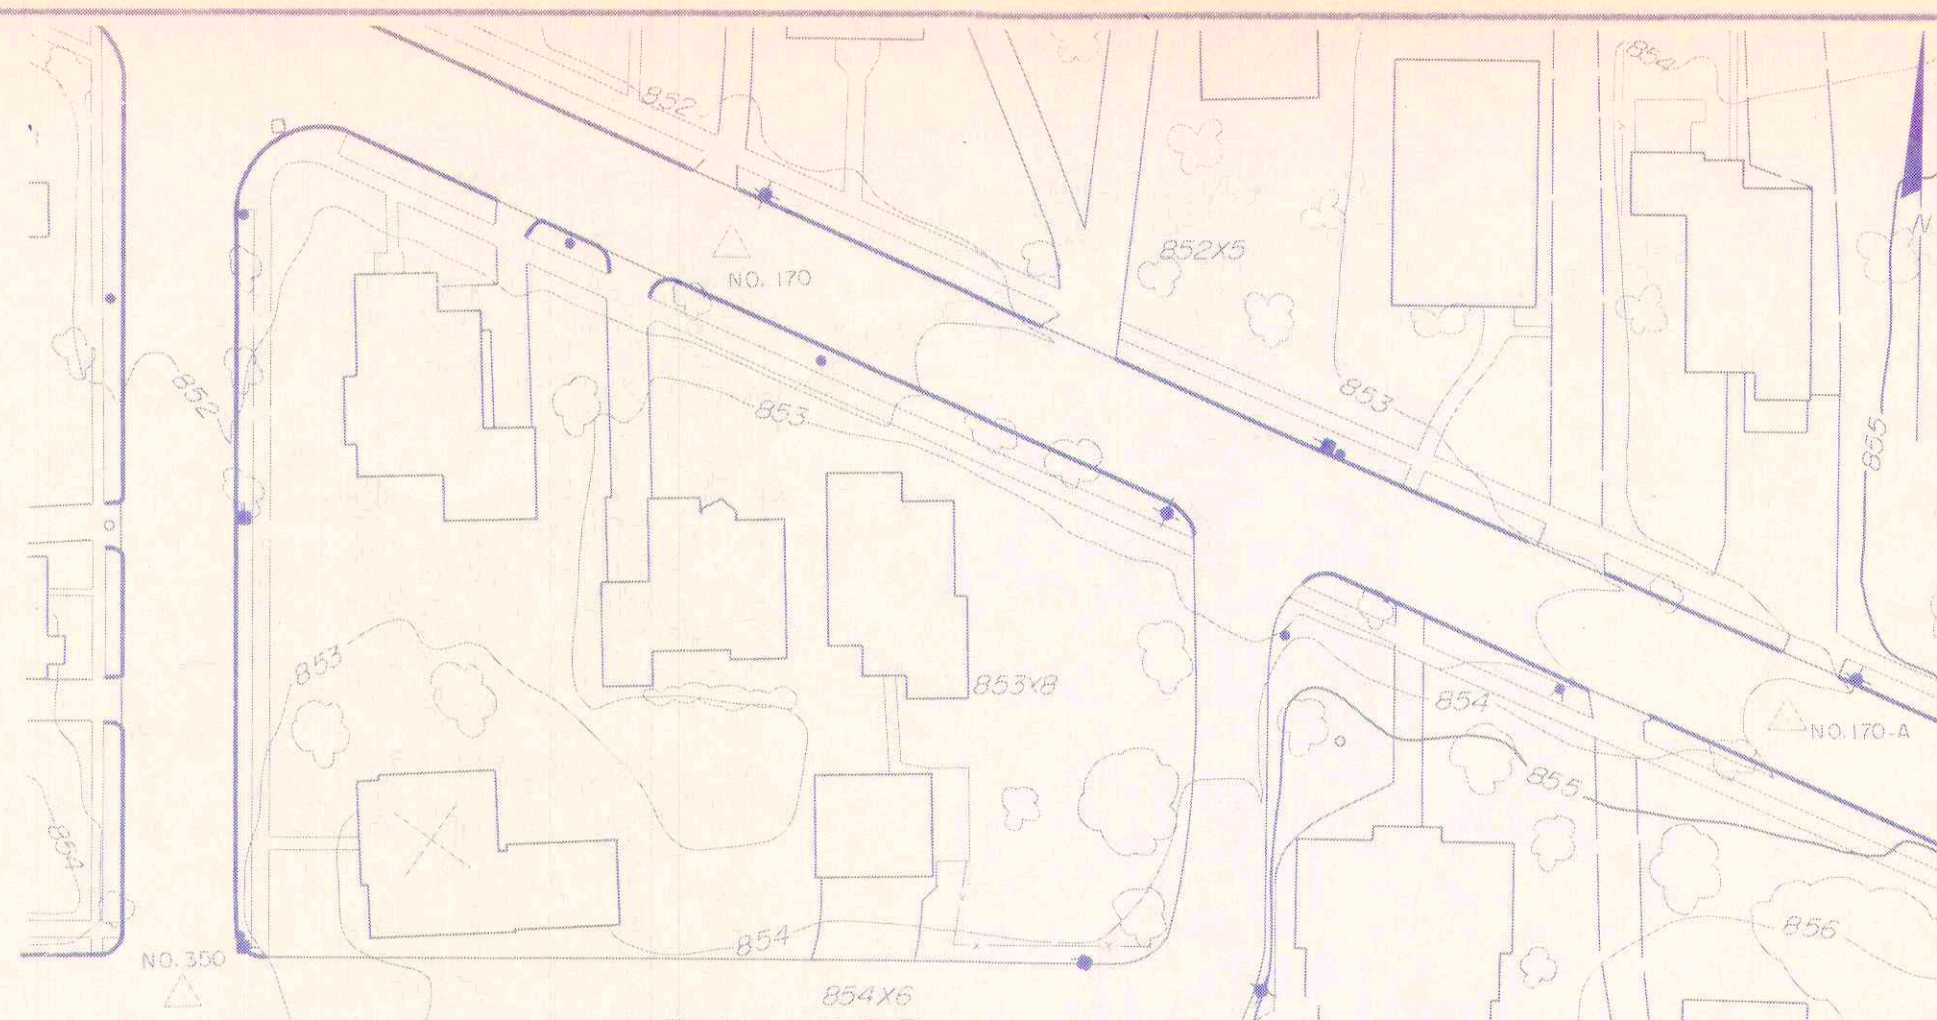


Note: 4" PVC Service Connection installed around MH 37

VOID

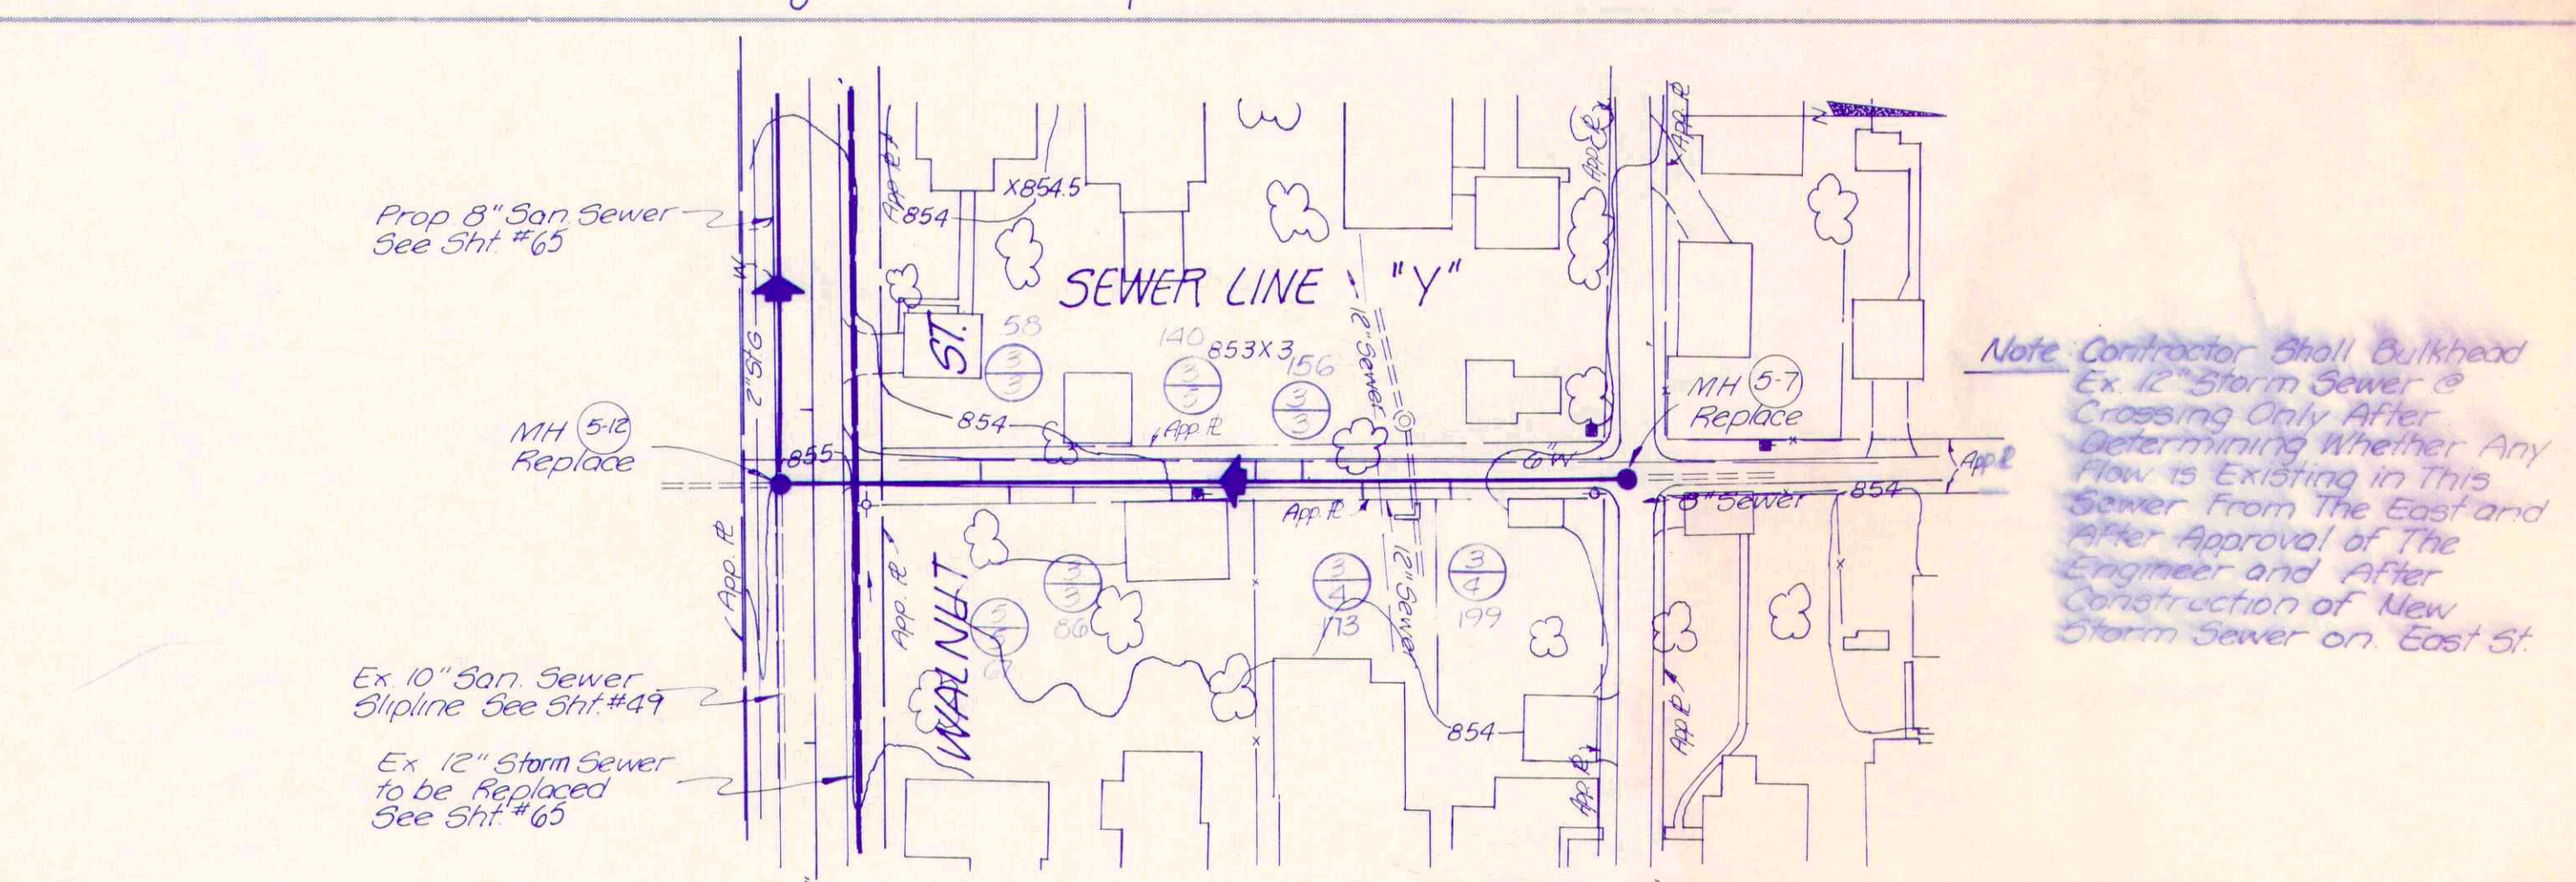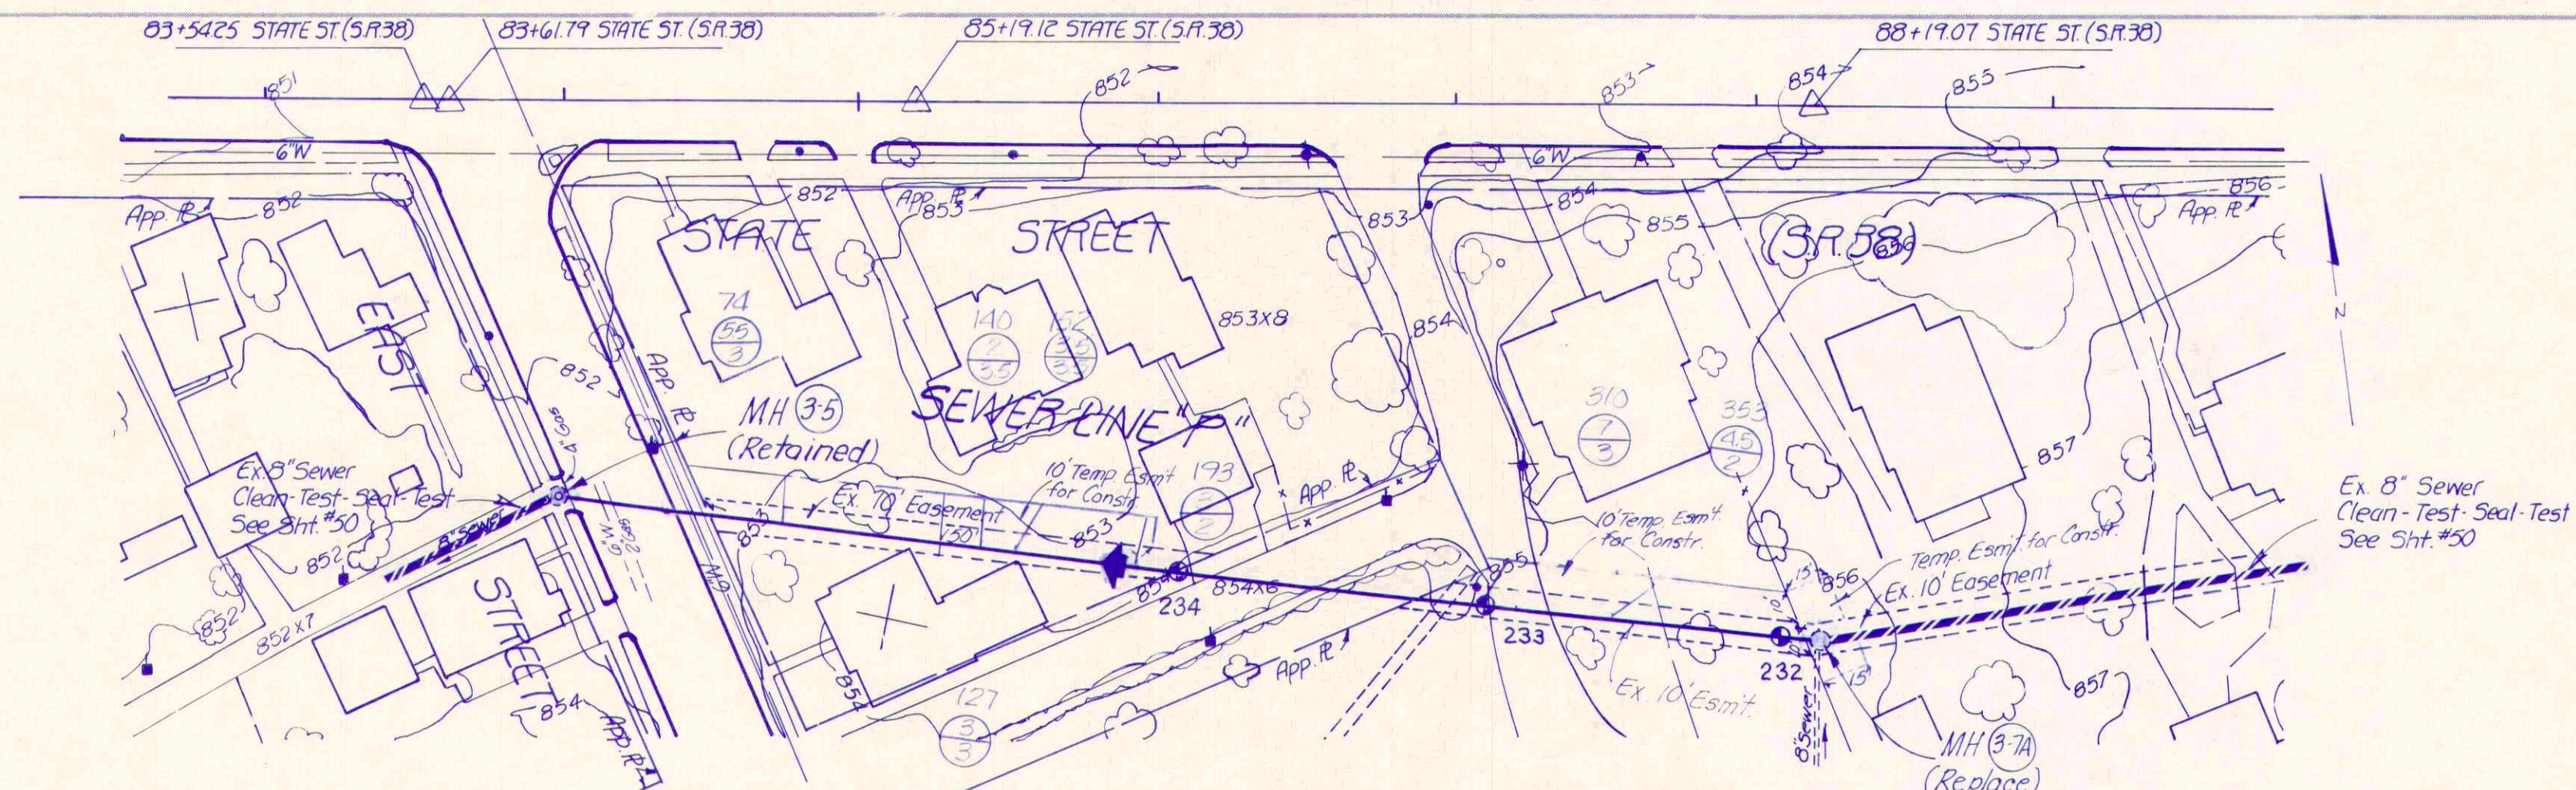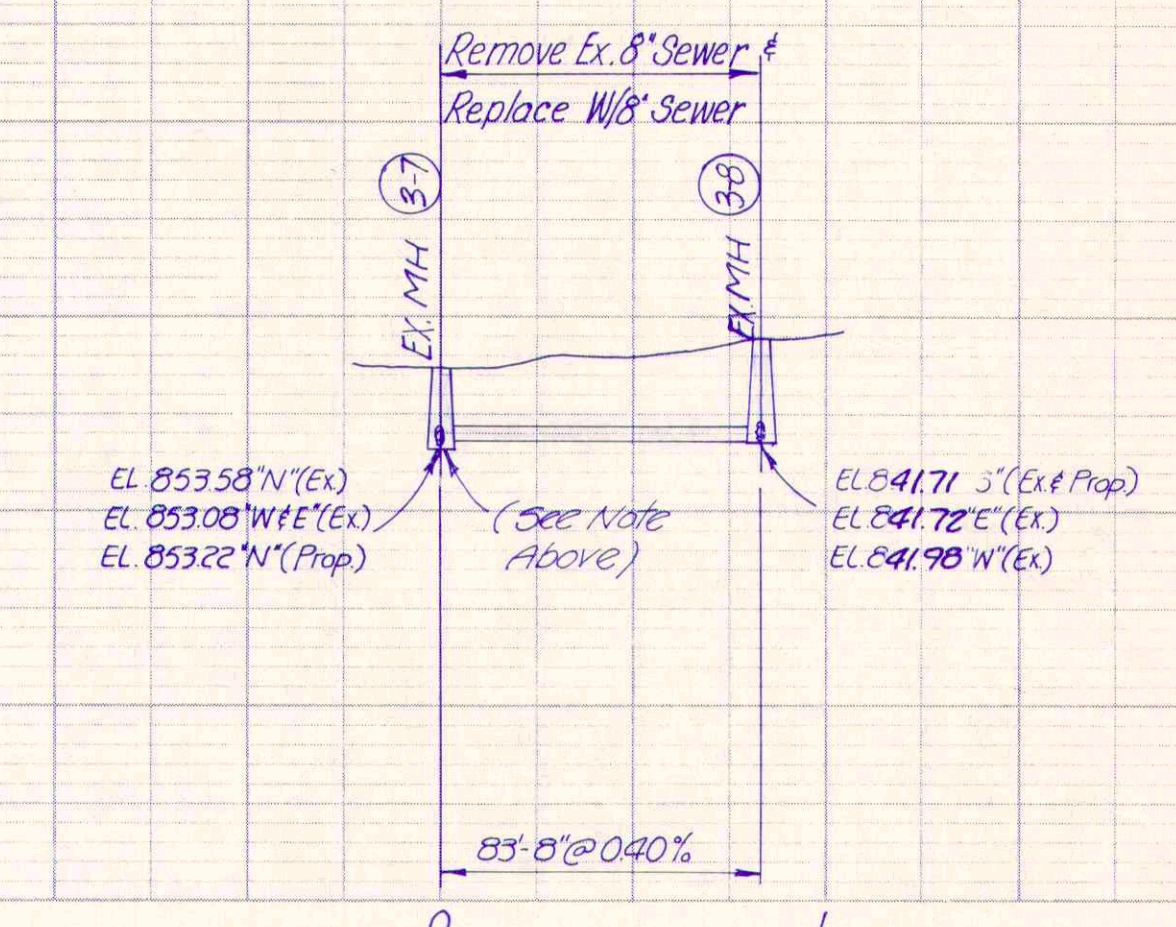

Note: Contractor Shall Bulkhead Ex. 12" Storm Sewer @ Crossing Only After Determining Whether Any Flow is Existing in This Sewer from The East and After Approval of The Engineer and After Construction of New Storm Sewer on East St.

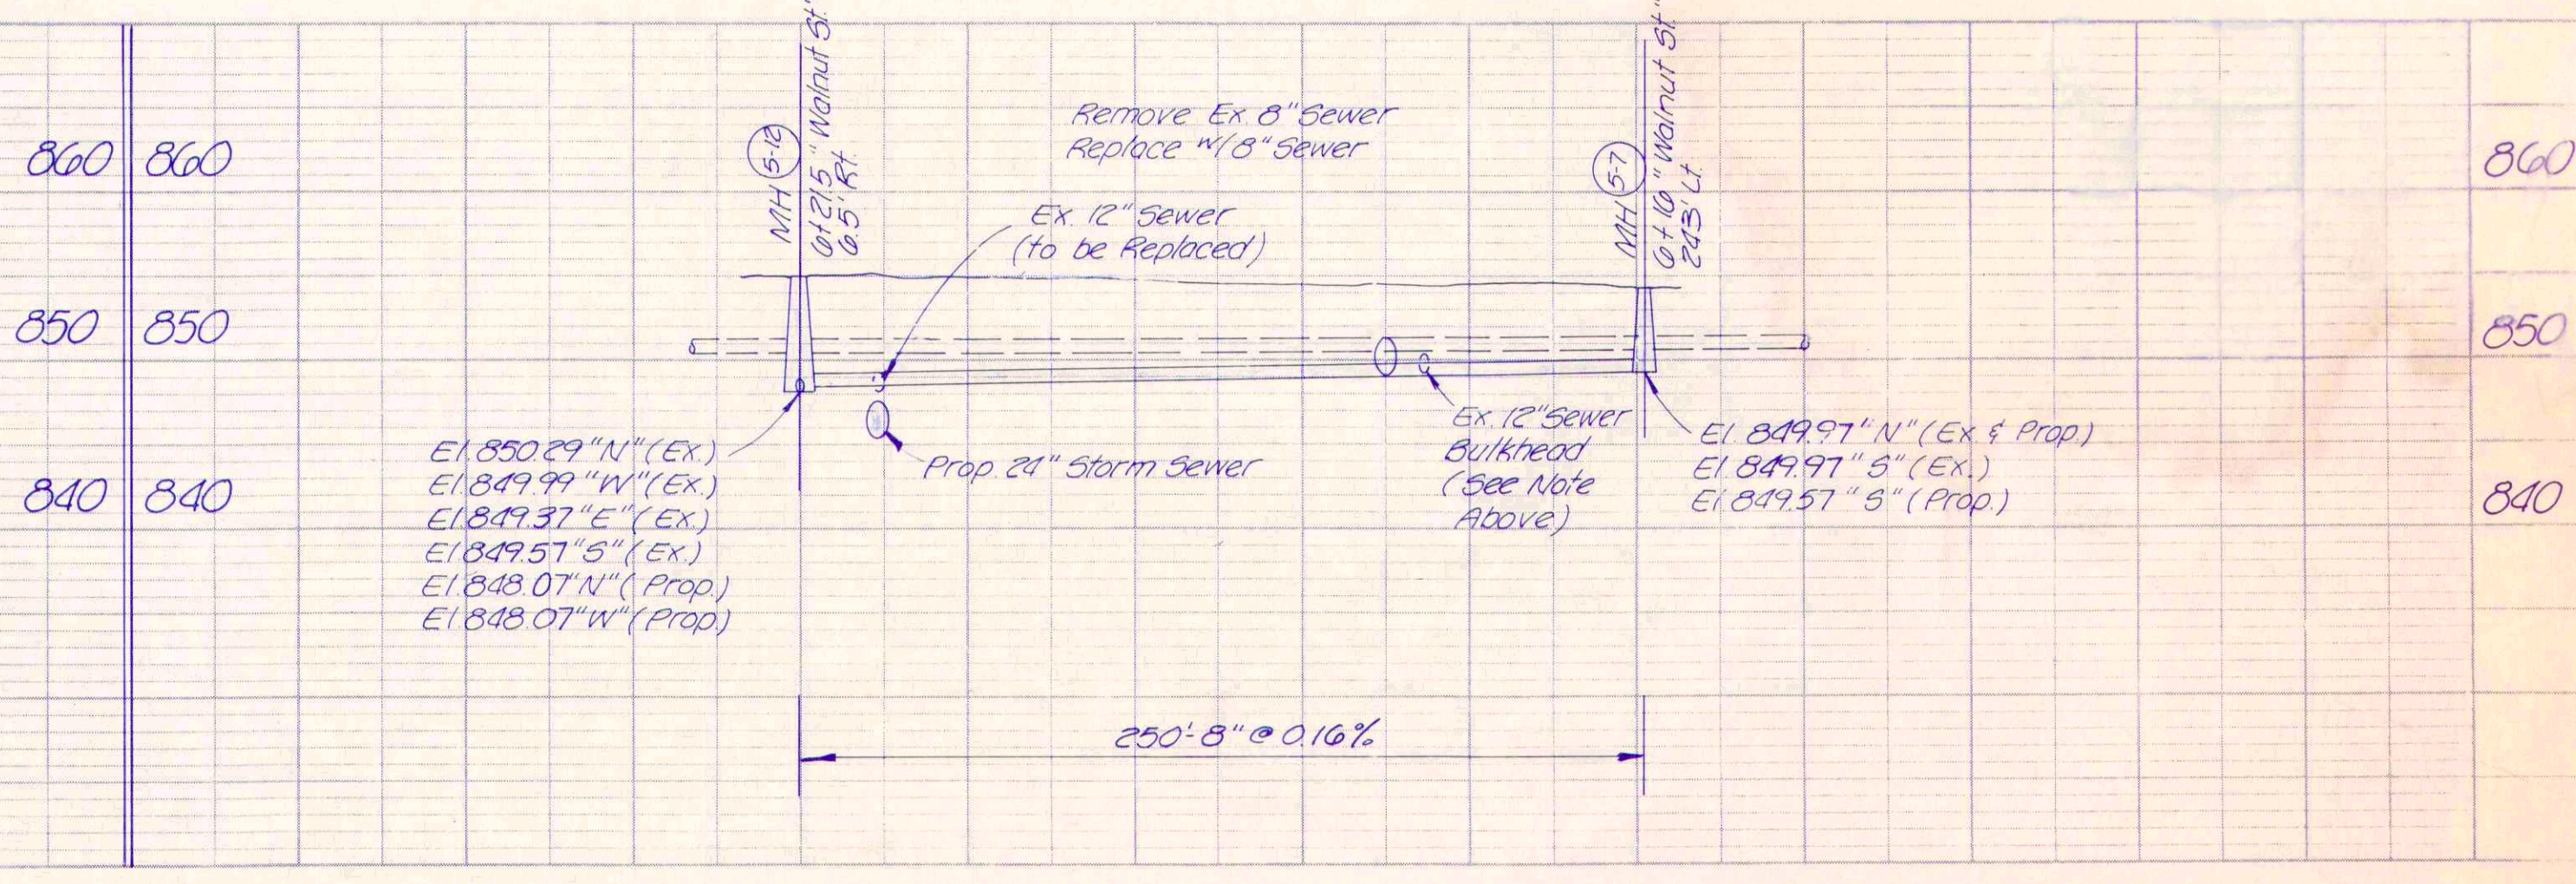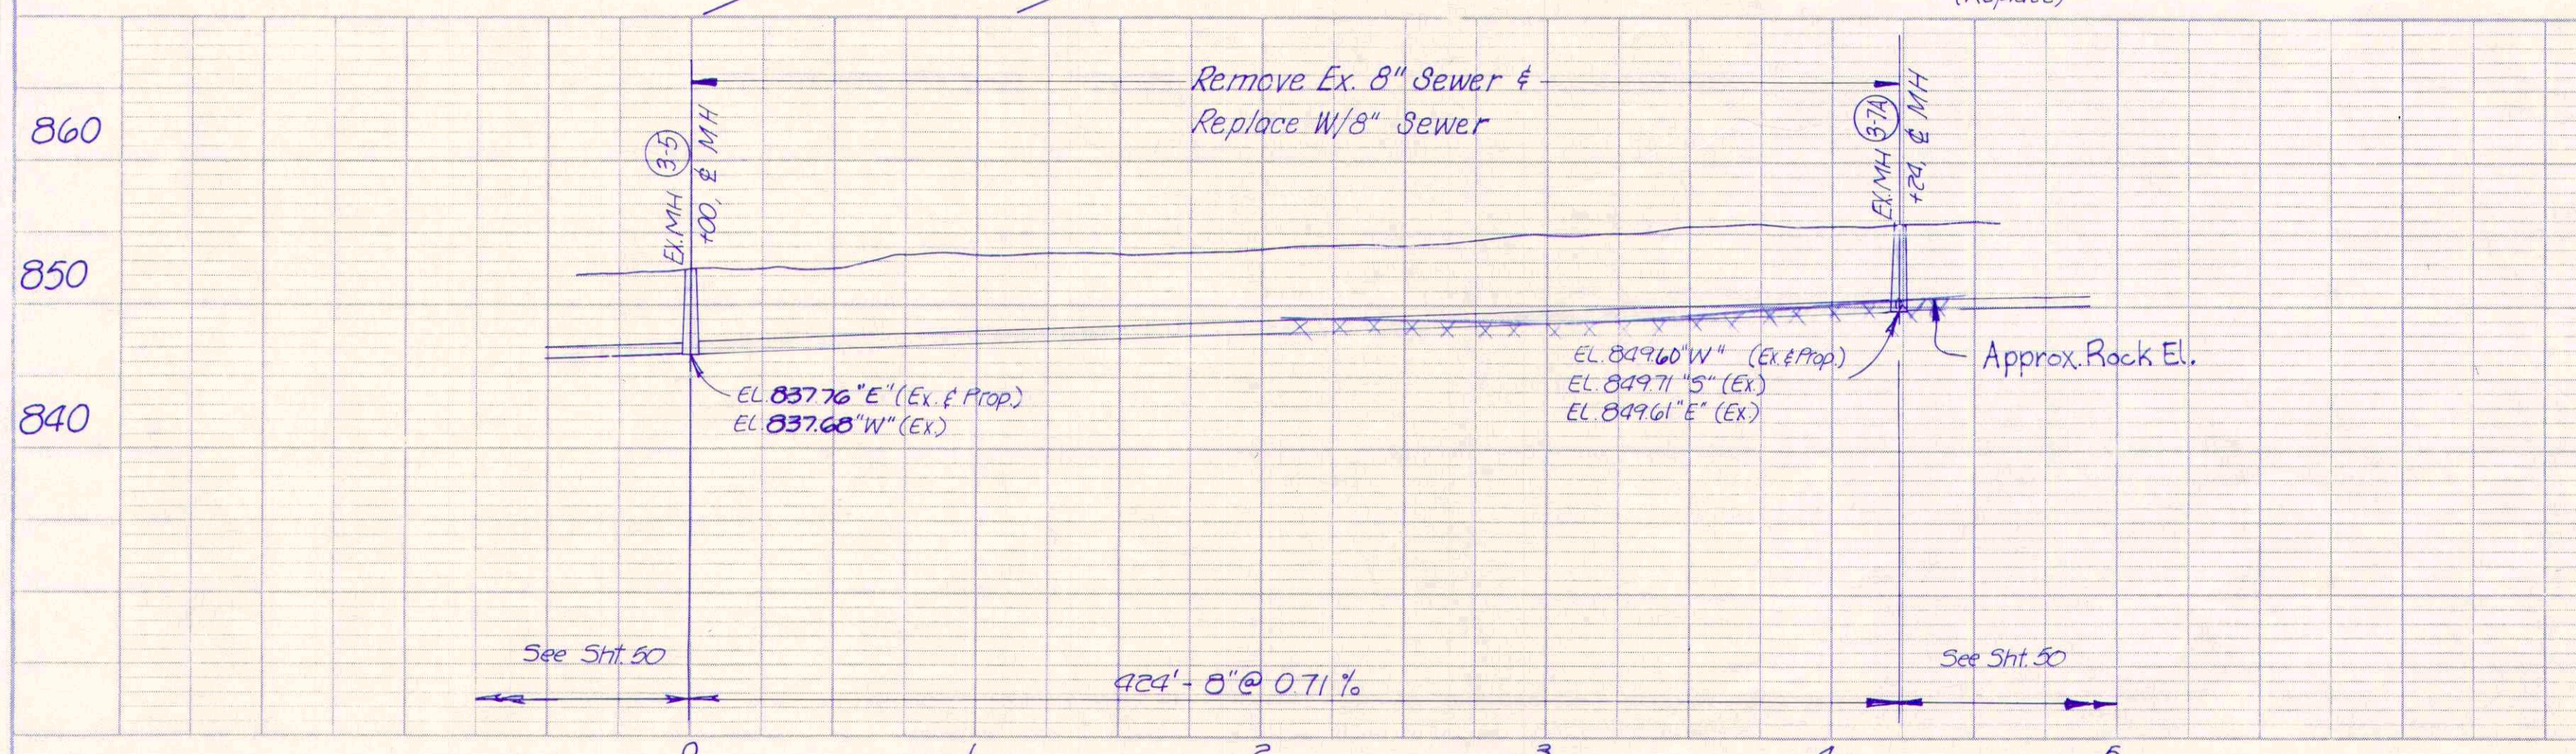

RECORD DRAWING

