


PLAN
 NOTE: SEE SHEET 54 FOR TOP RIGHT
 SEE SHEET 54 FOR LOWER RIGHT

PROFILE
 NOTE: SEE SHEET 54 FOR TOP RIGHT
 SEE SHEET 54 FOR LOWER RIGHT

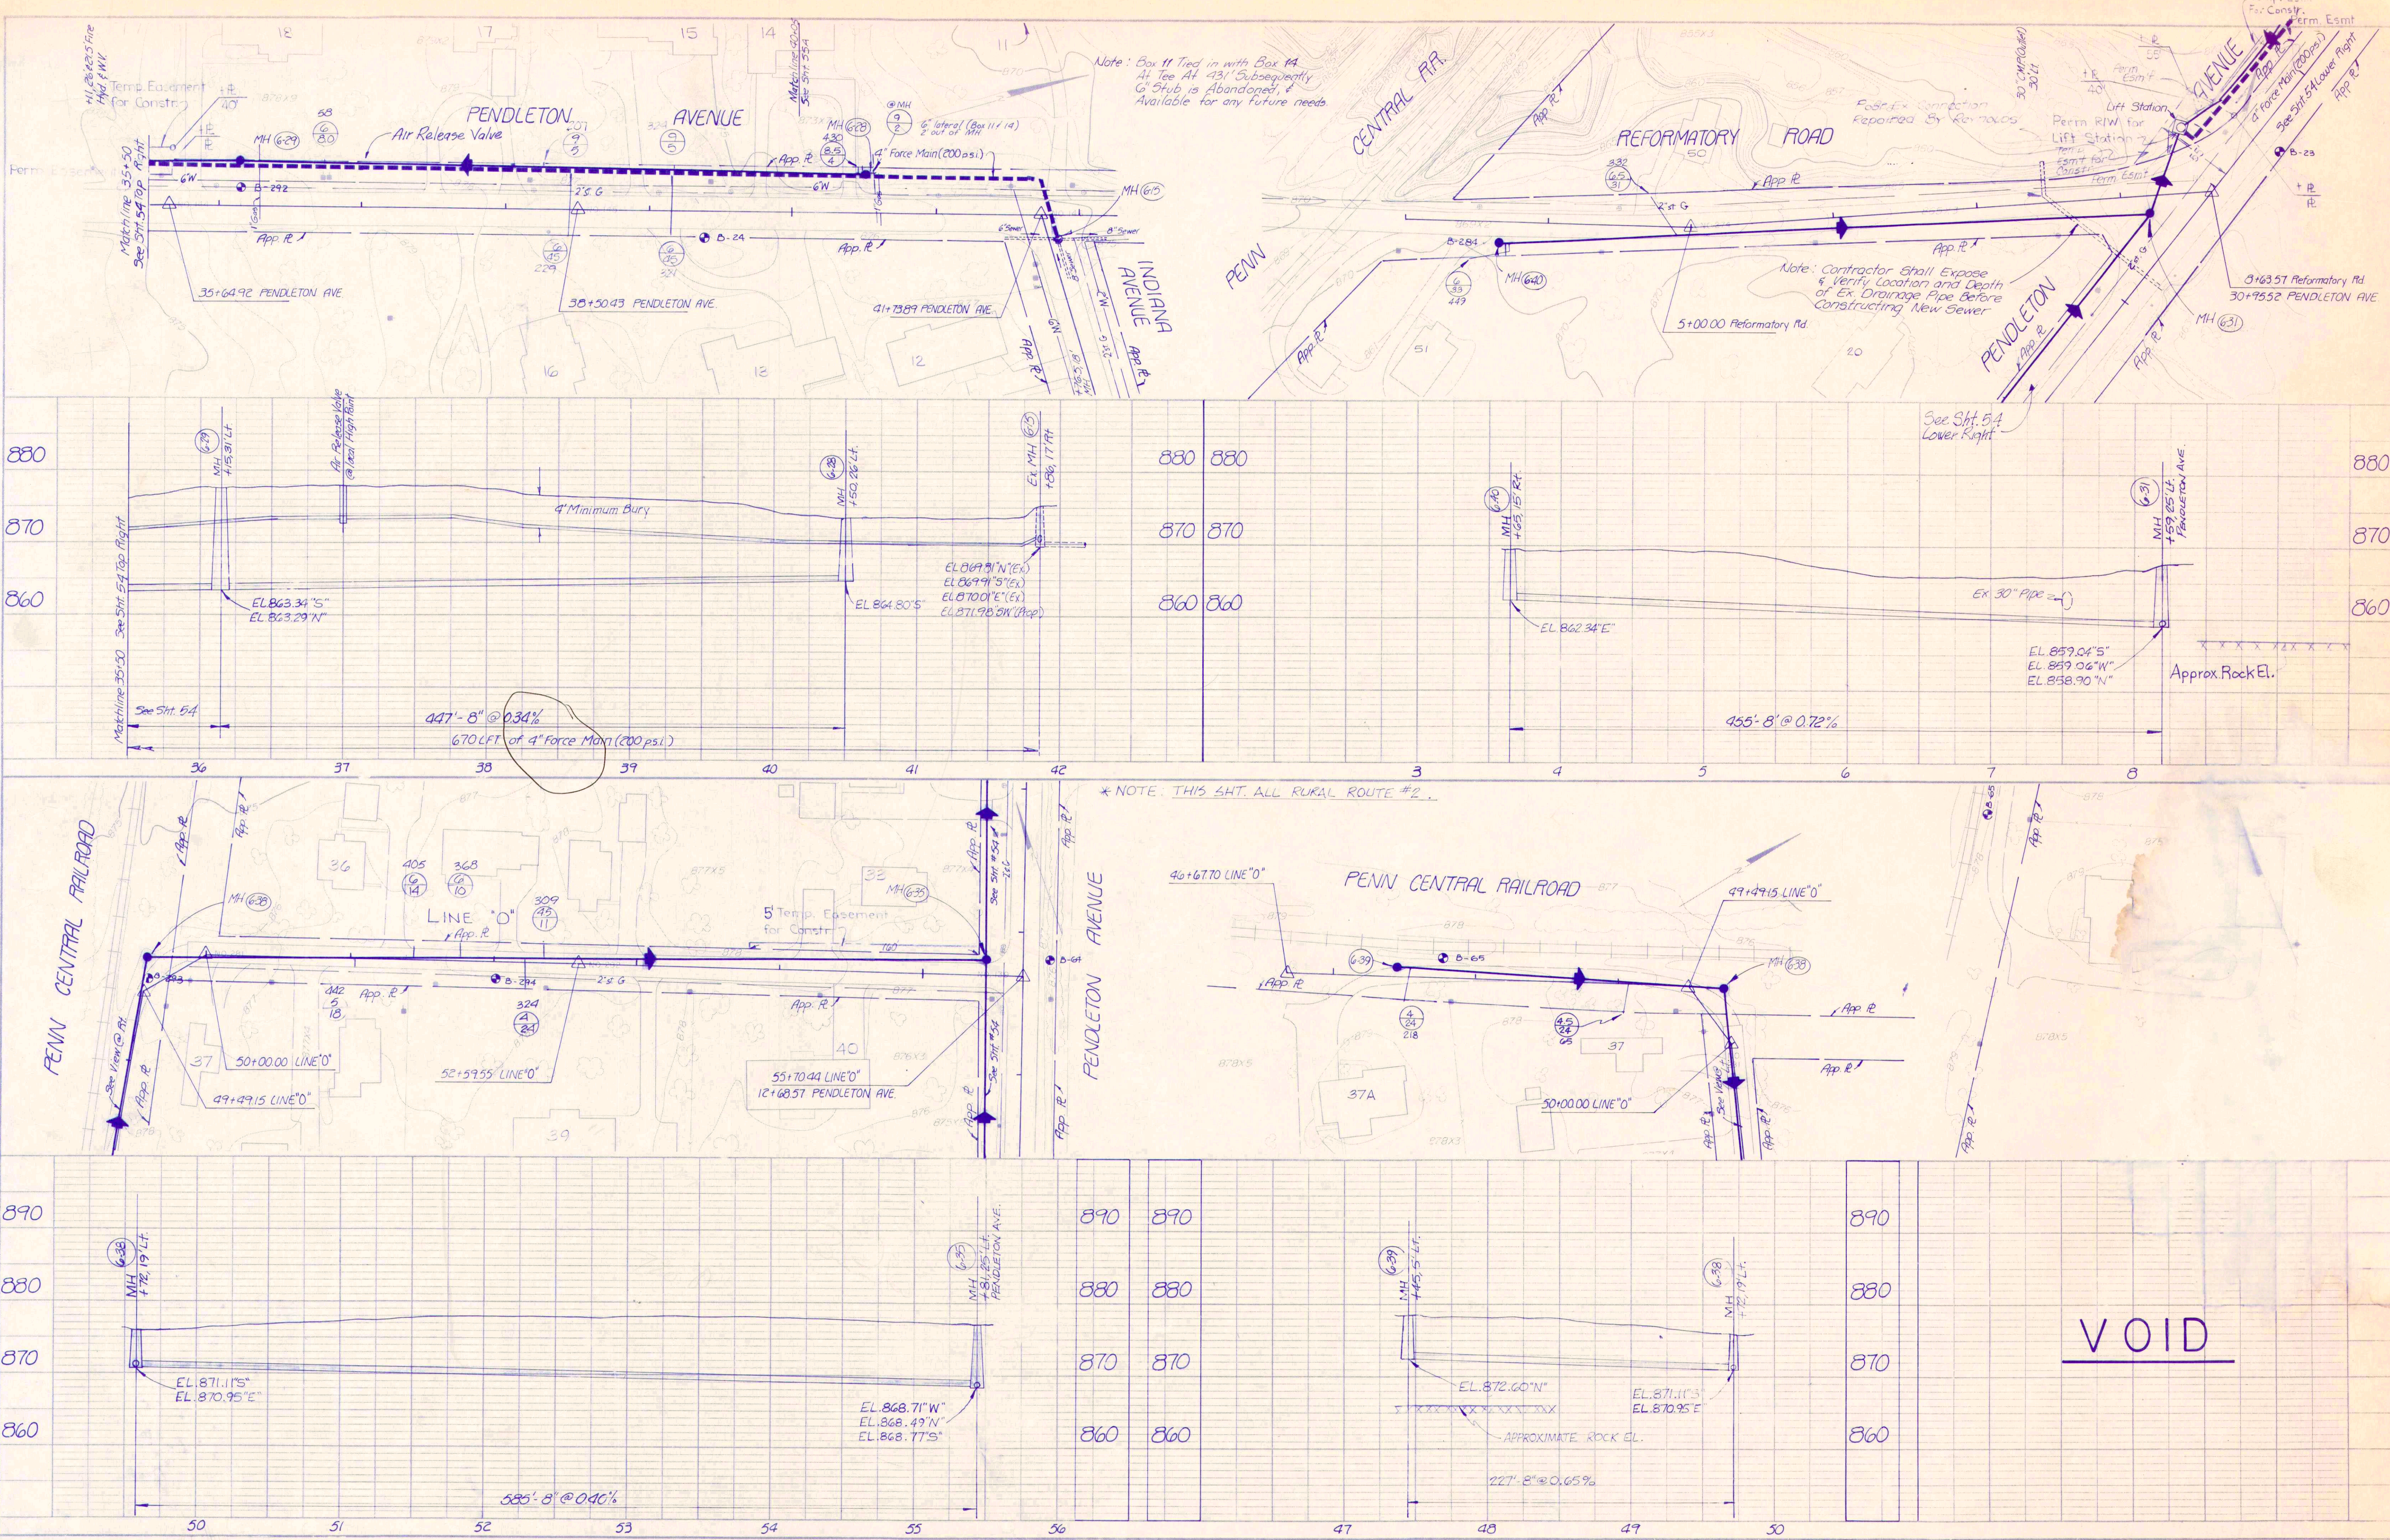

970.95'
 868.71'
 2.24'
 26.85'
 1.51'
 .0497'

REVISED 3-19-84
 CHANGED R/W AROUND
 LIFT STATION
 REVISED 8-1-84
 CHANGED GRADE FROM MH 629
 TO MH 625

RECORD DRAWING



PENDLETON AVE./REFORMATORY RD. & LINE "O"
 FALL CREEK R.W.D. PLAN & PROFILE SHEET
 HORIZ. 1"=50'
 VERT. 1"=10'
 BEAM, LONGEST & NEFF, INC.
 CONSULTING ENGINEERS
 INDIANAPOLIS, INDIANA
 55