


PLAN	DATE	BY	CHECKED
NO.			
NO.			

PROFILE	DATE	BY	CHECKED
NO.			
NO.			

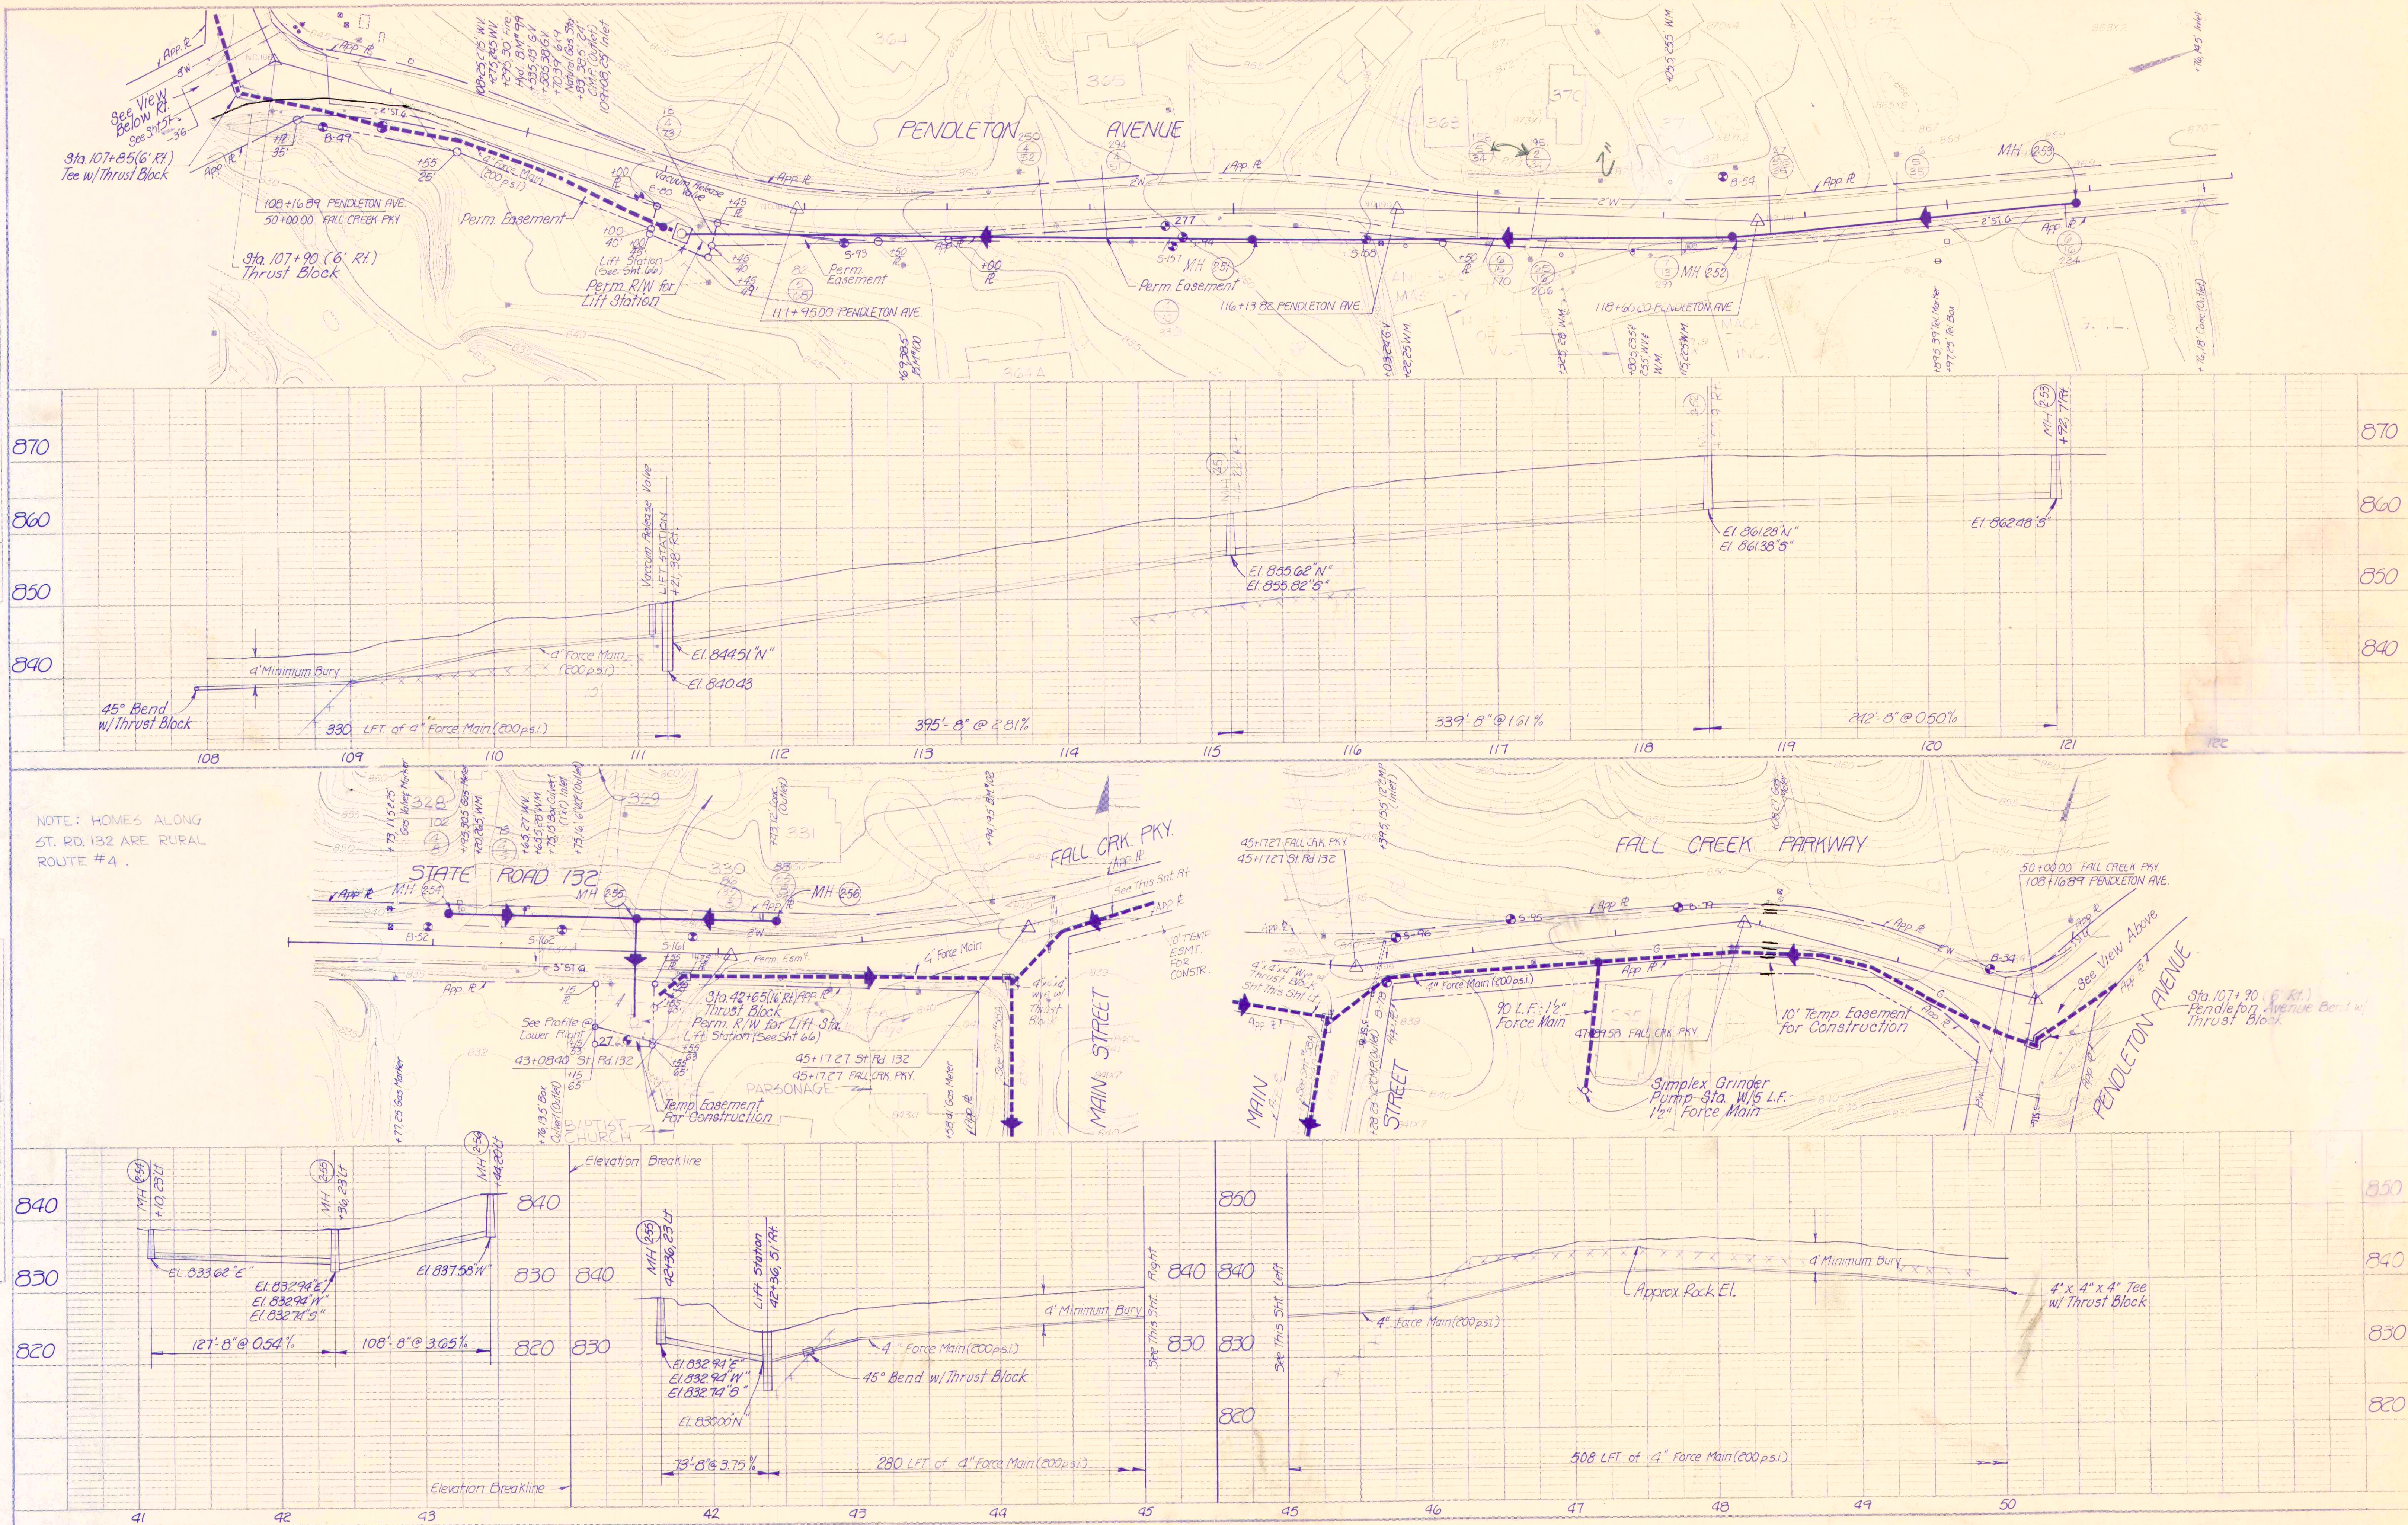

RECORD DRAWING

PENDLETON AVENUE STATE ROAD 132 / FALL CREEK PKY. FALL CREEK R.W.D. PLAN & PROFILE SHEET	
HORIZ. 1"=50'	BEAM, LONGEST & NEFF, INC.
VERT. 1"=10'	CONSULTING ENGINEERS INDIANAPOLIS, INDIANA

53