



PLAN	DATE	
	BY	
	NO.	
	NOTE BOOK	

PROFILE	DATE	
	BY	
	NO.	
	NOTE BOOK	

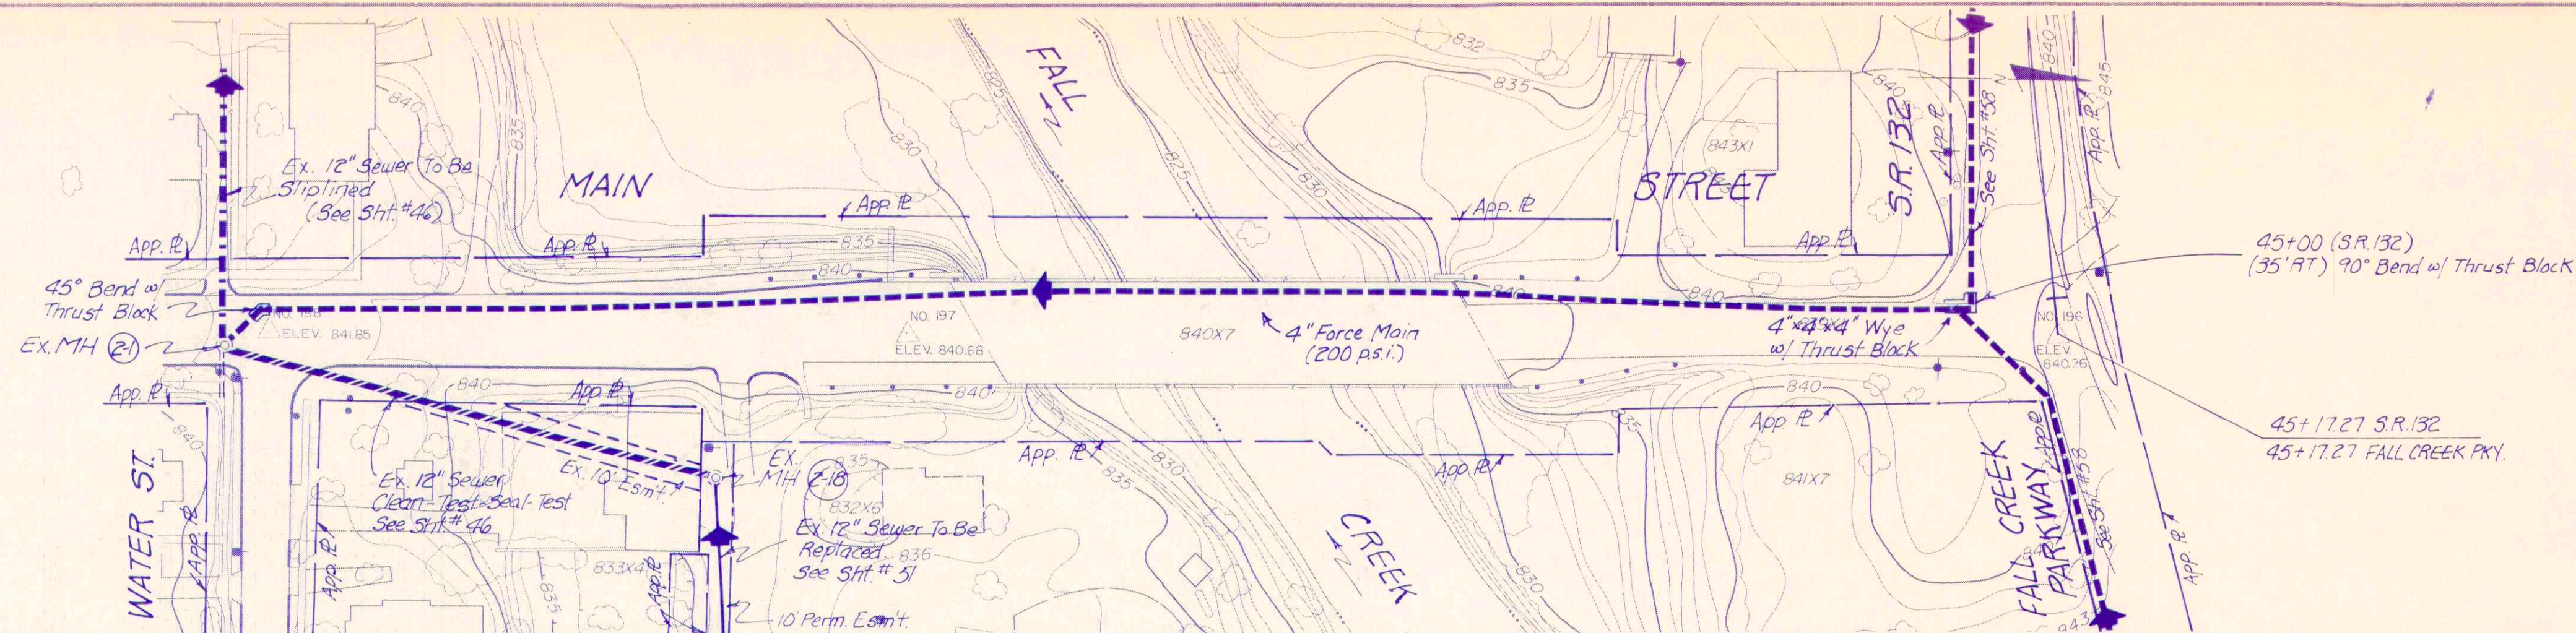

NOTE: 1. Proposed Force Main To Be Attached To Underside of Bridge (See Sht. 64 for Details)
2. Approx. 250' of Pipe Shall be Enclosed in a 2" Fiberglass Pipe Insulation. The Insulation Shall be Wrapped w/ Heat Shrinkable Covering To Form an Environmentally Tight Seal.

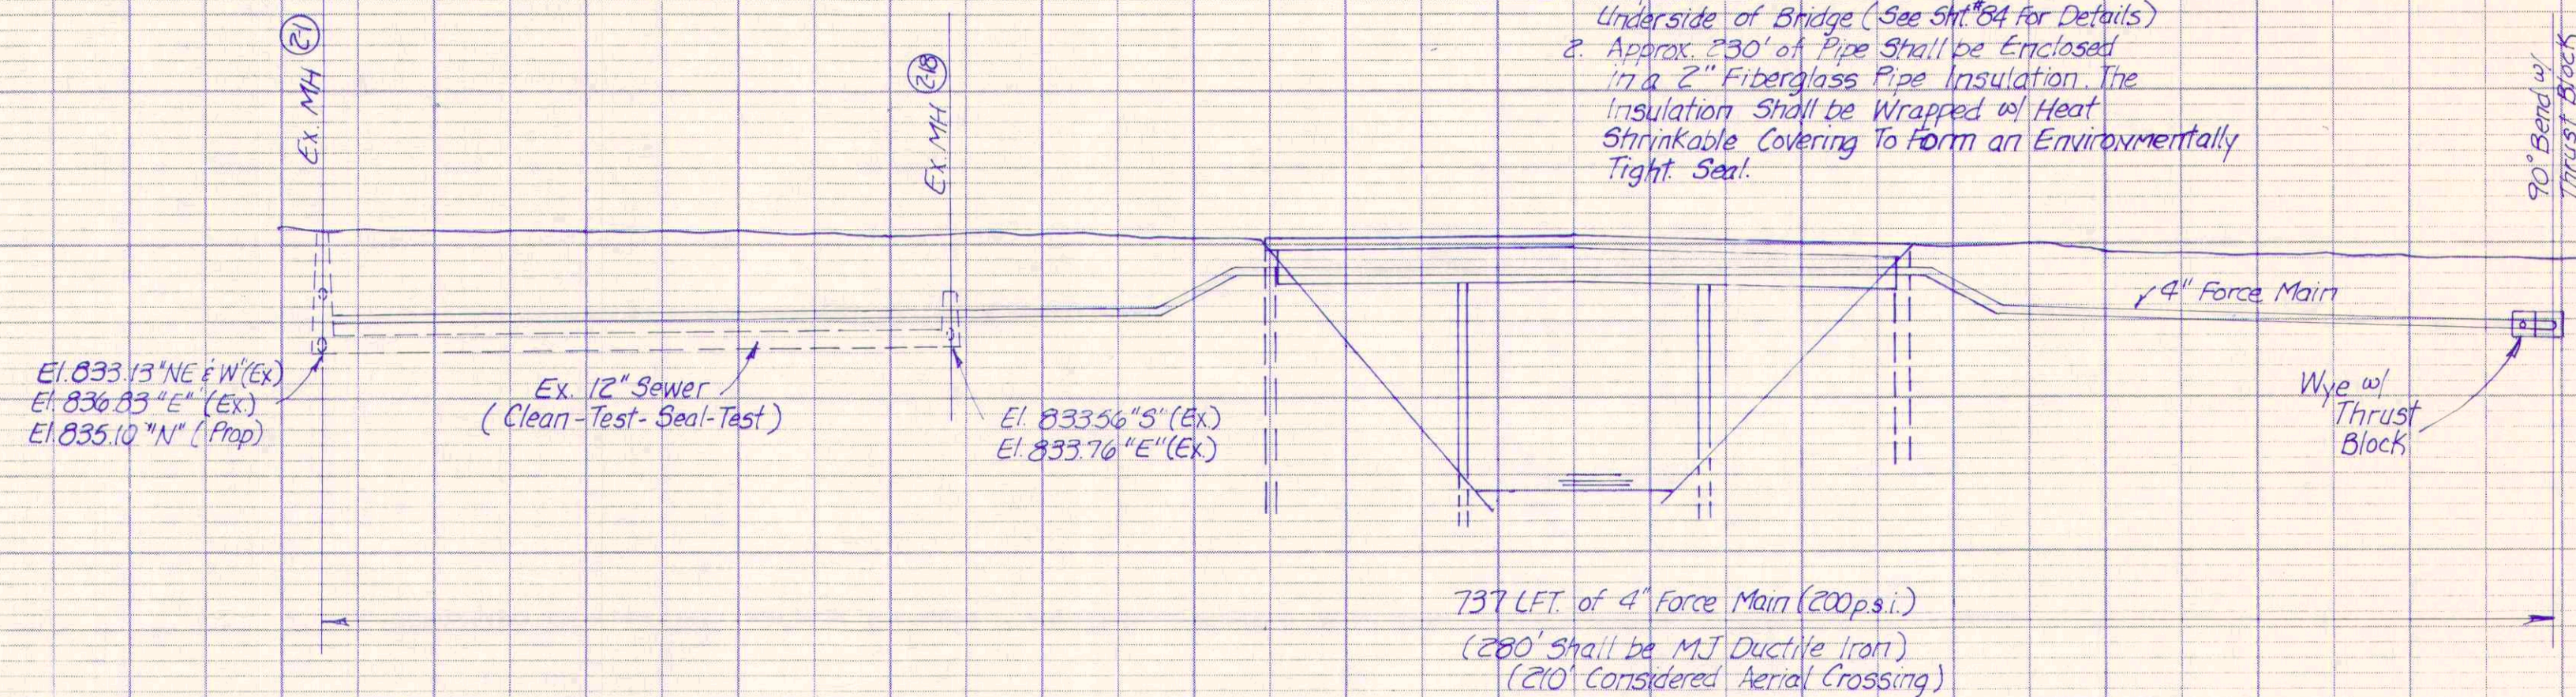

RECORD DRAWING

ER

3-30-83

MAIN STREET	
FALL CREEK R.W.D. PLAN & PROFILE	SHEET
HORIZ. 1"=50'	BEAM, LONGEST & NEFF, INC.
VERT. 1"=10'	CONSULTING ENGINEERS
	INDIANAPOLIS, INDIANA
	58A