


PLAN	REVISION	DATE
NO.	NO.	DATE
1	1	1

PROFILE	REVISION	DATE
NO.	NO.	DATE
1	1	1



RECORD DRAWING

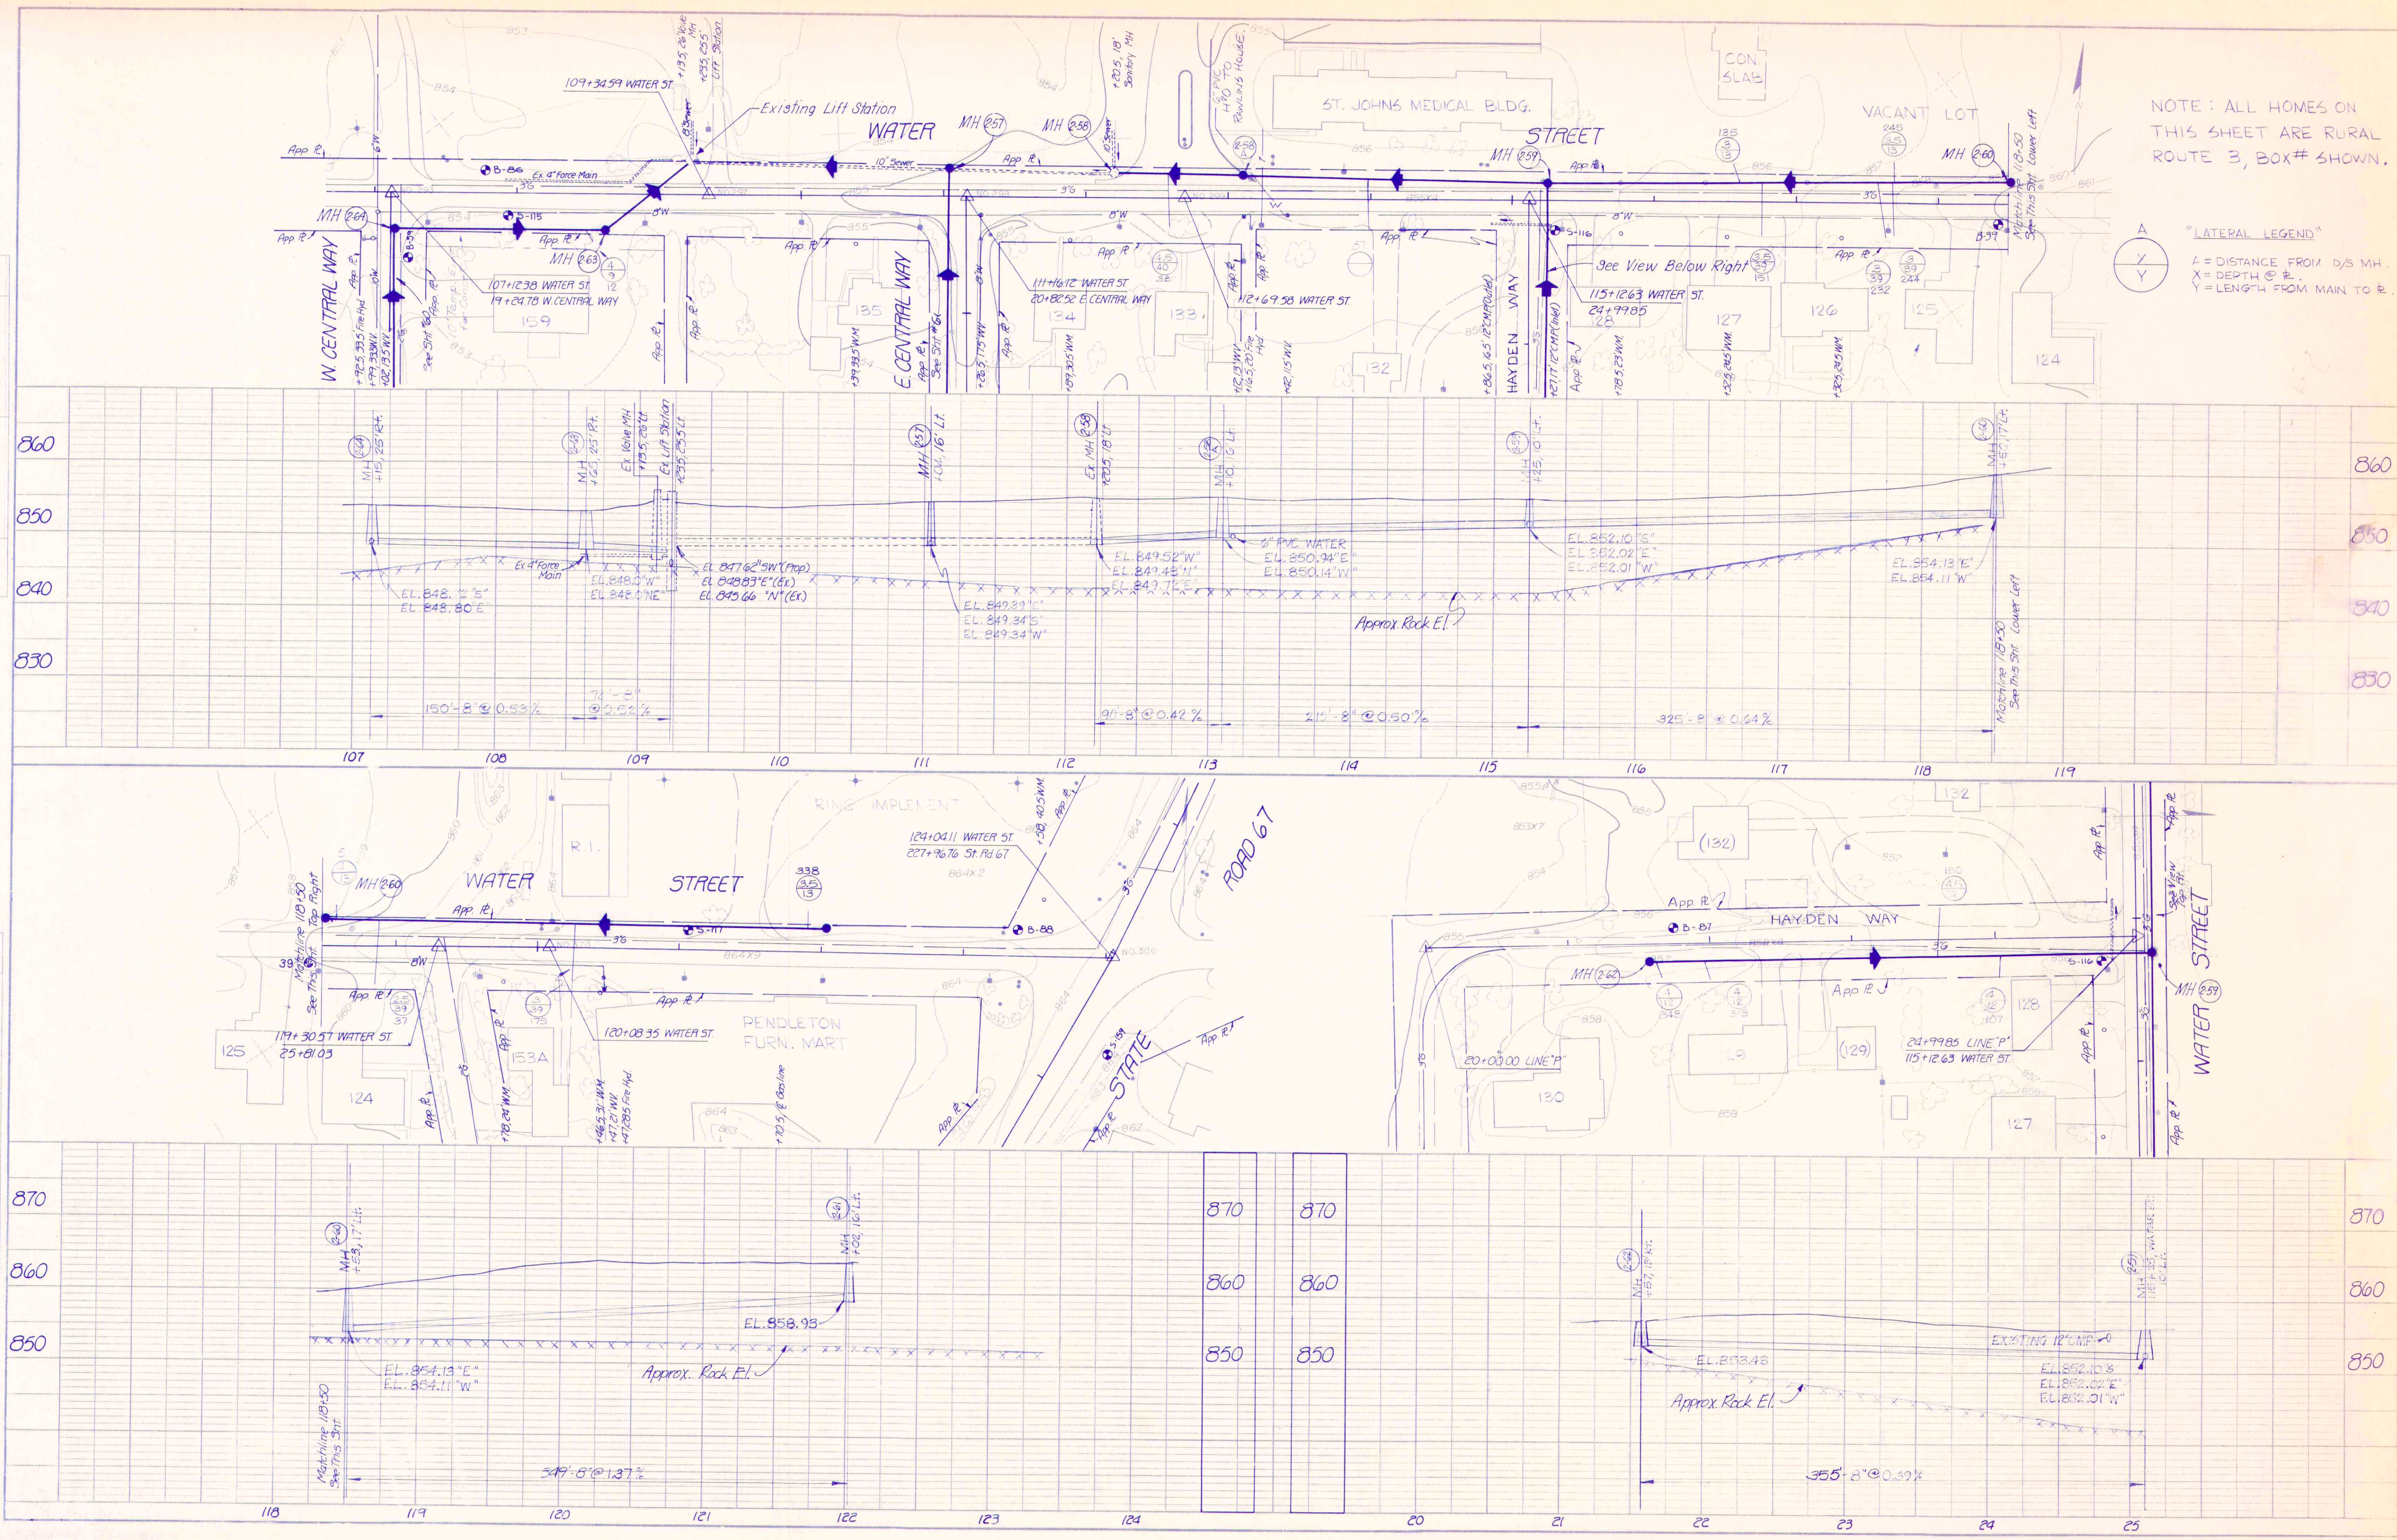