
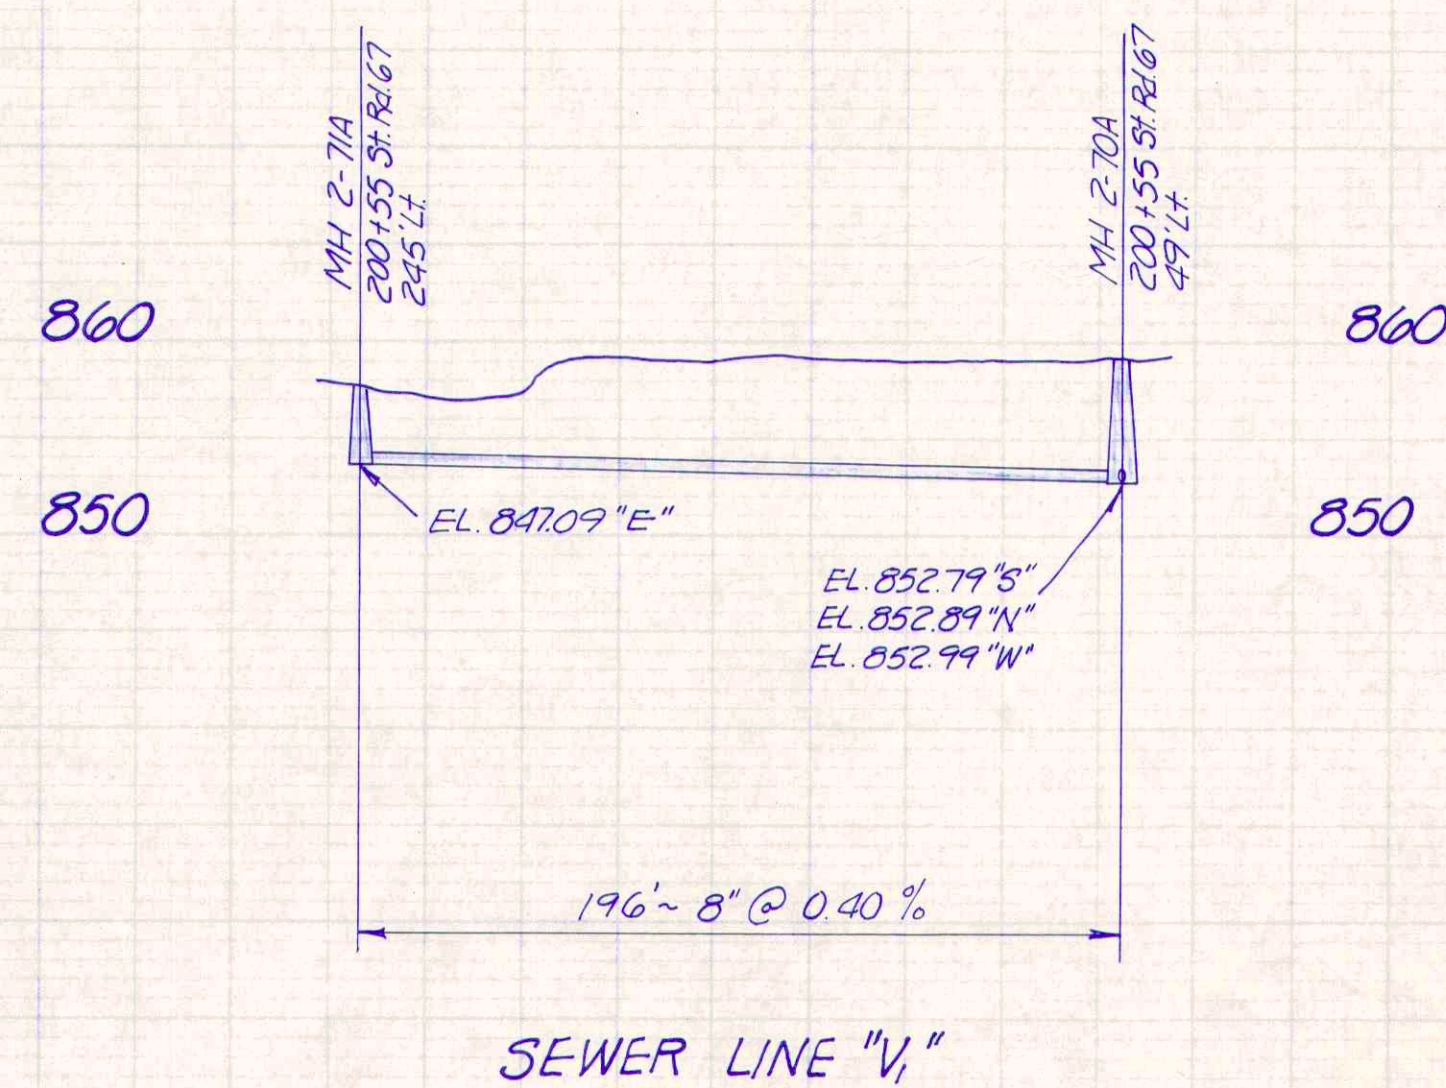


PLAN	DATE	
	BY	
	CHECKED	
	NOTED	
NOTE BOOK, ALIGNED, CHECKED		
No. 1		

PROFILE	DATE	
	BY	
	CHECKED	
	NOTED	
NOTE BOOK, GRADE, CH. 100		
No. 1		

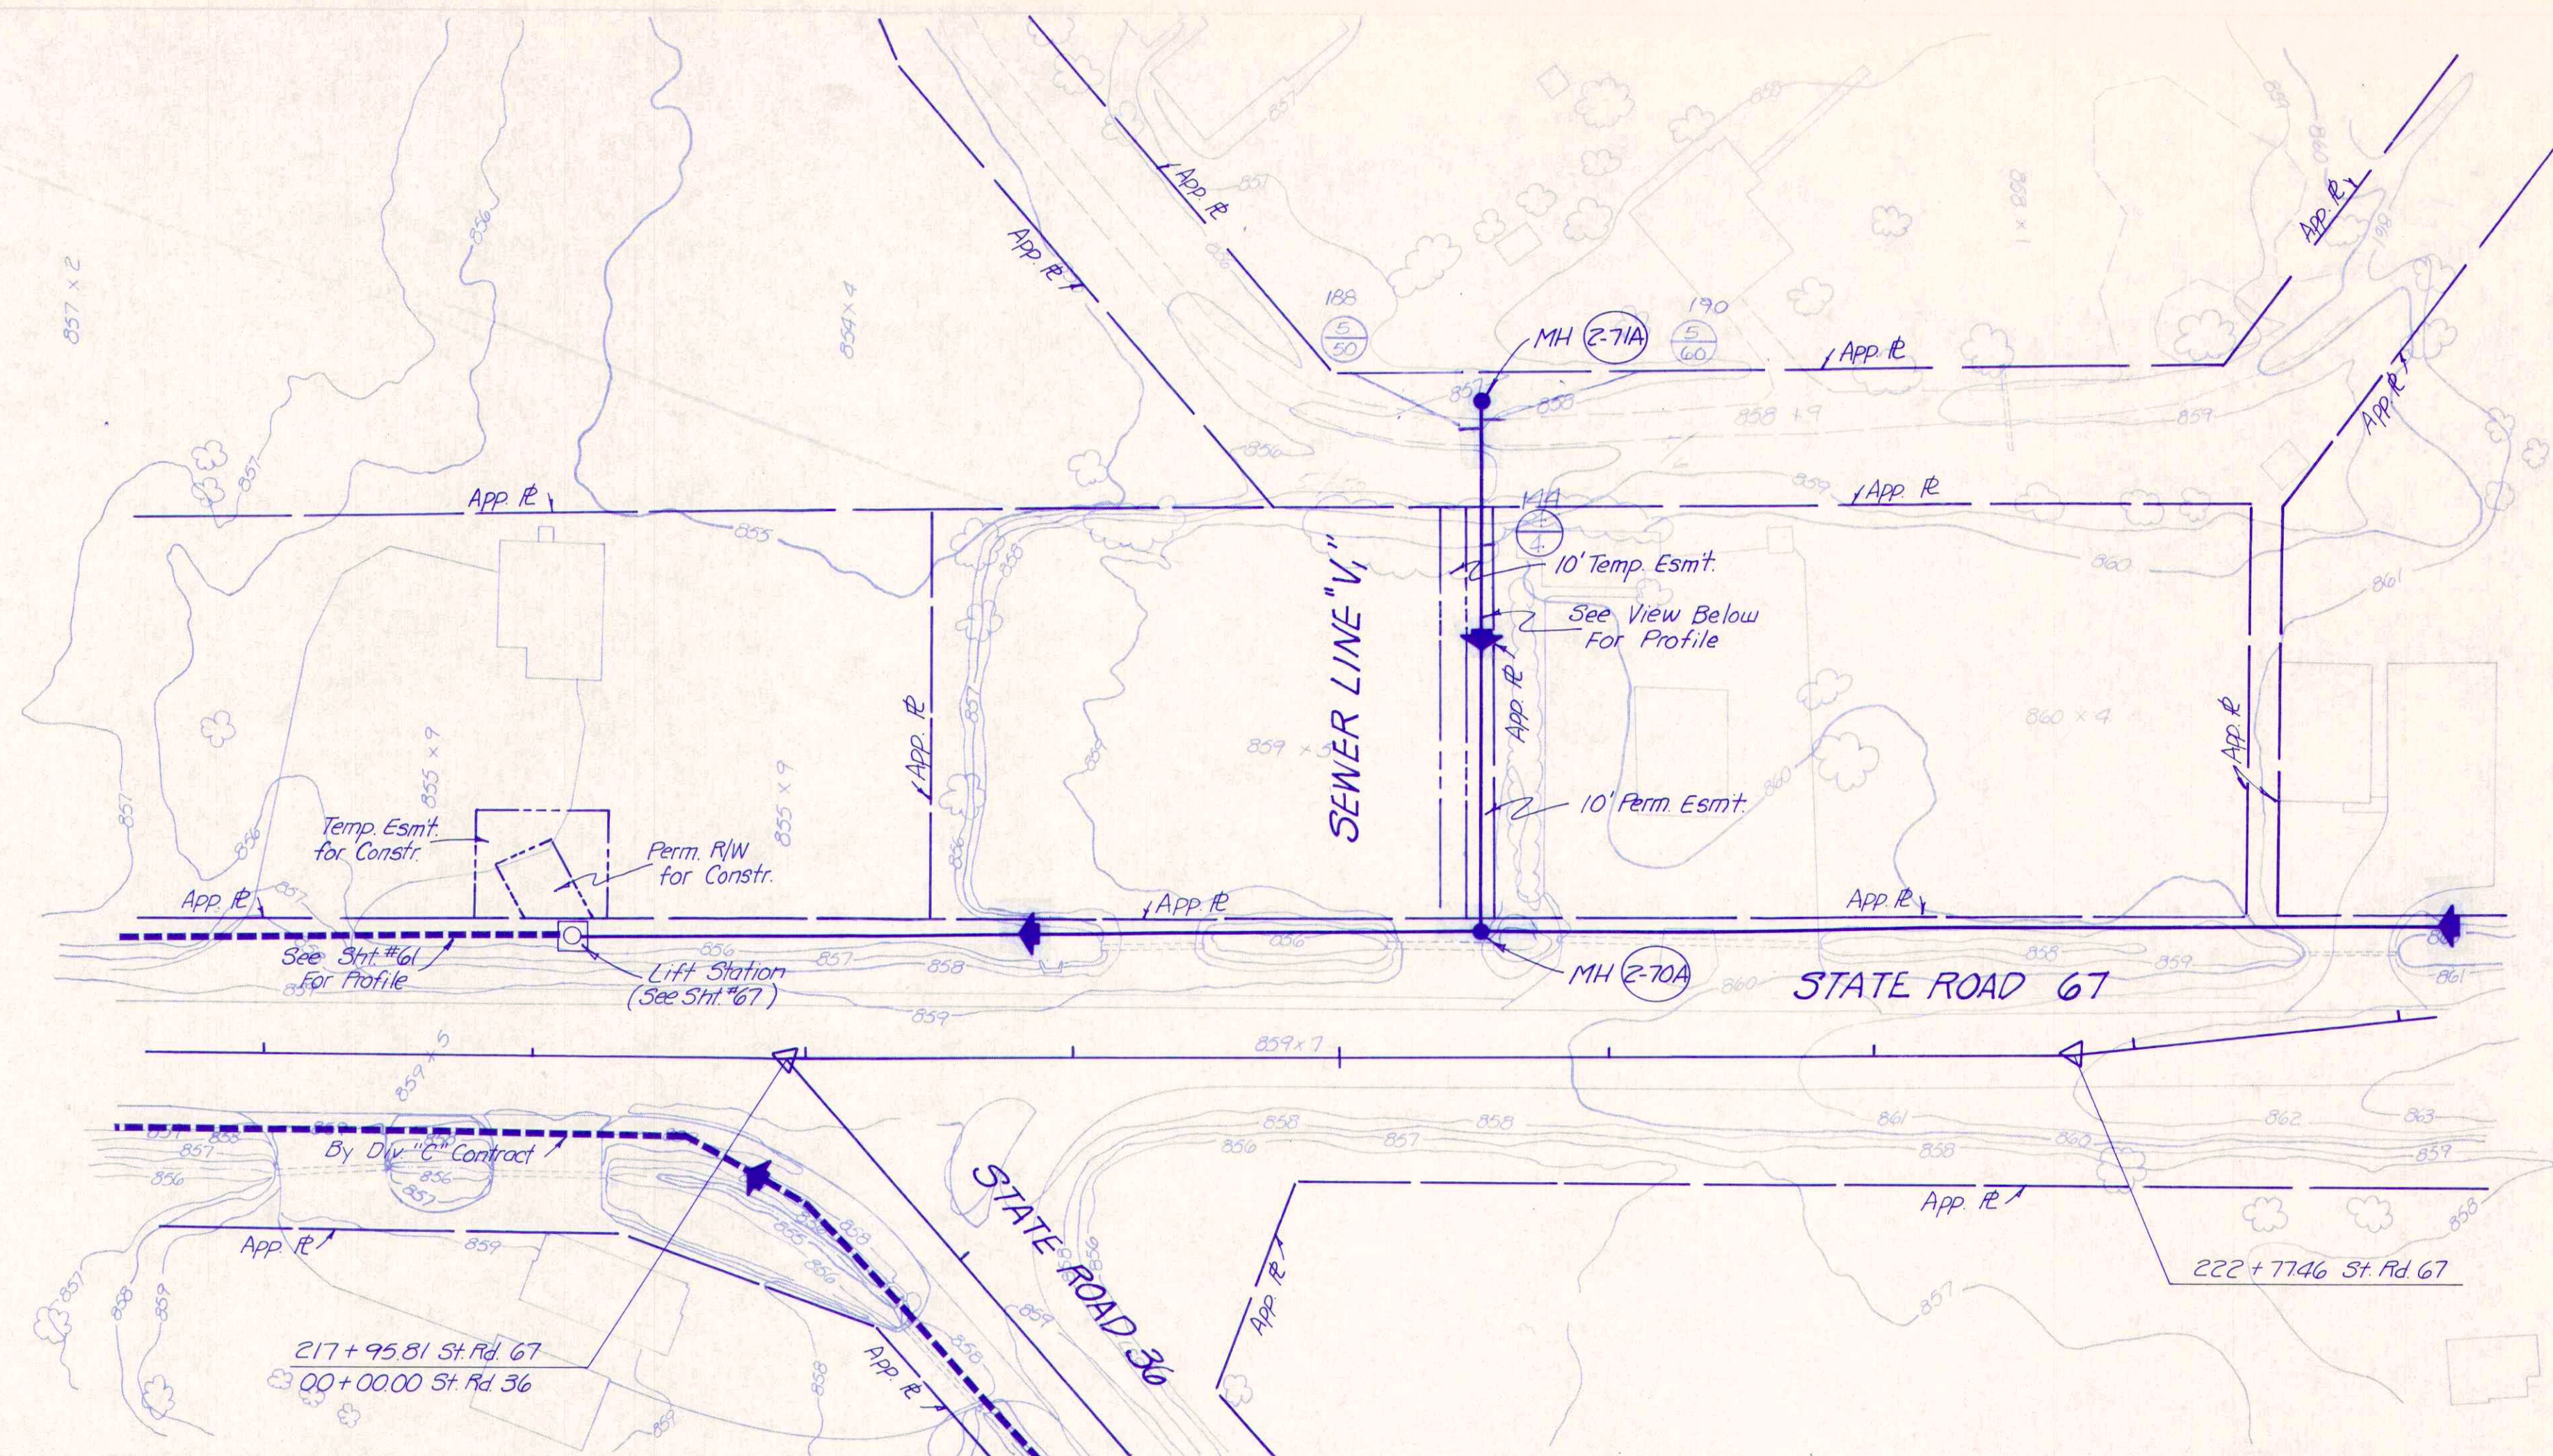

STATE ROAD 67		
FALL CREEK R.W.D. PLAN & PROFILE		
HORIZ. 1" = 50'	BEAM, LONGEST & NEFF, INC.	SHEET
VERT. 1" = 10'	CONSULTING ENGINEERS	60A
INDIANAPOLIS, INDIANA		

RECORD DRAWING