


PLAN	DATE	BY	CHECKED
DESIGNED			
DRAWN			
NOTED			
GRADES CHECKED			
STRUCTURE NOTATIONS			
NO.			

PROFILE	DATE	BY	CHECKED
DESIGNED			
DRAWN			
NOTED			
GRADES CHECKED			
STRUCTURE NOTATIONS			
NO.			



RECORD DRAWING

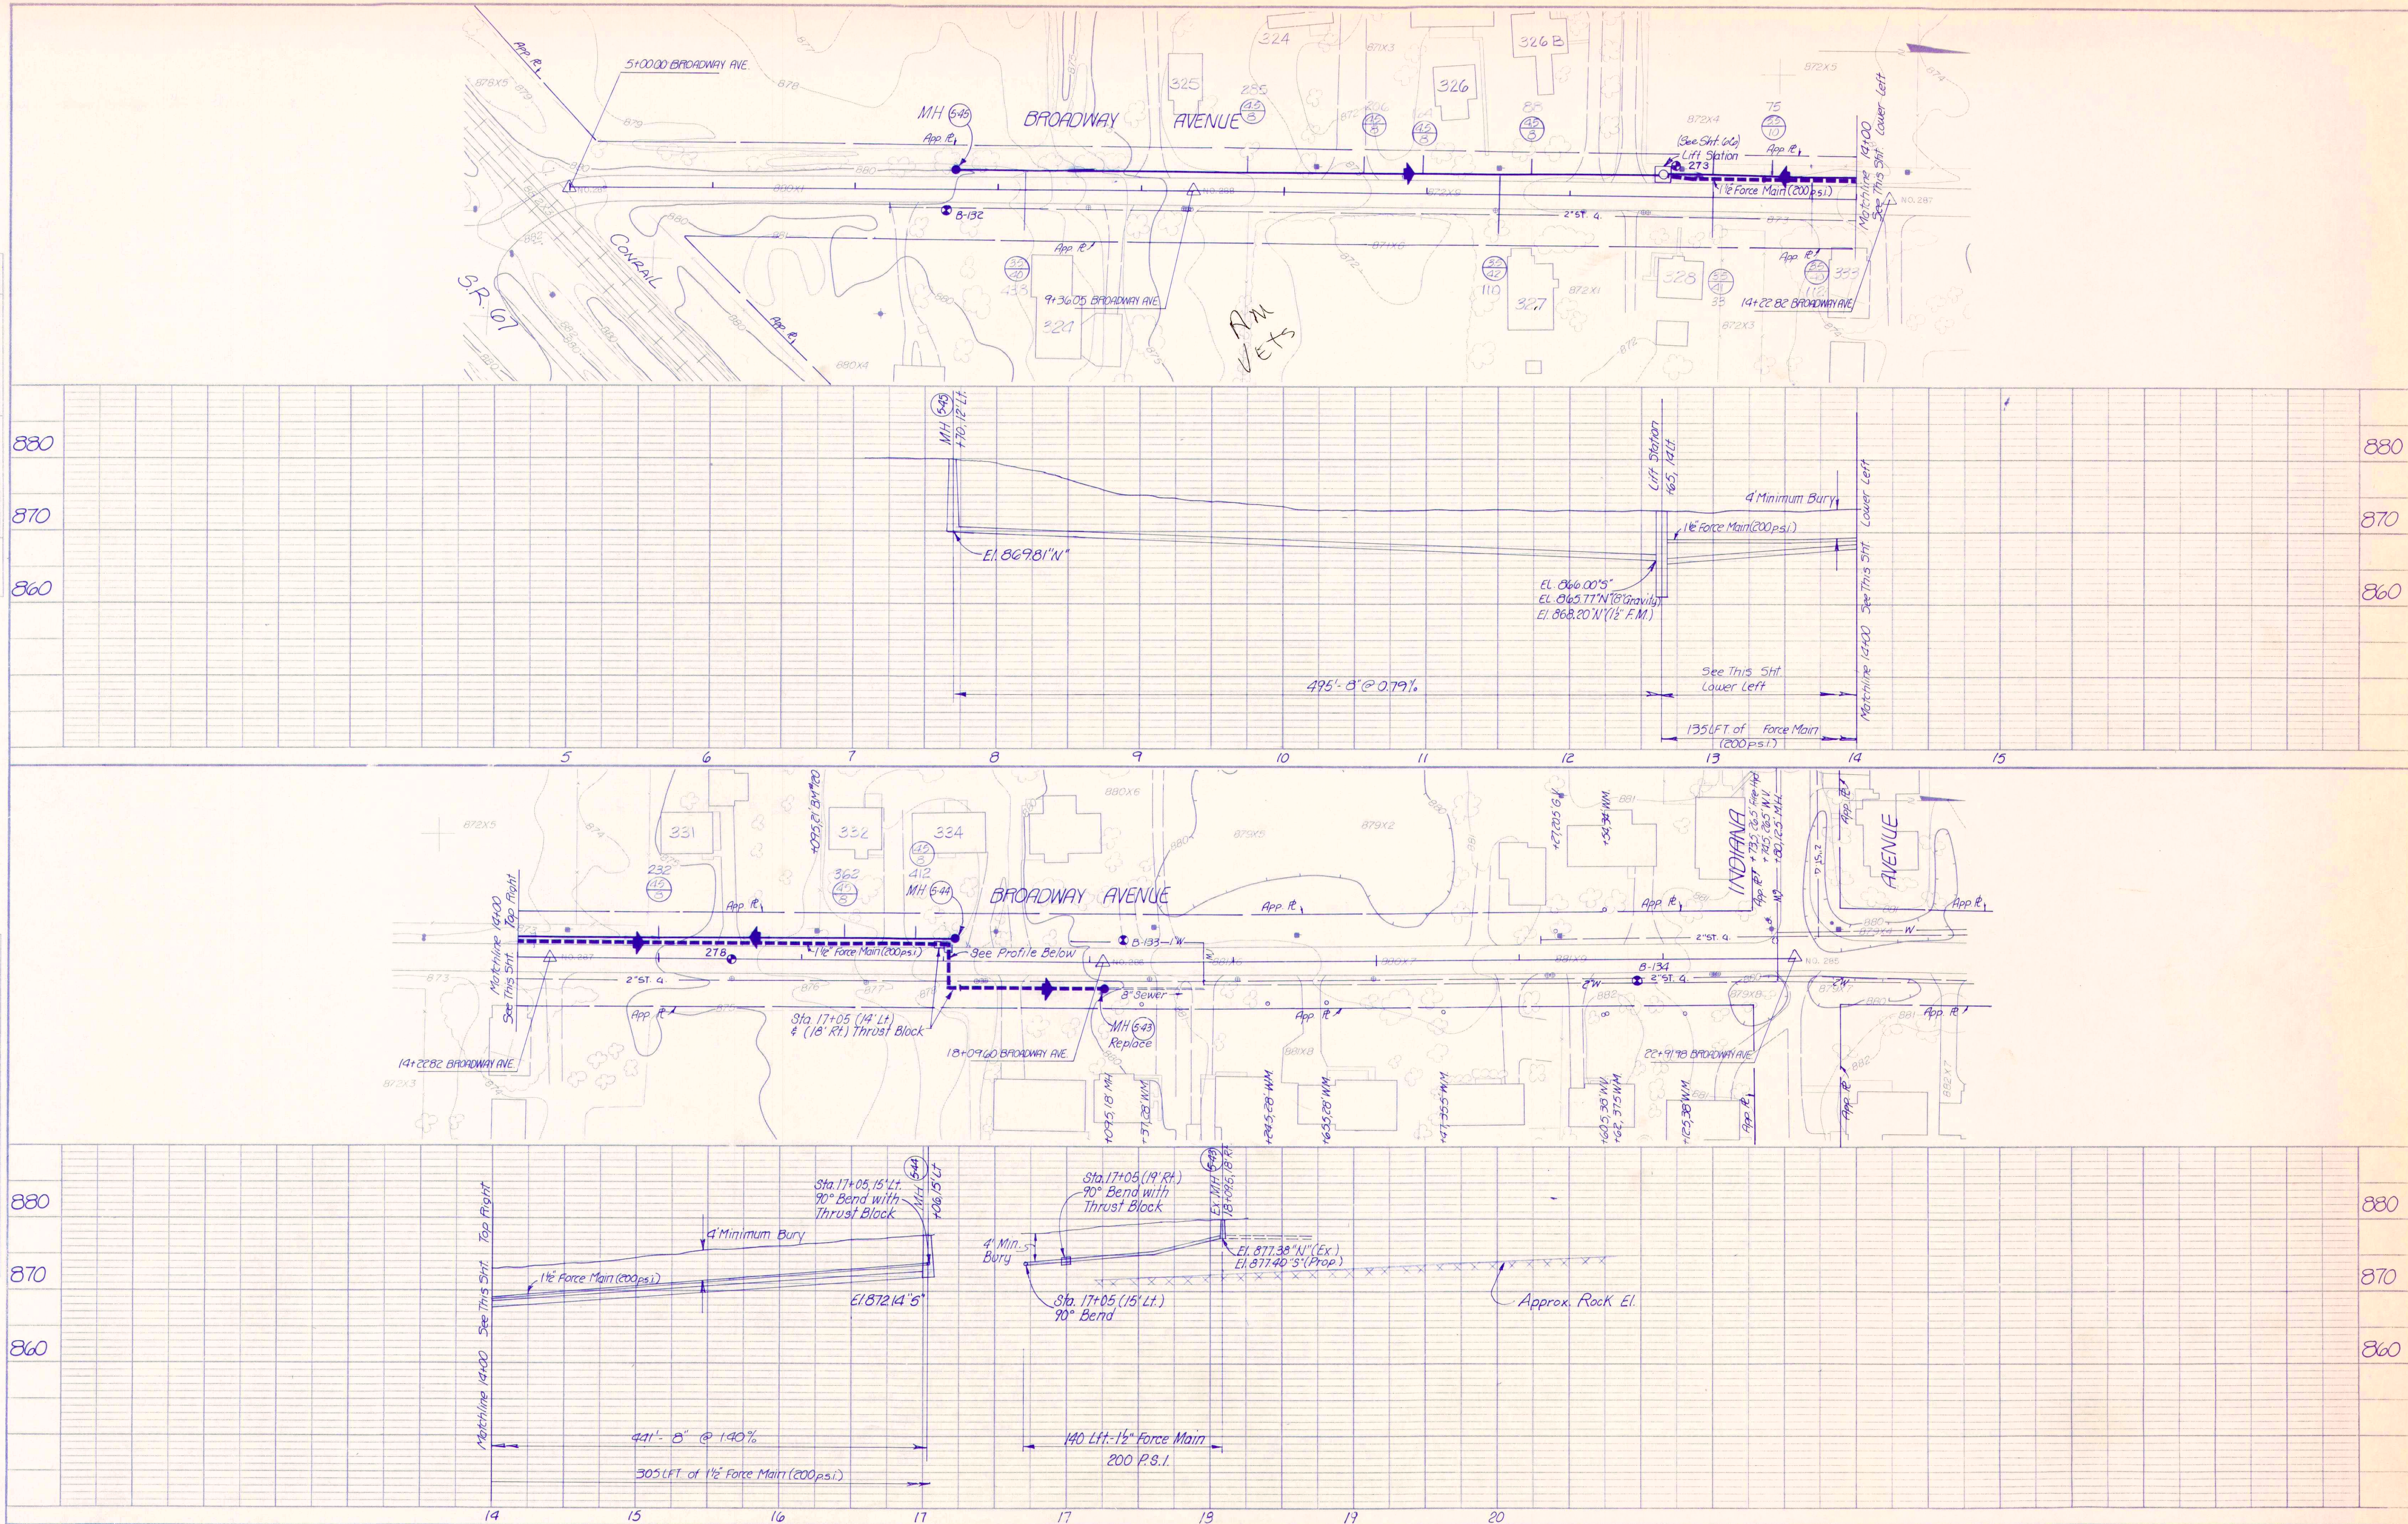

BROADWAY AVENUE		SHEET
FALL CREEK R.W.D. PLAN & PROFILE		
HORIZ. 1"=50'	BEAM, LONGEST & NEFF, INC.	
VERT. 1"=10'	CONSULTING ENGINEERS	
	INDIANAPOLIS, INDIANA	63