

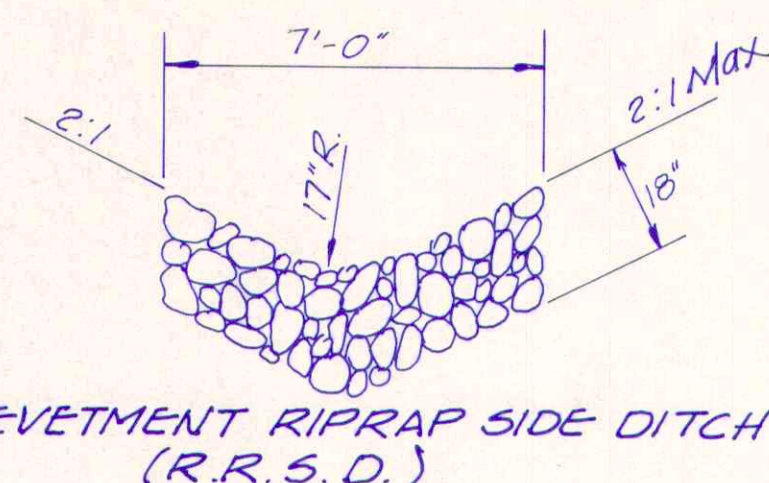
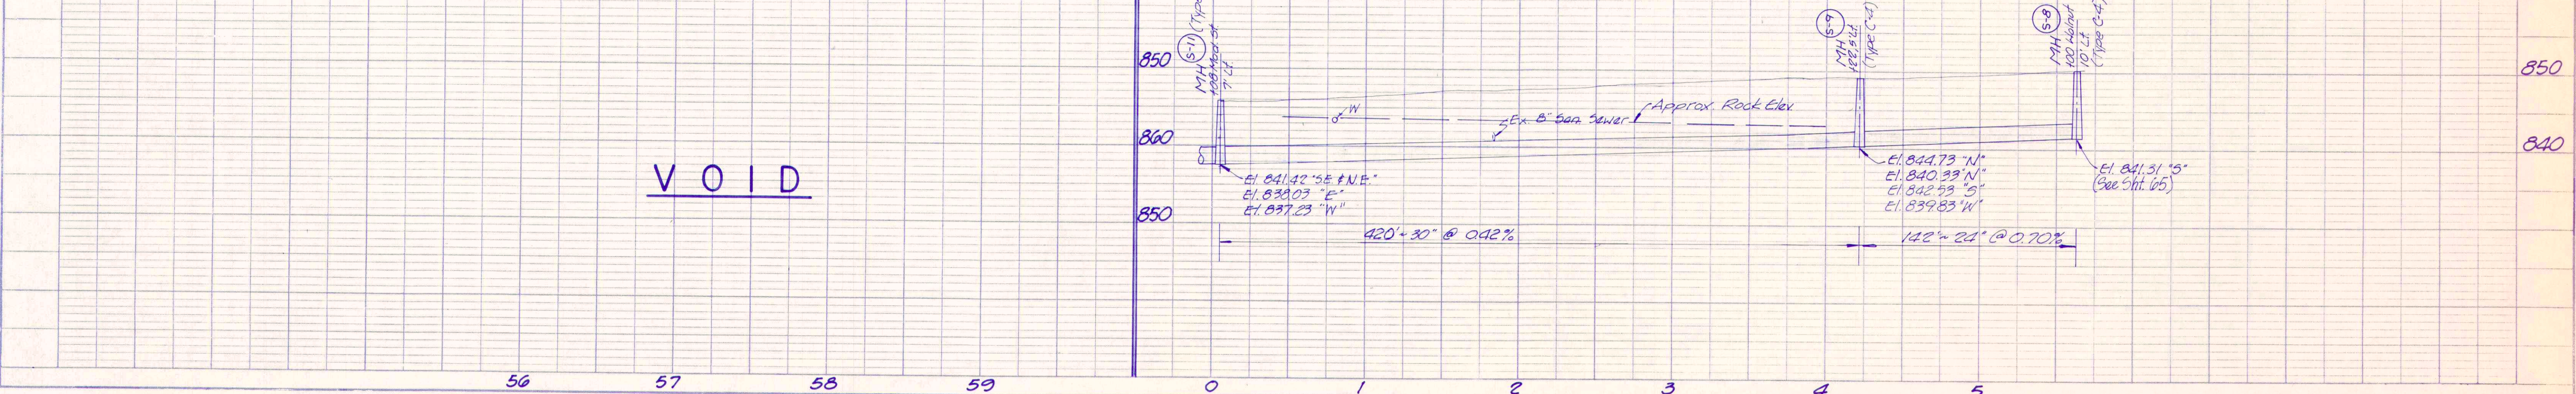


PLAN	DATE	BY	CHKD
SUPPLEMENTAL NOTES NO.			

PROFILE	DATE	BY	CHKD
SUPPLEMENTAL NOTES NO.			

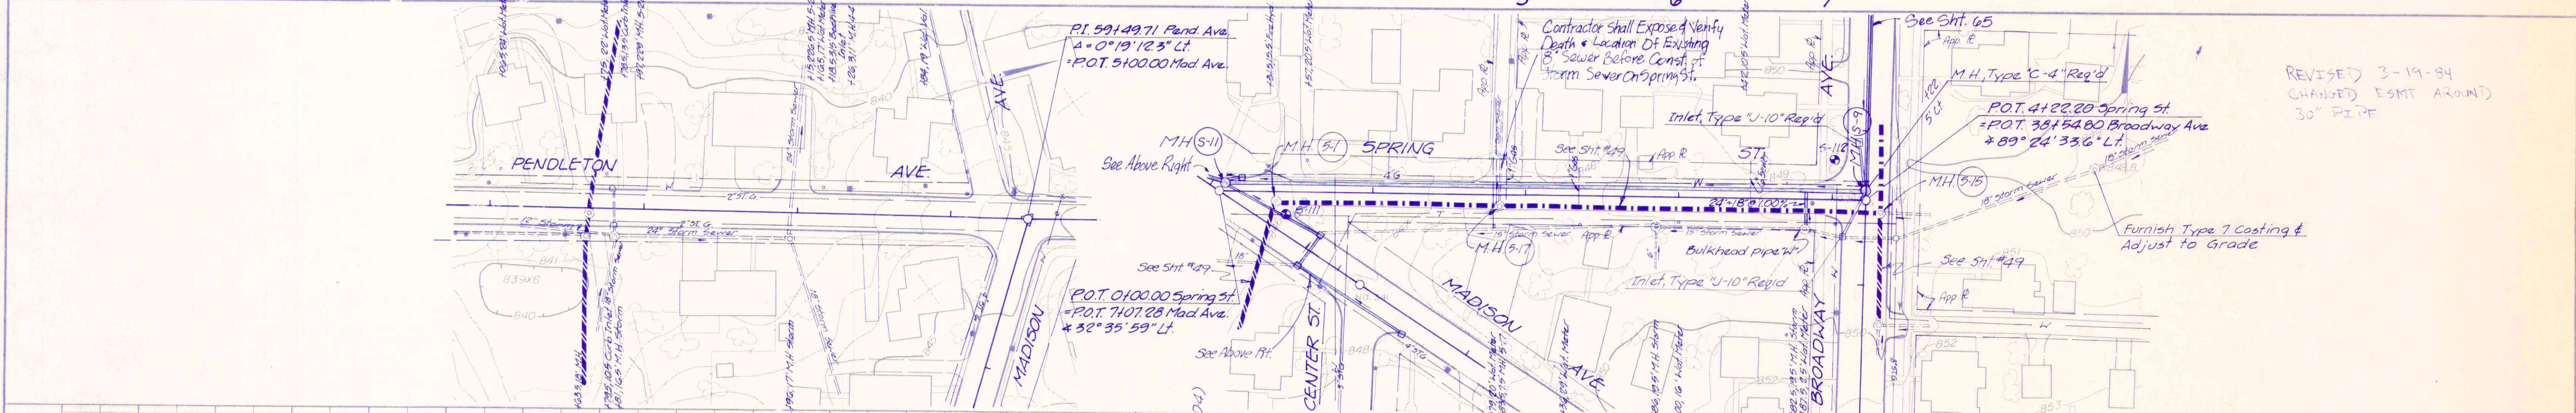

REVELMENT RIPRAP SIDE DITCH (R.R.S.D.)

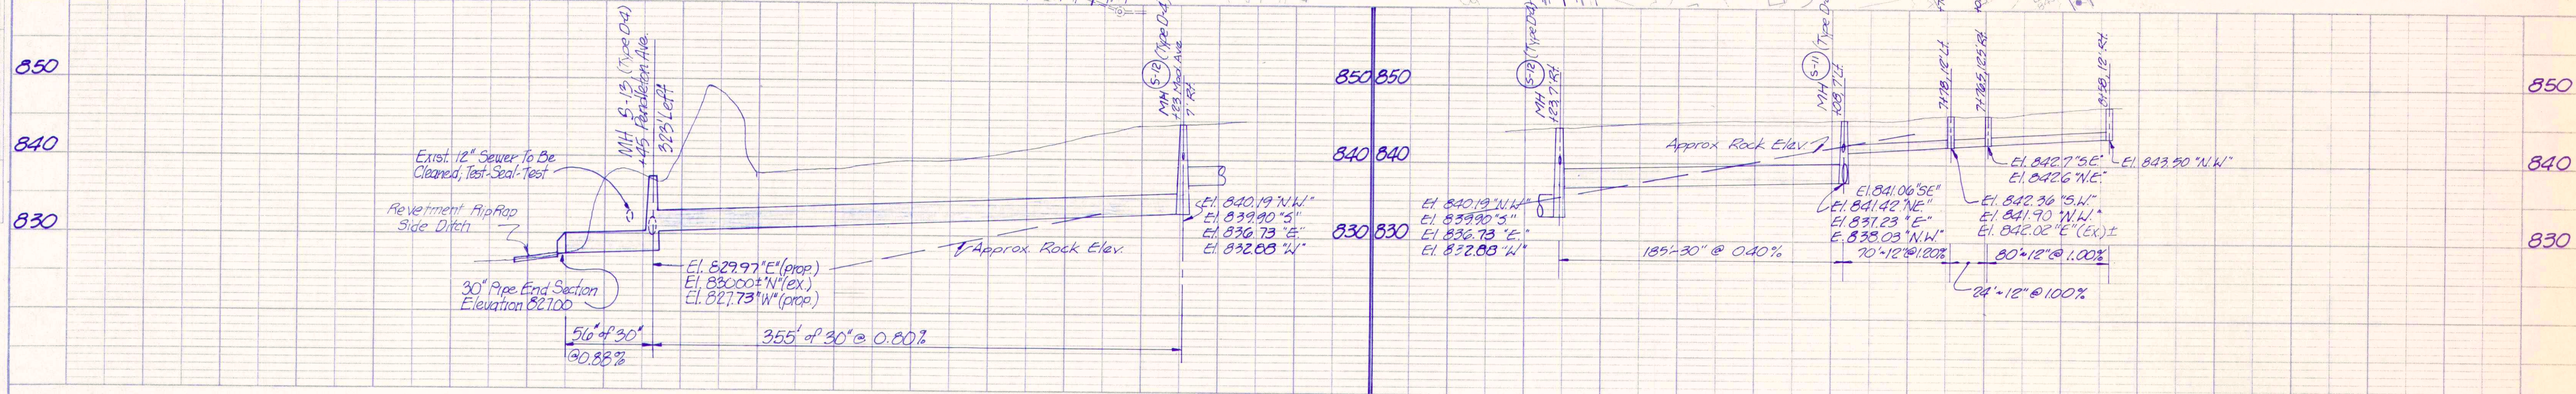

RECORD DRAWING



MADISON AVE. / PENDLETON AVE. SPRING STREET	
FALL CREEK R.W.D. PLAN & PROFILE SHEET	
HORIZ. 1"=50'	BEAM, LONGEST & NEFF, INC.
VERT. 1"=10'	CONSULTING ENGINEERS
	INDIANAPOLIS, INDIANA