




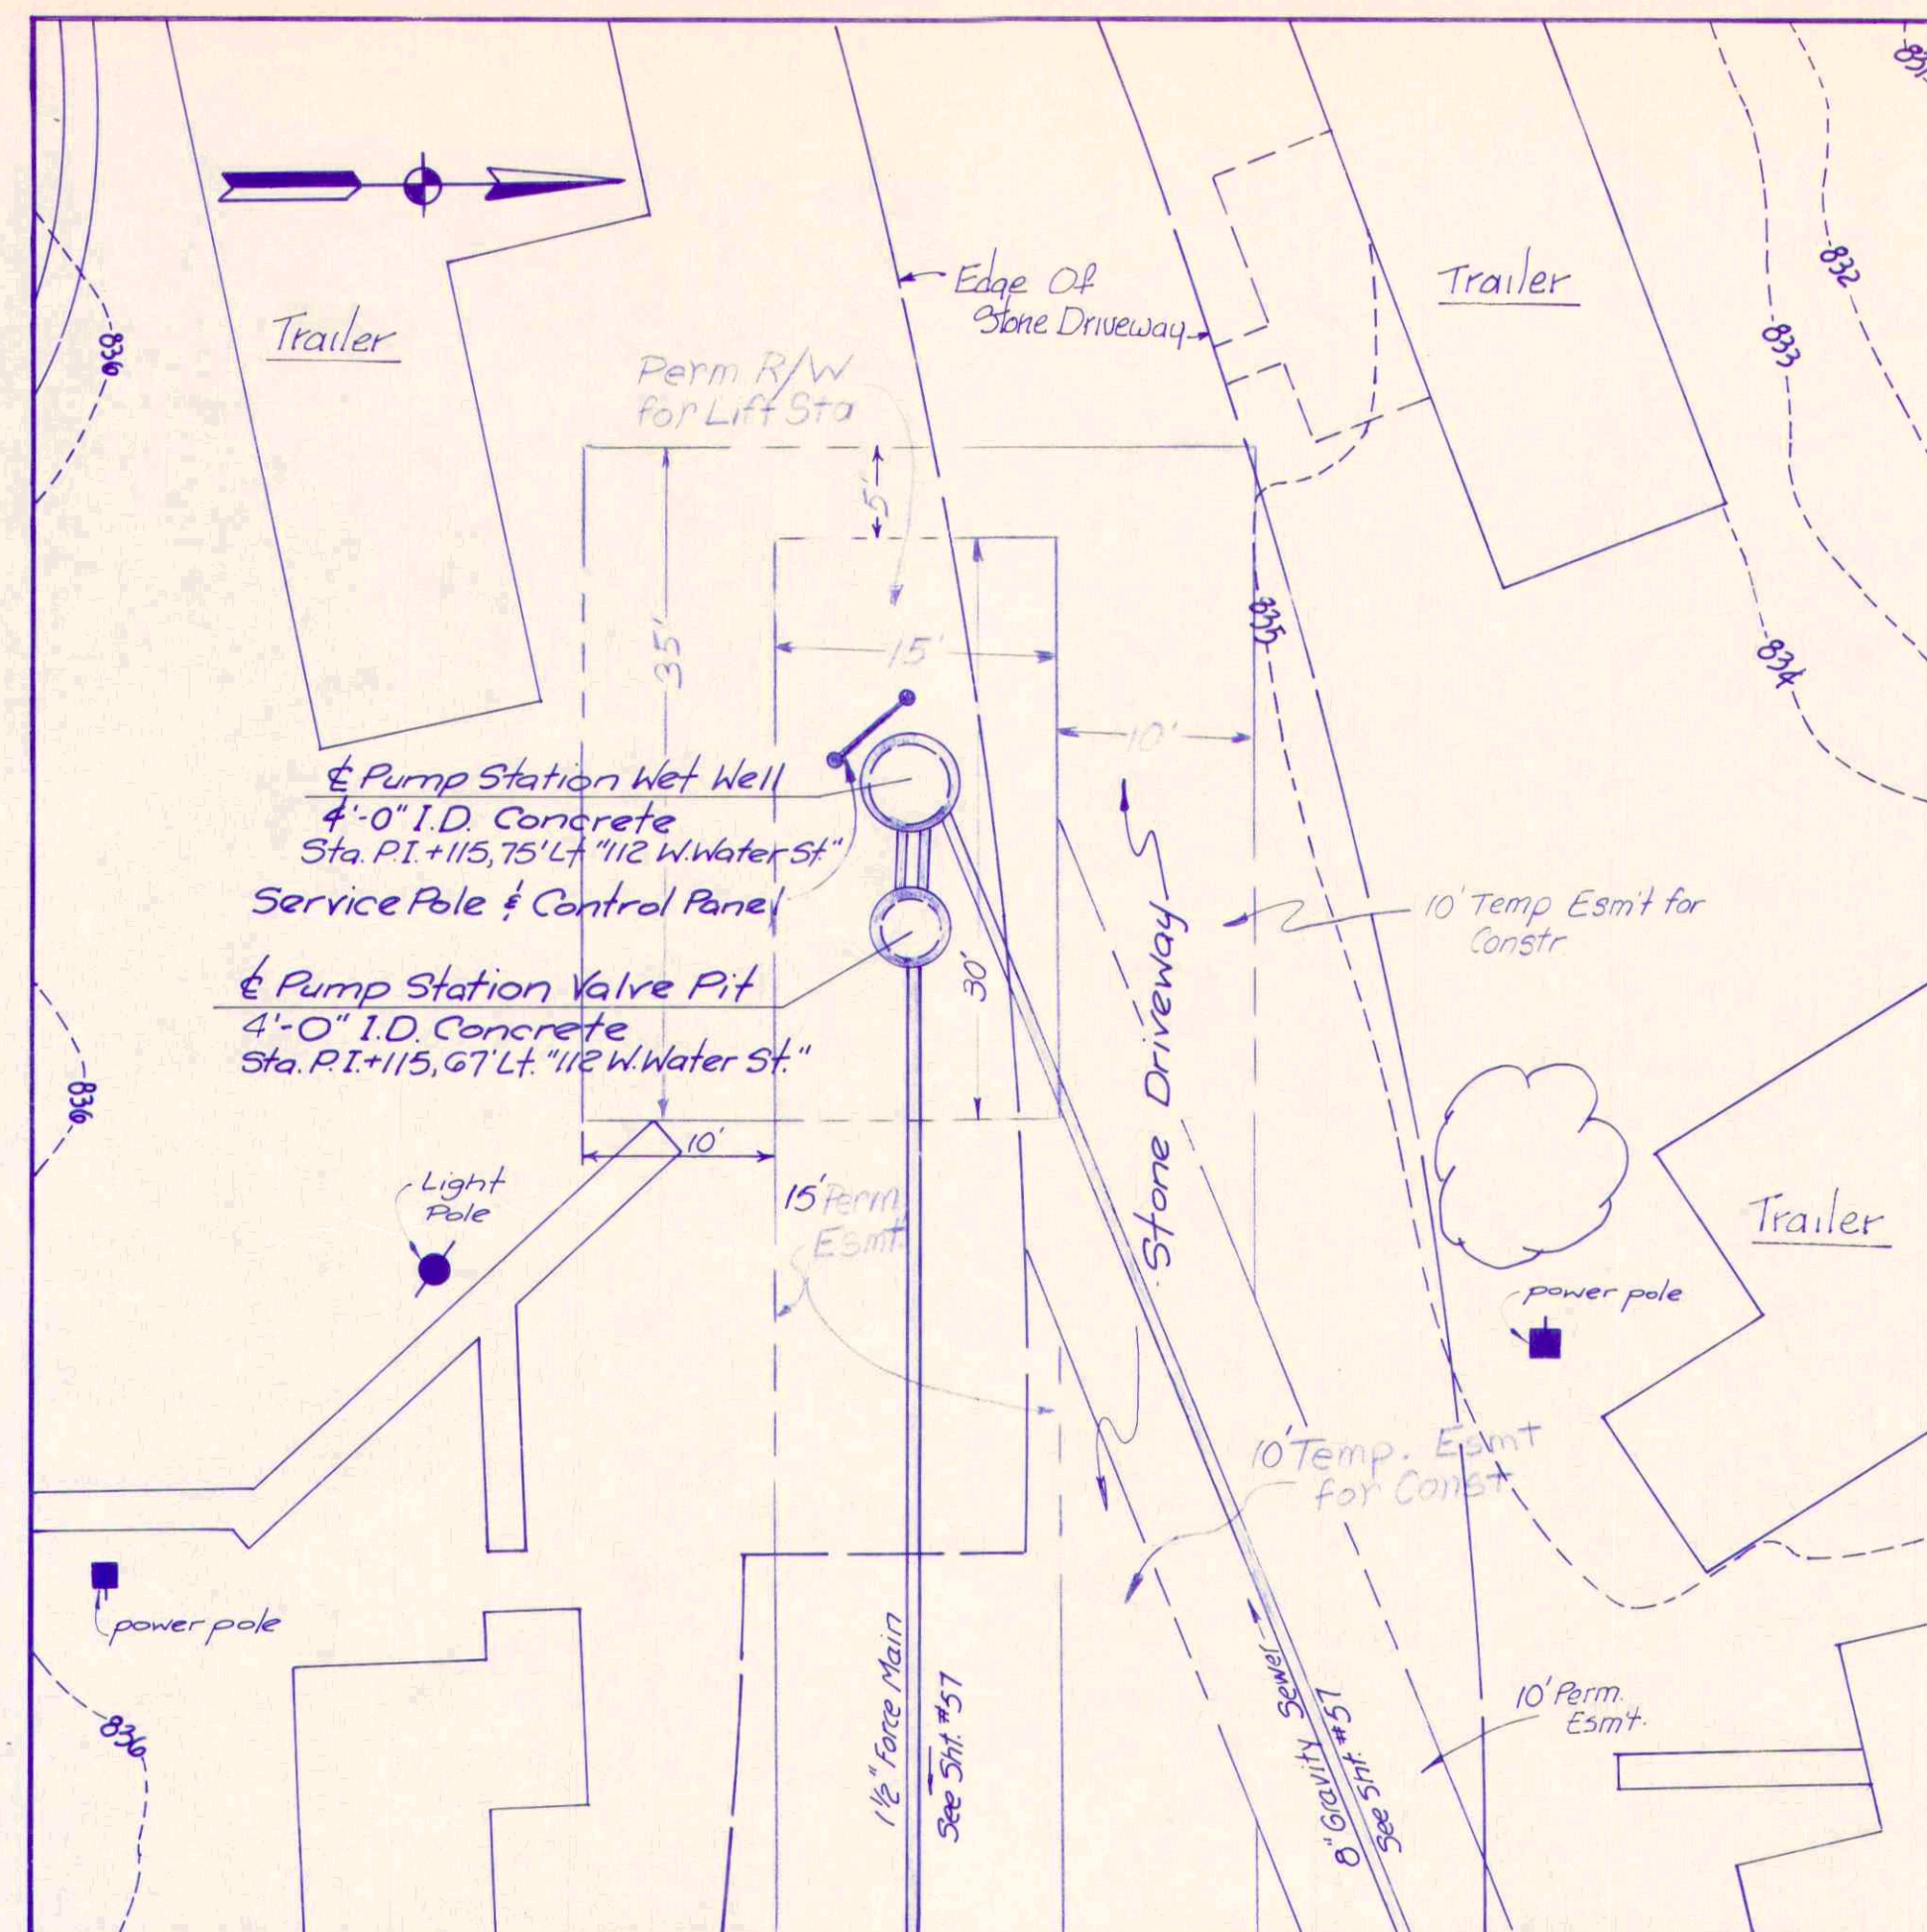


112 W. WATER ST. L.S.

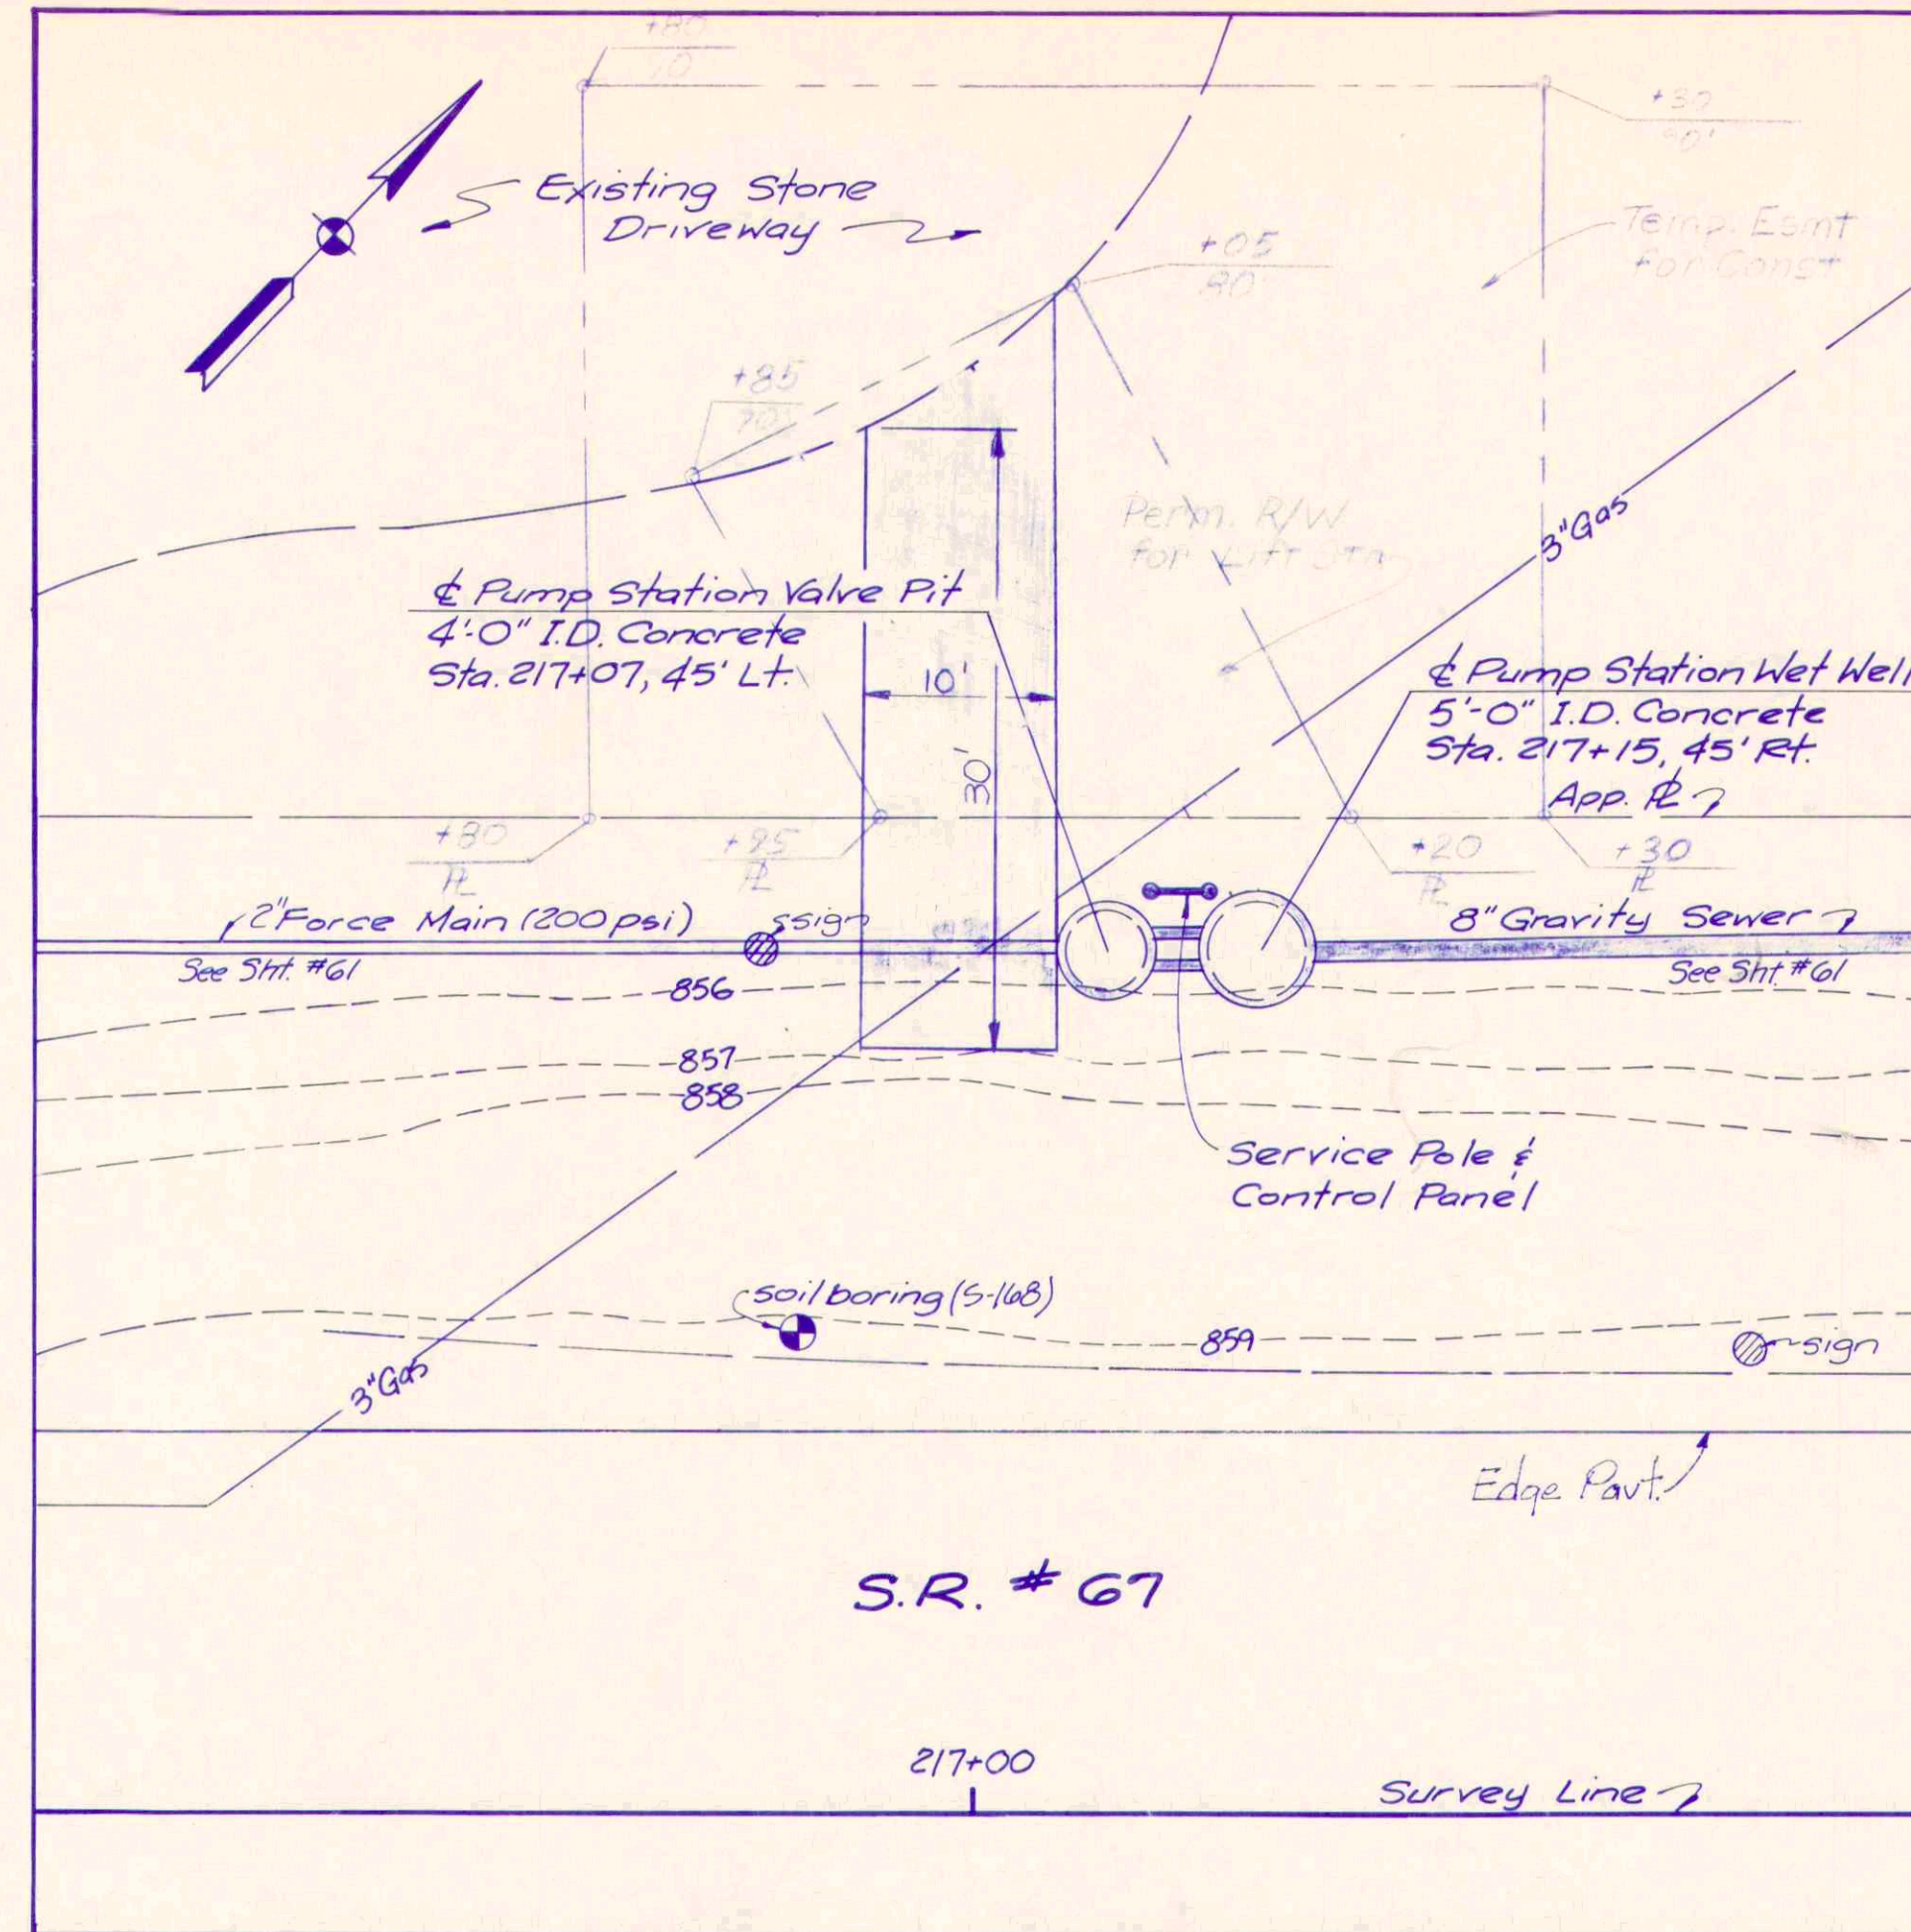


S.R. #67 L.S.

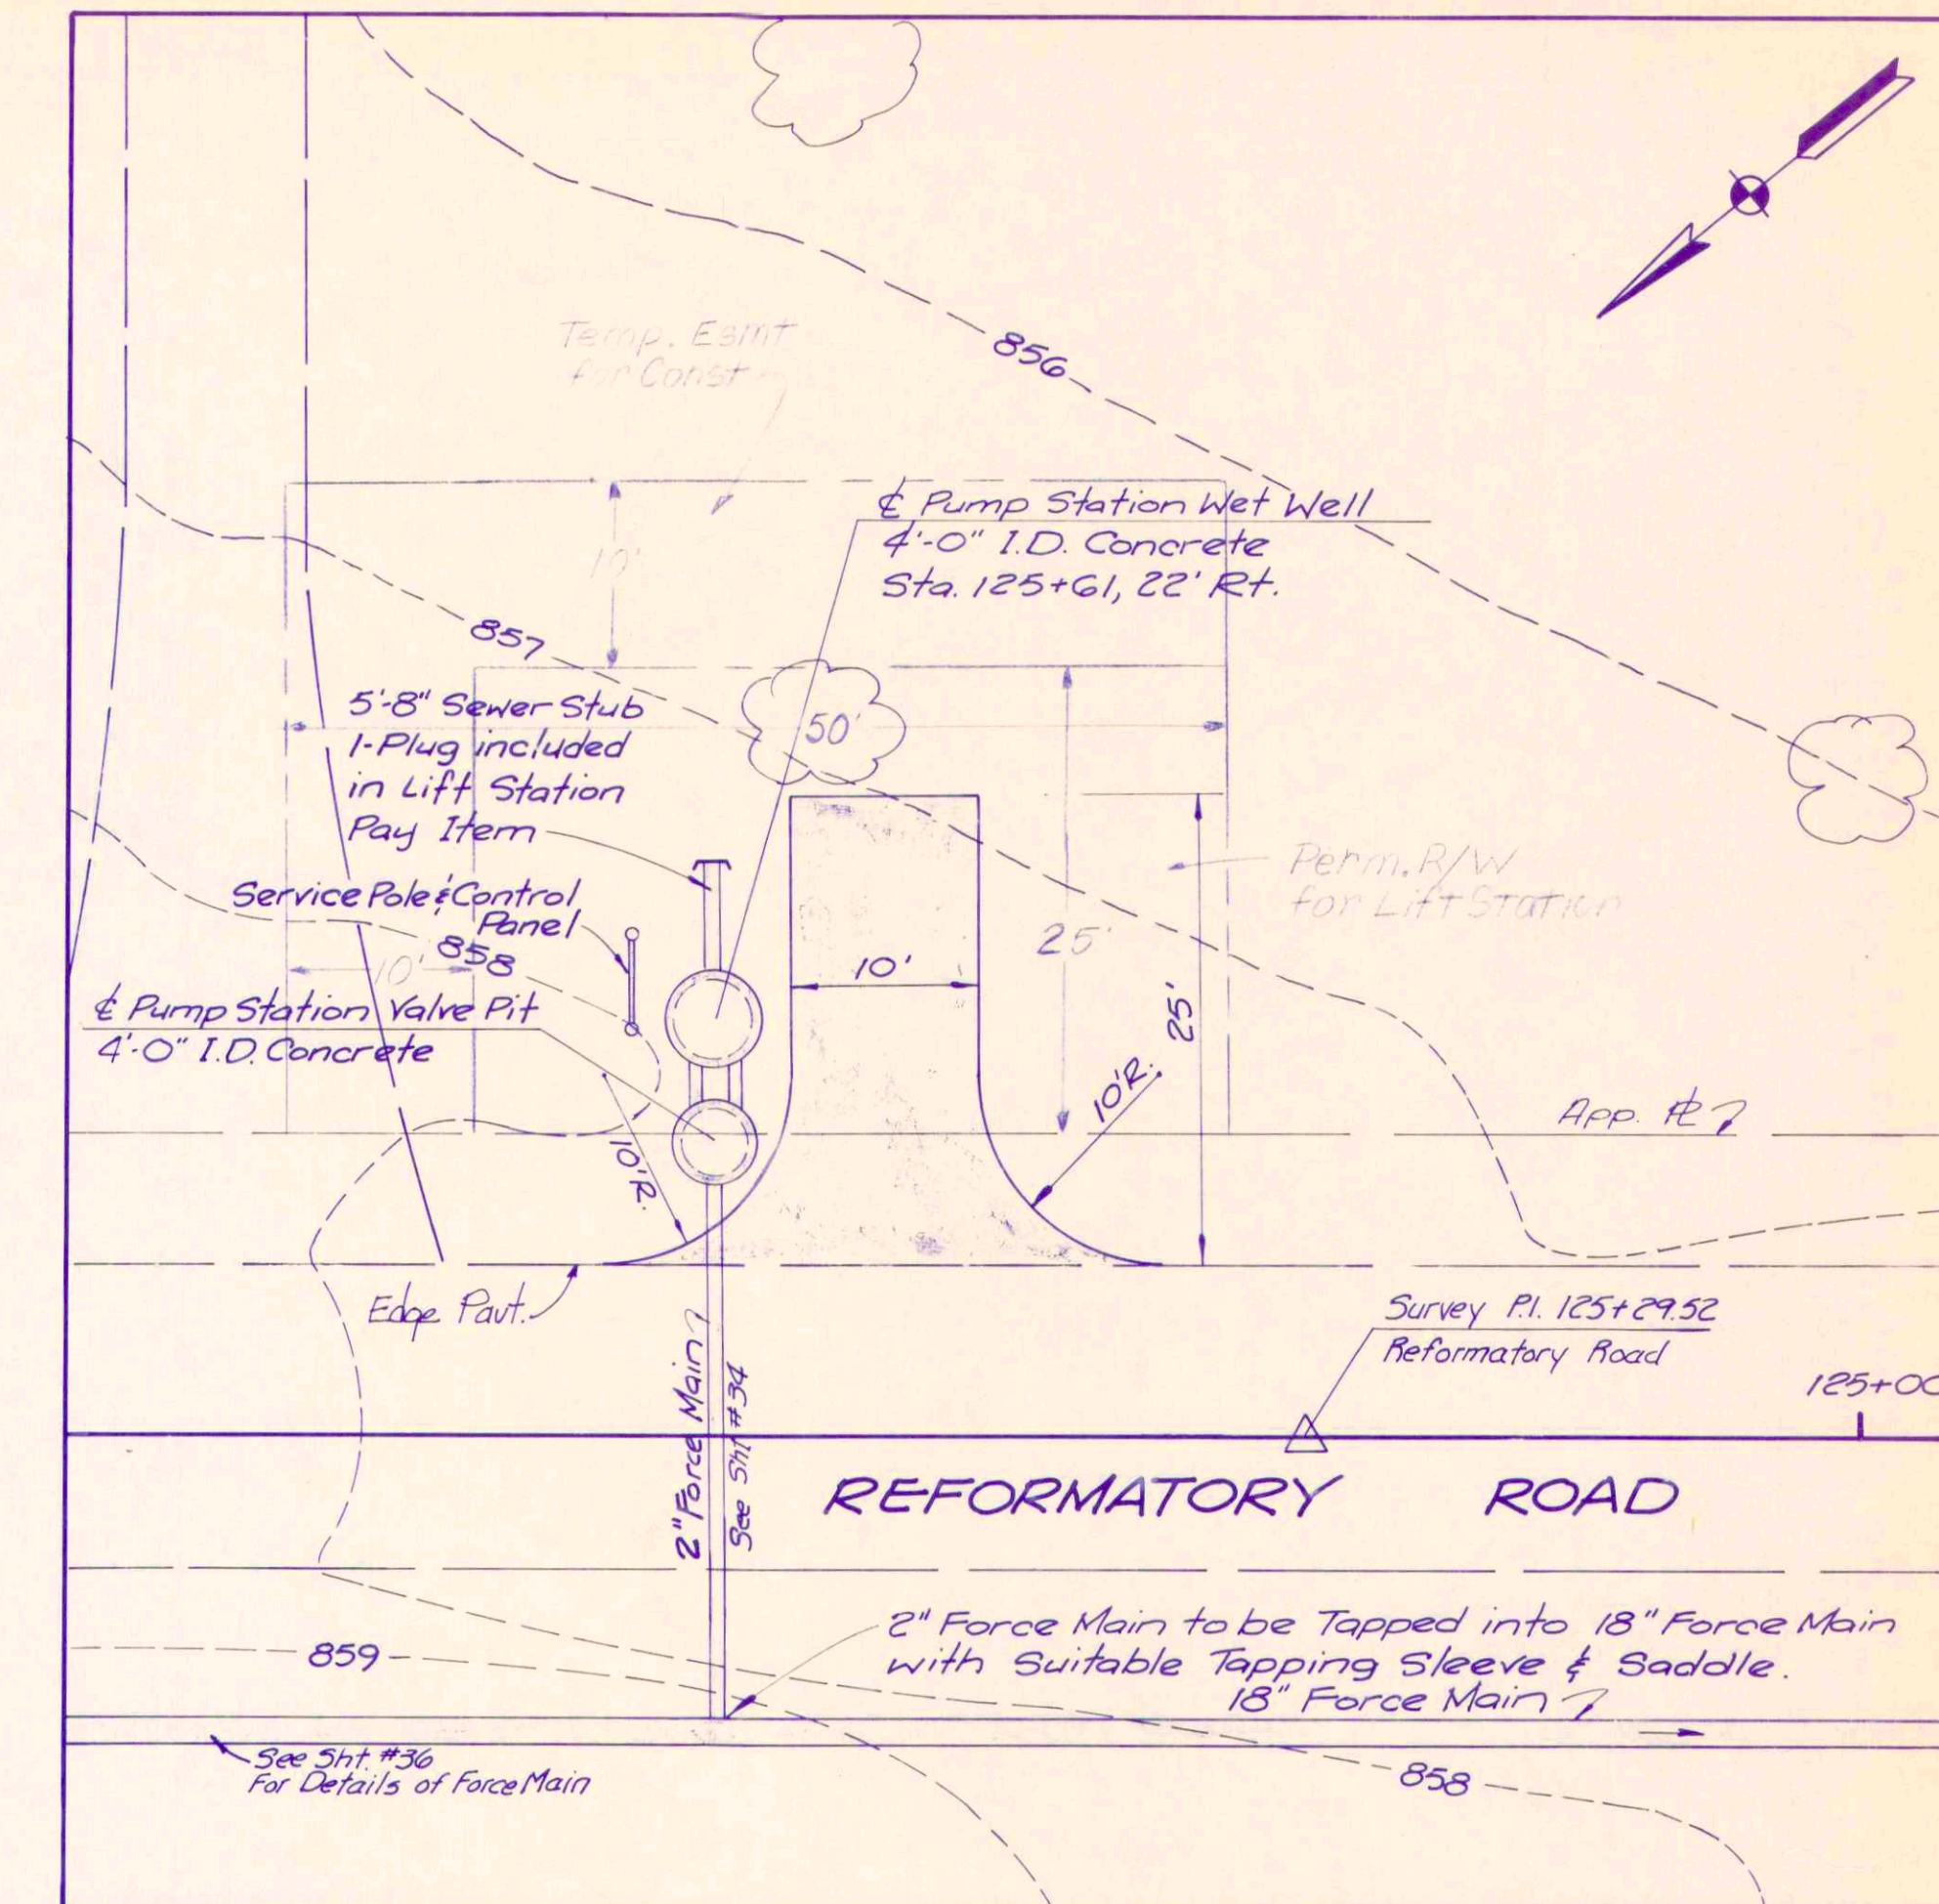

NE - M.H.P. L.S.

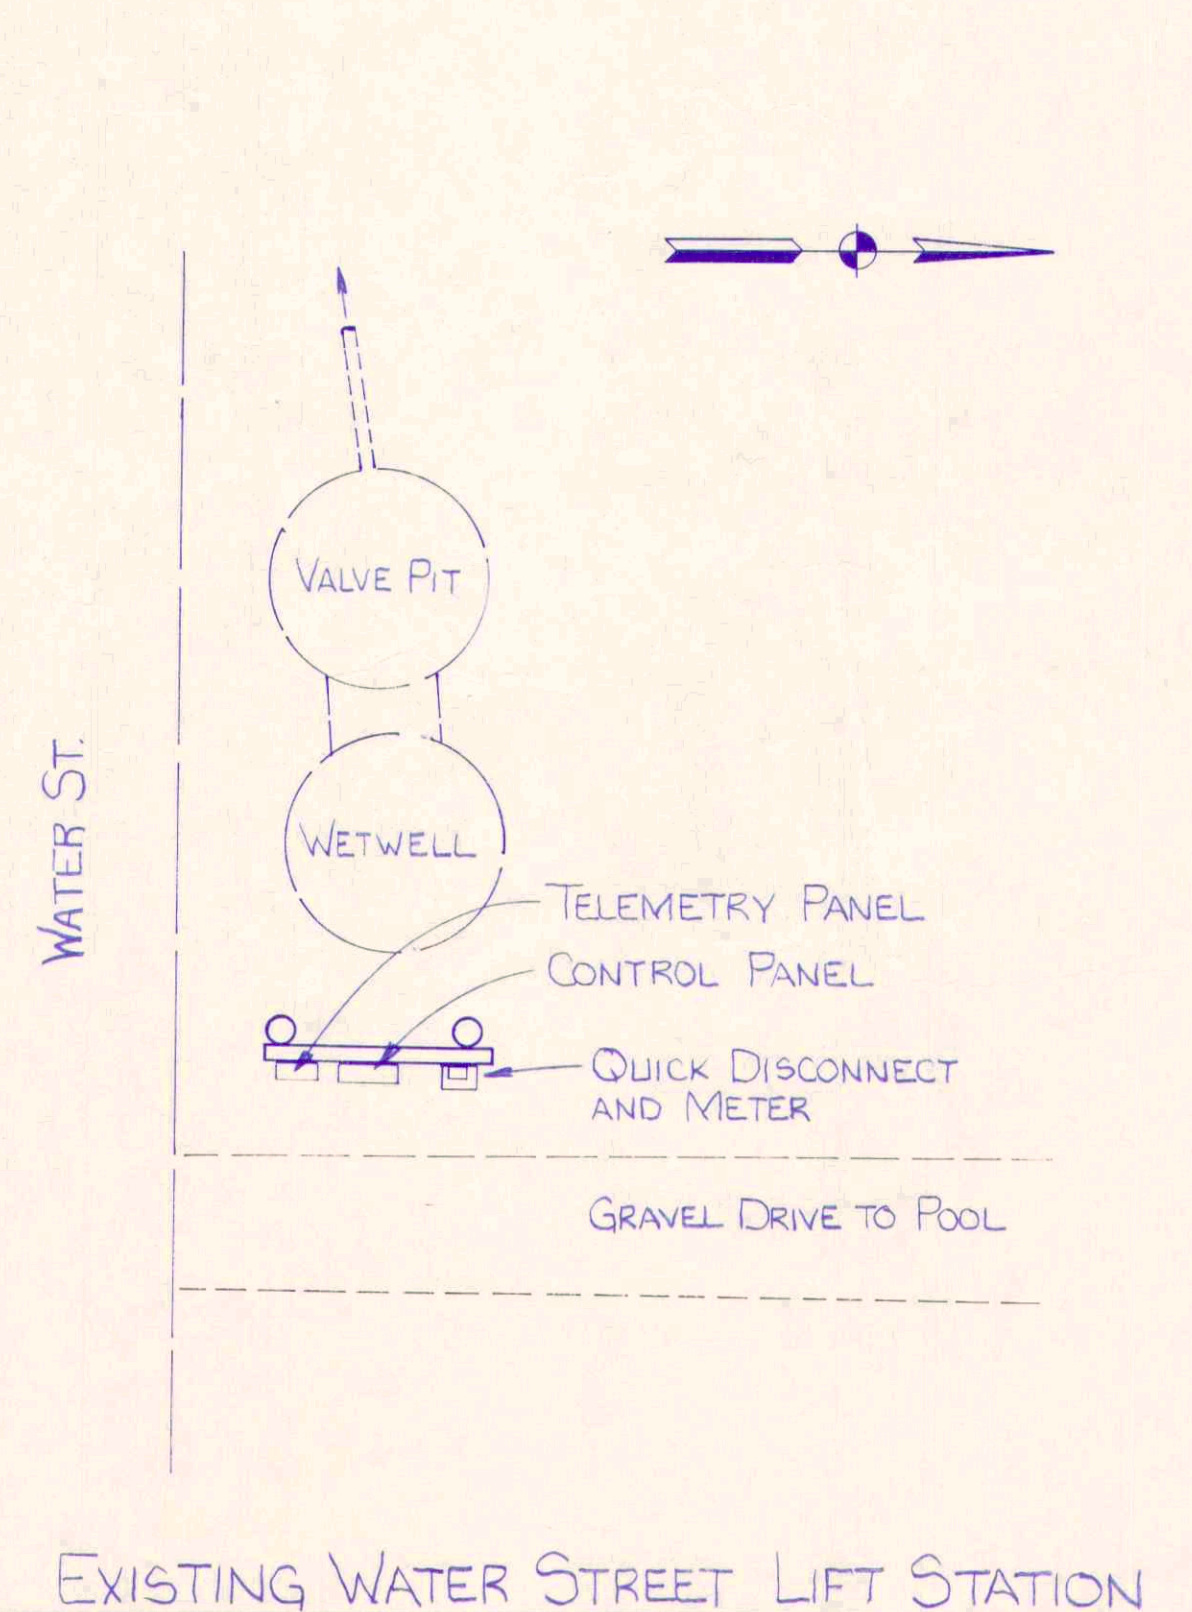

EXISTING WATER STREET LIFT STATION

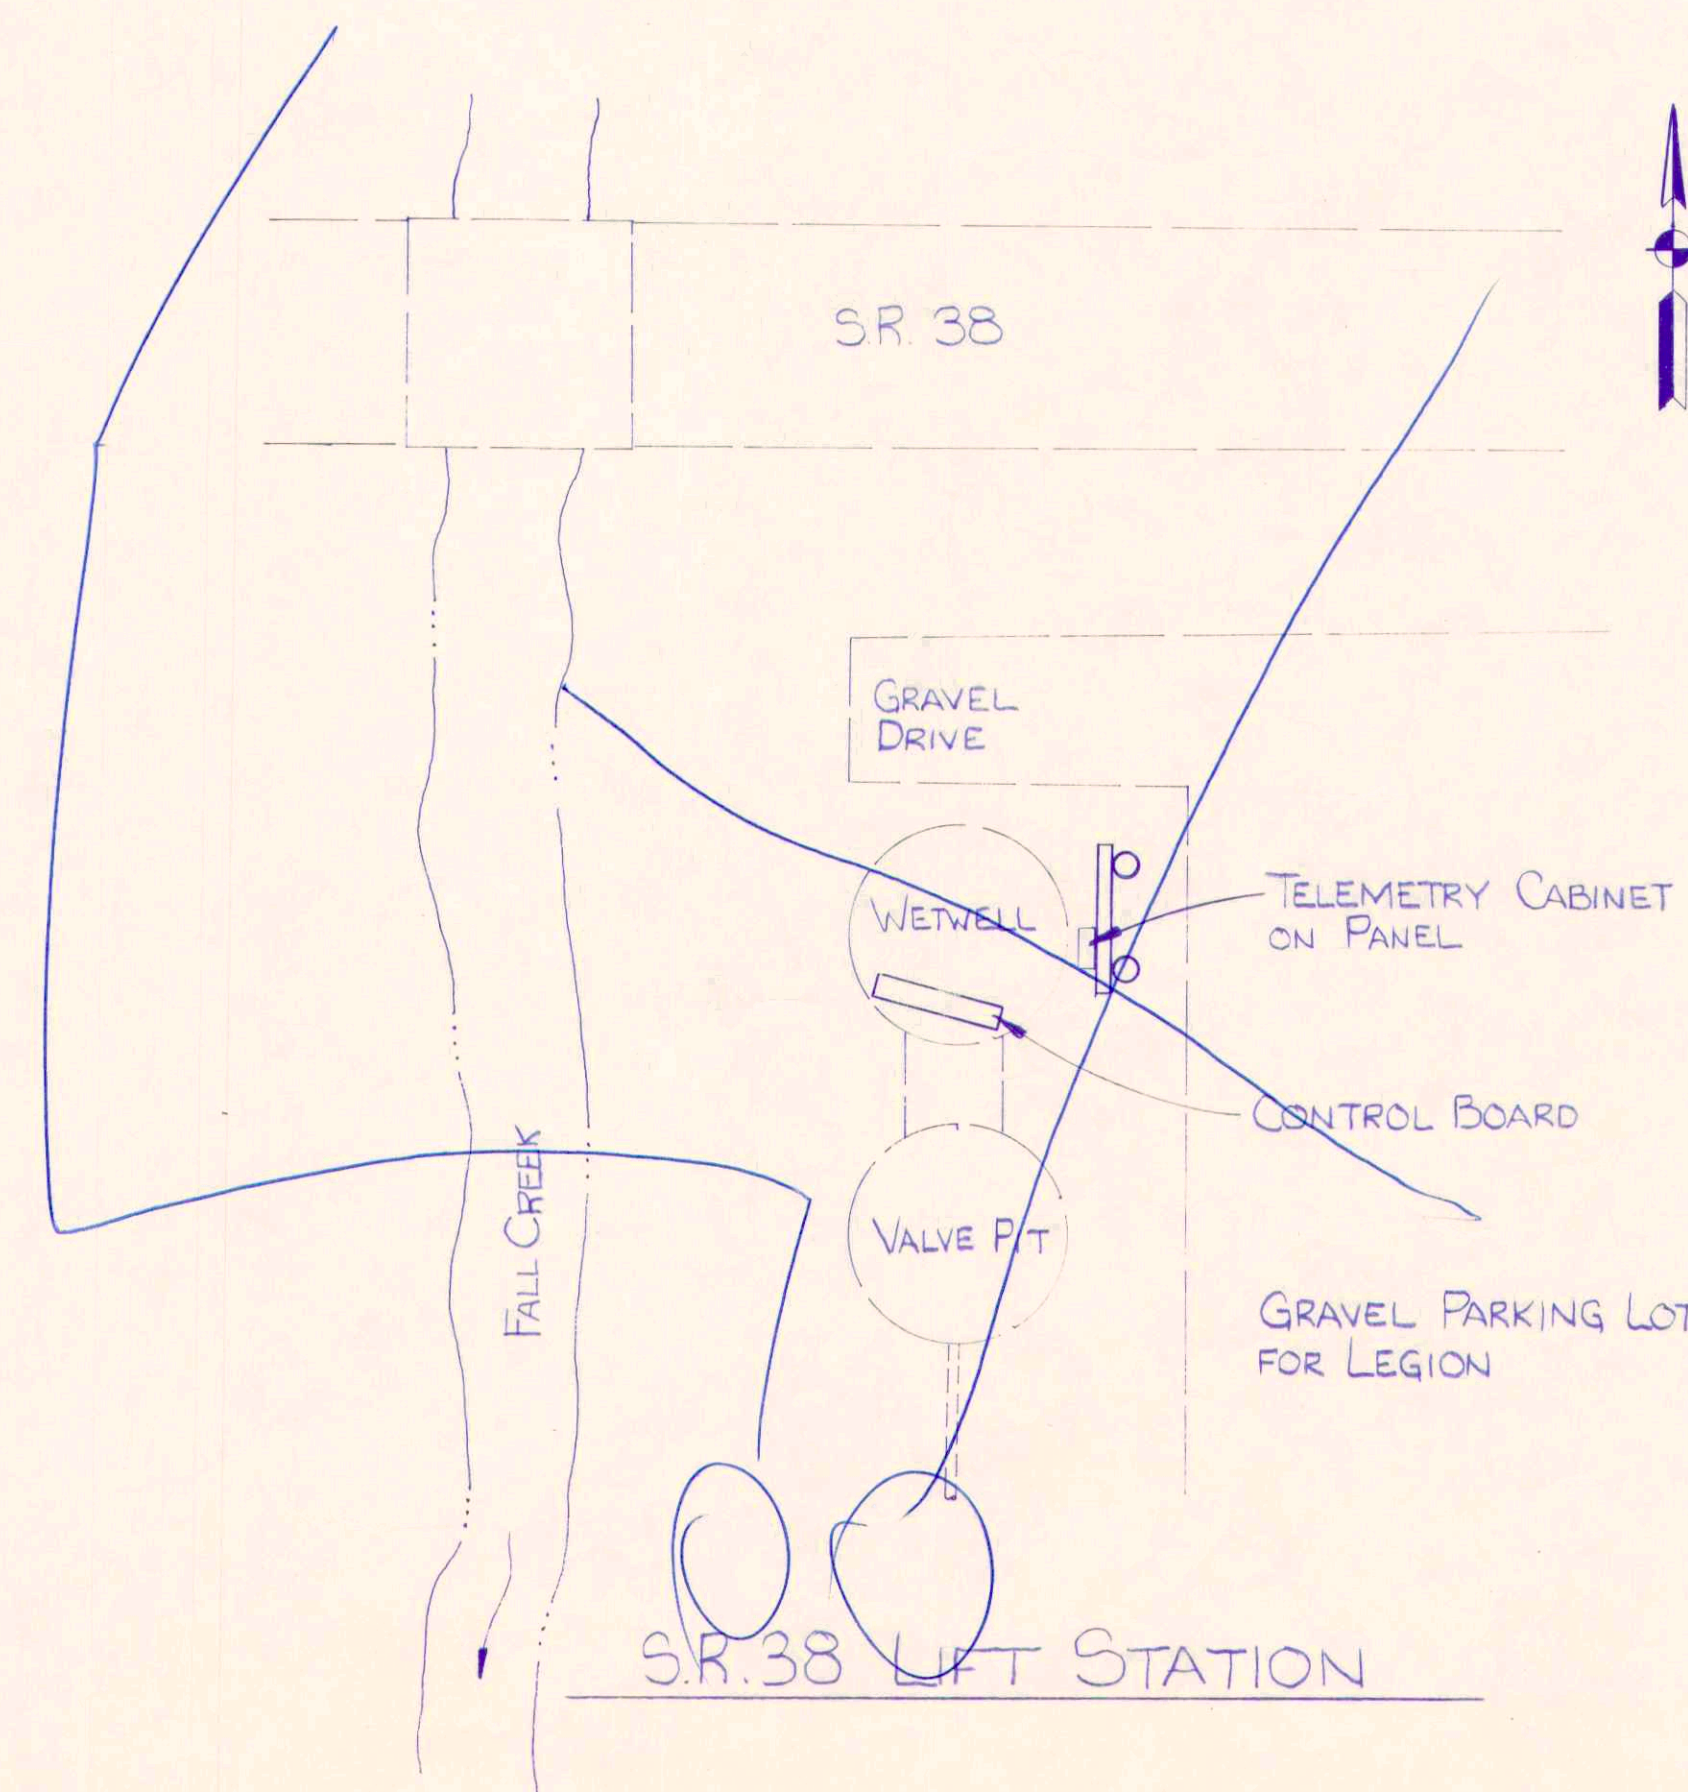

S.R. 38 LIFT STATION

## RECORD DRAWING

### LIFT STATION LAYOUTS

|                        |                                                                       |       |
|------------------------|-----------------------------------------------------------------------|-------|
| Scale: 1"=10'          | FALL CREEK R.W.D.                                                     | Sheet |
| Drawn By: VMS.         | BEAM, LONGEST & NEFF                                                  | 67    |
| Designed By: GDL<br>SE | Consulting Engineers<br>8136 Castleton Road<br>Indianapolis In. 46250 |       |
| Certified By: ER.      |                                                                       |       |