



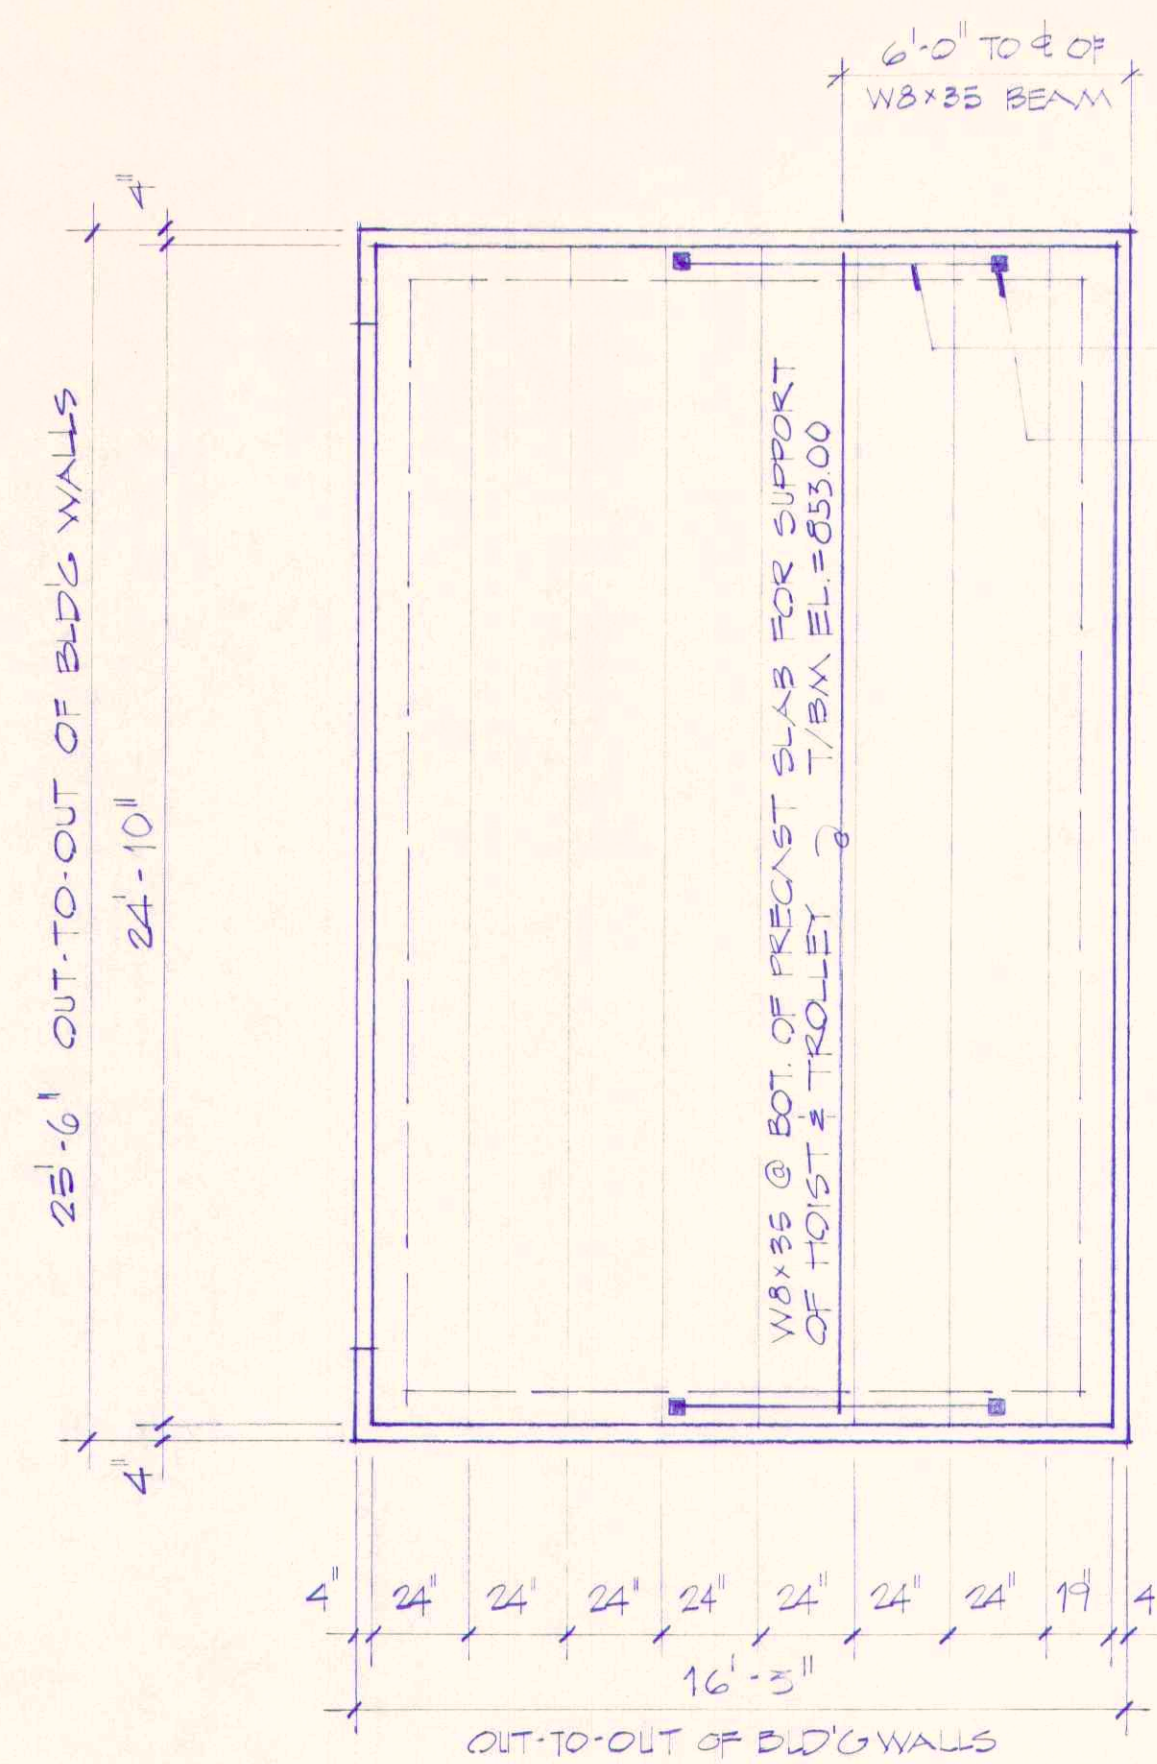


ROOF FRAMING PLAN

SCALE: 1/4" = 1'-0"

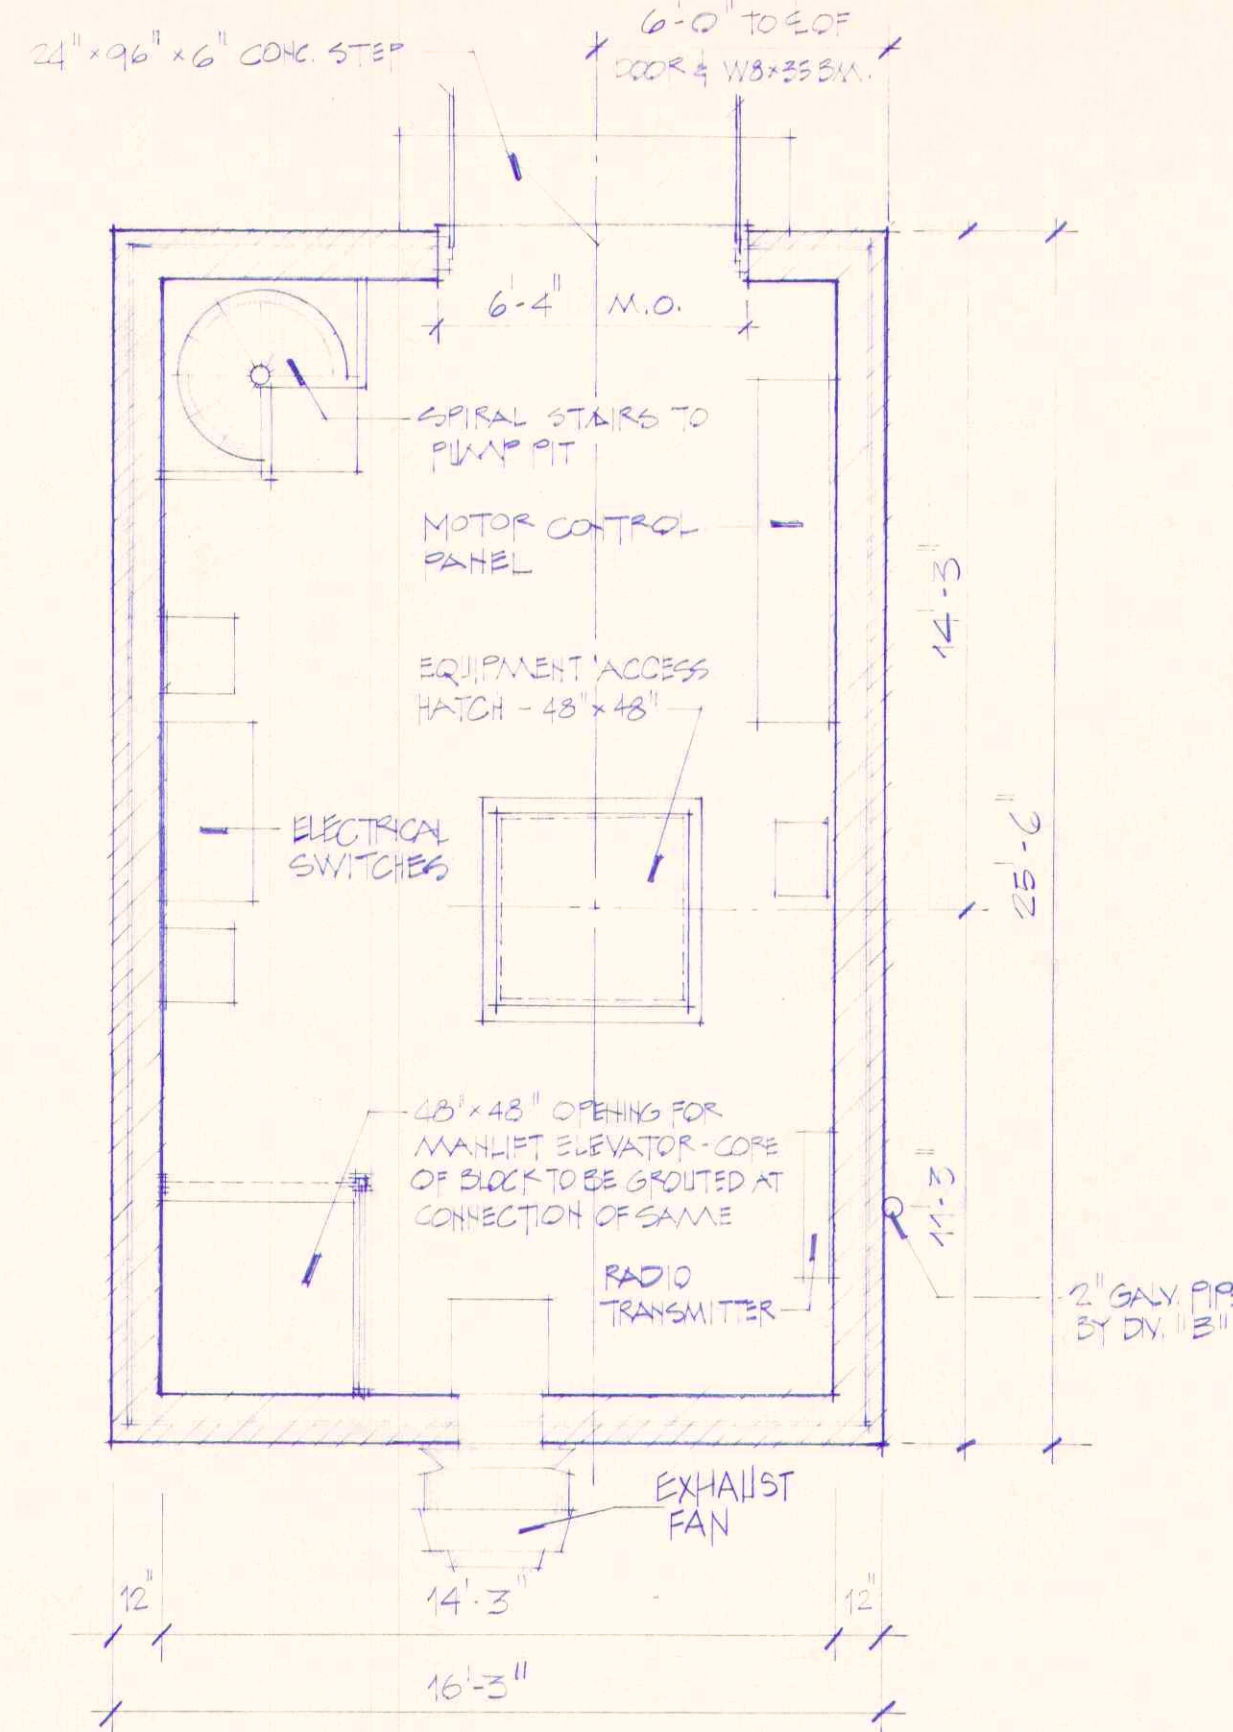


FLOOR PLAN

SCALE: 1/4" = 1'-0"

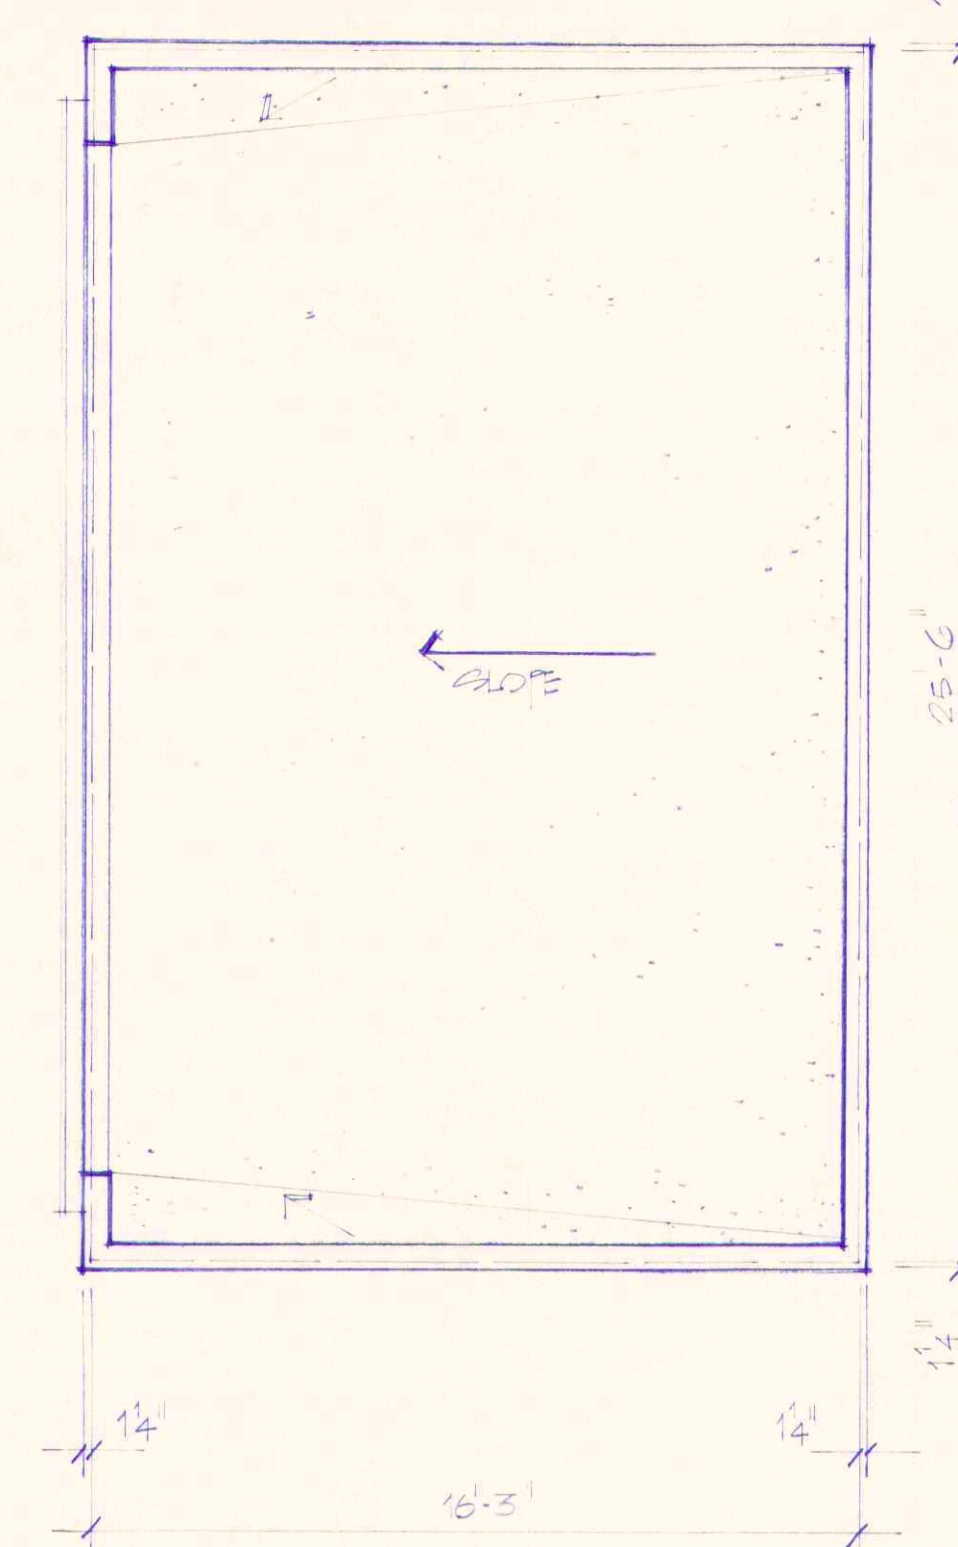


ROOF PLAN

SCALE: 1/4" = 1'-0"

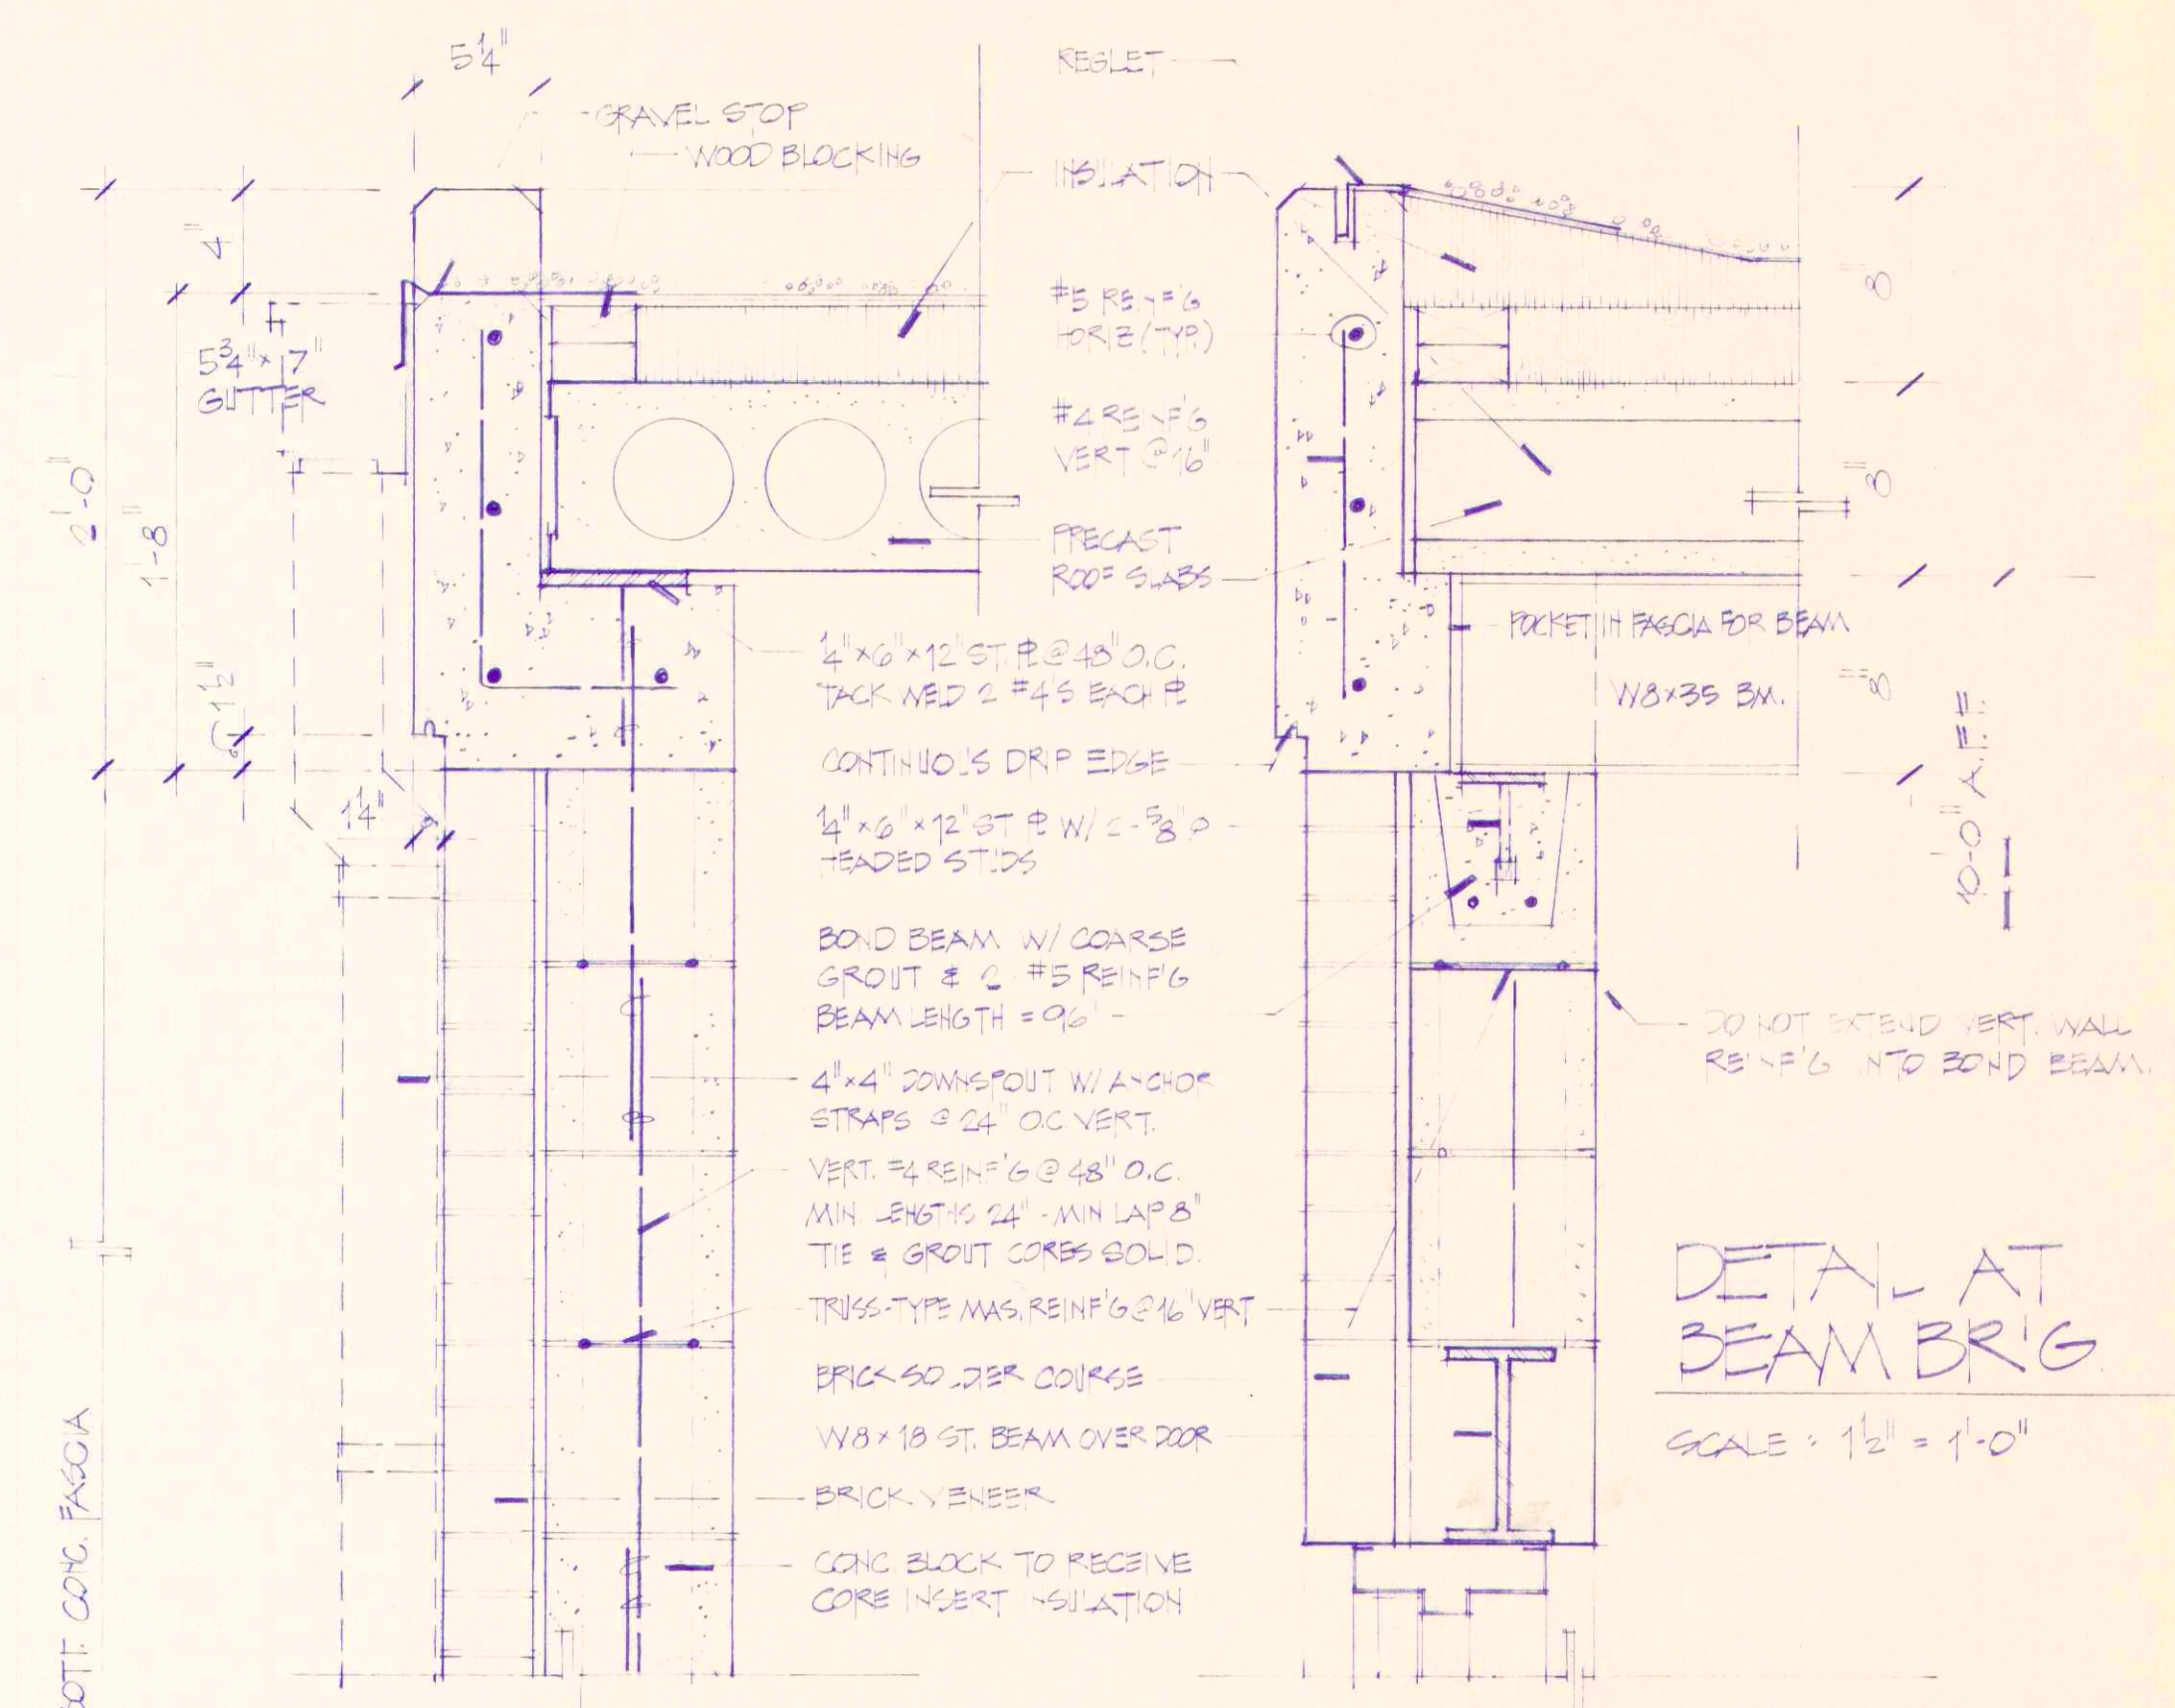

DETAIL AT BEAM BRIG


SCALE: 1/2" = 1'-0"

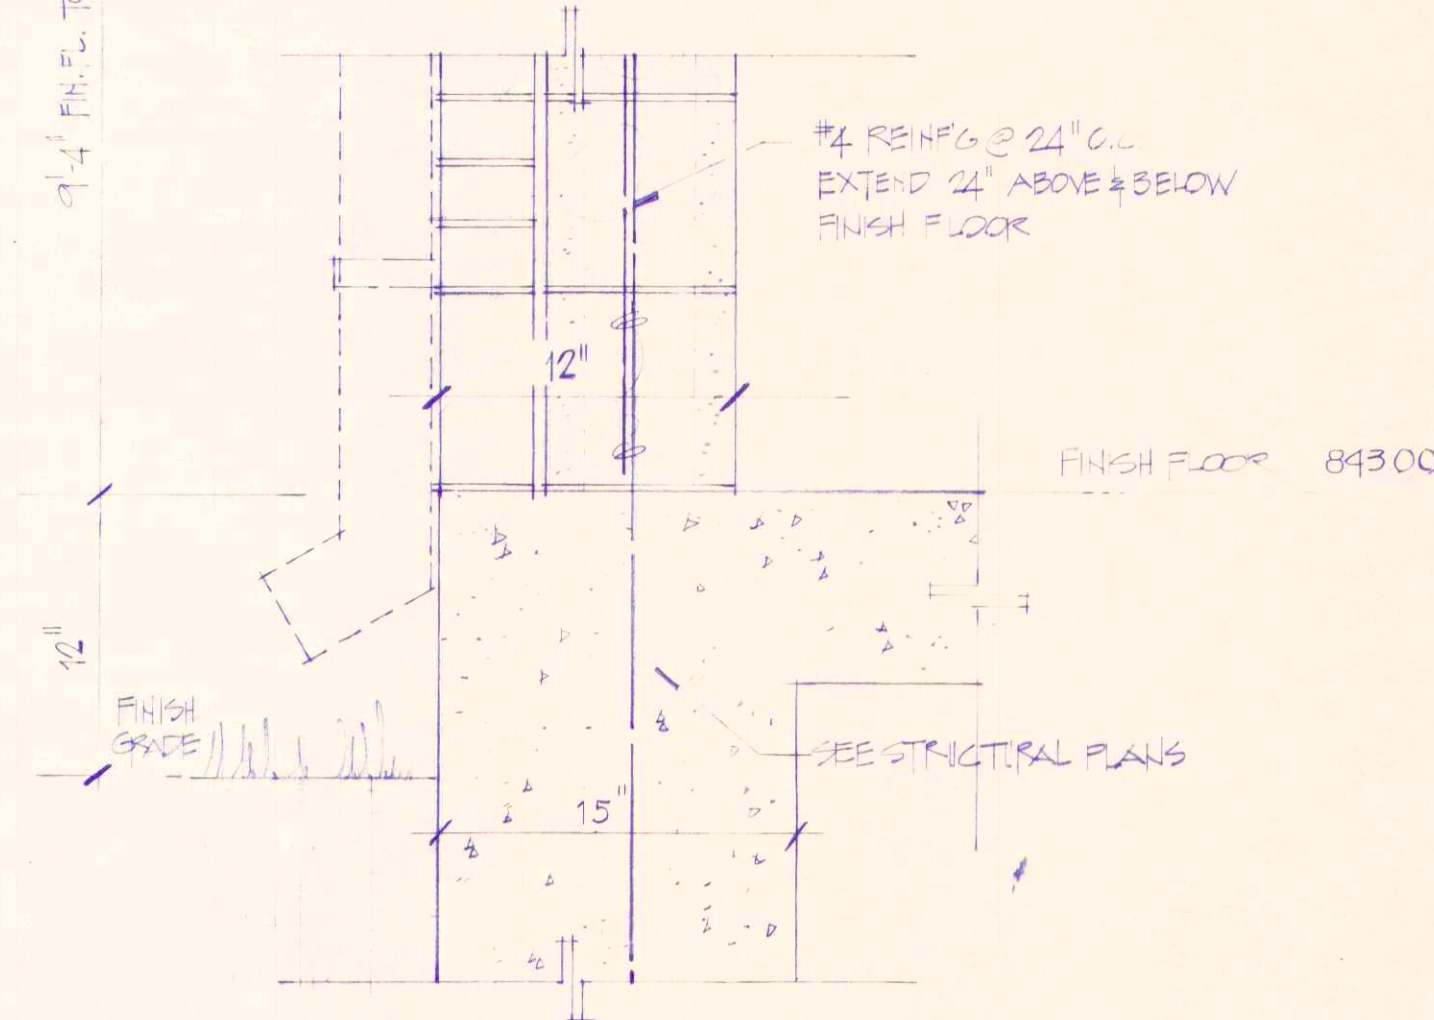

TYPICAL SECTION

SCALE: 1/2" = 1'-0"


INTERIOR FINISH NOTE = EXPOSED CONC. SLAB CEILING TO BE PAINTED. WALLS TO BE PAINTED. FLOORS TO BE EXPOSED CONC. W/ SEALER. NO BASE MOLDING IS REQ'D.

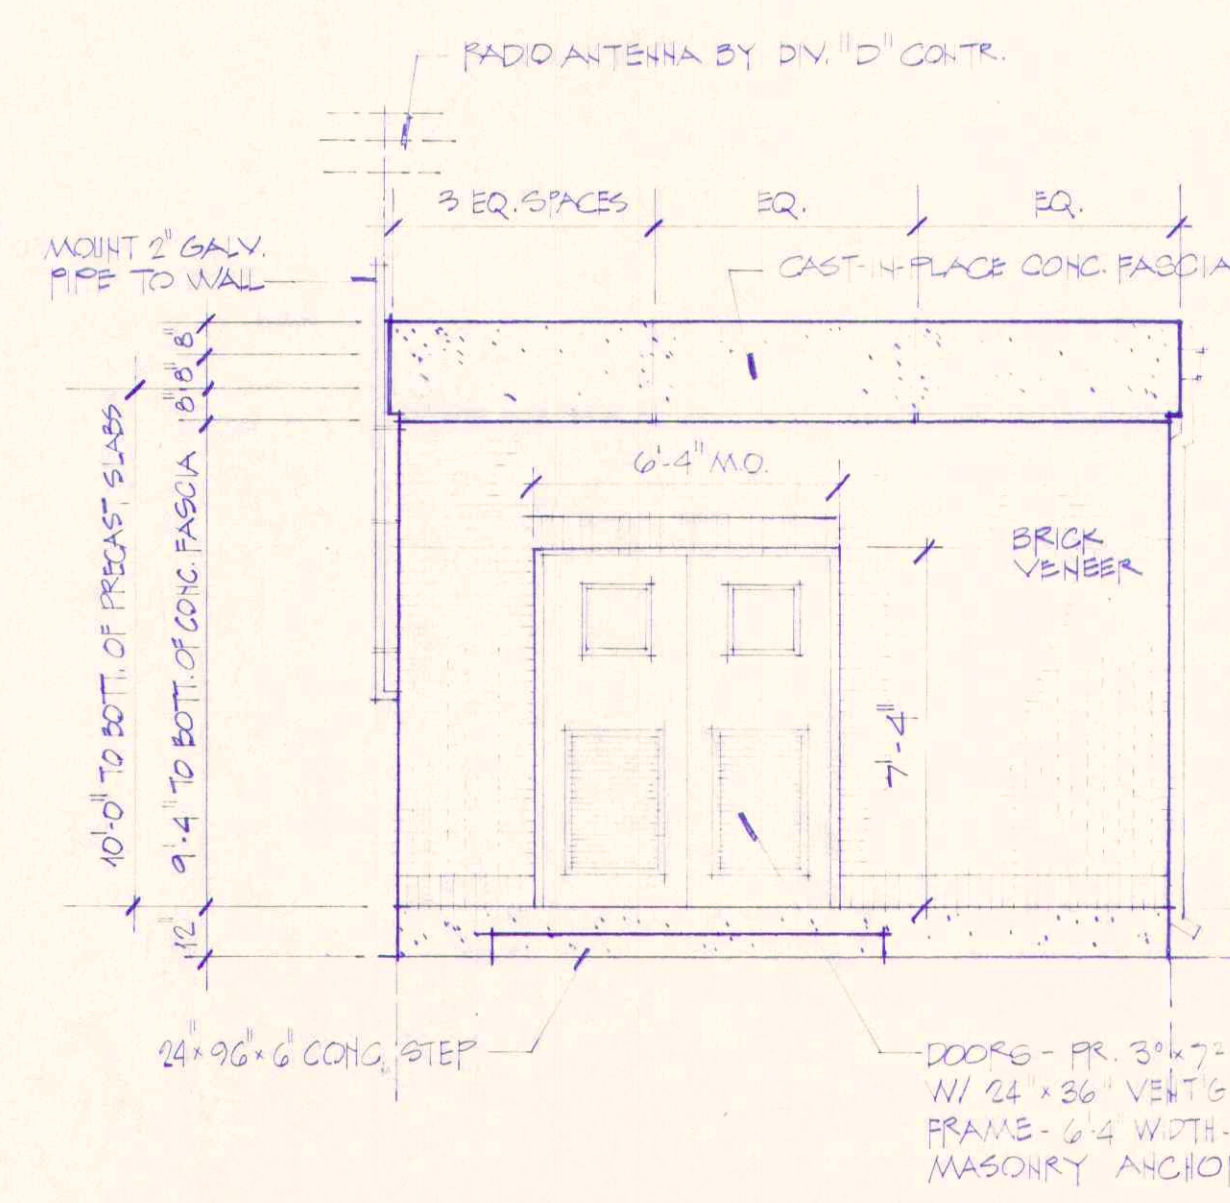

NORTH ELEVATION


SCALE: 1/4" = 1'-0"

SOUTH ELEV. SIMILAR

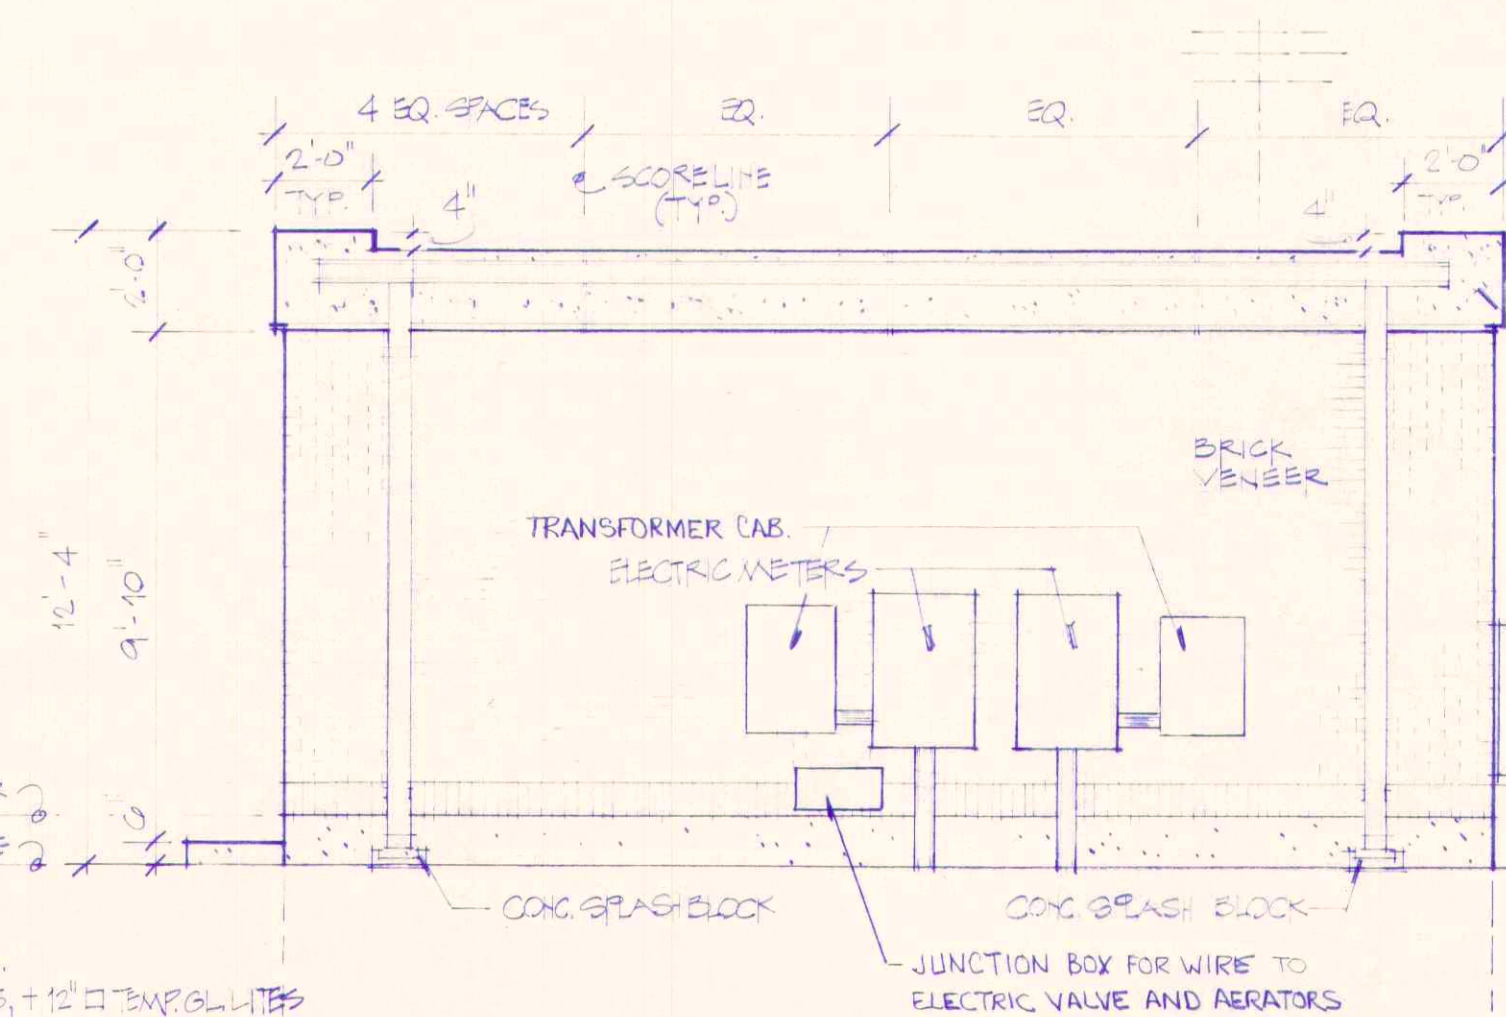

WEST ELEVATION

SCALE: 1/4" = 1'-0"

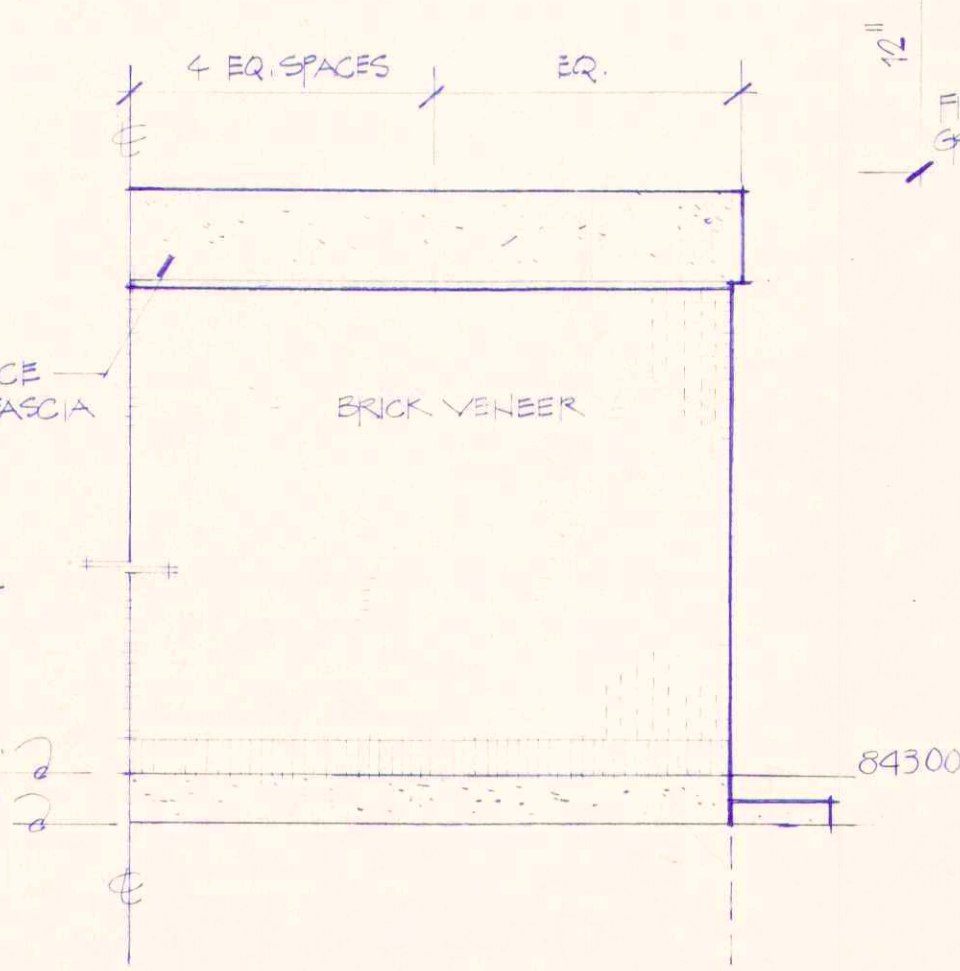

PARTIAL EAST ELEVATION

SCALE: 1/4" = 1'-0"

RECORD DRAWING

REFORMATORY LIFT STATION BUILDING		
Scale: AS NOTED	FALL CREEK R.W.D.	Sheet
Drawn By: DMW	BEAM, LONGEST & NEFF	70
Designed By: LP	Consulting Engineers	
Certified By: ER	8136 Castleton Road Indianapolis, IN 46250	