

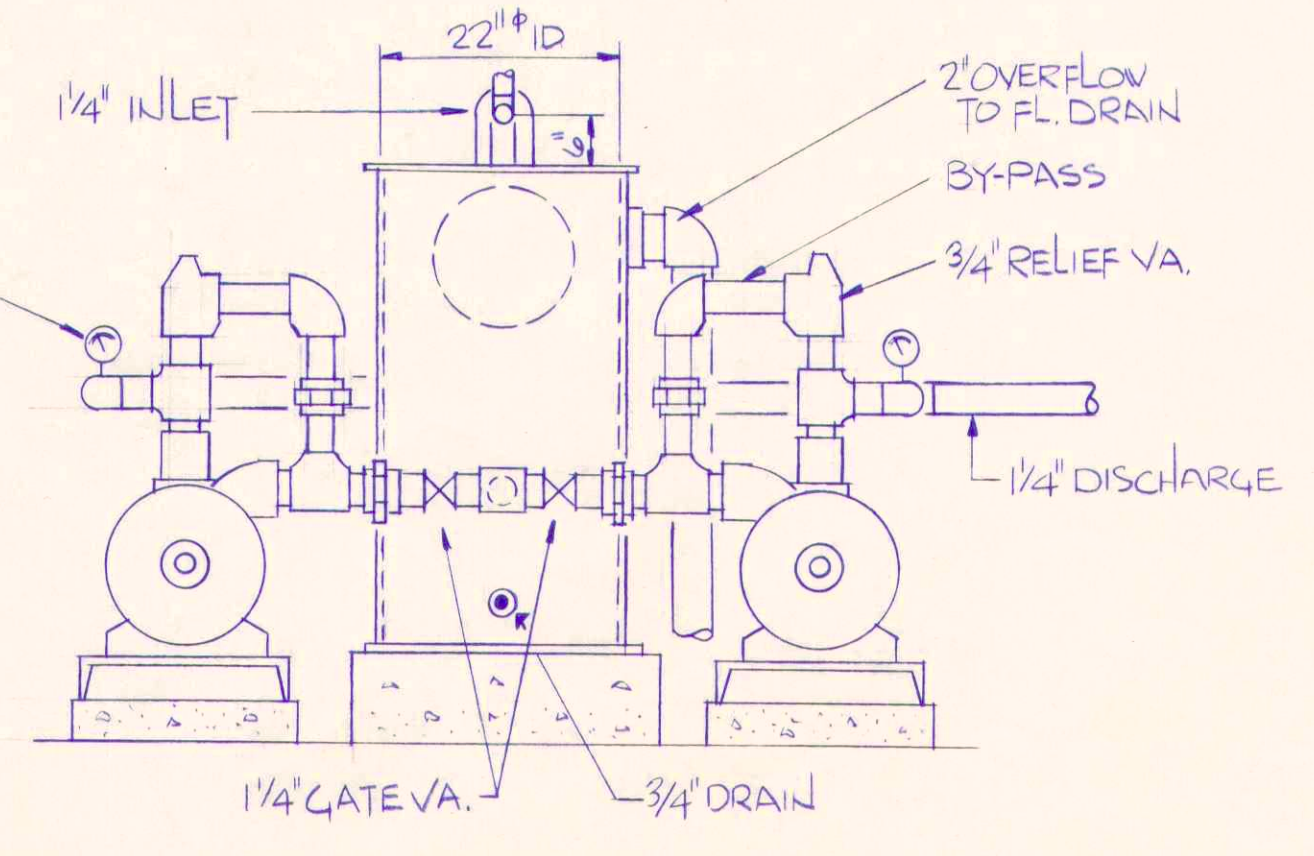
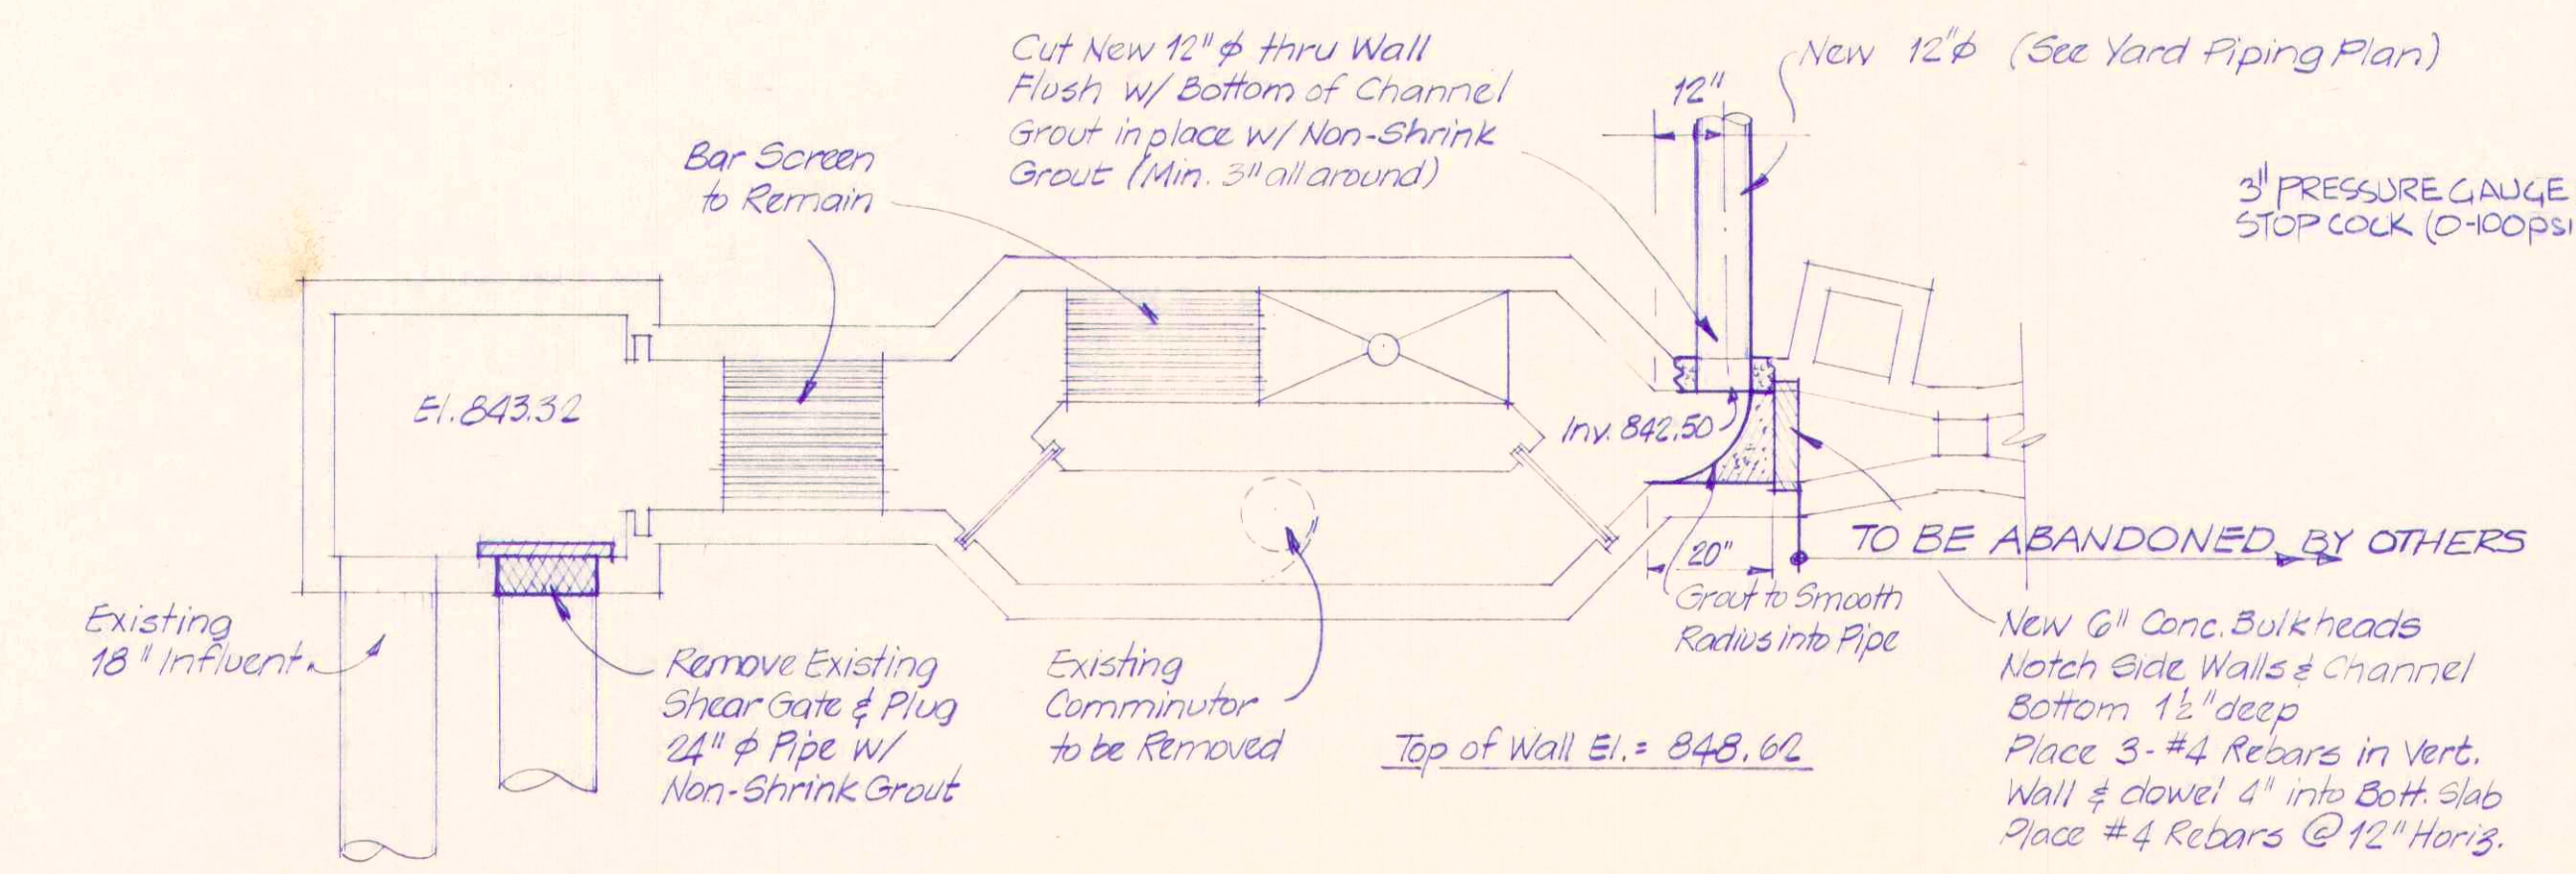
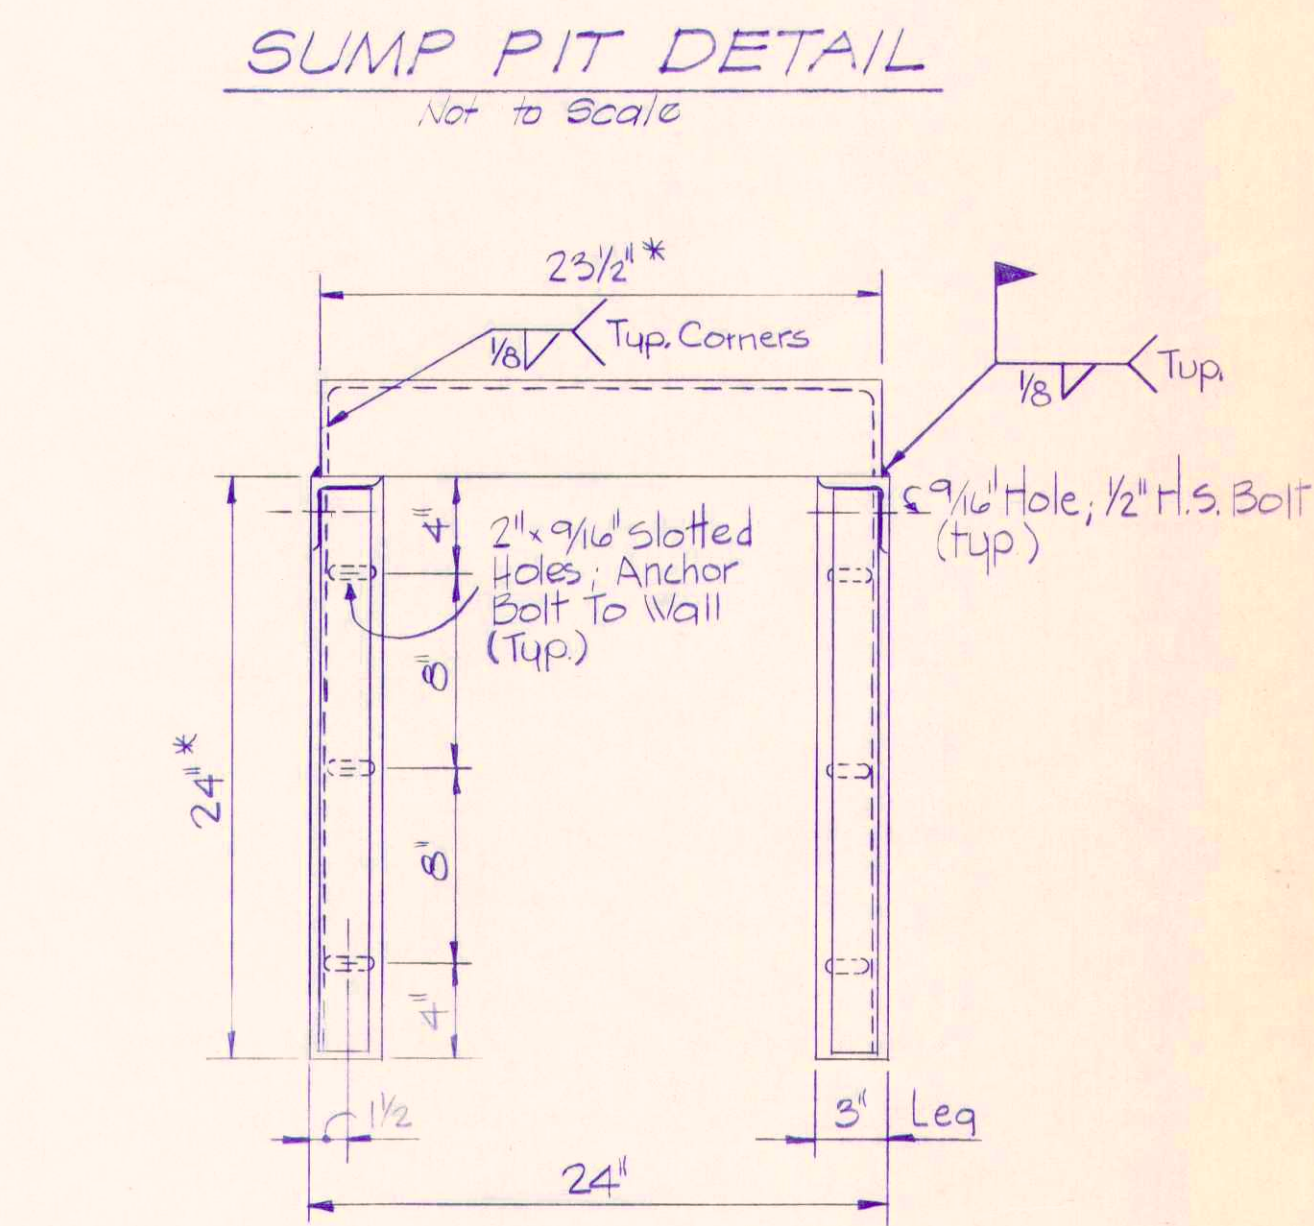
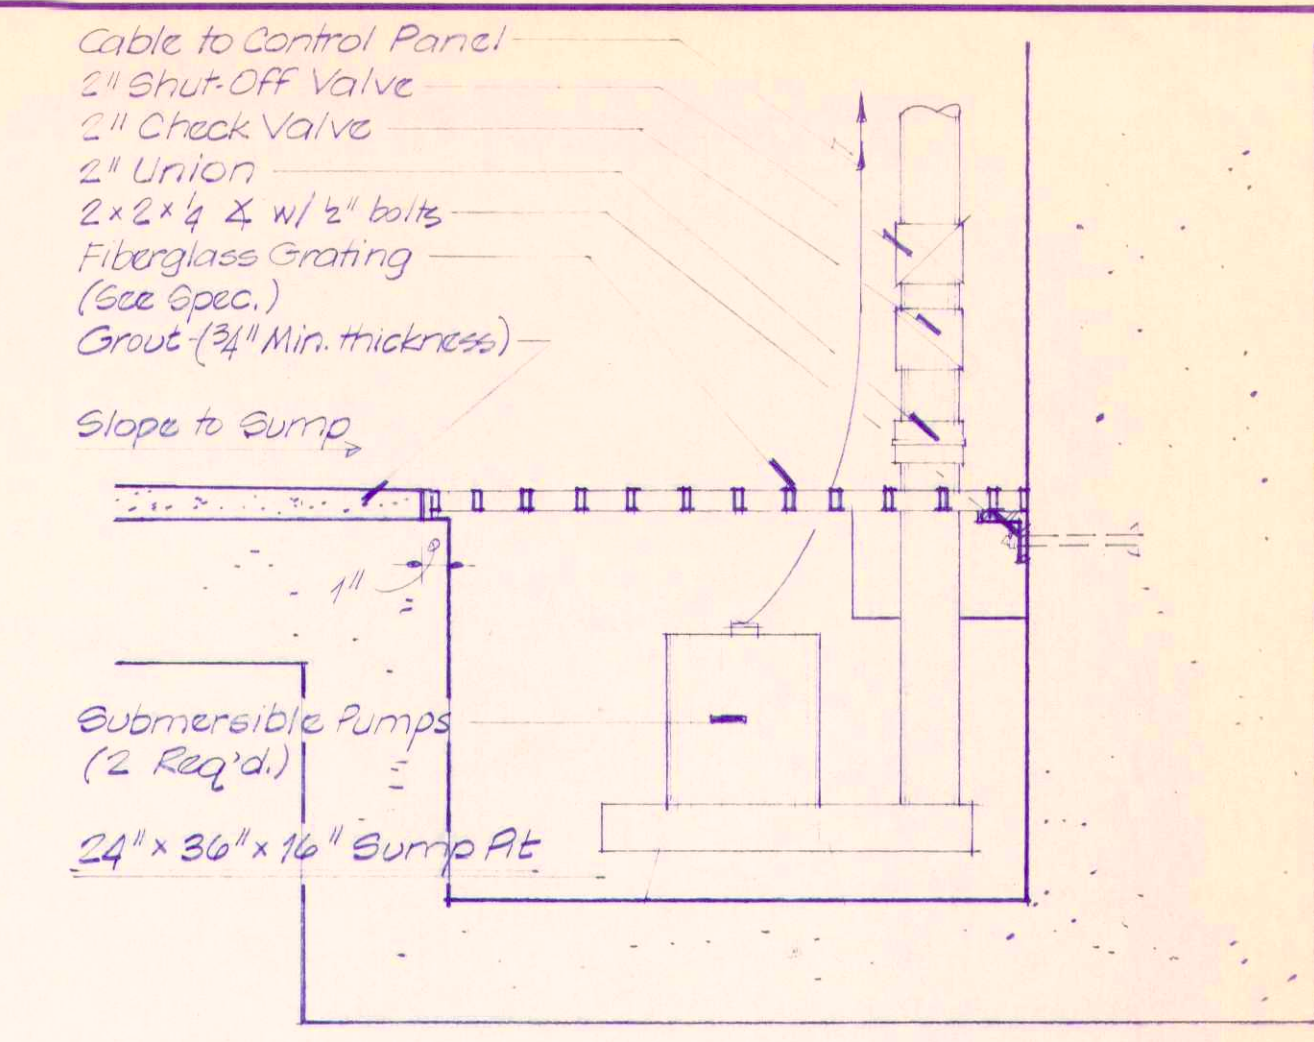
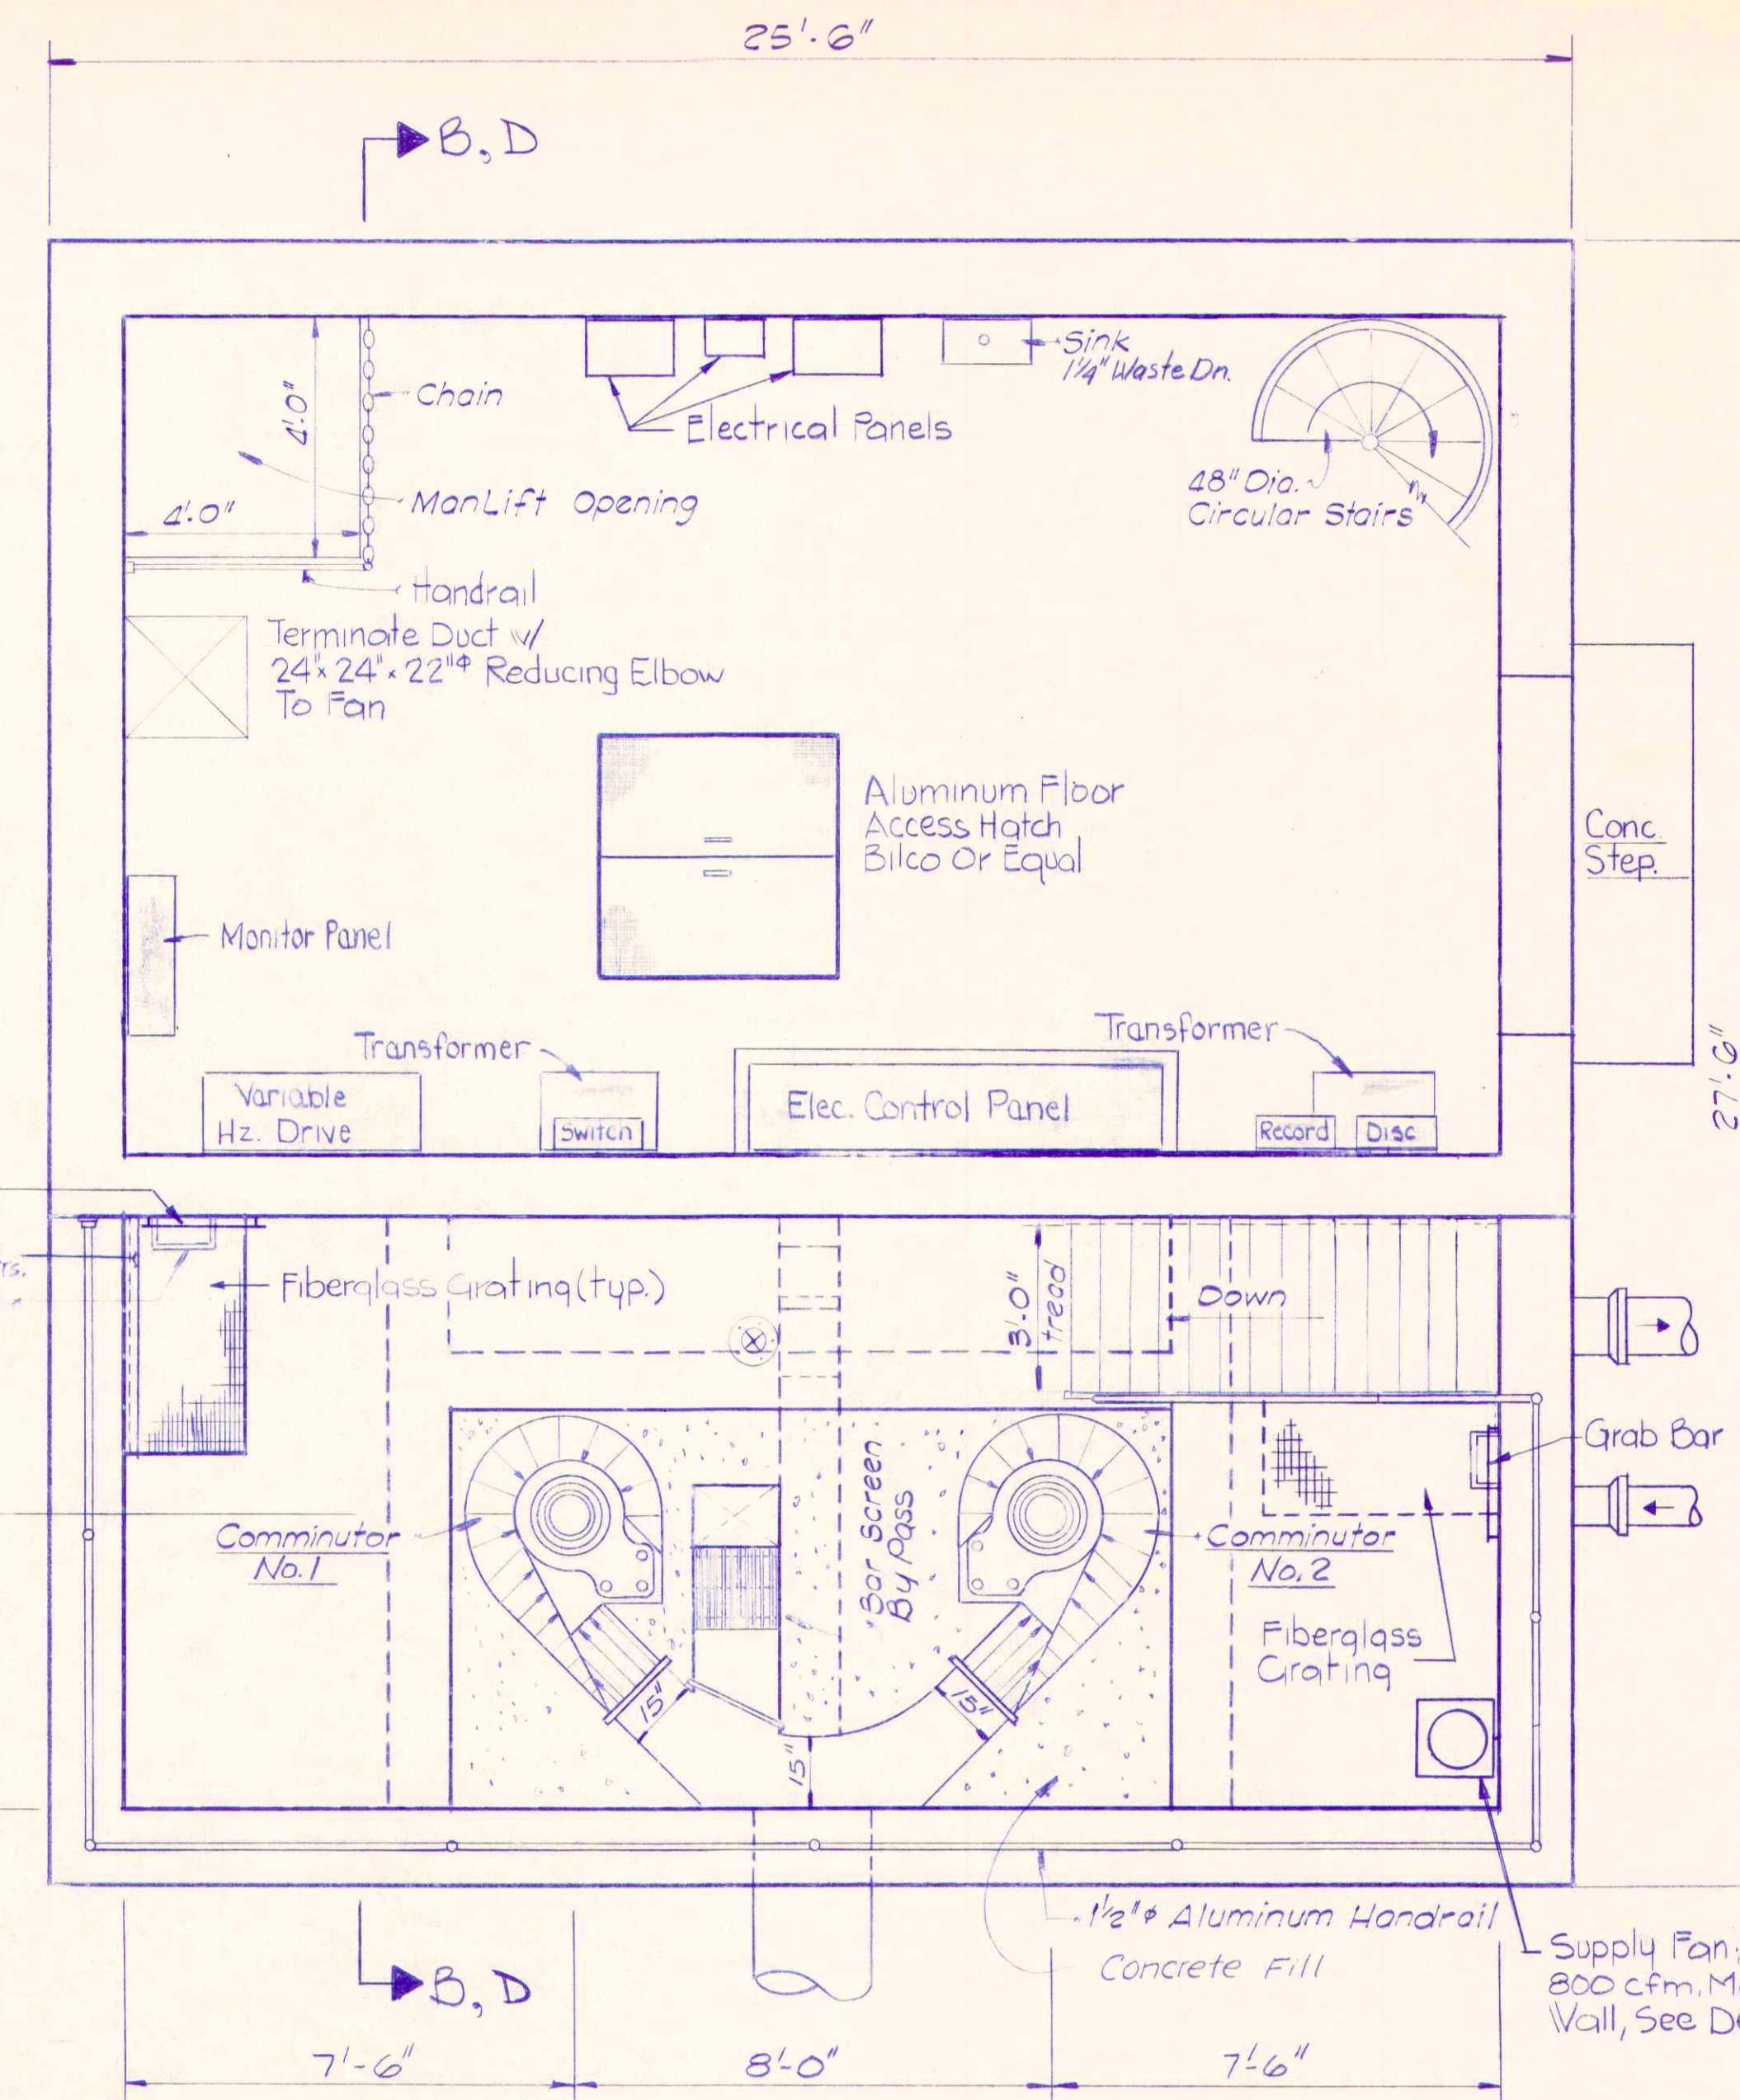


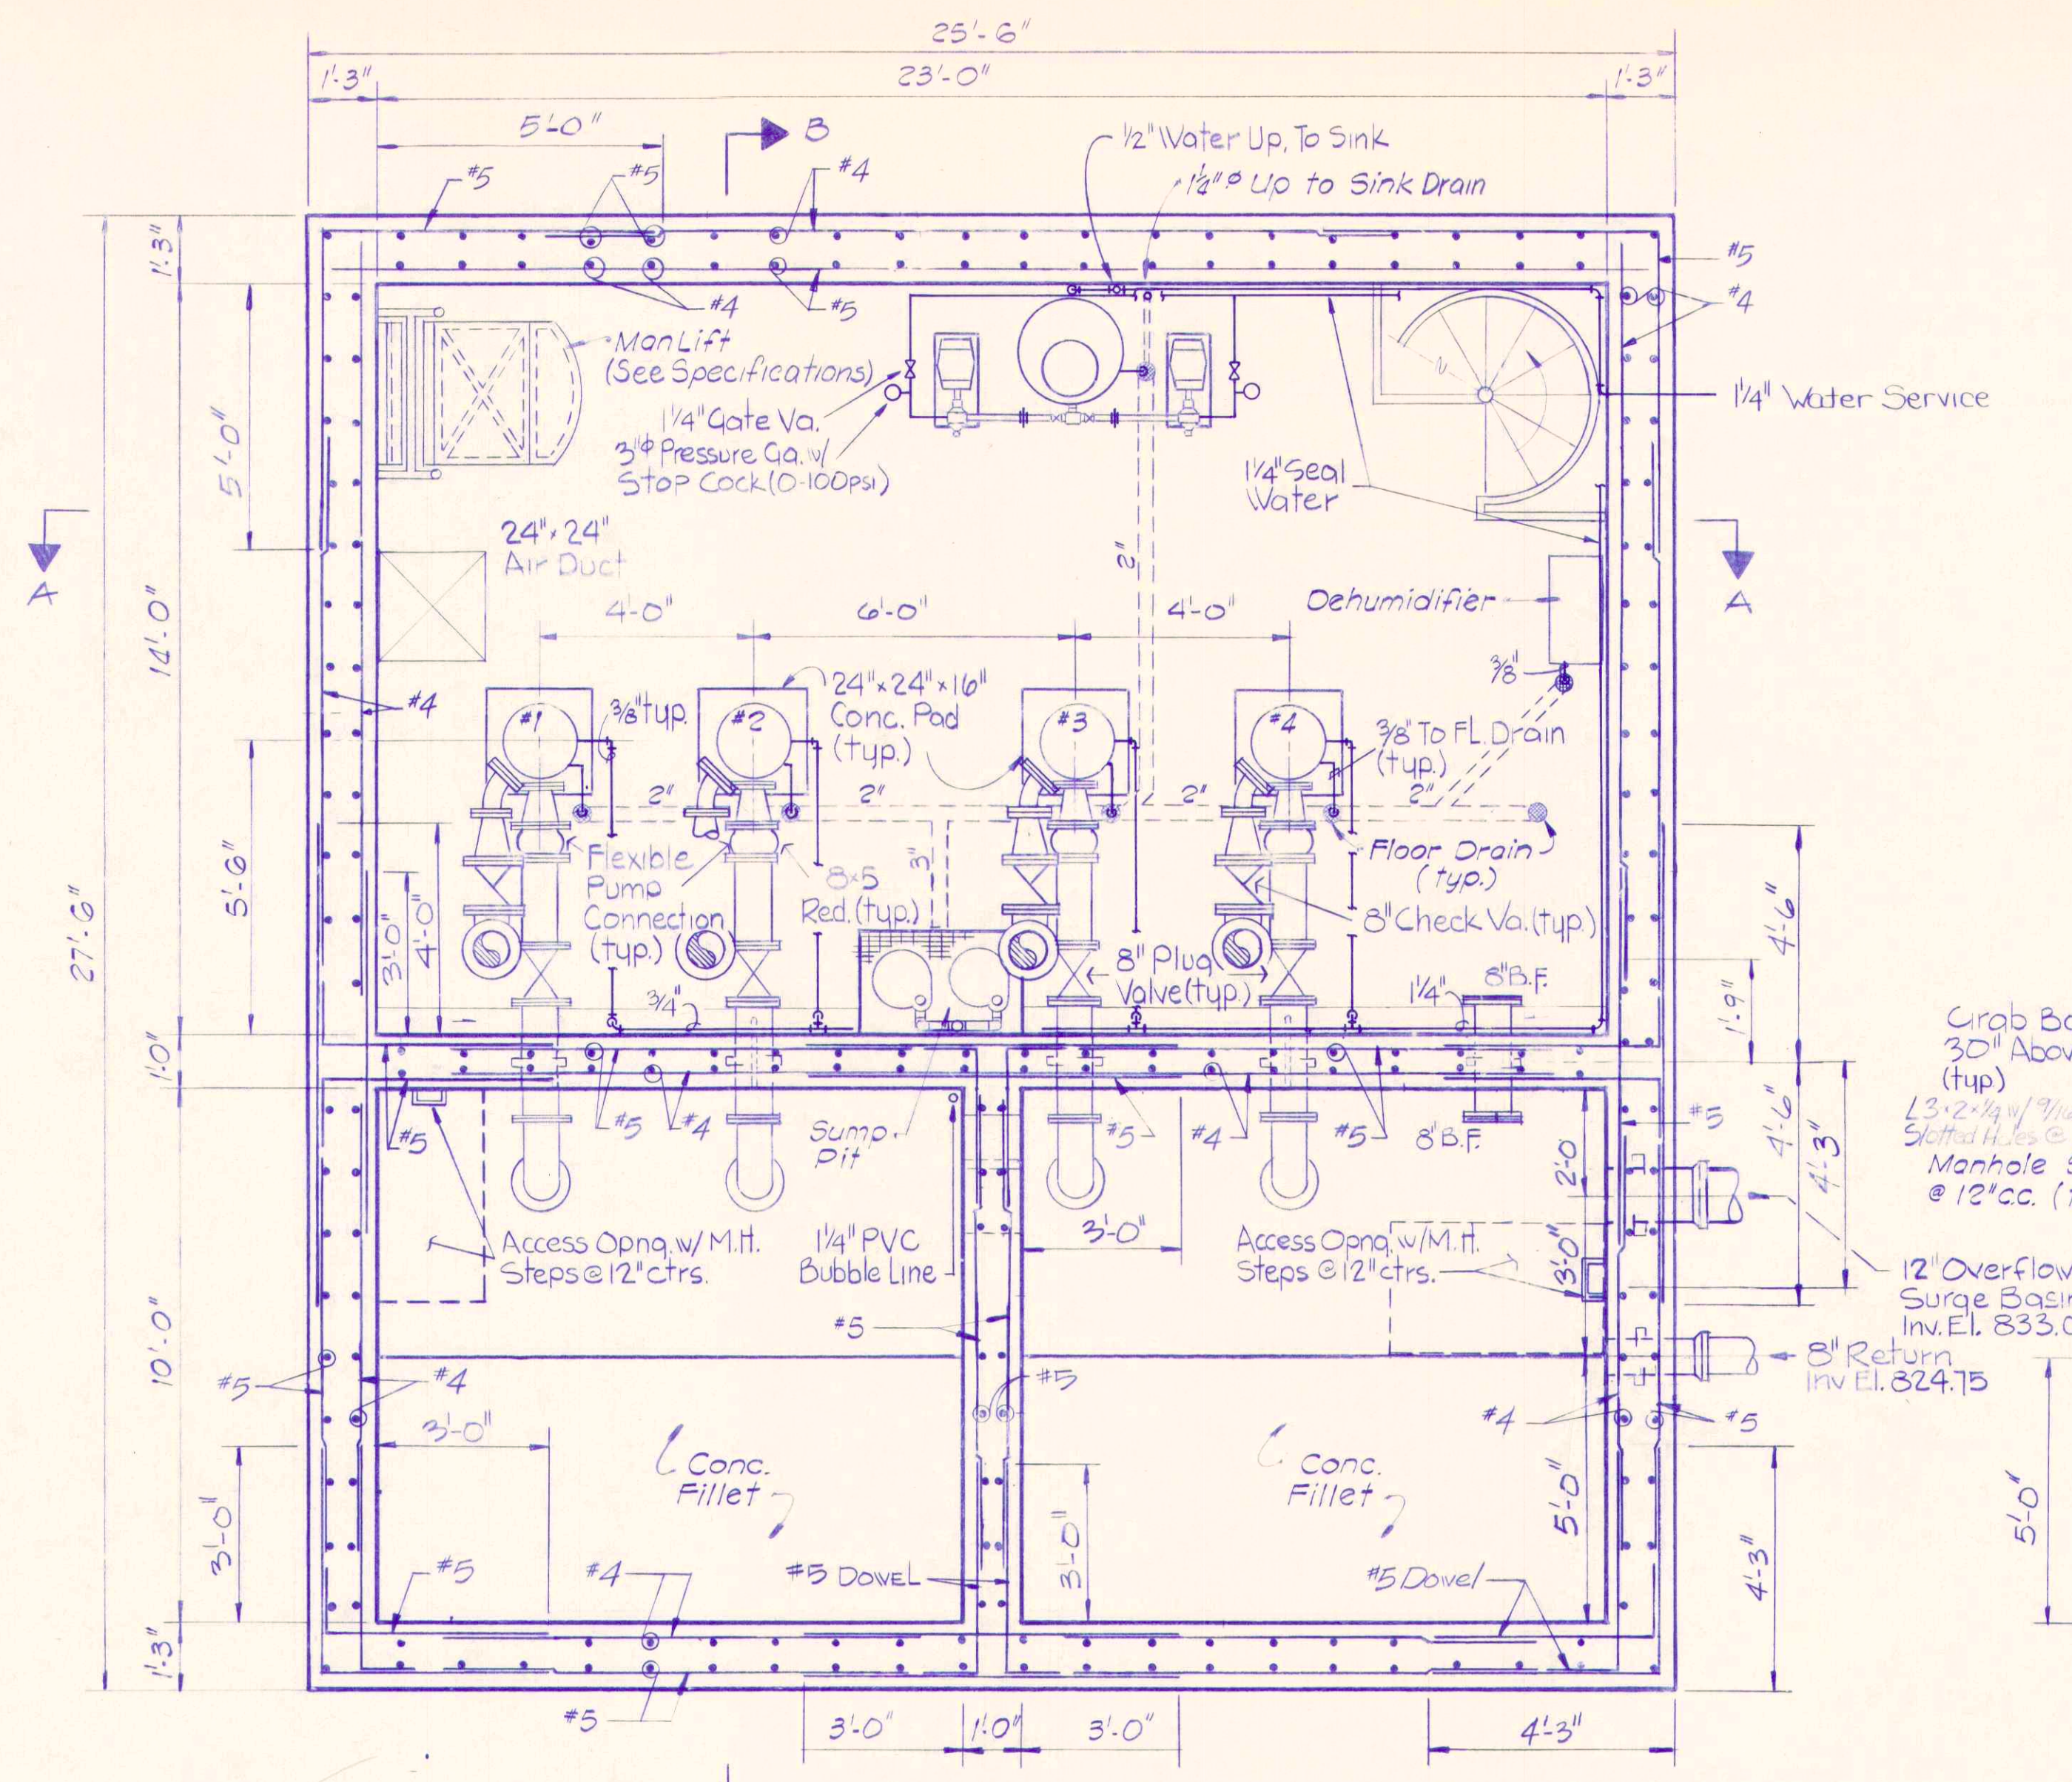

- NOTES:**
1. CONTRACTOR SHALL FURNISH CUT-OUTS WHEREVER REQUIRED EVEN IF NOT SHOWN ON PLANS.
 2. LARGE CUT-OUTS SHALL HAVE STRUCTURAL SUPPORT.
 3. LARGEST RECOMMENDED SPAN @ 1/4" DEFLECTION 100 LBS/FT. UNIFORM LOAD FOR SPECIFIED GRATING SHALL NOT BE SURPASSED FOR LARGER SPANS. CONTRACTOR SHALL FURNISH ADDITIONAL SUPPORT FOR LARGER SIZE GRATING AT NO EXTRA COST.
 4. GRATING SHALL BE REINFORCED FIBERGLASS, CHEMGRADE OR EQUAL.

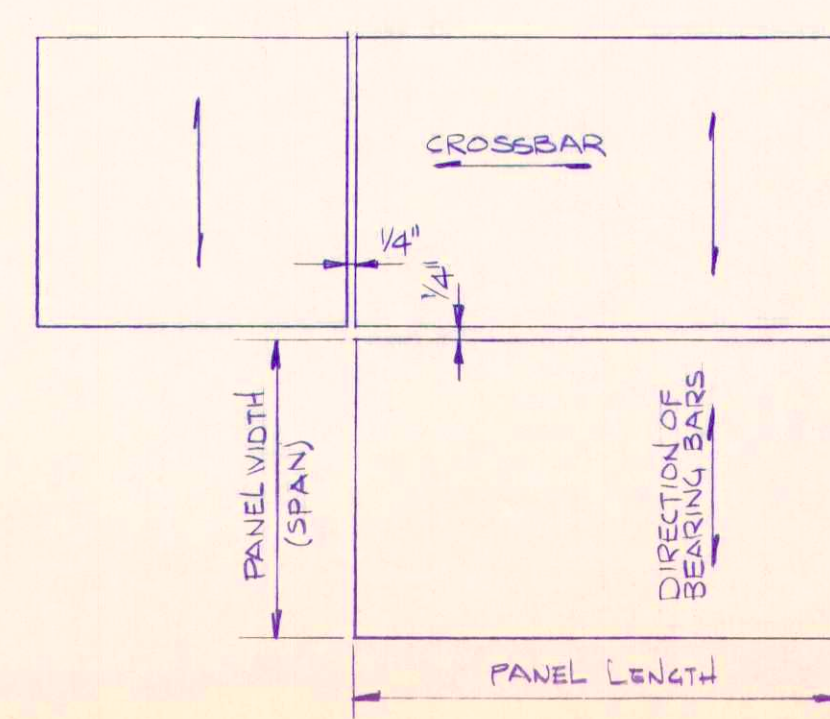

RECORD DRAWING

REFORMATORY LIFT STATION STRUCTURAL AND DETAILS

Scale: As Noted	FALL CREEK R.W.D.	Sheet
Drawn By: R.R.	BEAM, LONGEST & NEFF	71
Designed By: R.R.	Consulting Engineers	
Certified By: E.R.	8136 Castleton Road	
	Indianapolis, IN 46250	