
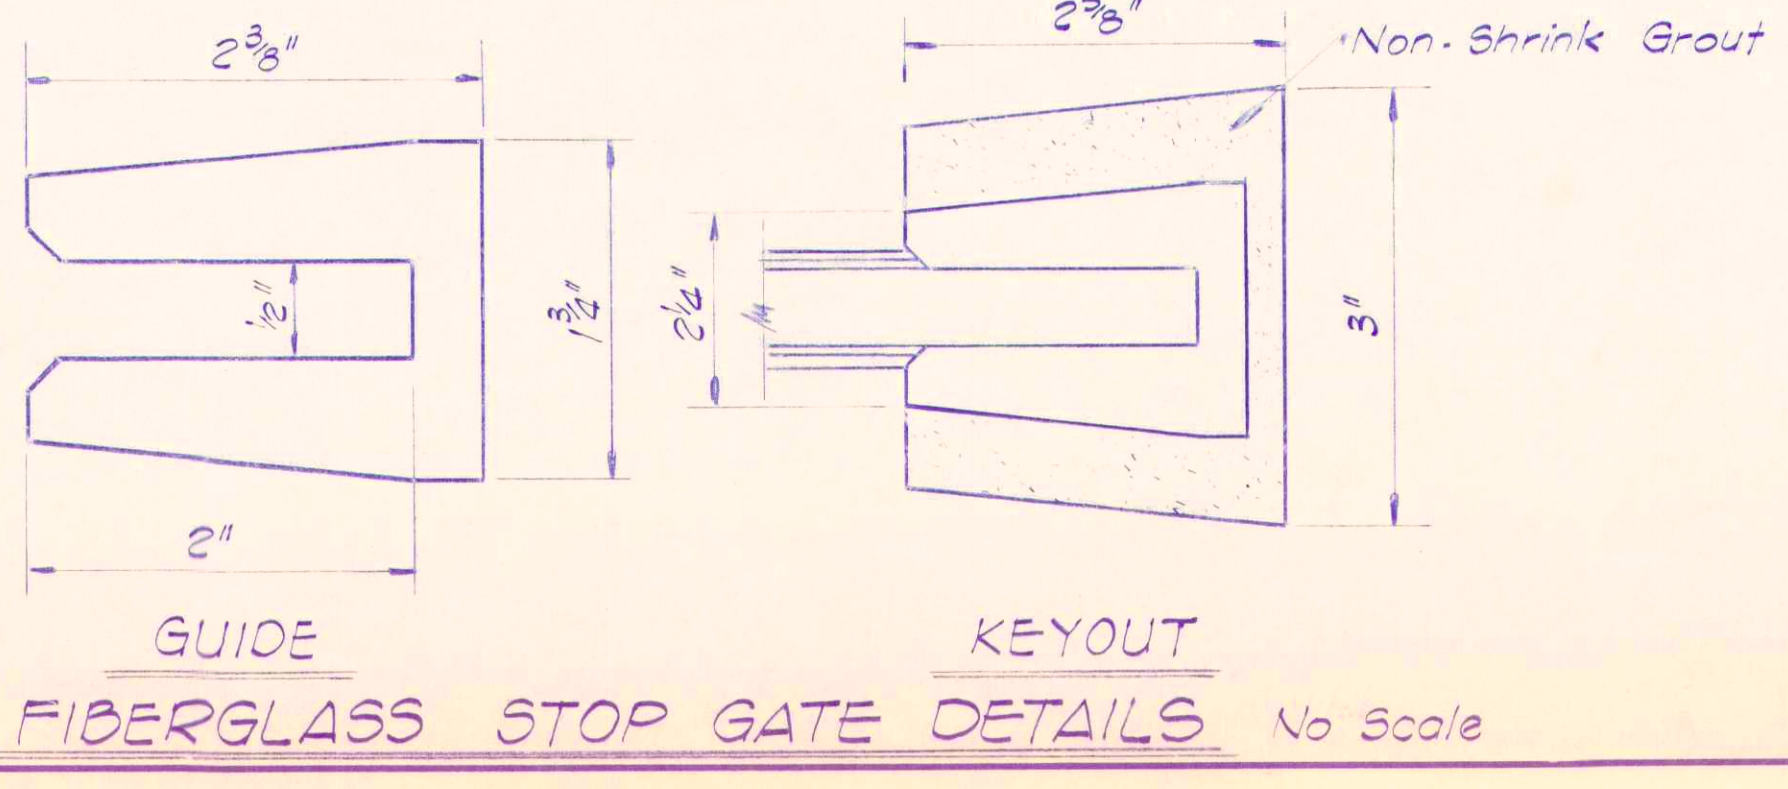
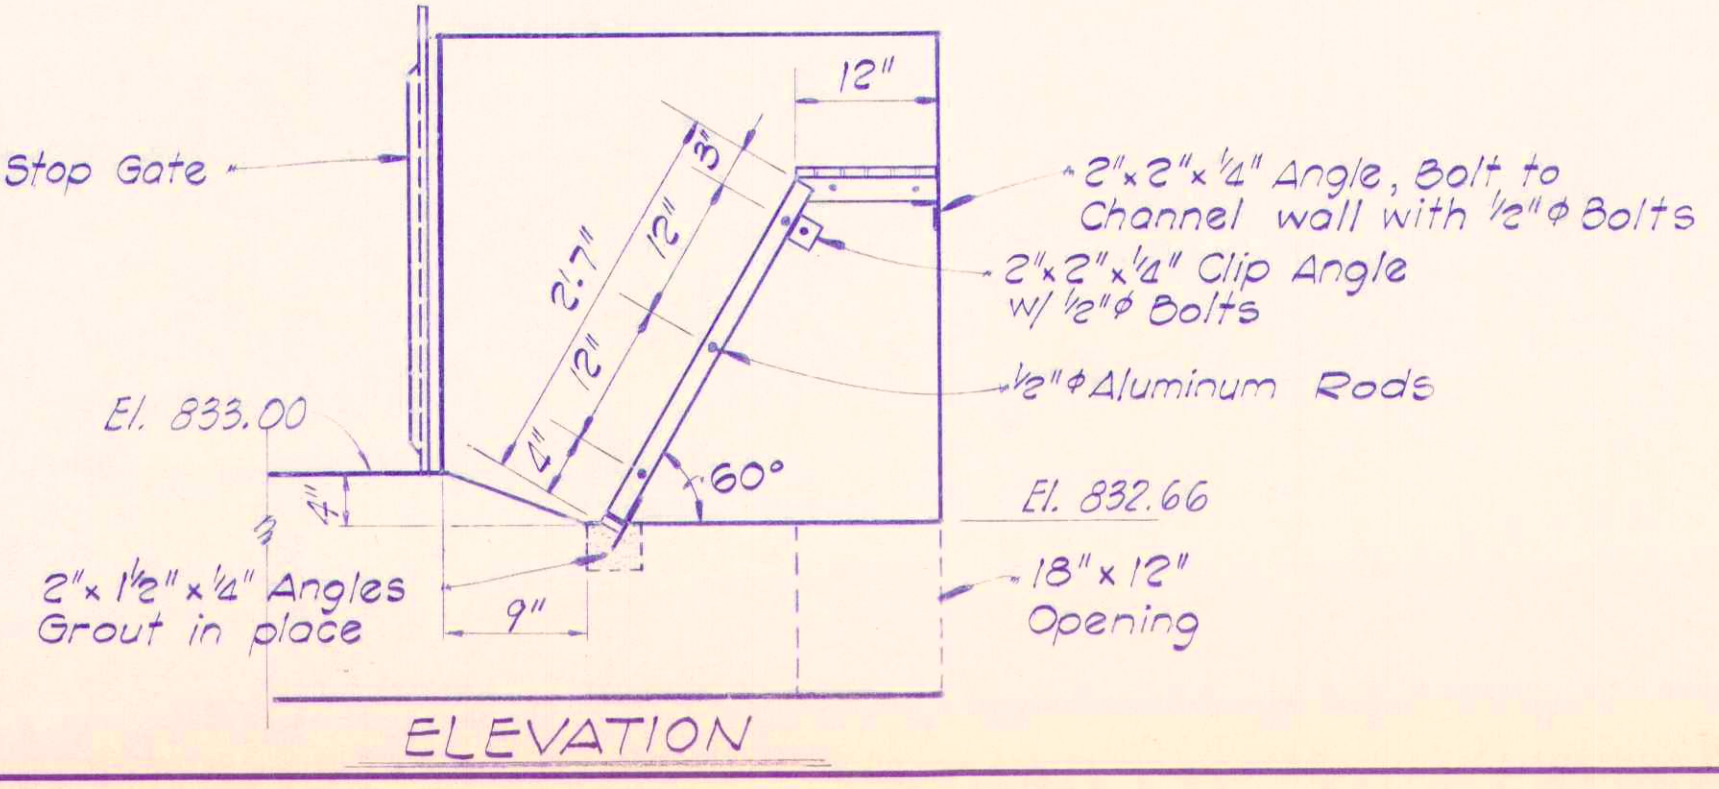
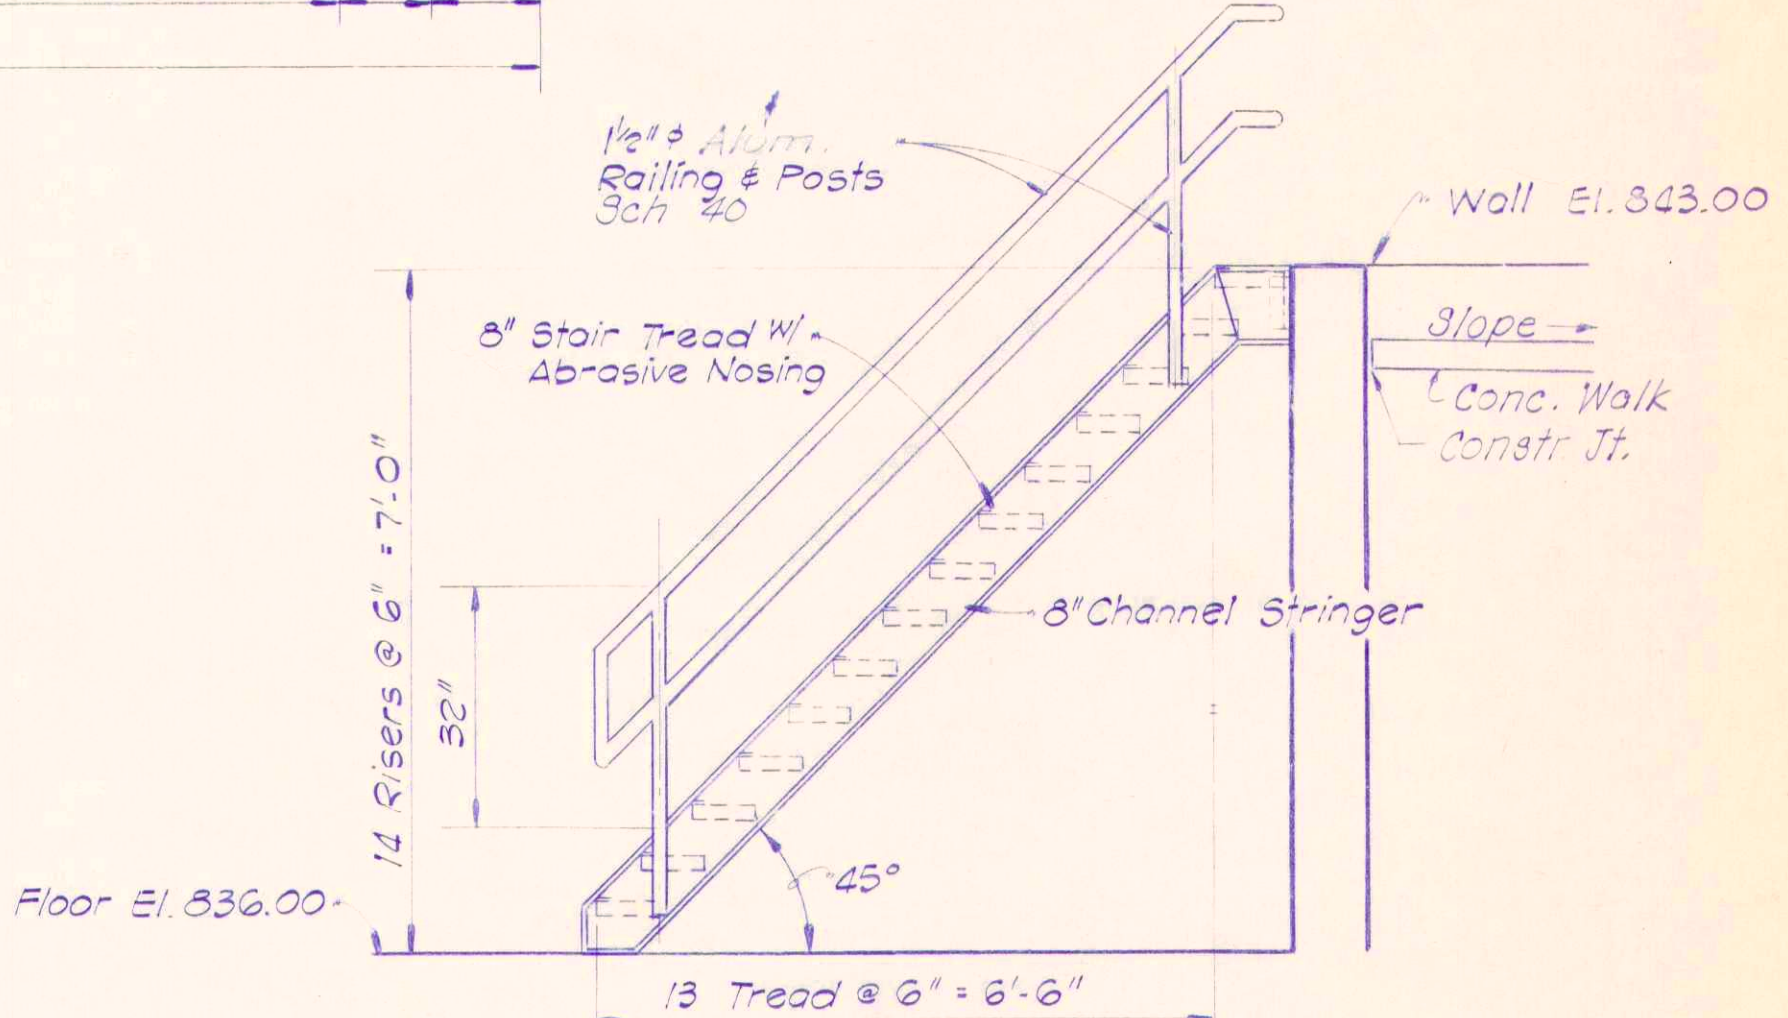
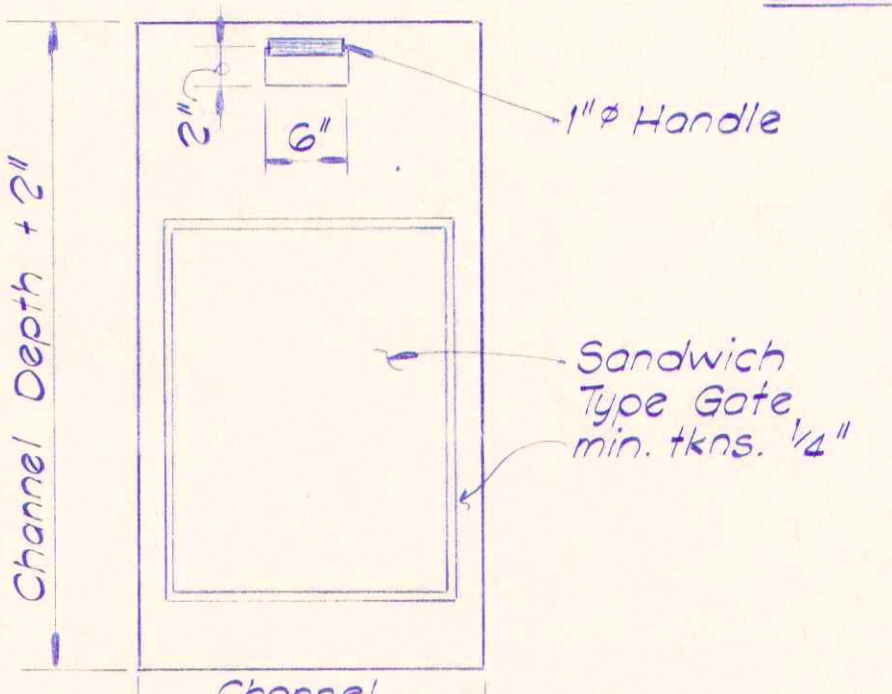
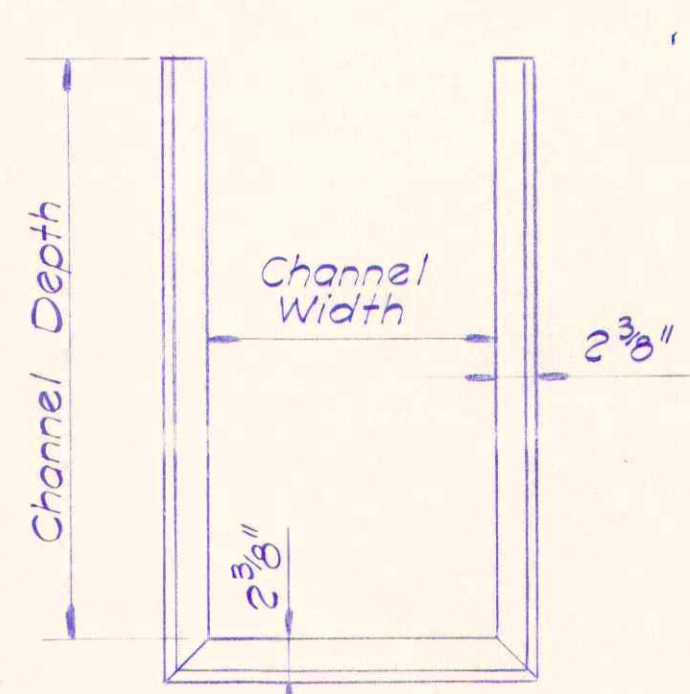
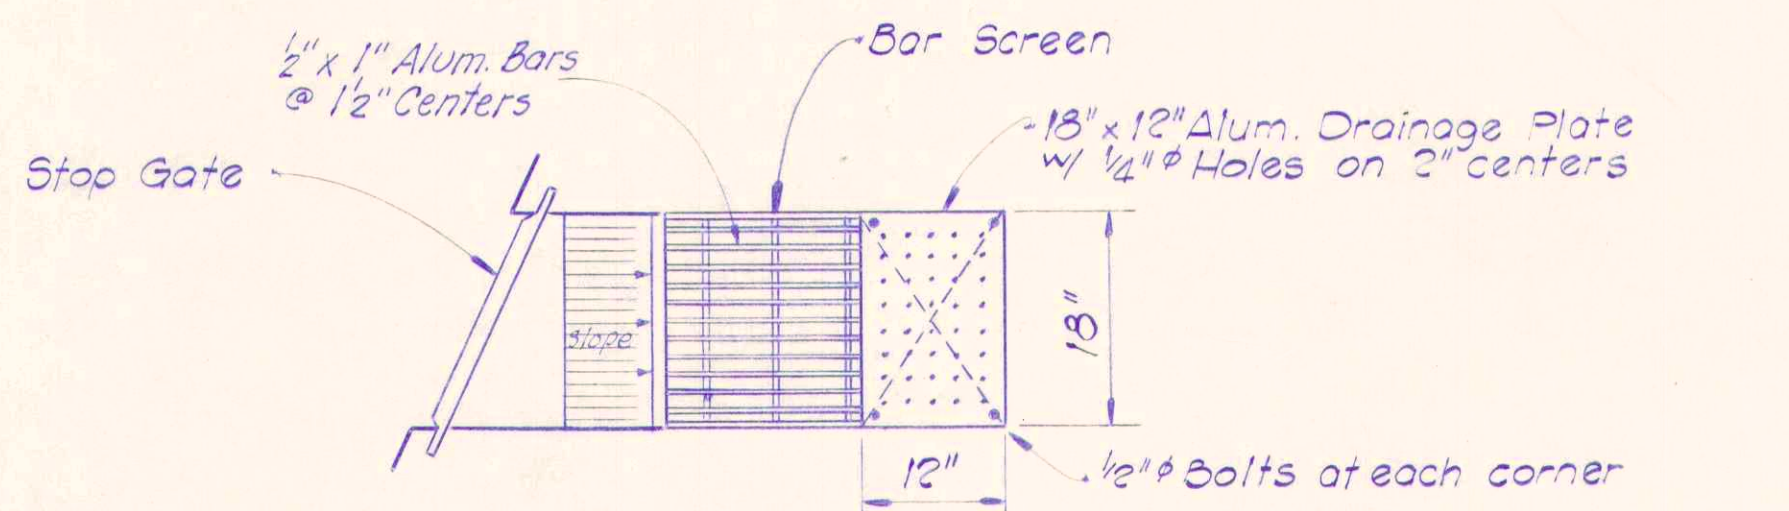
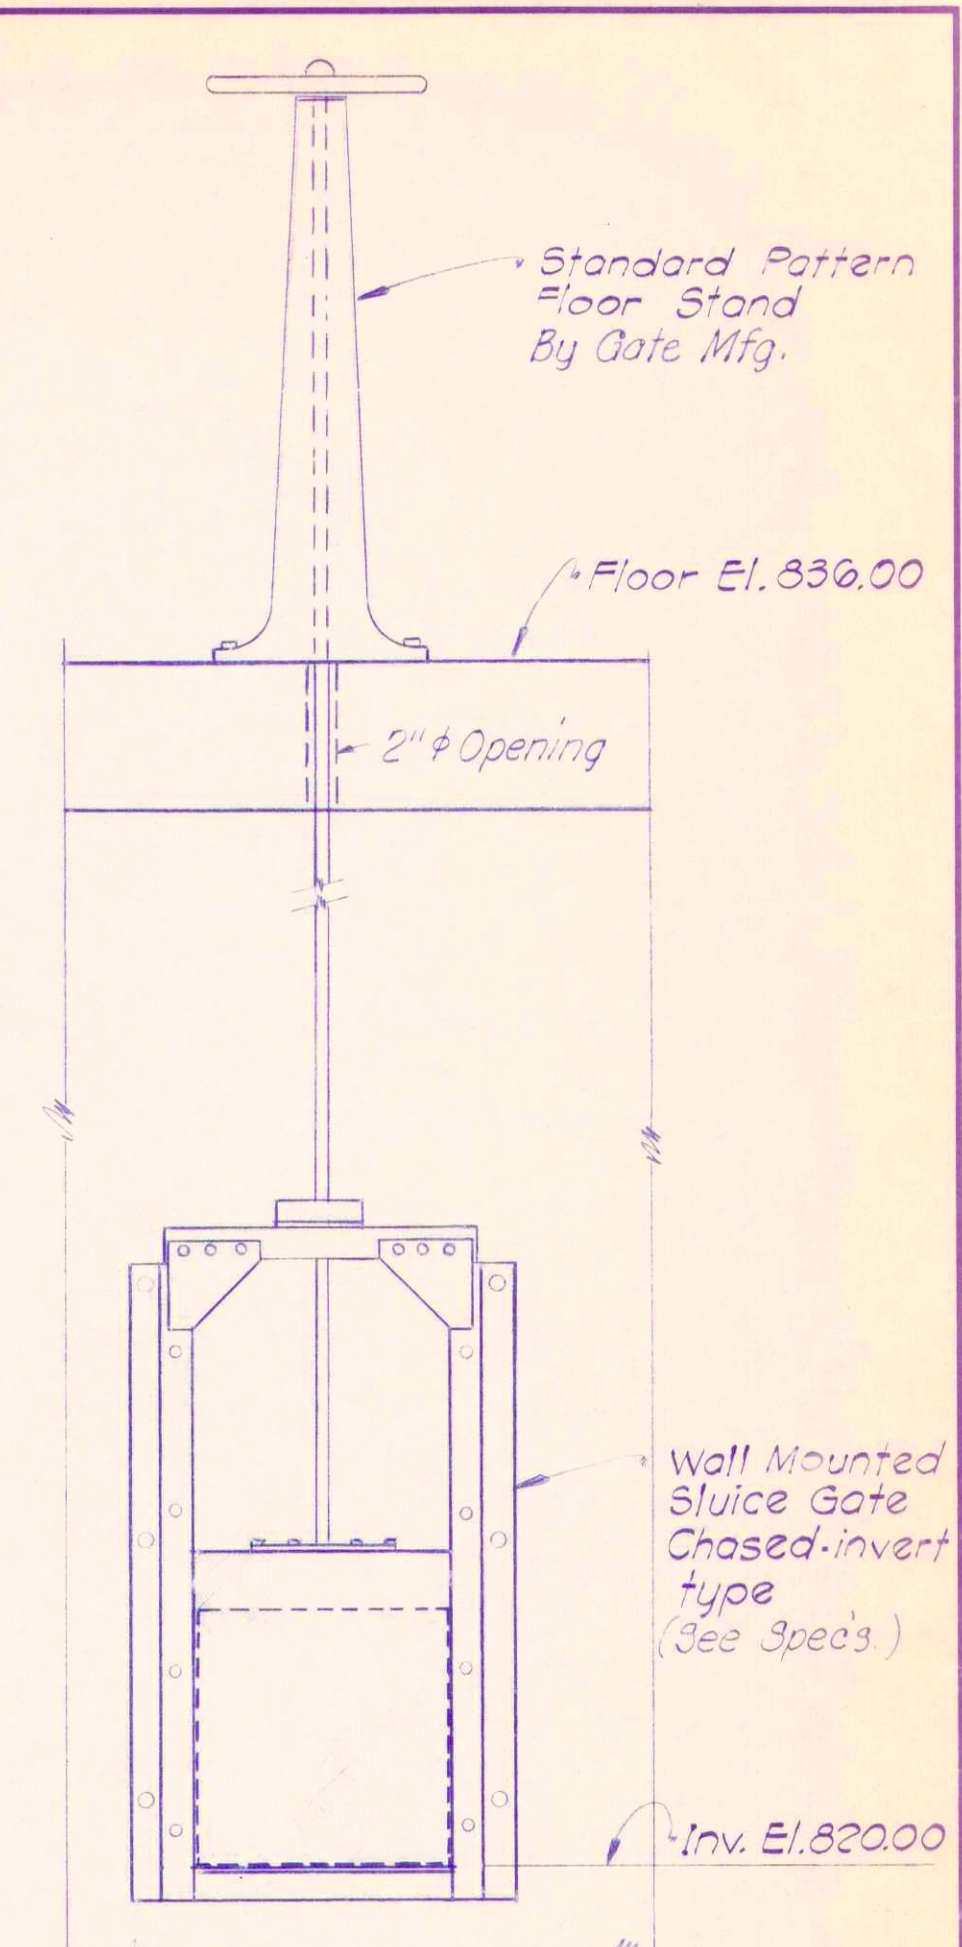
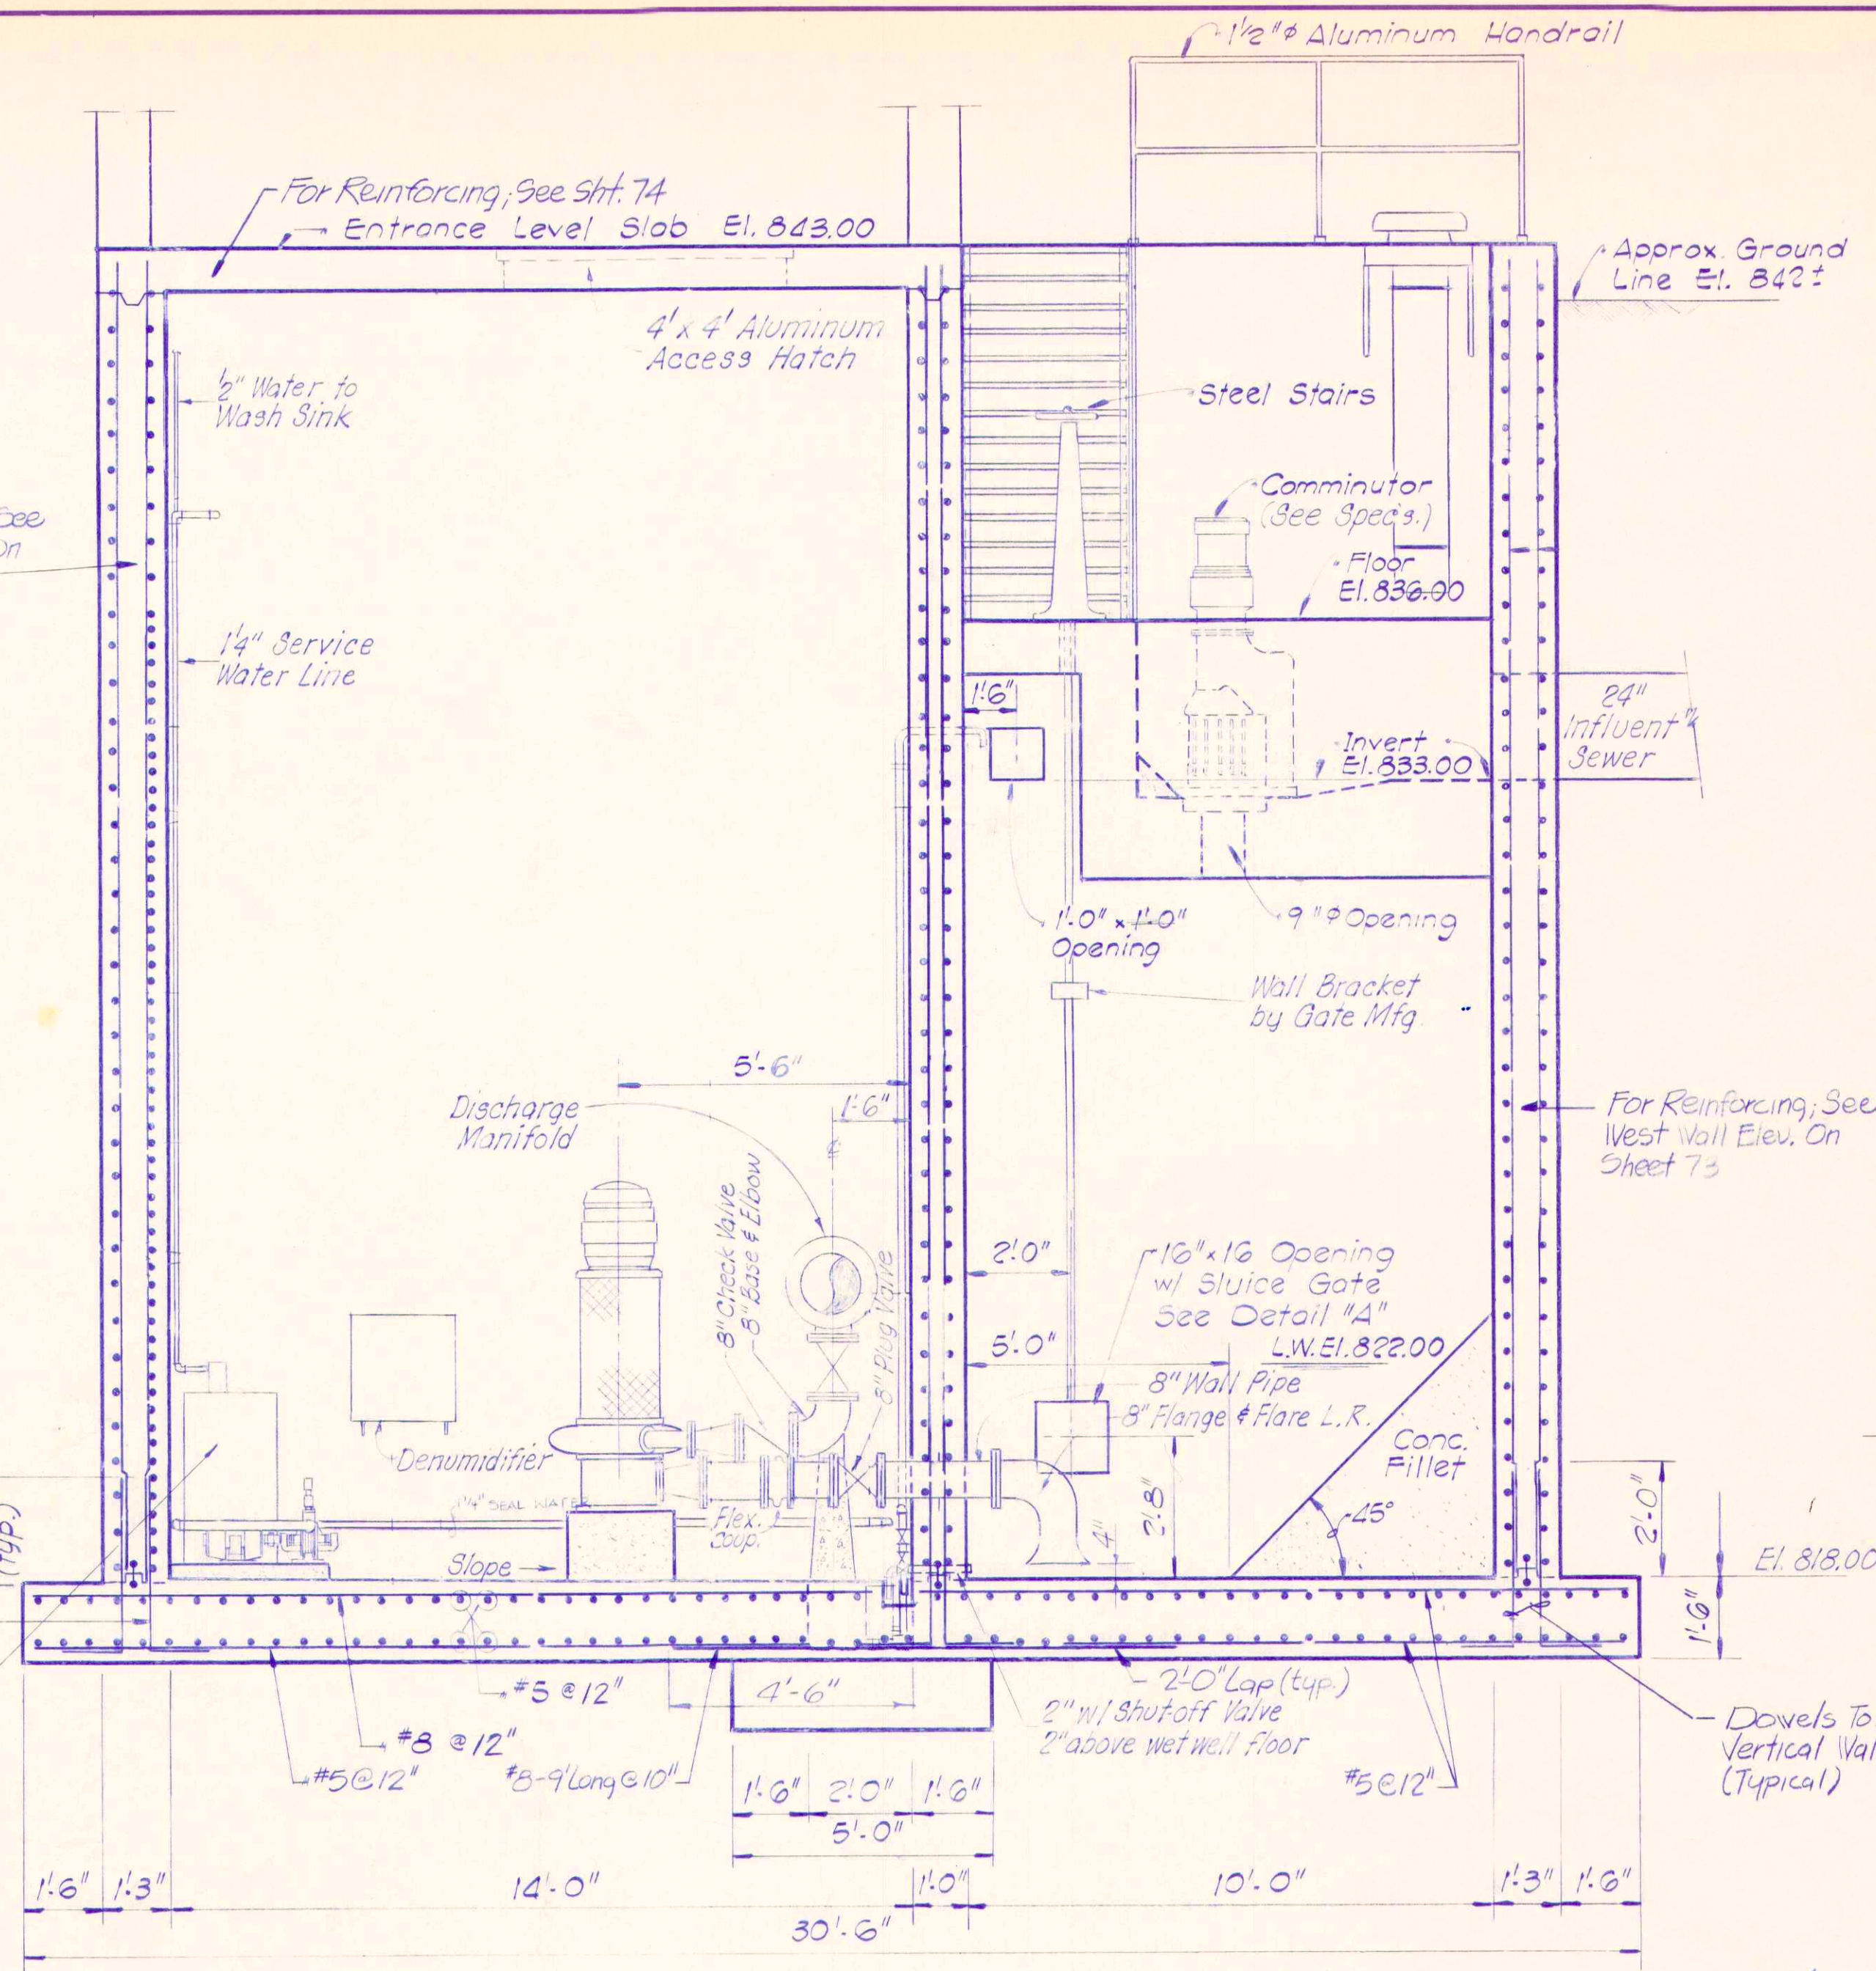


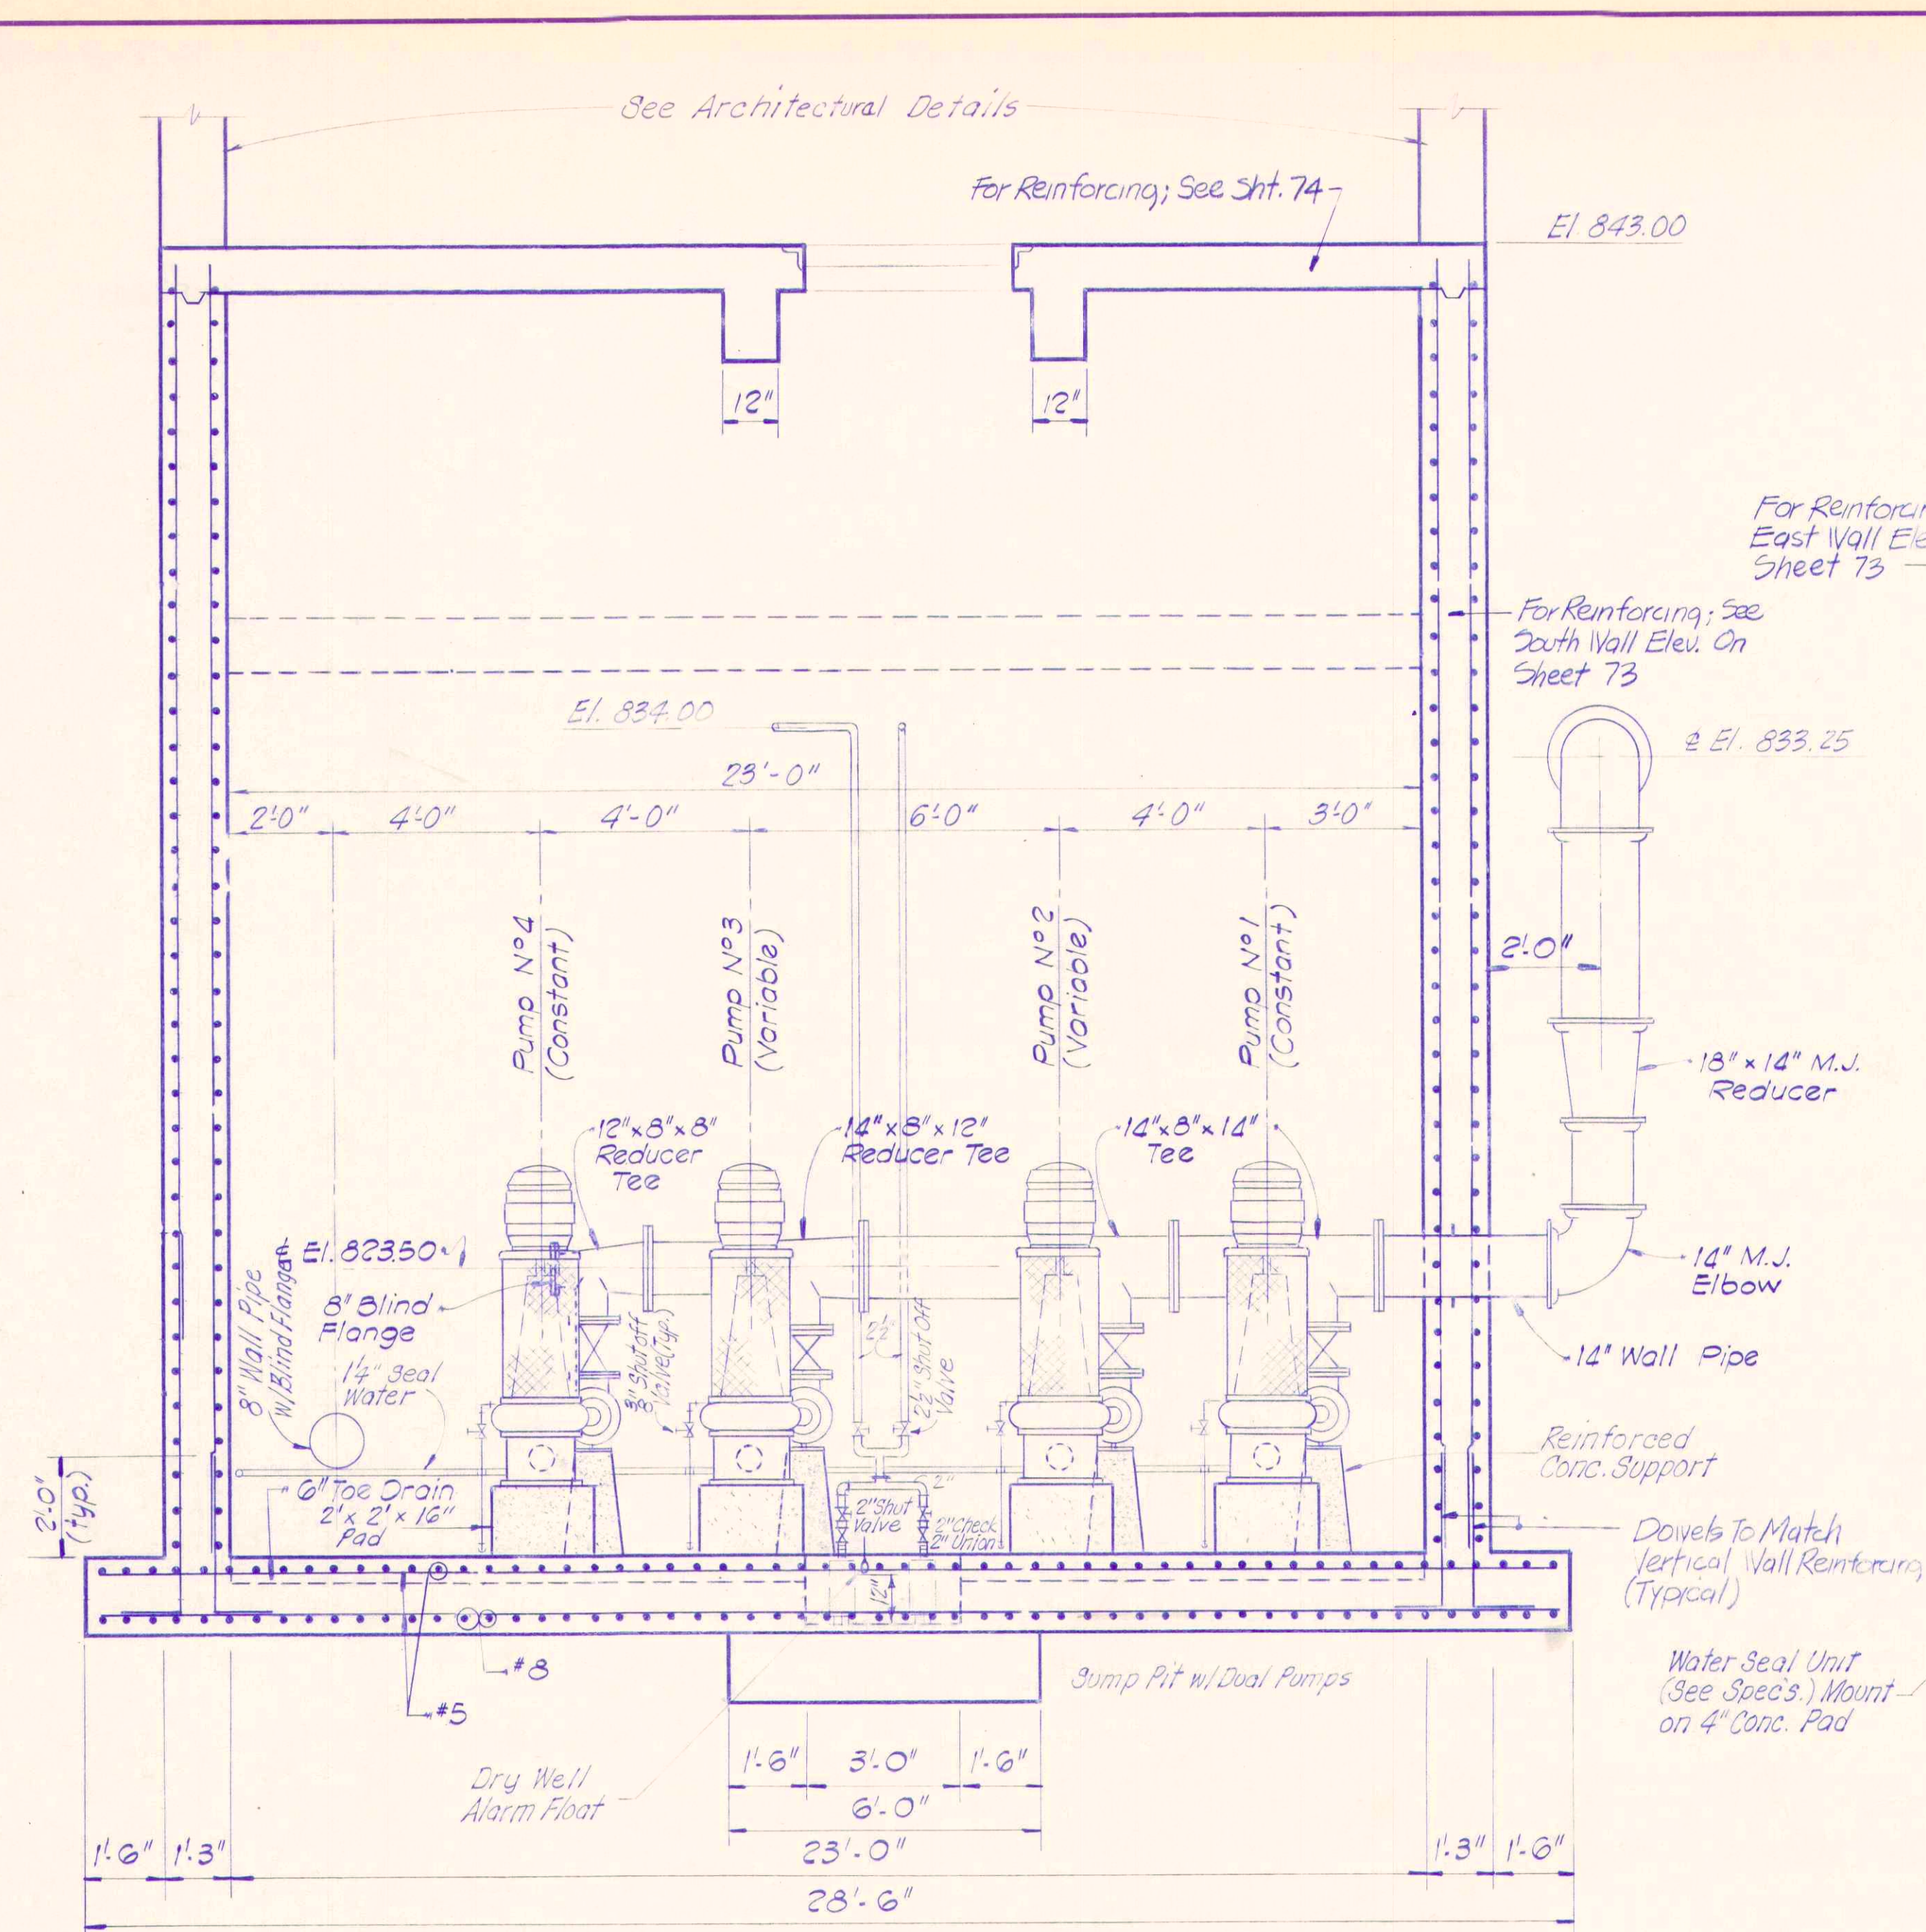

NOTE: STAIRS TO BE ANCHORED ACCORDING TO MANUFACTURER'S RECOMMENDATIONS.

RECORD DRAWING

REFORMATORY MAIN LIFT STATION SECTIONS & MISCELLANEOUS DETAILS		
Scale: As Noted	FALL CREEK R.W.D.	Sheet
Drawn By: D.G.	BEAM, LONGEST & NEFF	72
Designed By: RFS J.P.	Consulting Engineers	
Certified By: E.R.	8136 Castleton Road Indianapolis, IN 46250	