




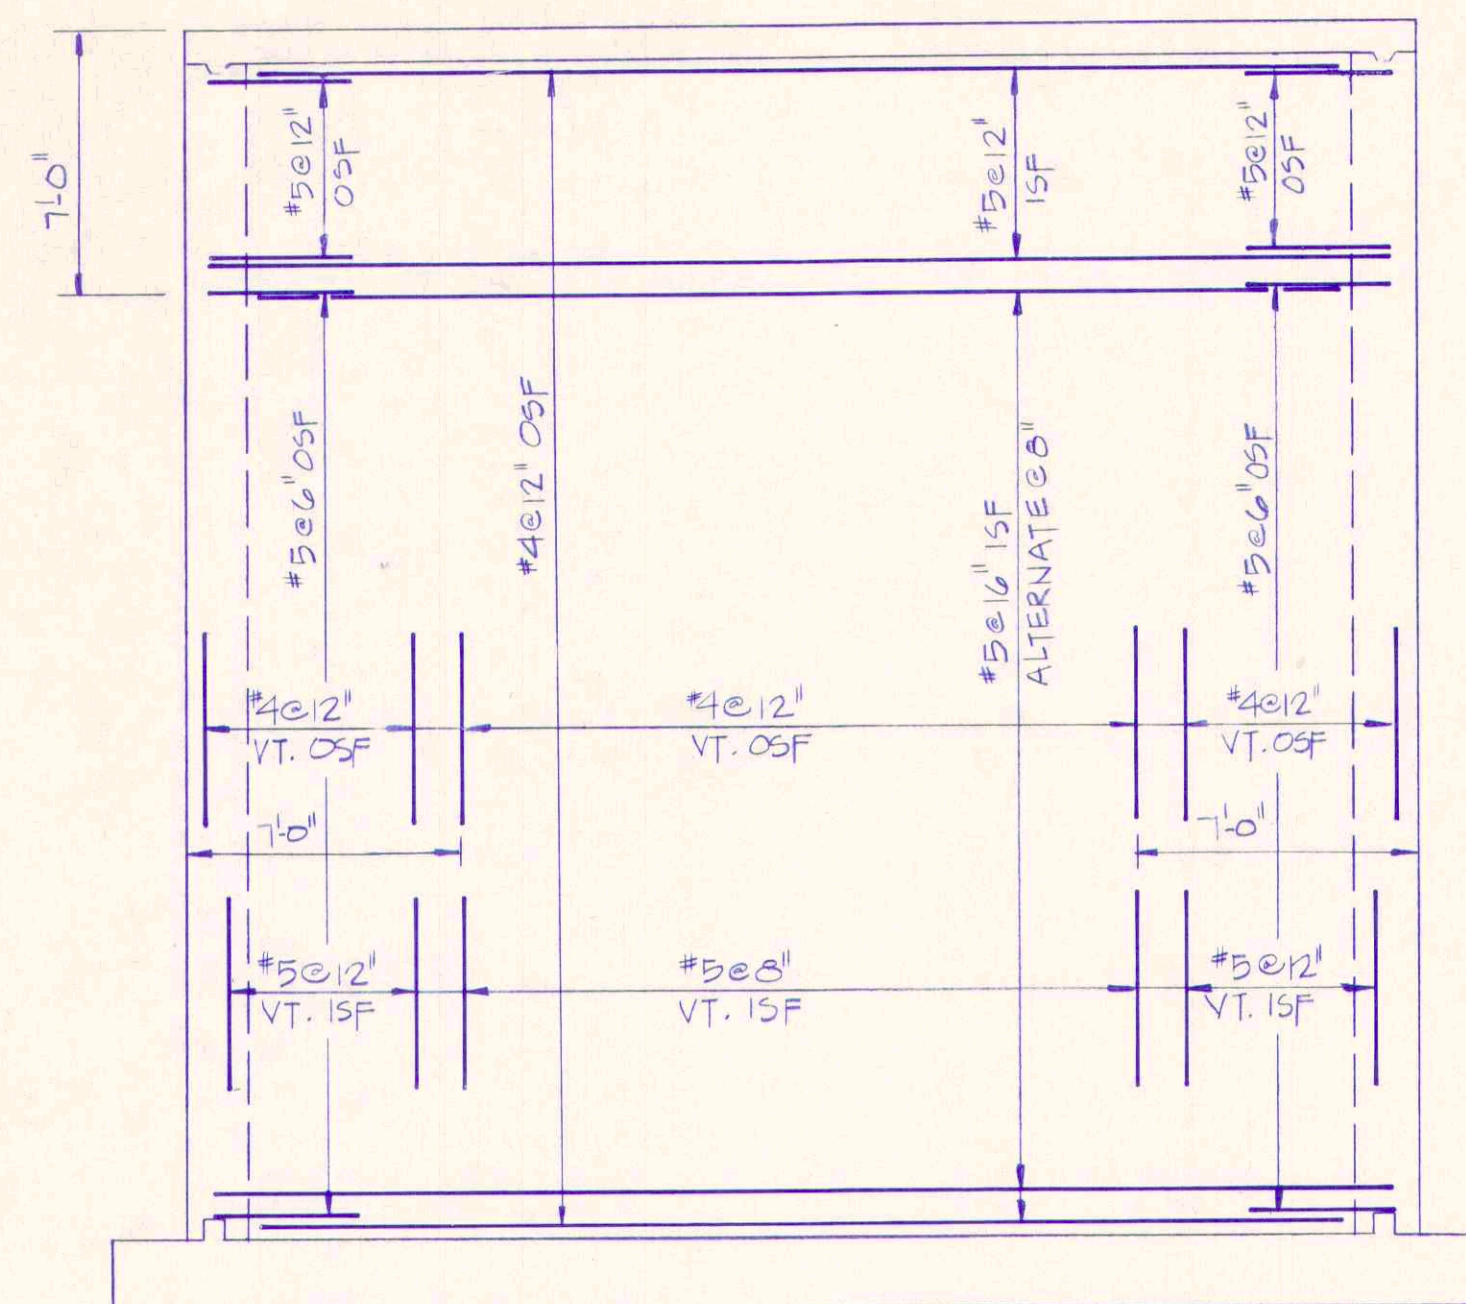


WEST WALL ELEVATION
SCALE 1/4" = 1'-0"

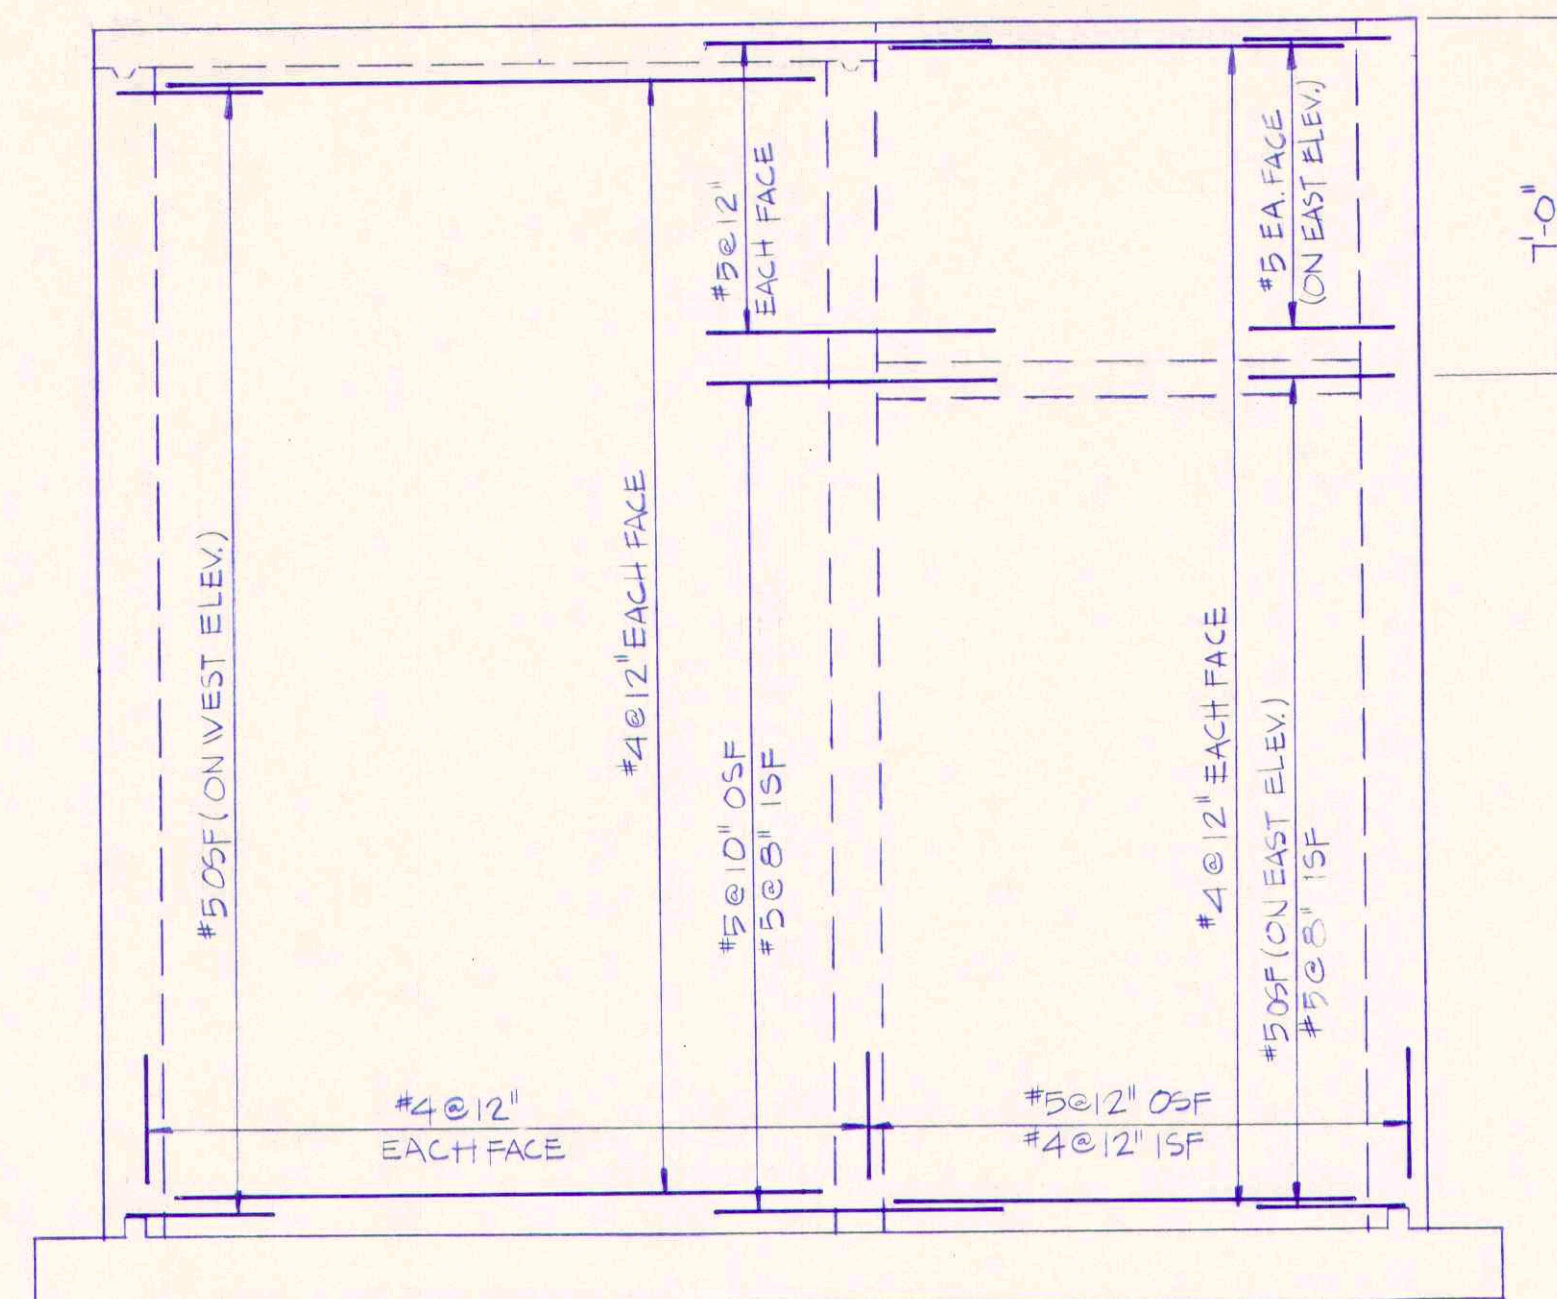


SOUTH WALL ELEVATION
SCALE 1/4" = 1'-0"

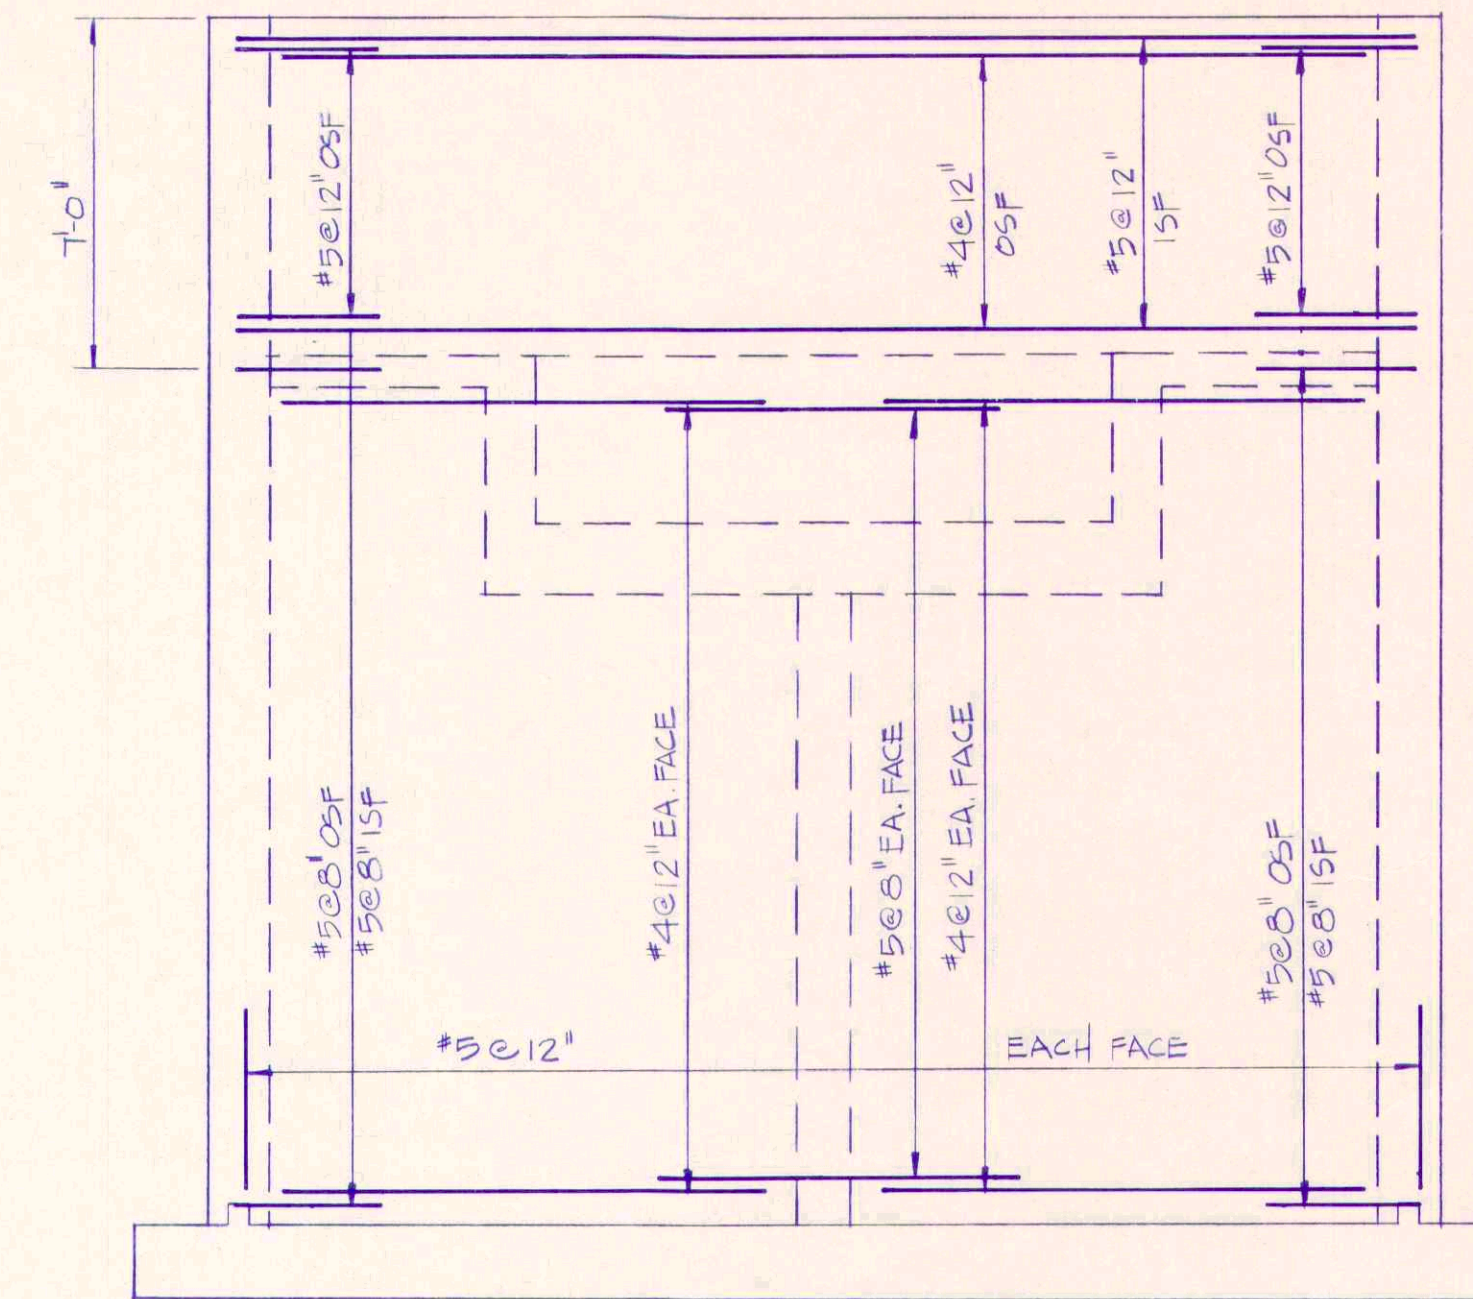


EAST WALL ELEVATION
SCALE 1/4" = 1'-0"

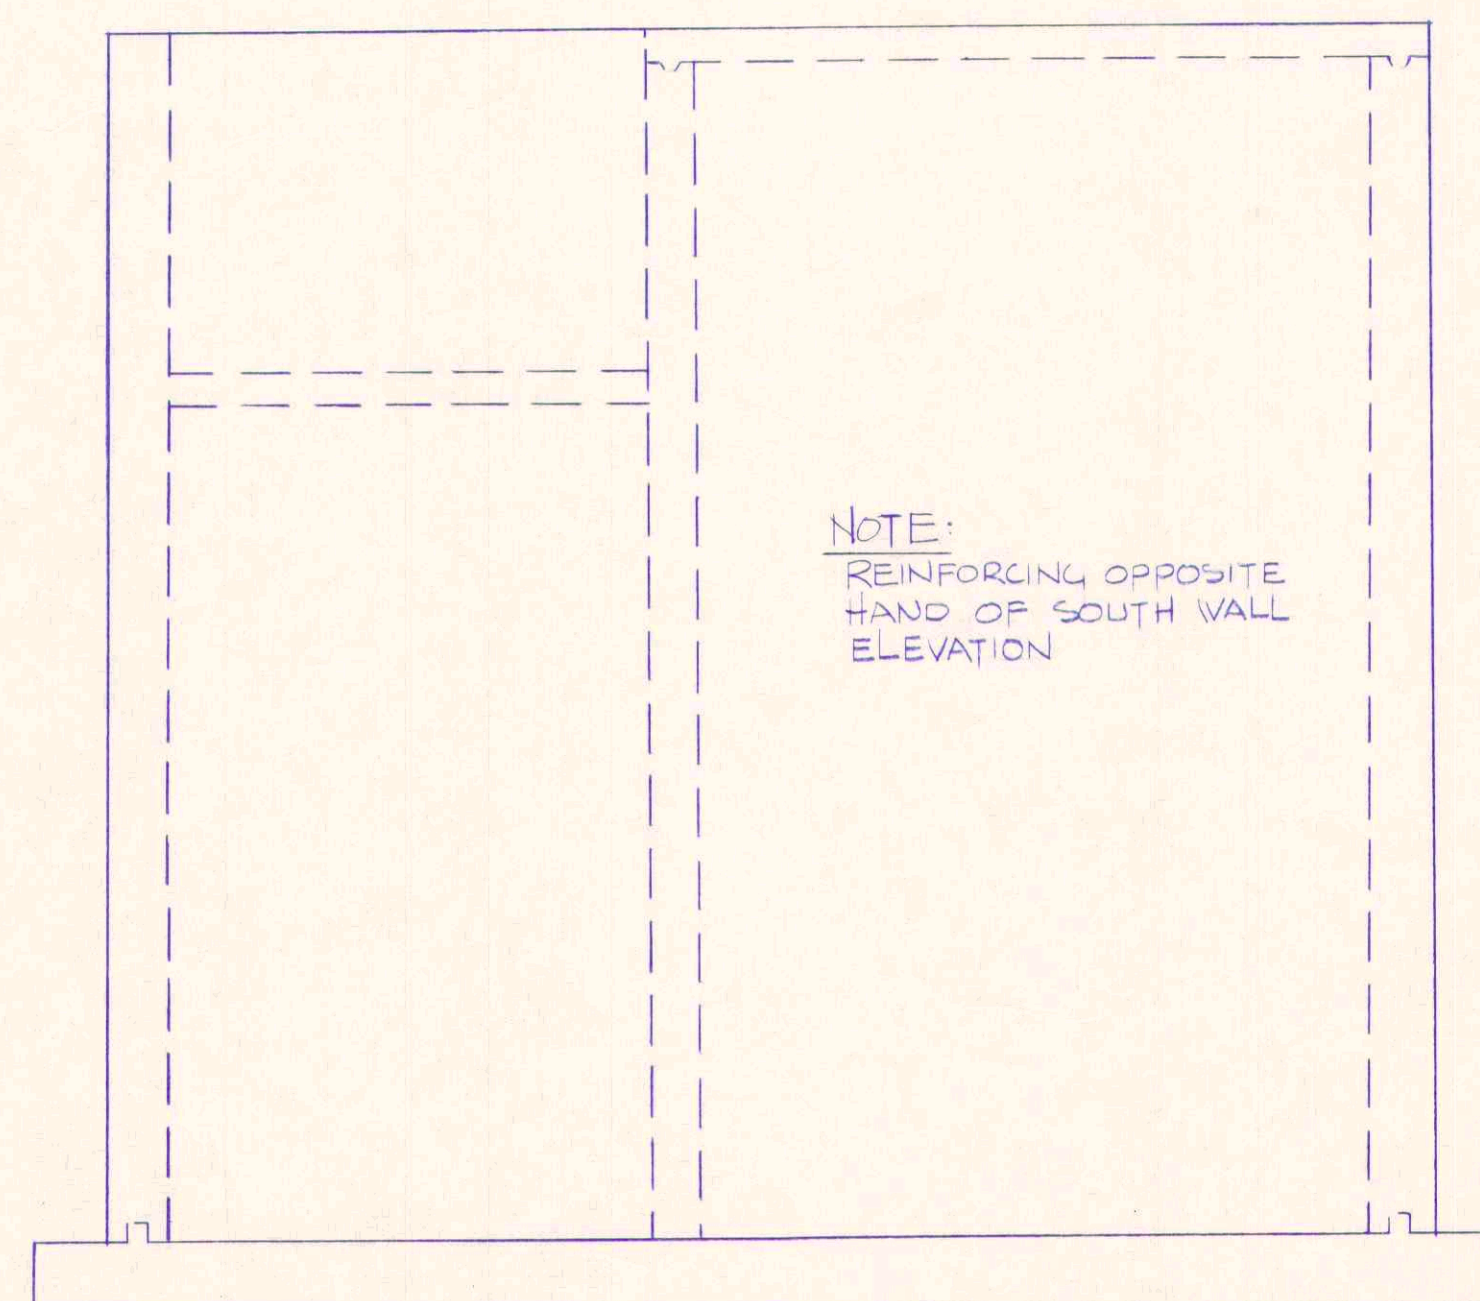

NORTH WALL ELEVATION
SCALE 1/4" = 1'-0"

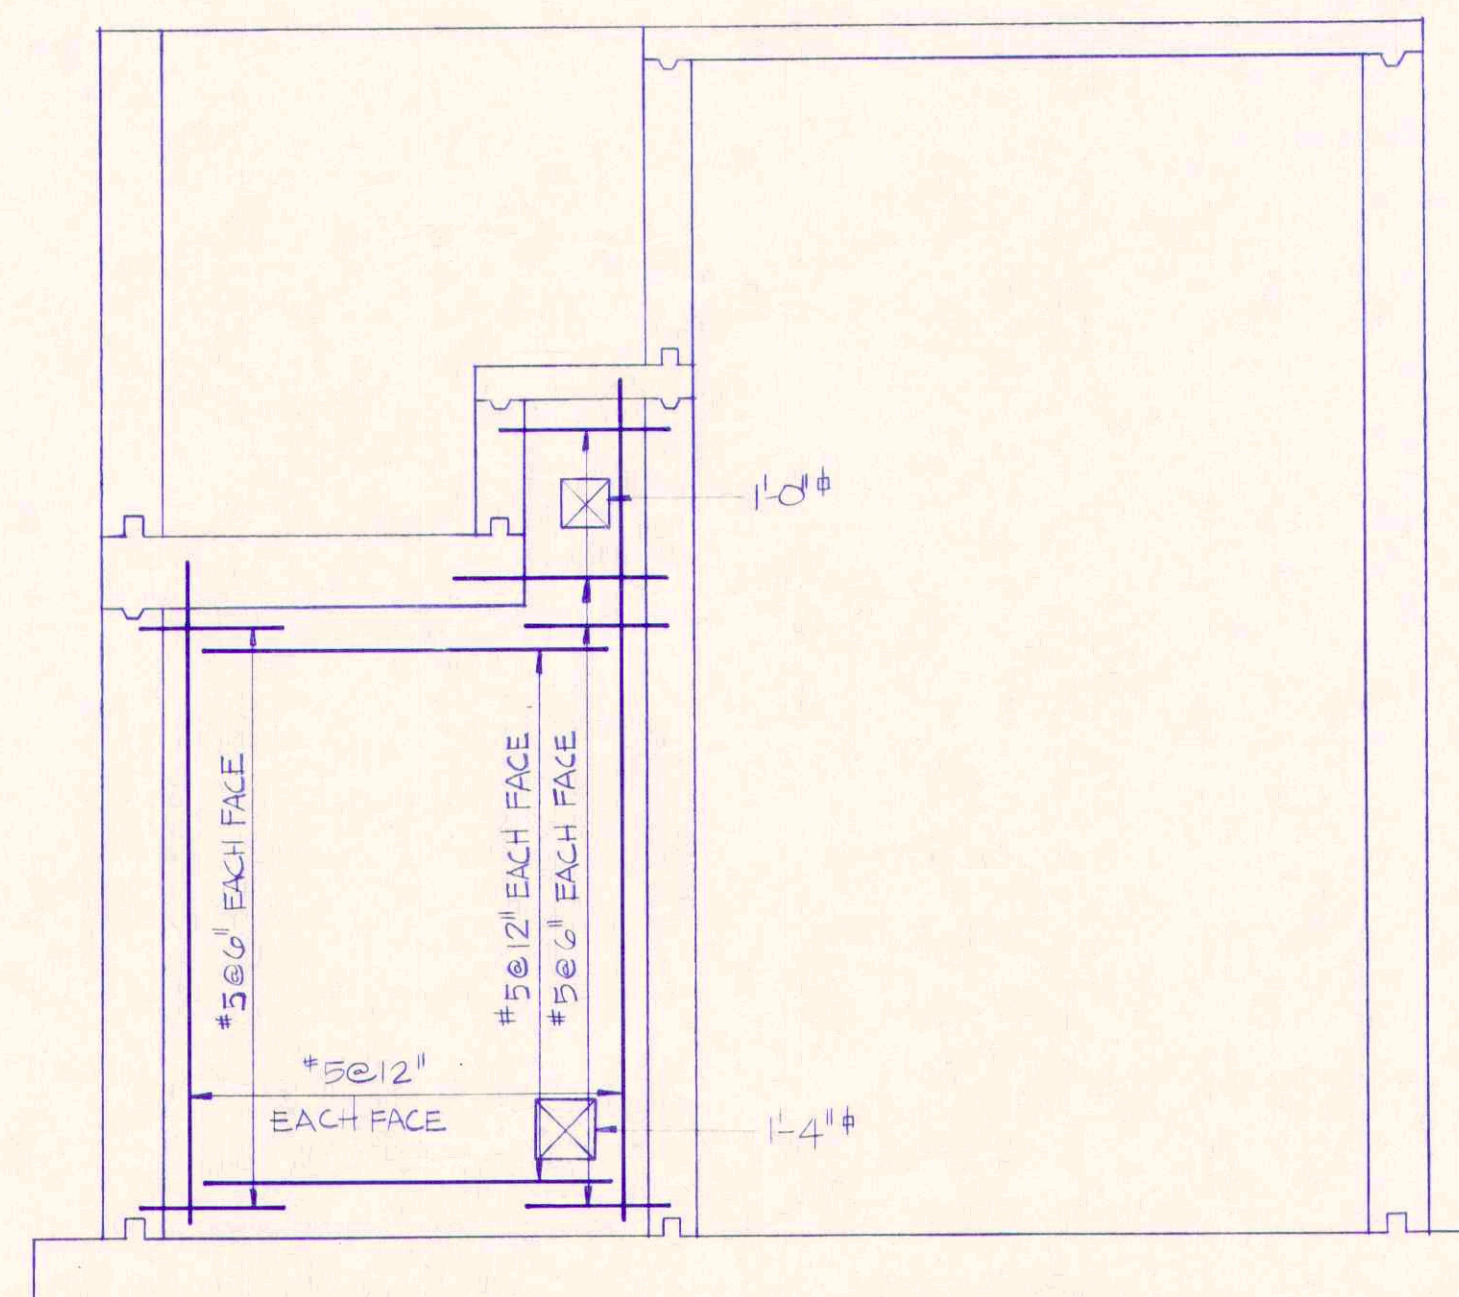

INTERIOR WALL, LOOKING SOUTH
SCALE 1/4" = 1'-0"

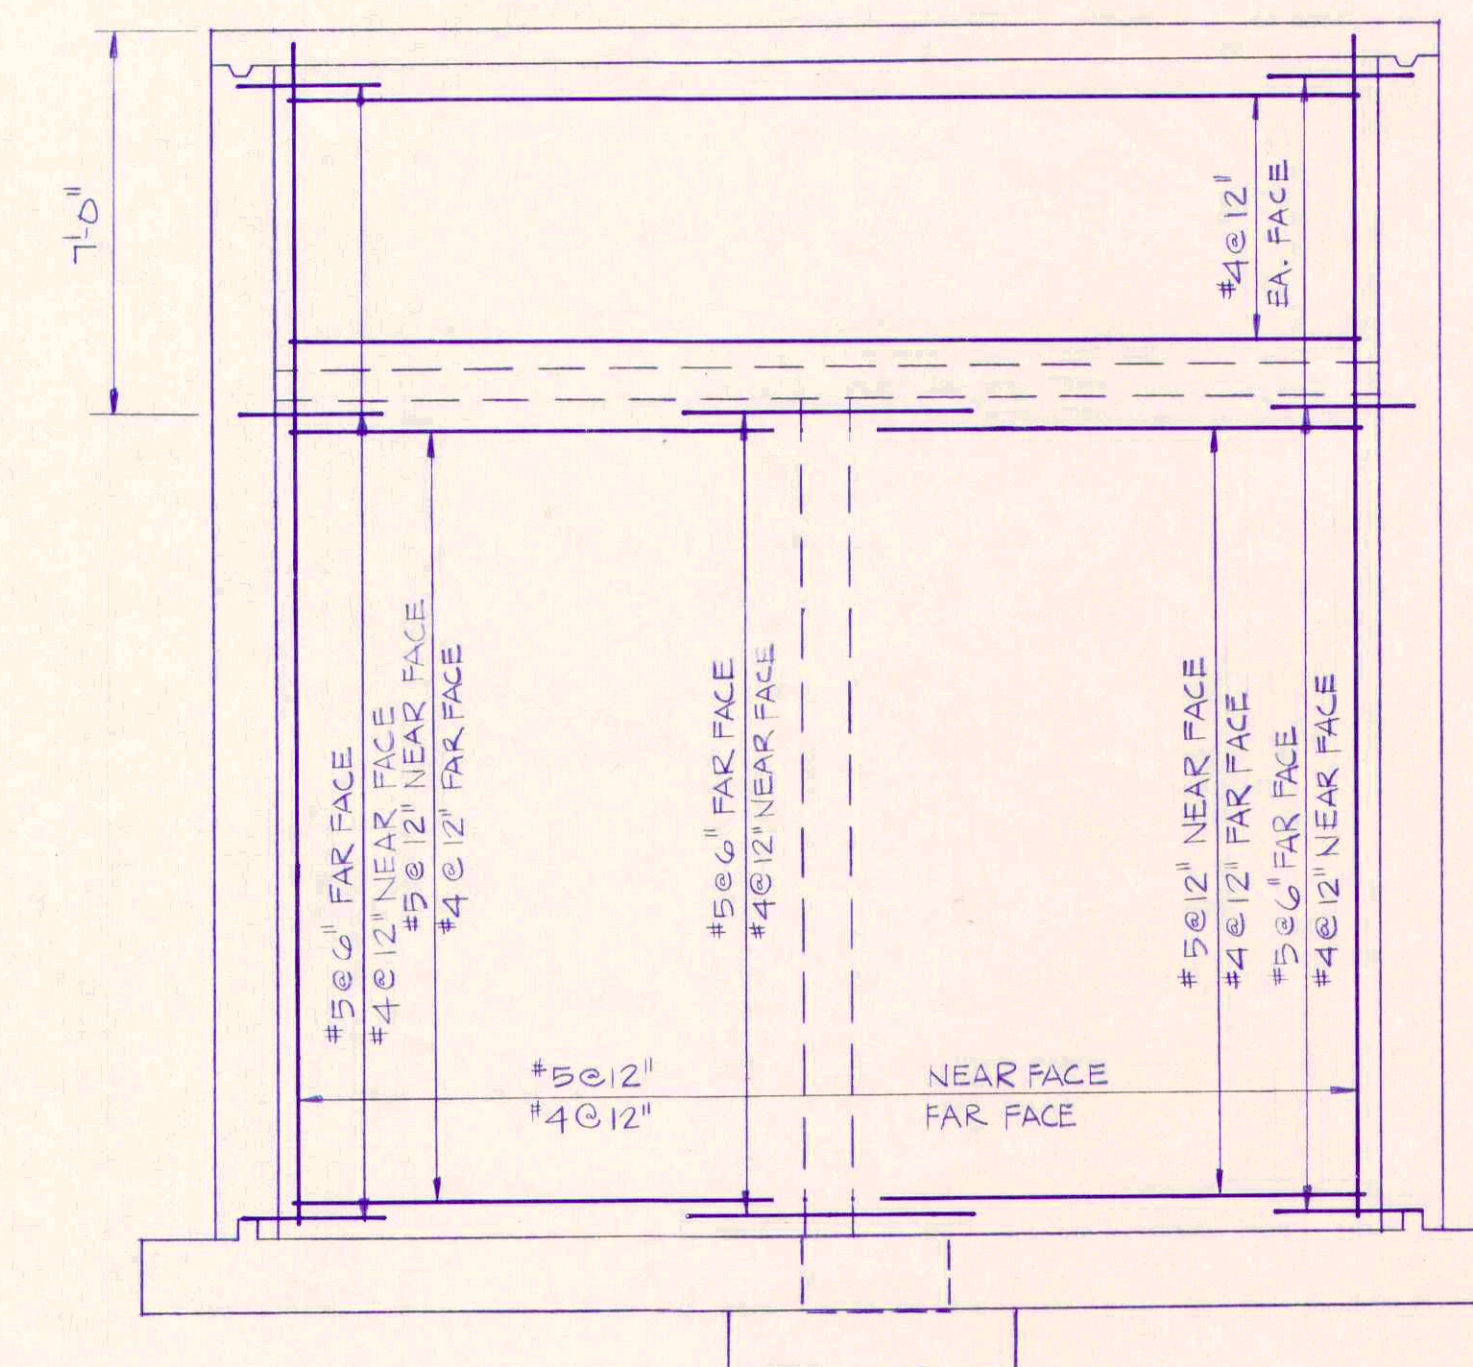

INTERIOR WALL, LOOKING EAST
SCALE 1/4" = 1'-0"

RECORD DRAWING

REFORMATORY LIFT STATION STRUCTURAL ELEVATIONS		
Scale: AS NOTED	FALL CREEK RWD.	Sheet
Drawn By: CULLY	BEAM, LONGEST & NEFF	73
Designed By: ZIV	Consulting Engineers	
Certified By: ER	8136 Castleton Road Indianapolis In. 46250	