




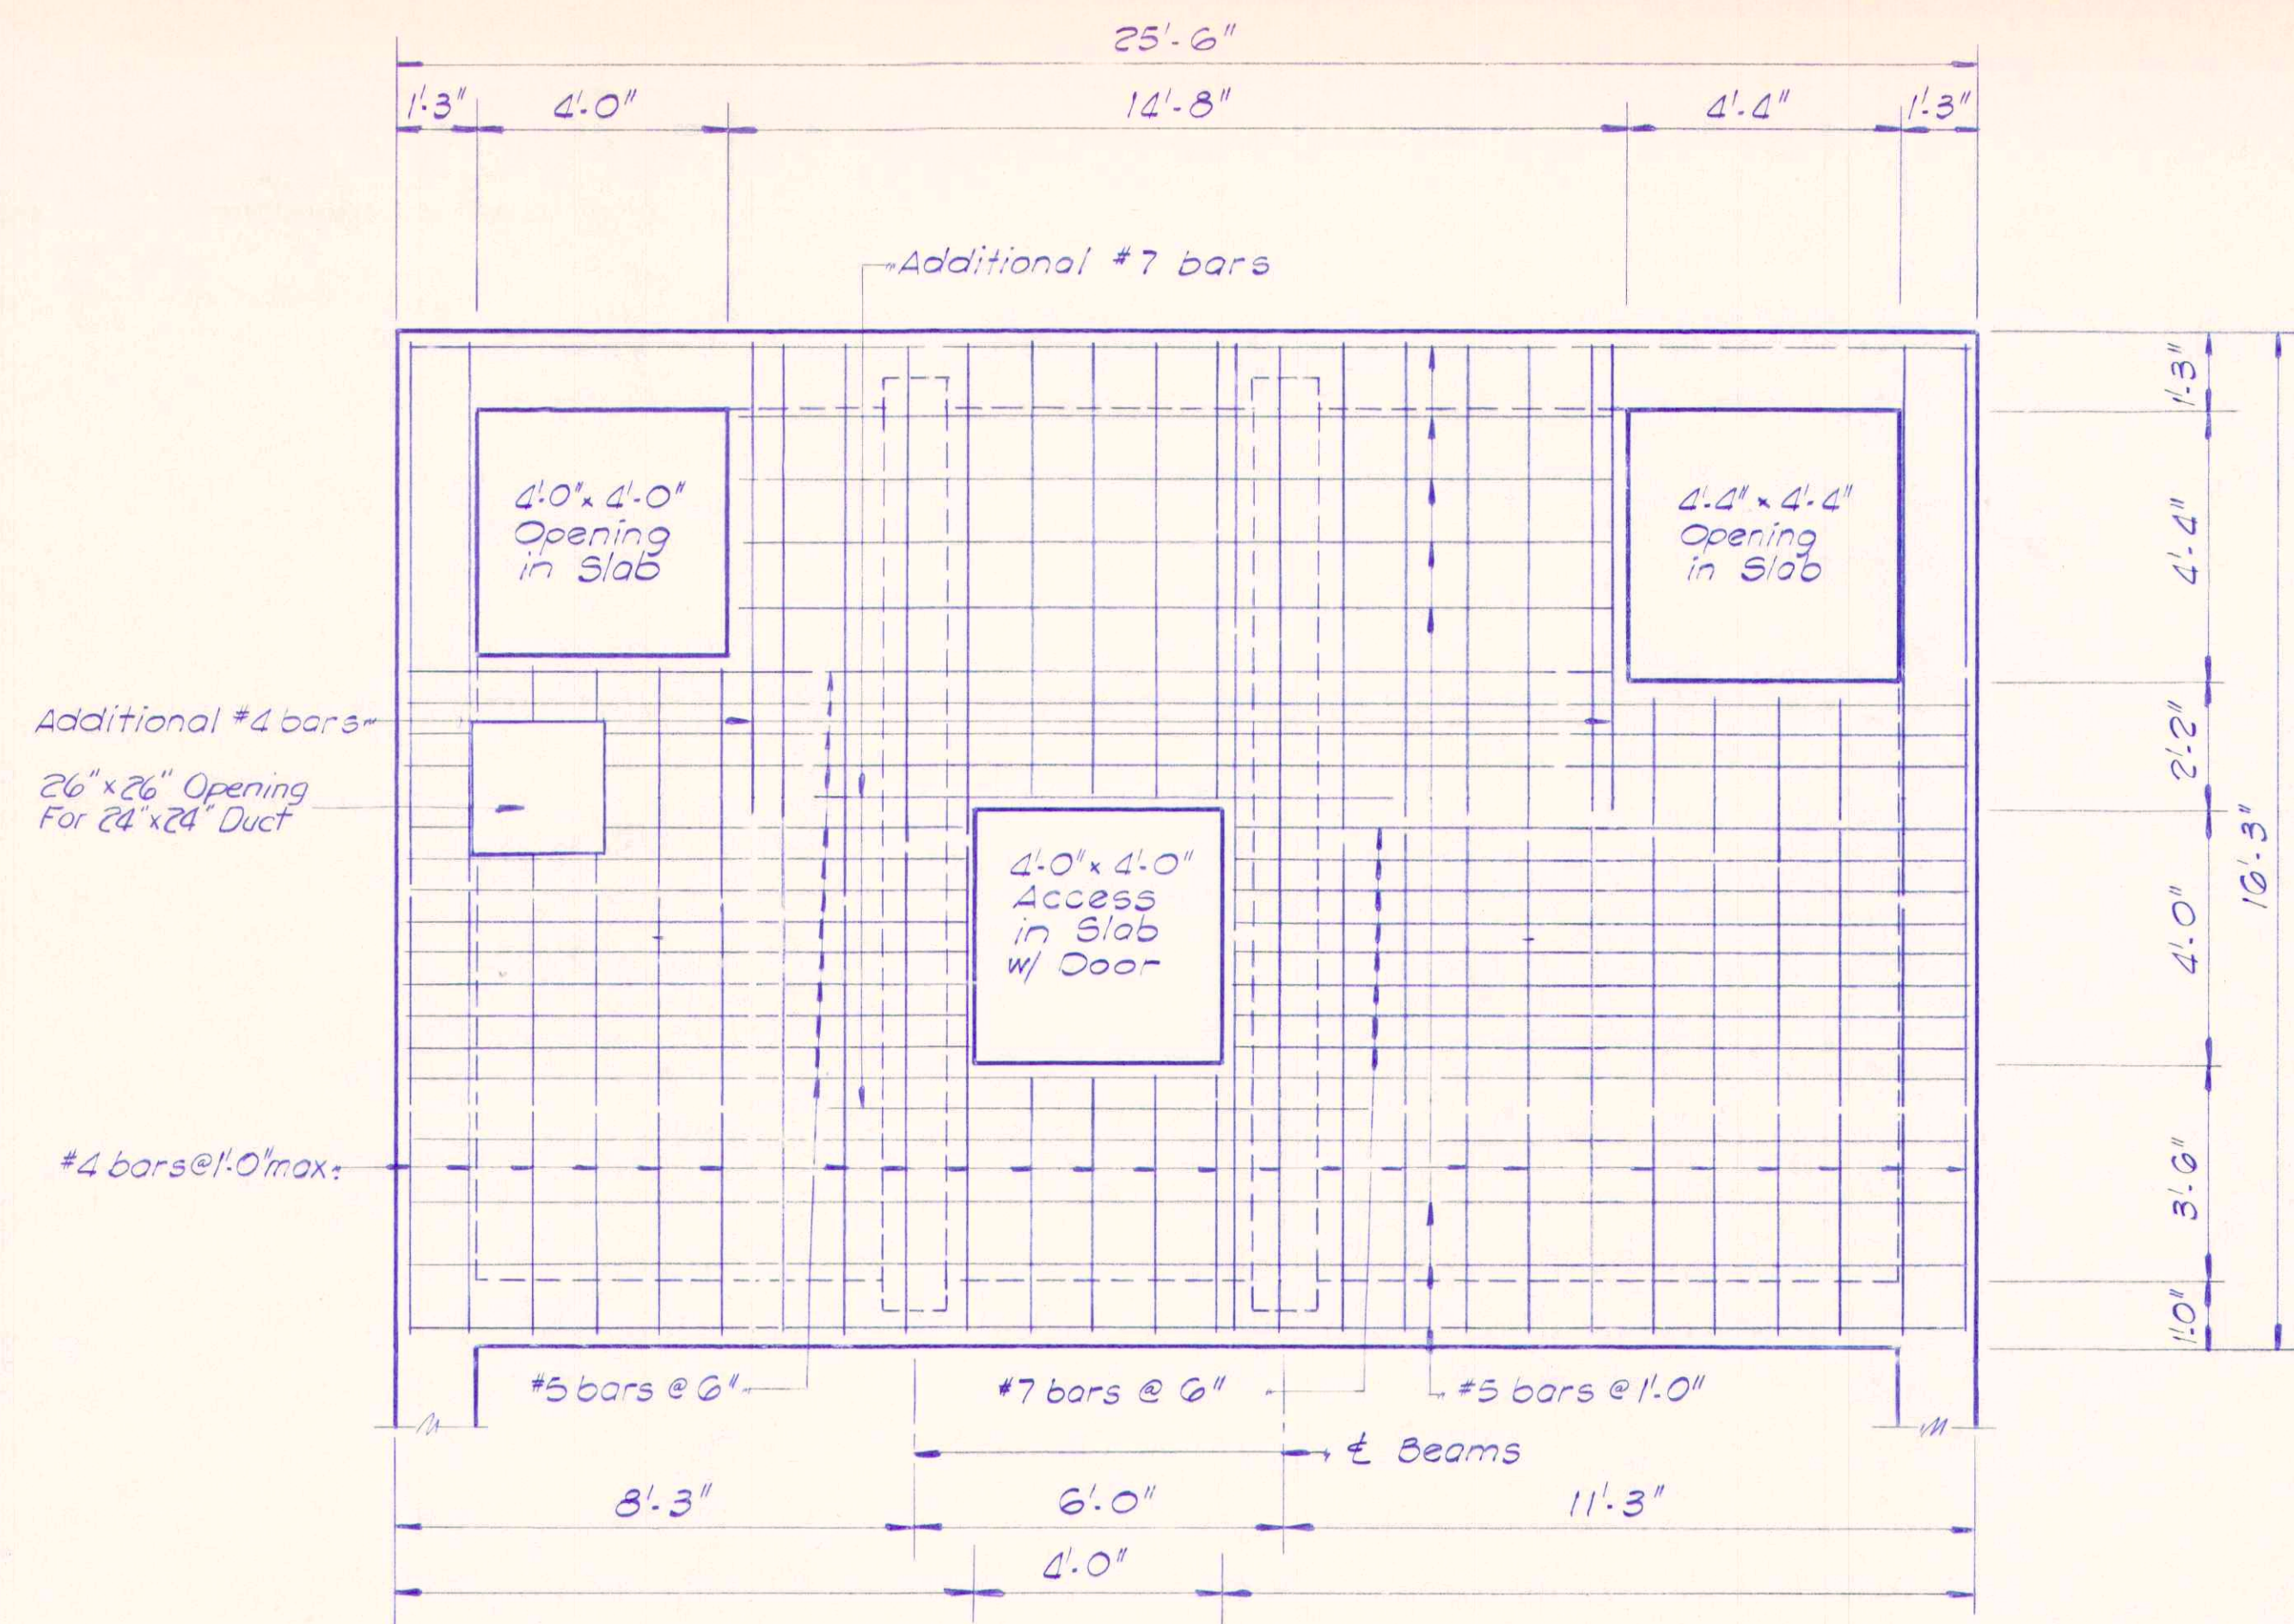


ENTRANCE LEVEL SLAB PLAN
SHOWING BOTTOM REINFORCING
Scale: $\frac{3}{8}" = 1'-0"$

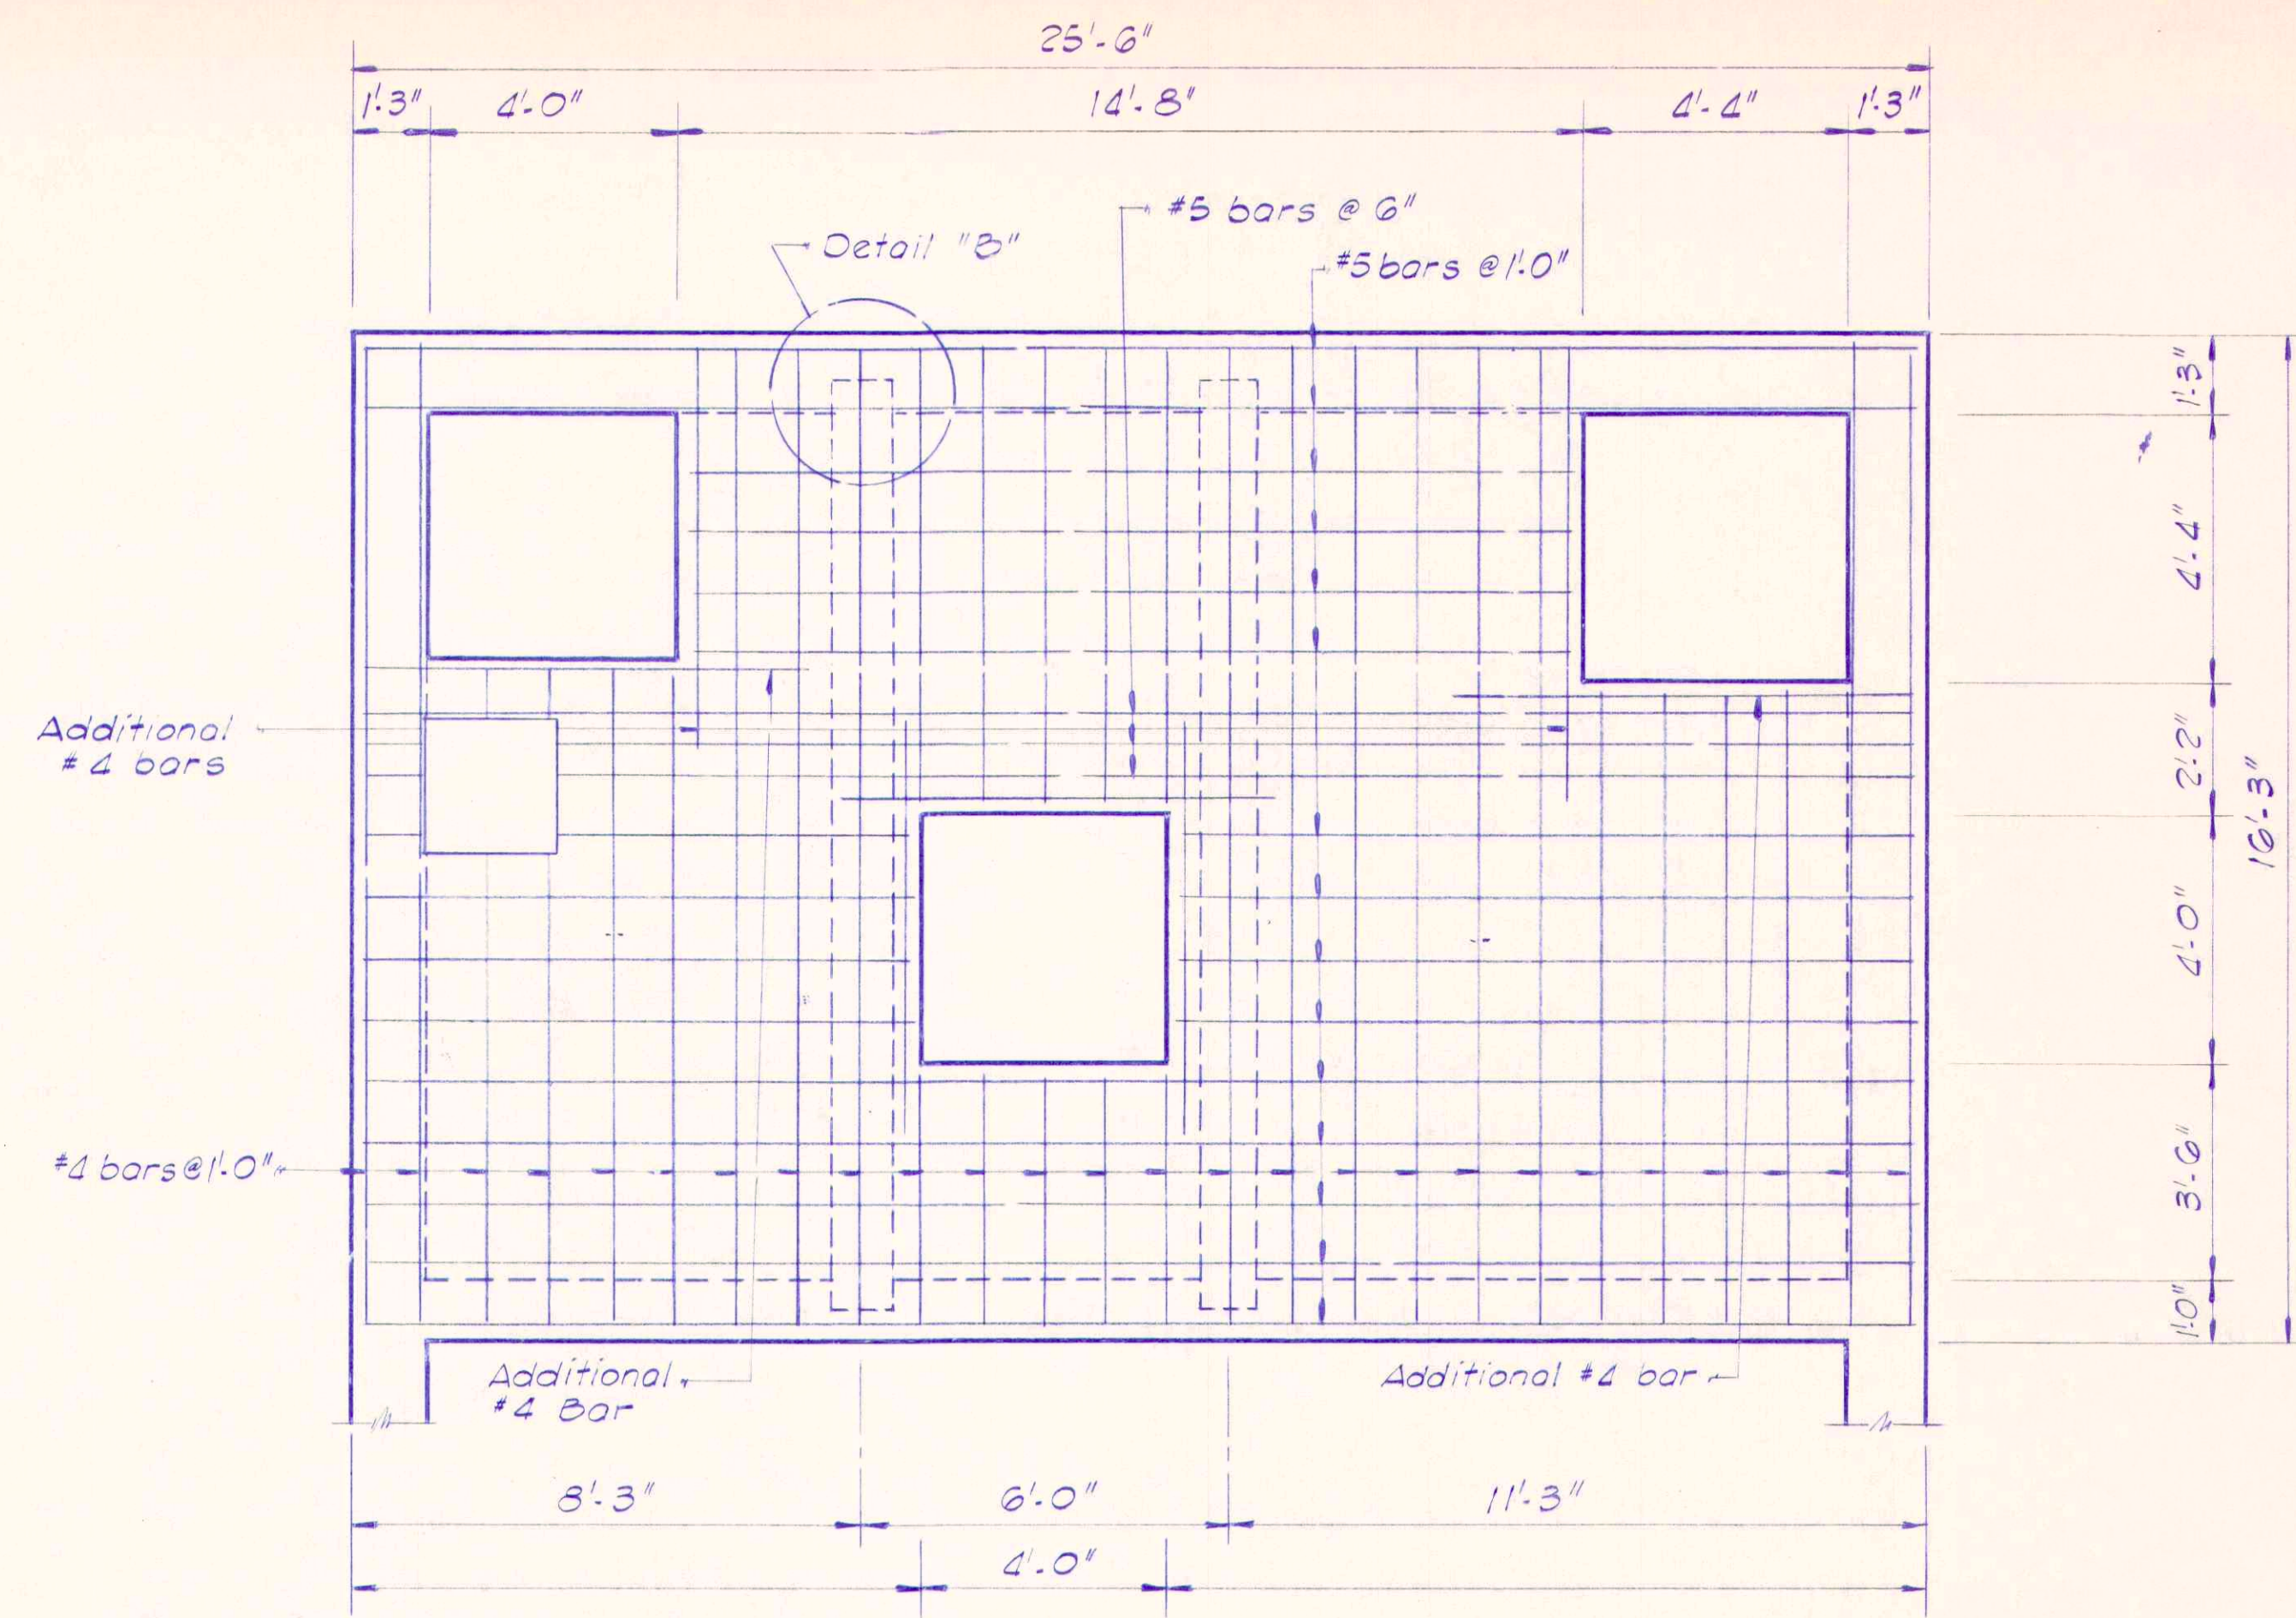


ENTRANCE LEVEL SLAB PLAN
SHOWING TOP REINFORCING
Scale: $\frac{3}{8}" = 1'-0"$

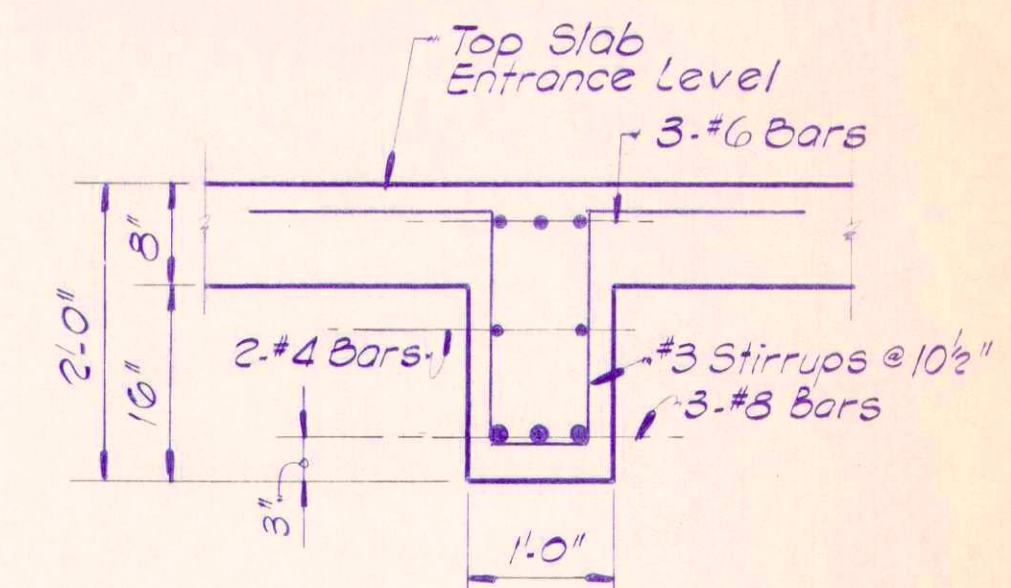


TYPICAL BEAM SECTION
Scale: $\frac{3}{4}" = 1'-0"$

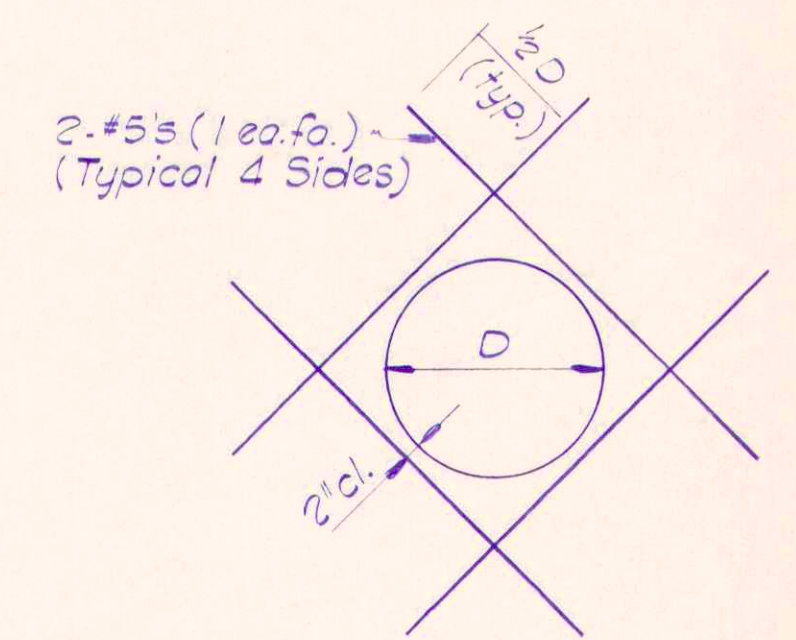


TYPICAL WALL OPENING
REINFORCING DETAIL
No Scale

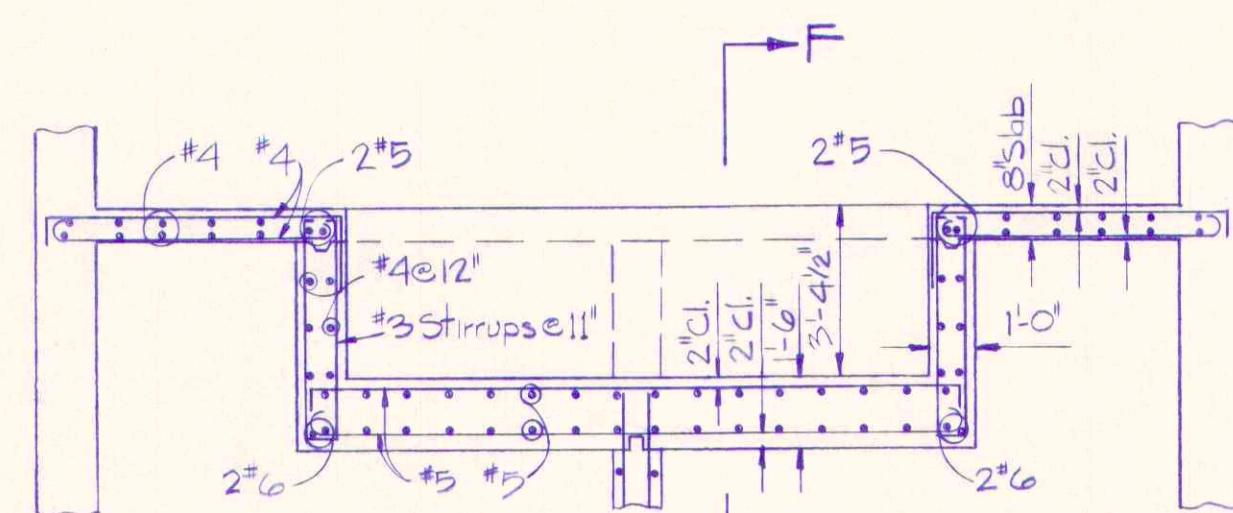


SECTION E-E
Scale: $\frac{1}{4}" = 1'-0"$

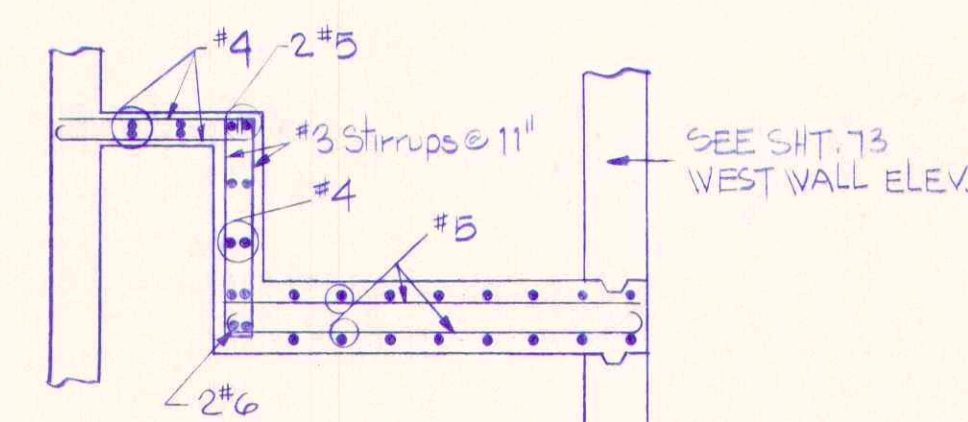


SECTION F-F
Scale: $\frac{1}{4}" = 1'-0"$

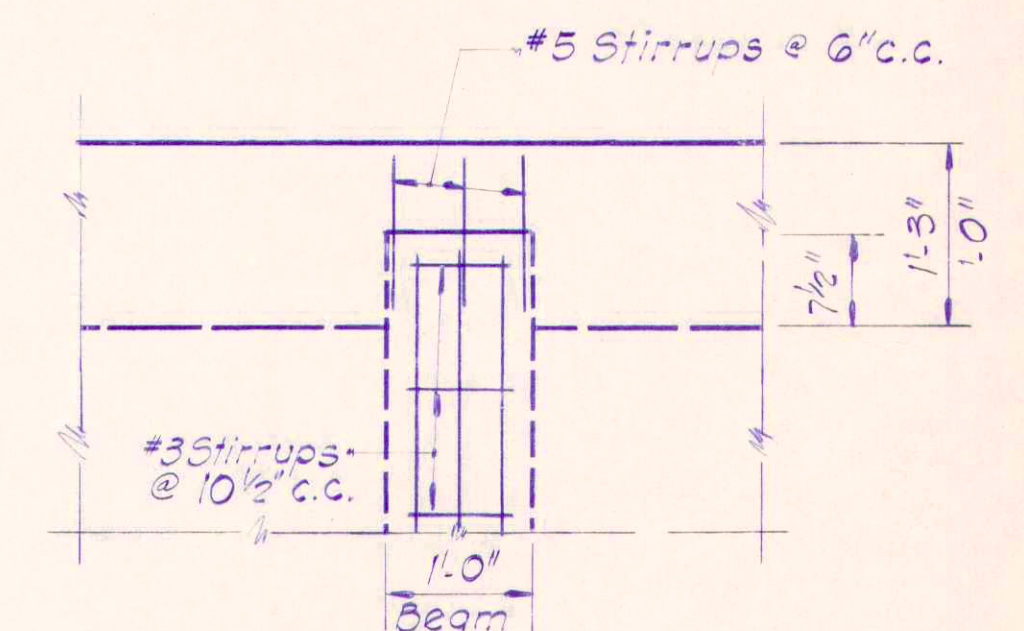


DETAIL "B"
Scale: $\frac{3}{4}" = 1'-0"$

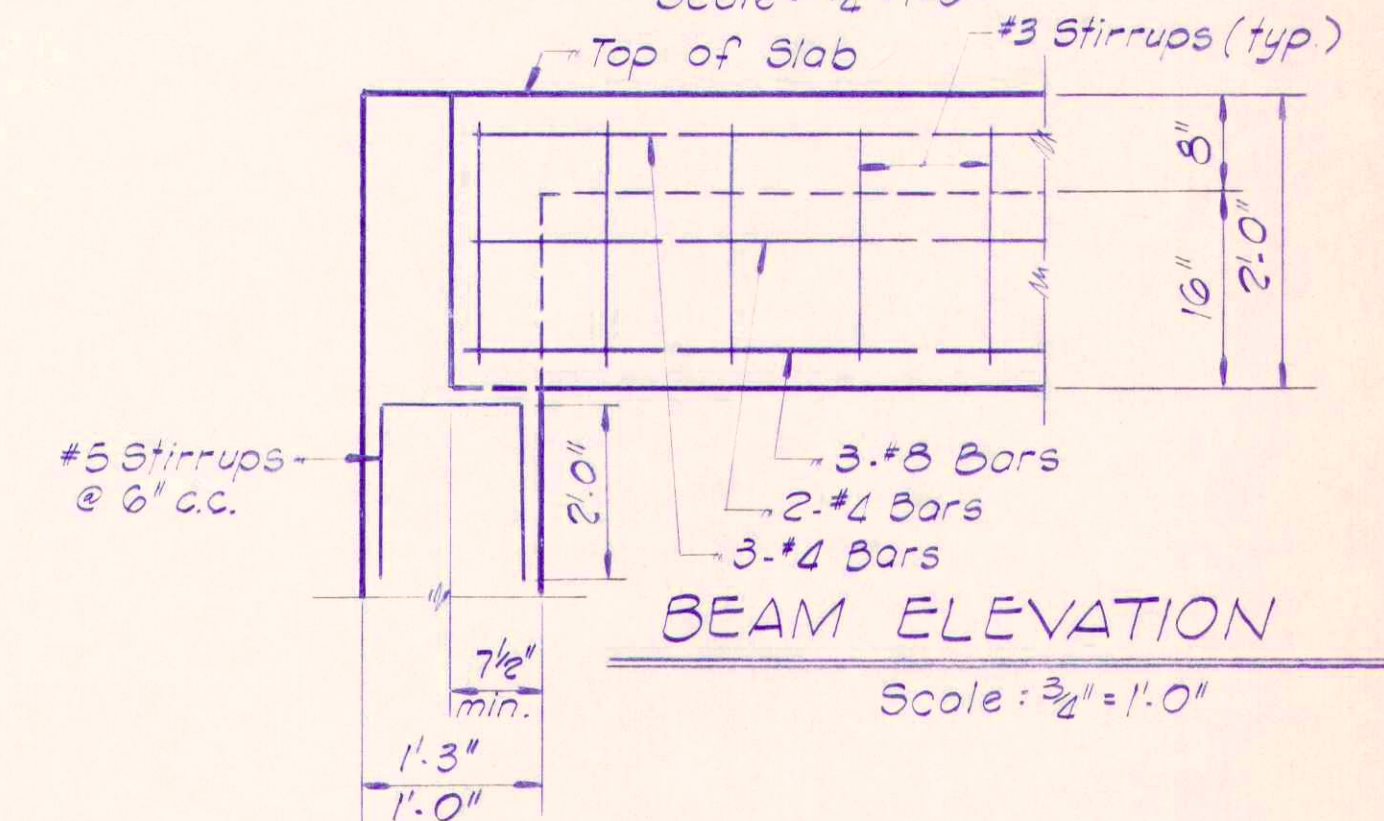

BEAM ELEVATION
Scale: $\frac{3}{4}" = 1'-0"$

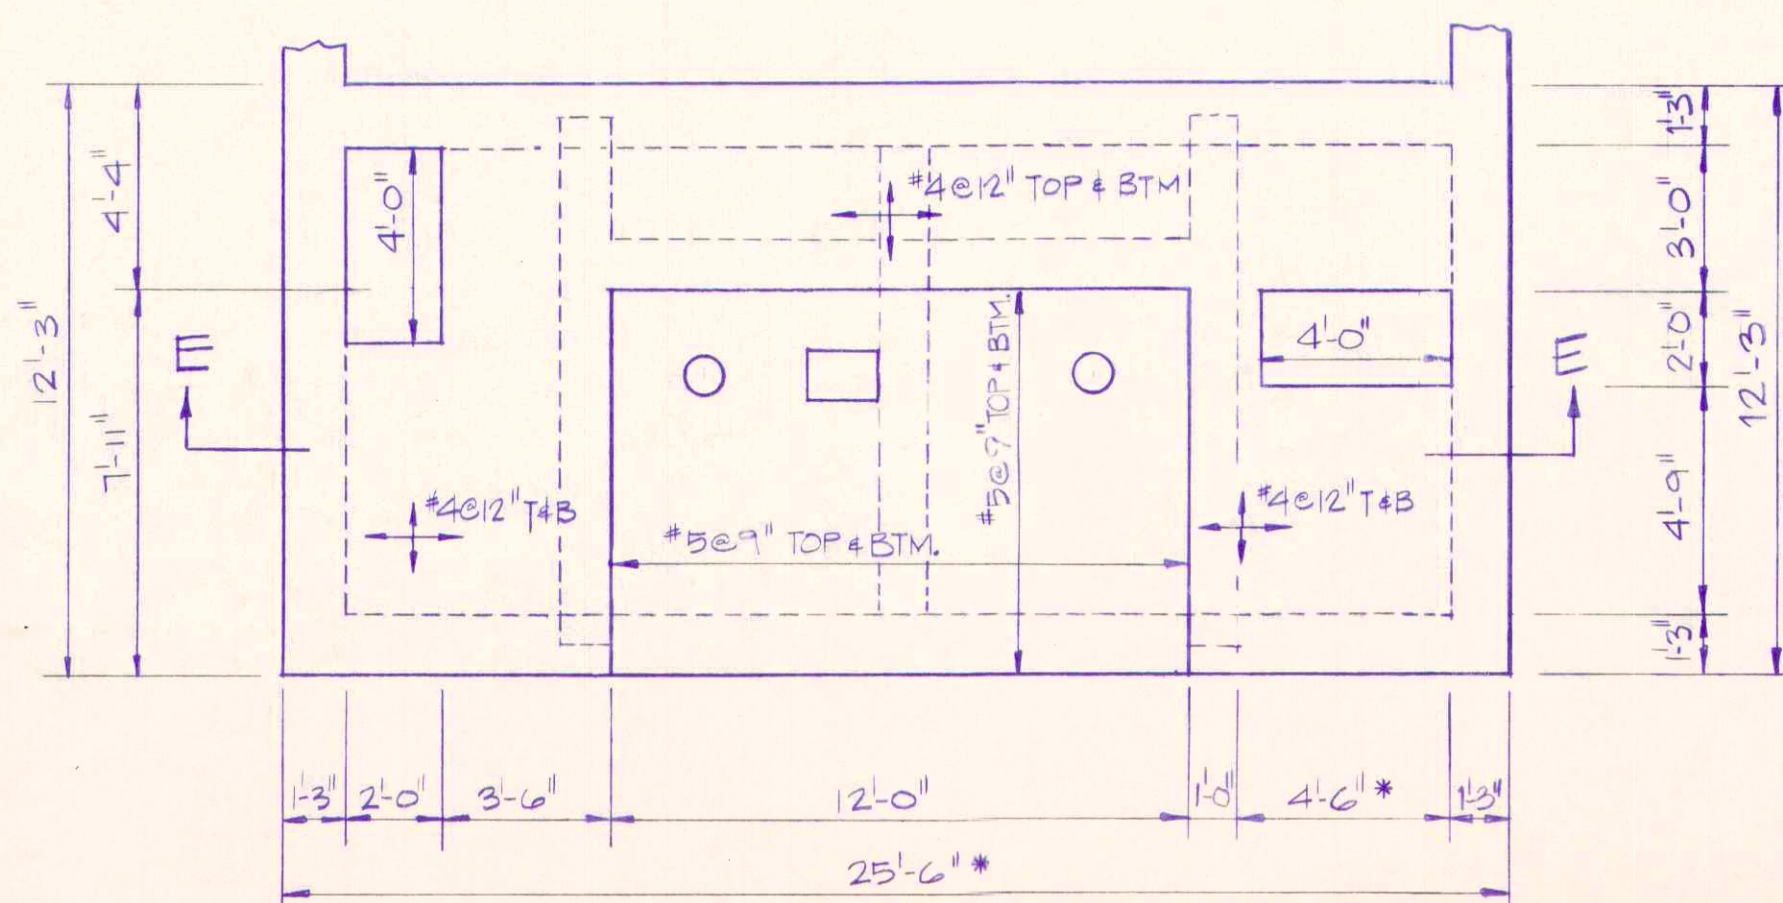

COMMINUTOR SLAB PLAN
Scale: $\frac{1}{4}" = 1'-0"$

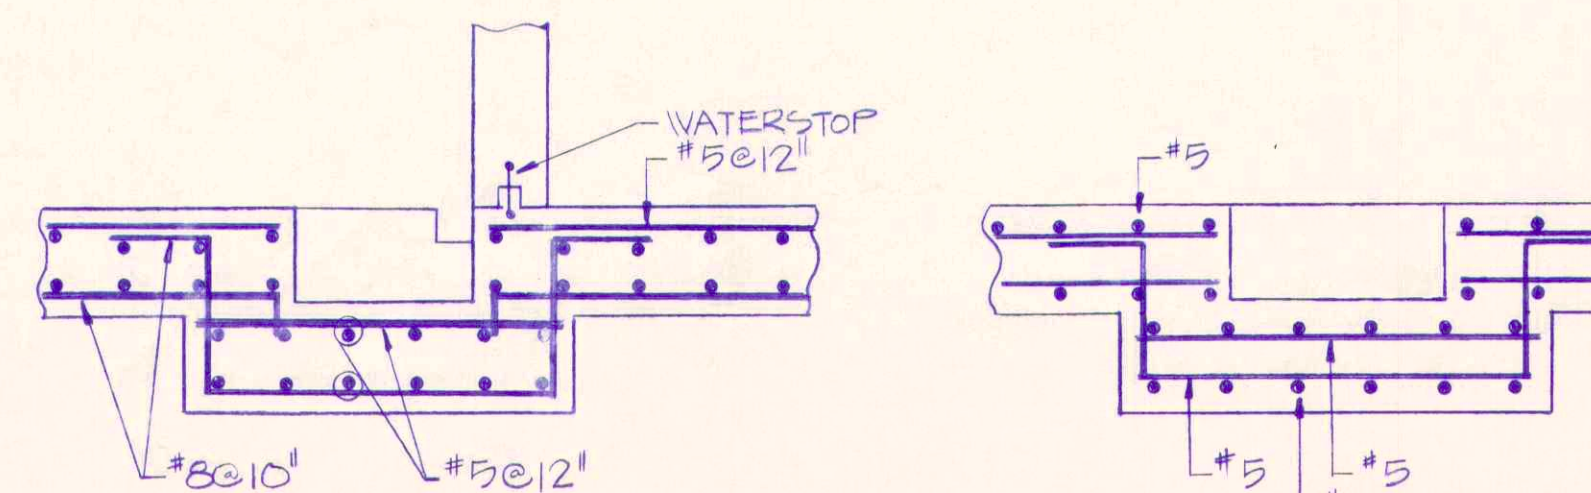

SUMP PIT SECTIONS
Scale: $\frac{3}{8}" = 1'-0"$

RECORD DRAWING

REV. 3-2-84 * DENOTES DIMENSIONS INCREASED BY 6" RLS
REV. 11-4-83 DUCT OPENINGS, RE-BAR

REFORMATORY LIFT STATION STRUCTURAL AND DETAILS		
Scale: As Noted	FALL CREEK R.W.D.	Sheet
Drawn By: D.G.	BEAM, LONGEST & NEFF	74
Designed By: RFS	Consulting Engineers	
Certified By: E.R.	8136 Castleton Road Indianapolis, IN 46250	