
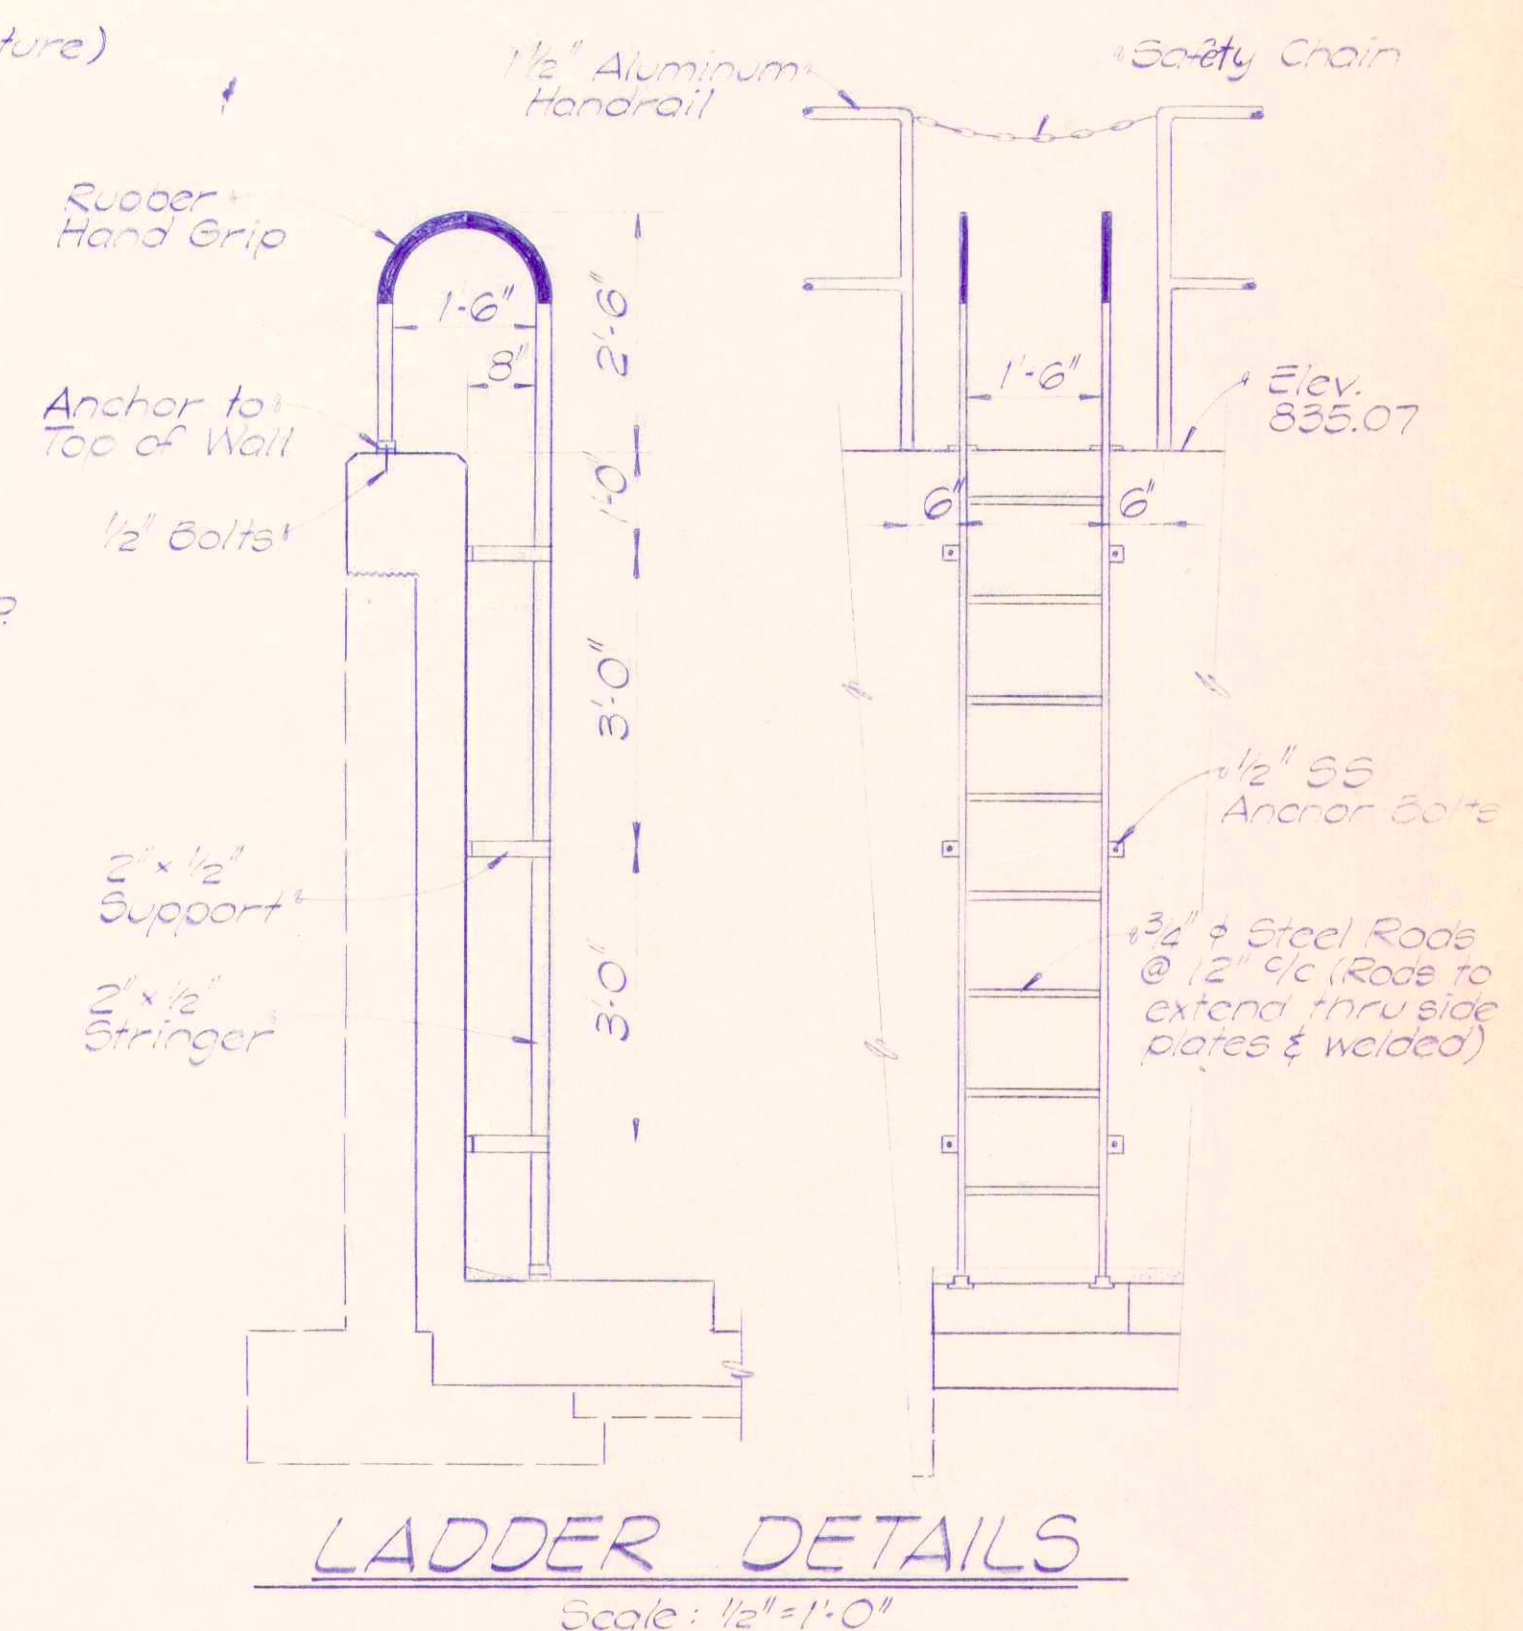
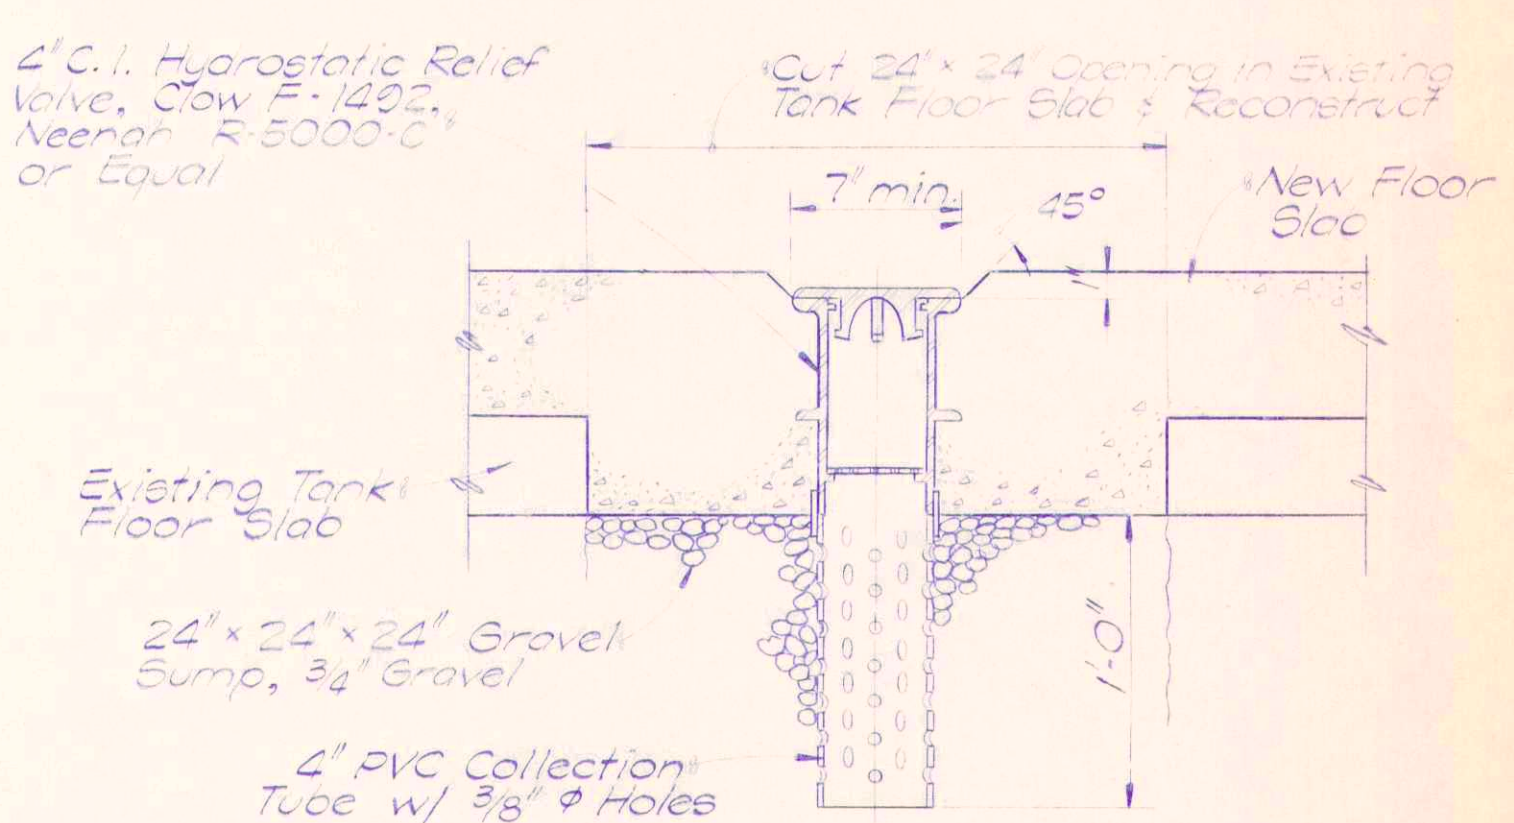
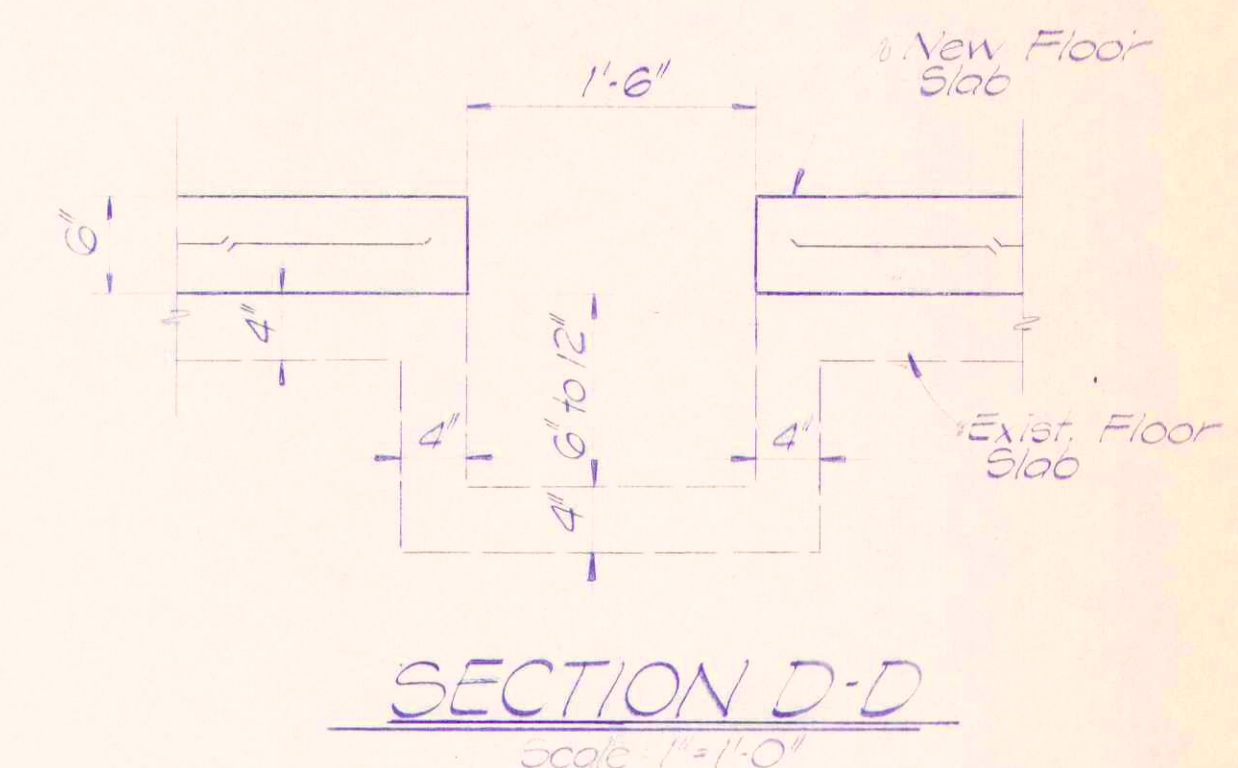
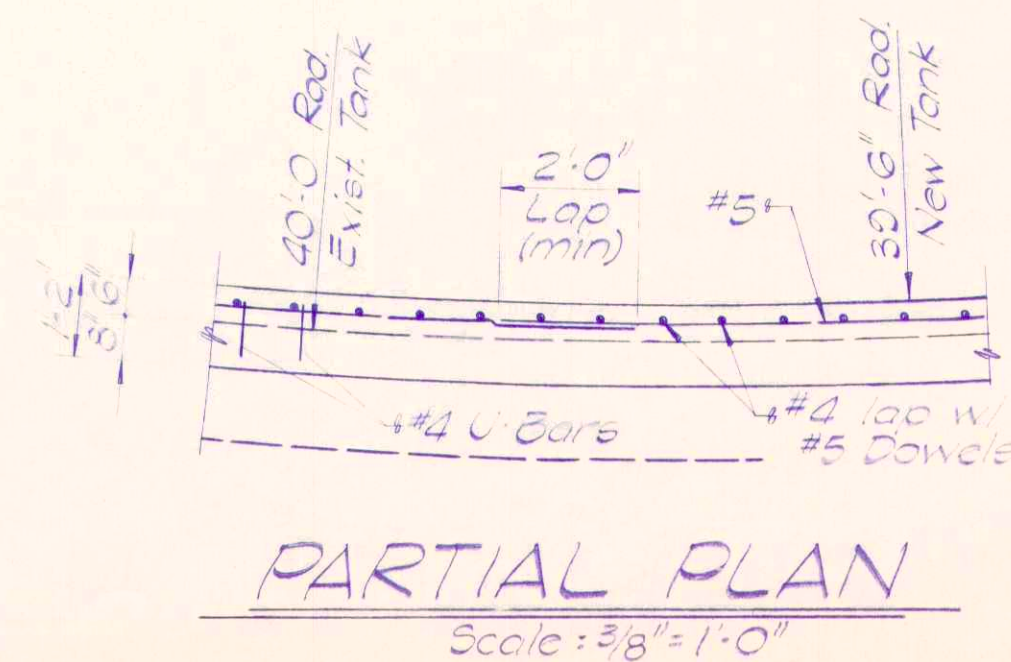
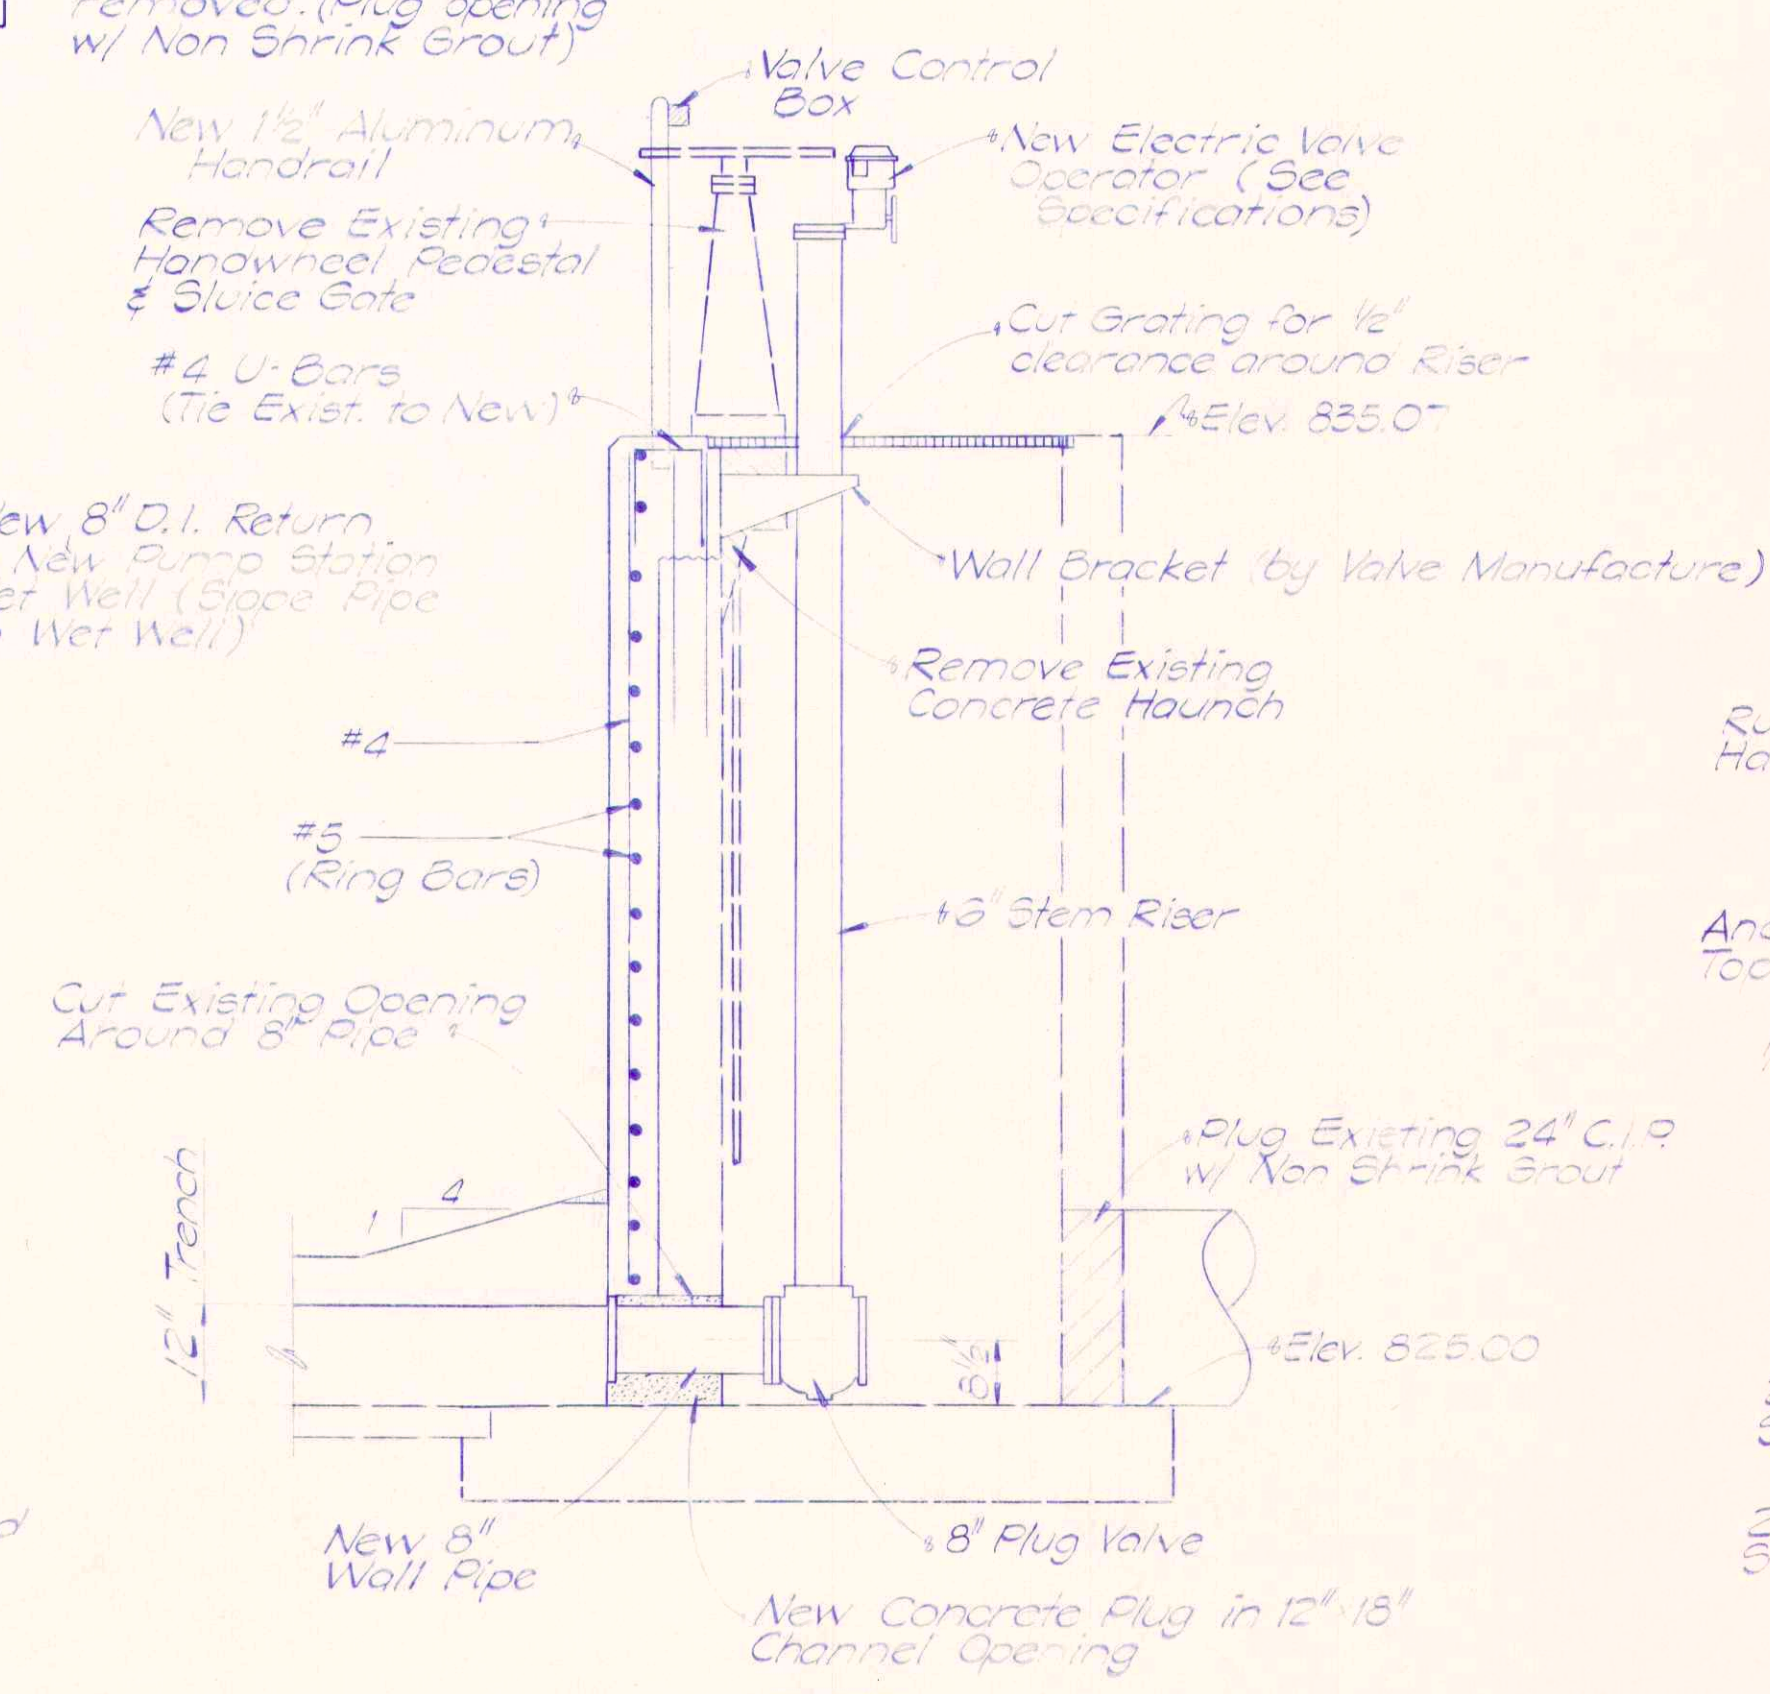
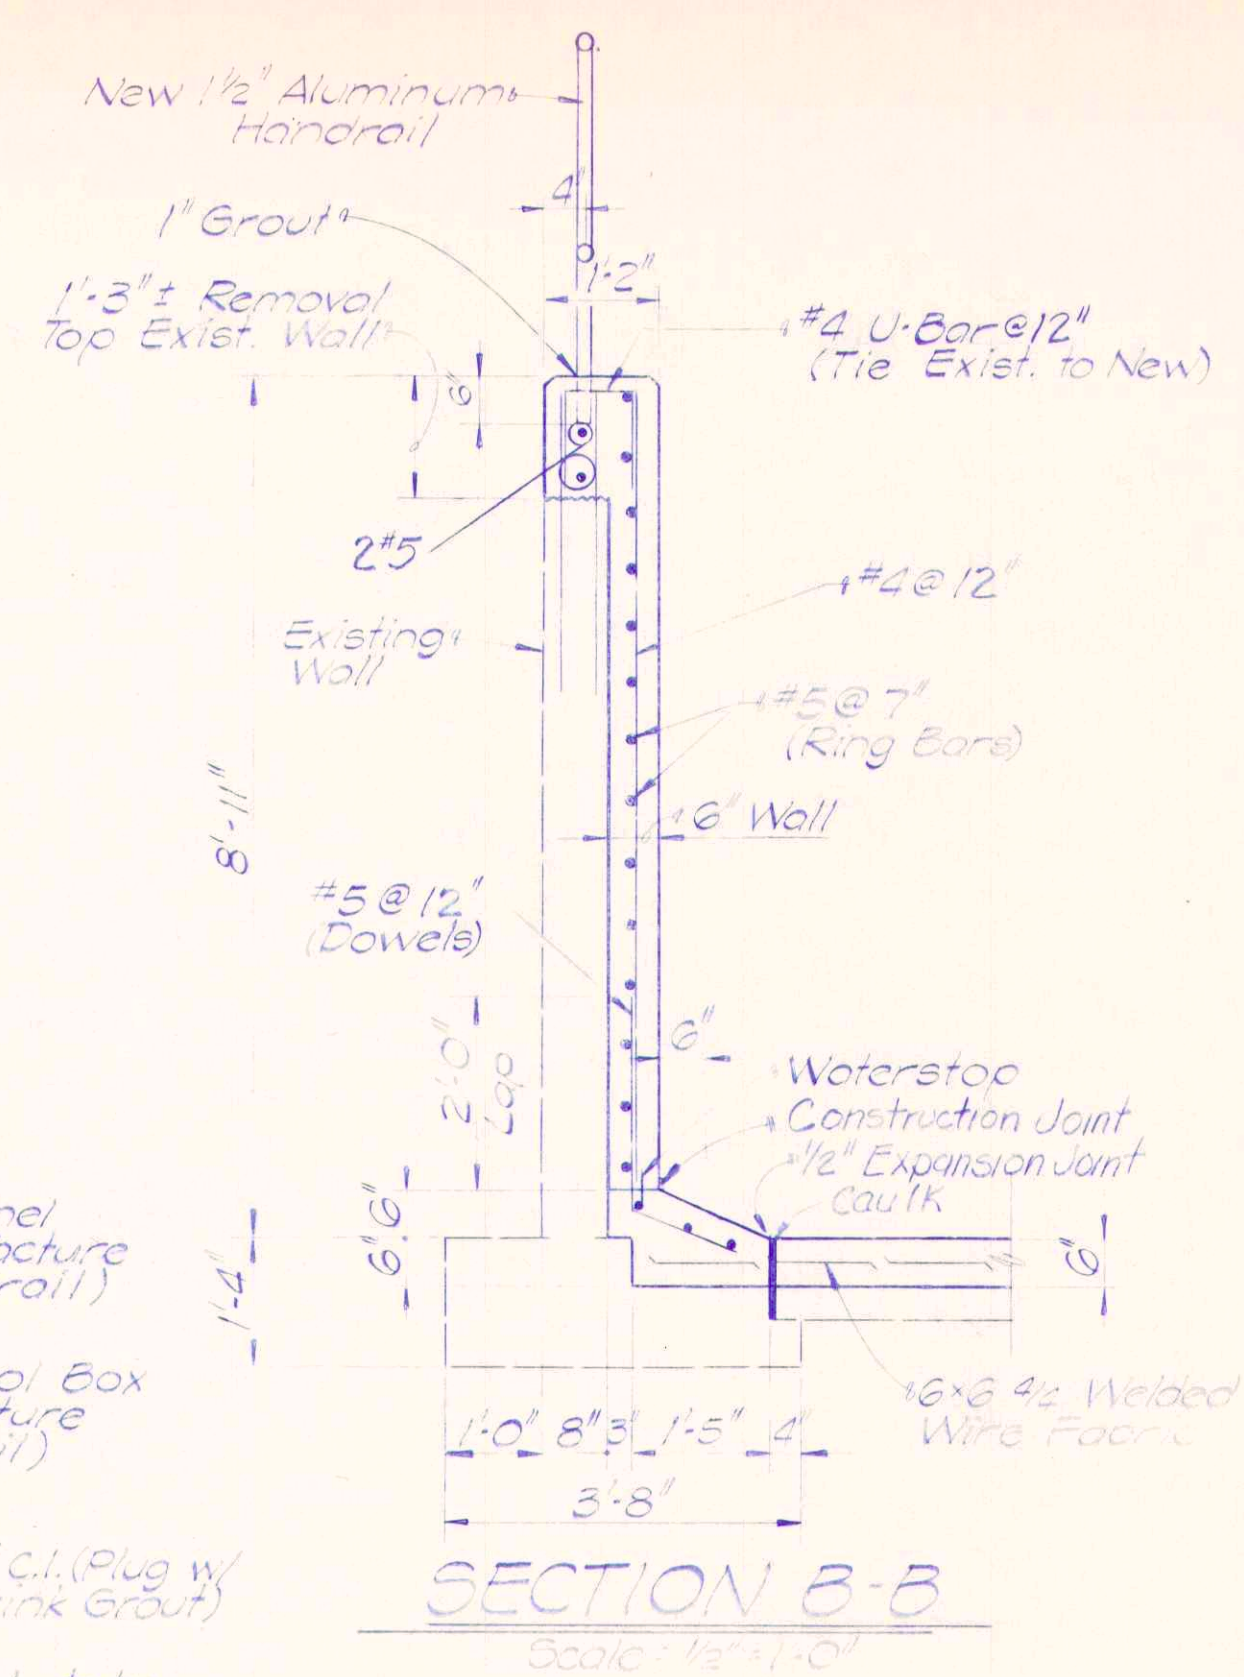
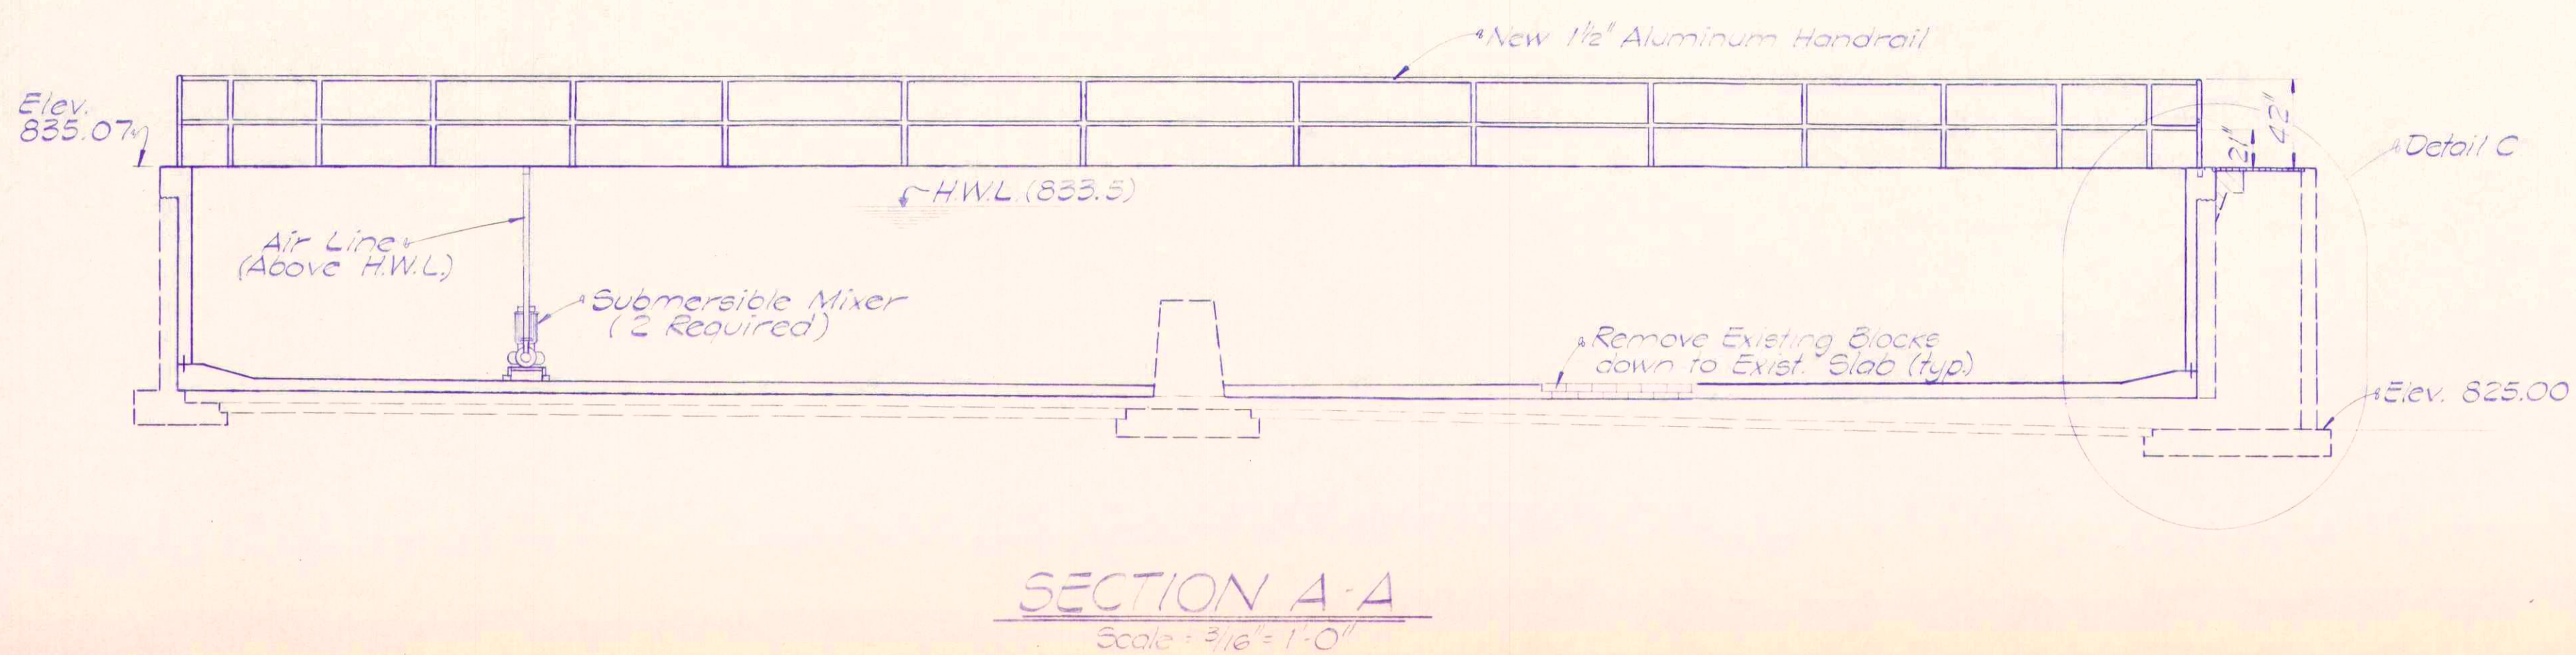


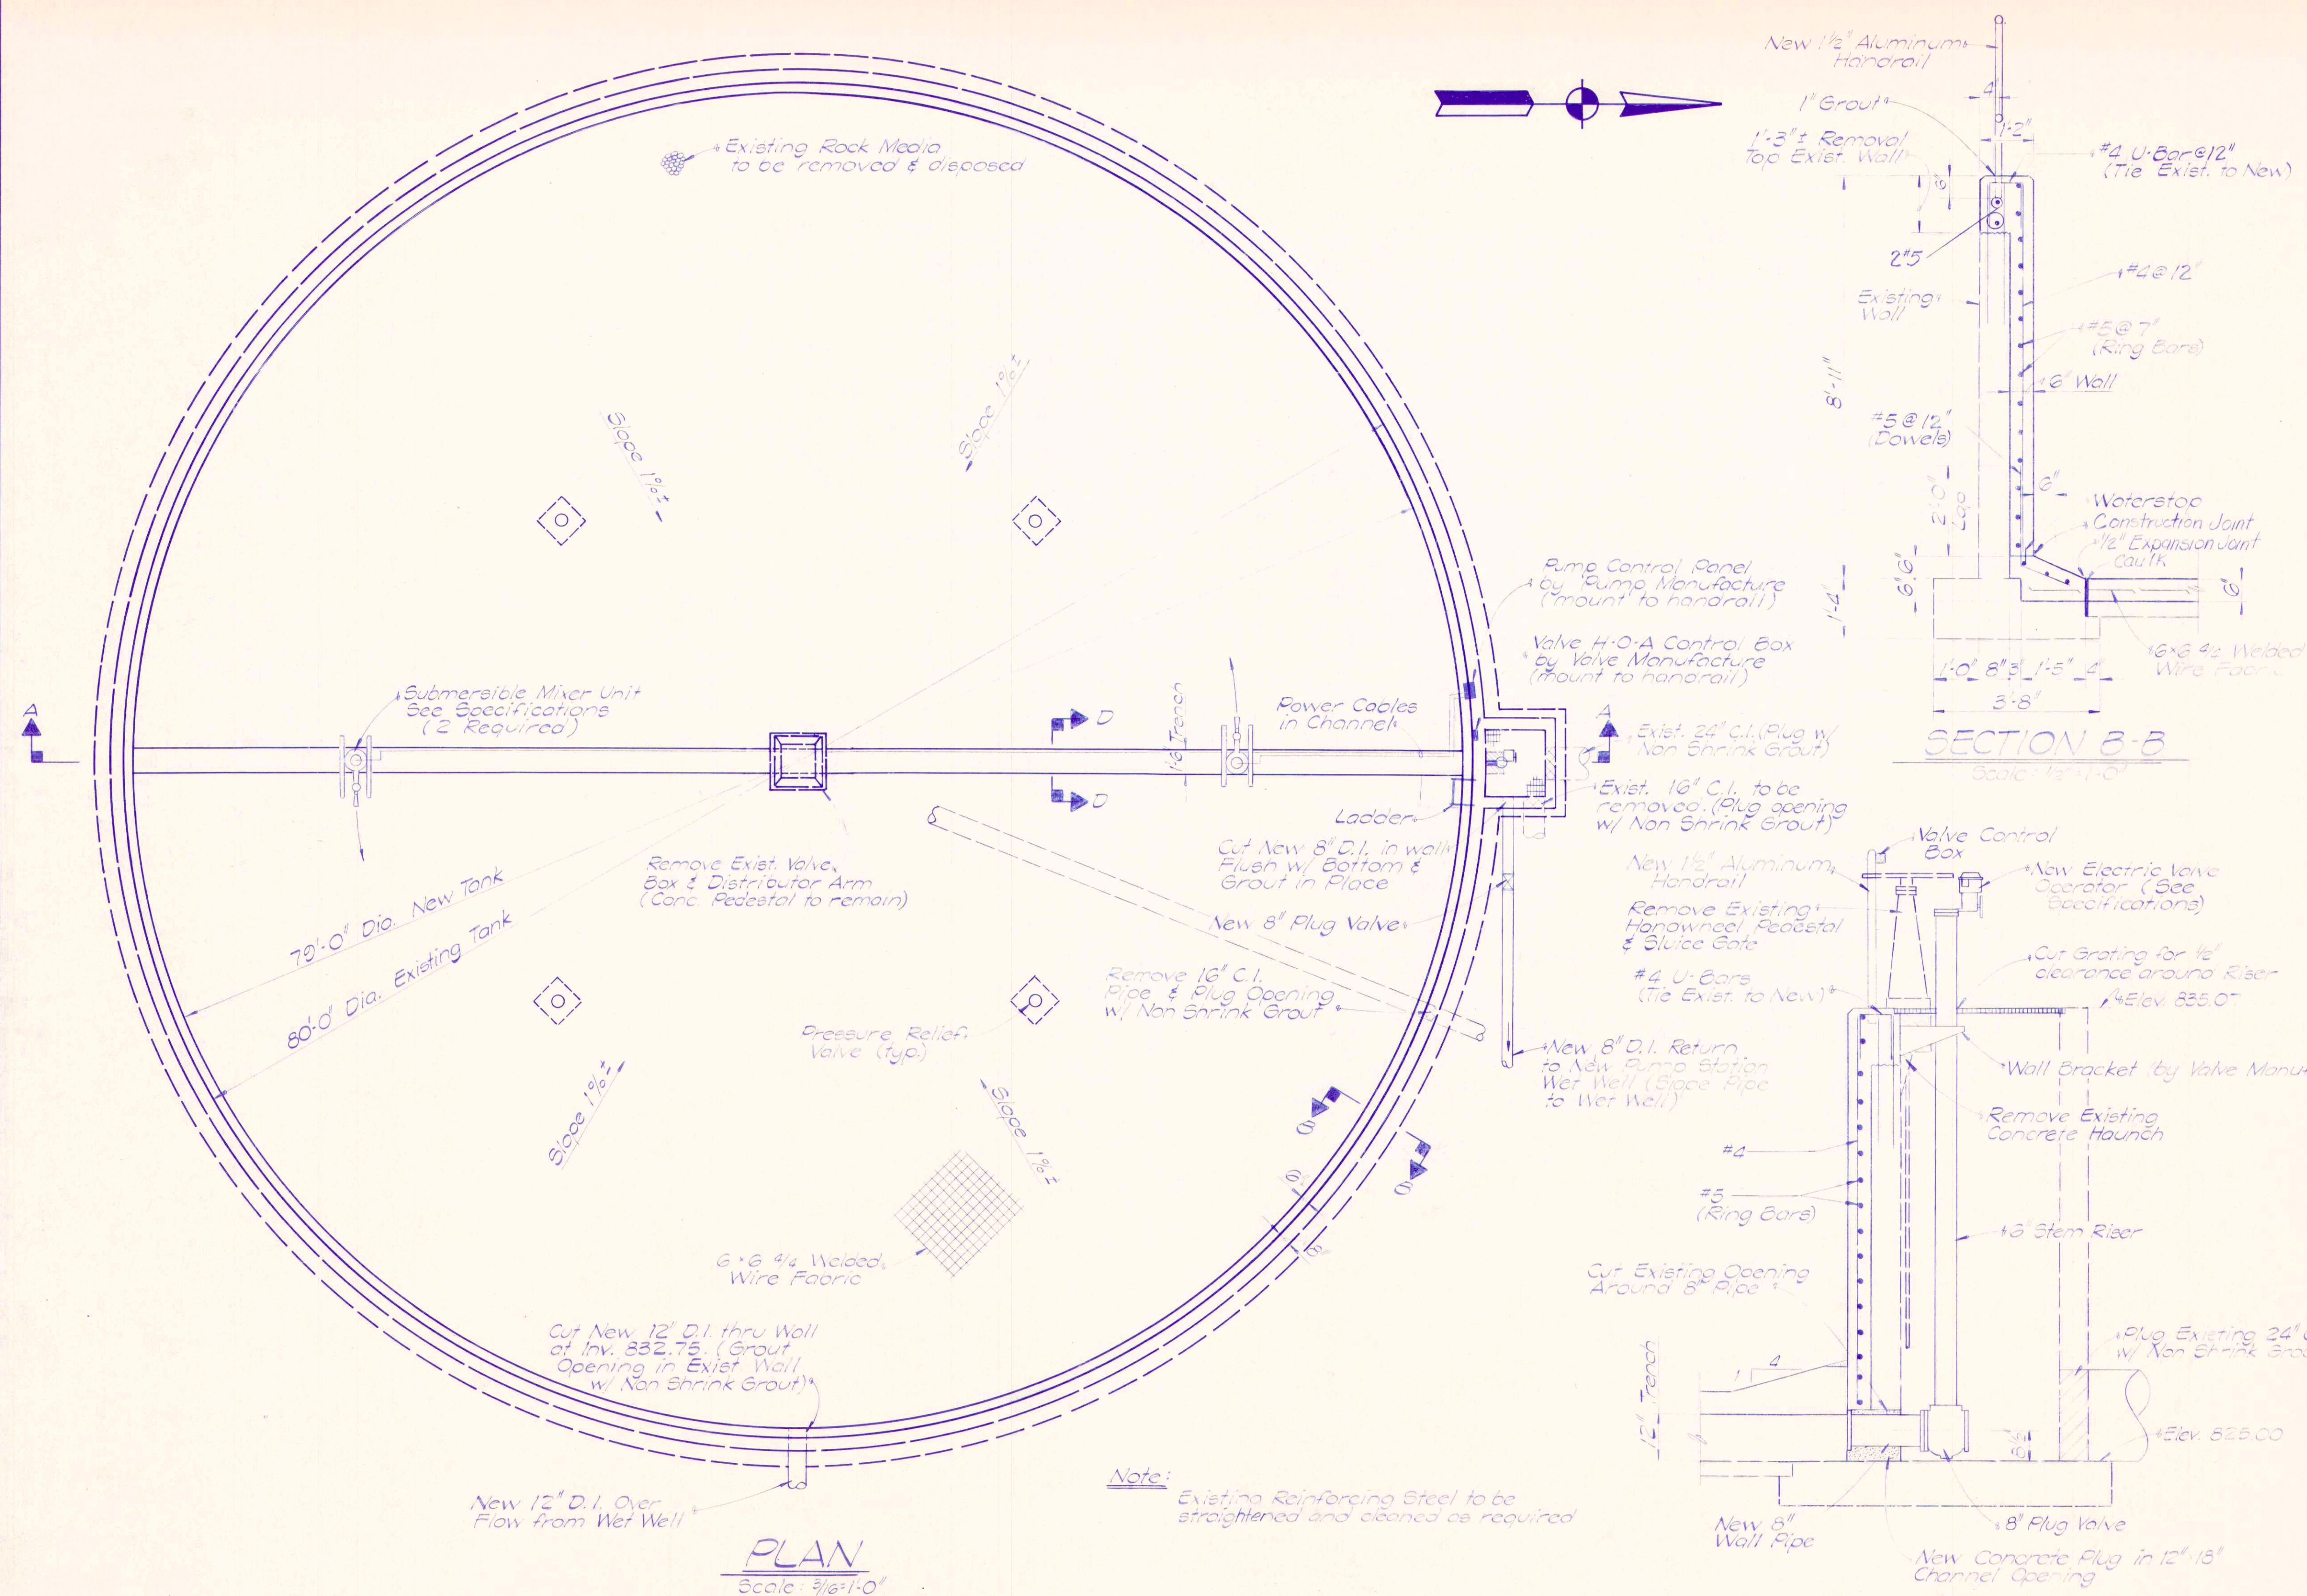

RECORD DRAWING

SURGE HOLDING TANK
(EXIST. REFORMATORY TRICKLE FILTER)

Scale: <i>As Noted</i>	FALL CREEK R.W.D.	Sheet
Drawn By: <i>DG</i>	BEAM, LONGEST & NEFF Consulting Engineers 8136 Castleton Road Indianapolis In. 46250	75
Designed By: <i>RFS</i> <i>J.P.</i>		
Certified By: <i>E.R.</i>		