
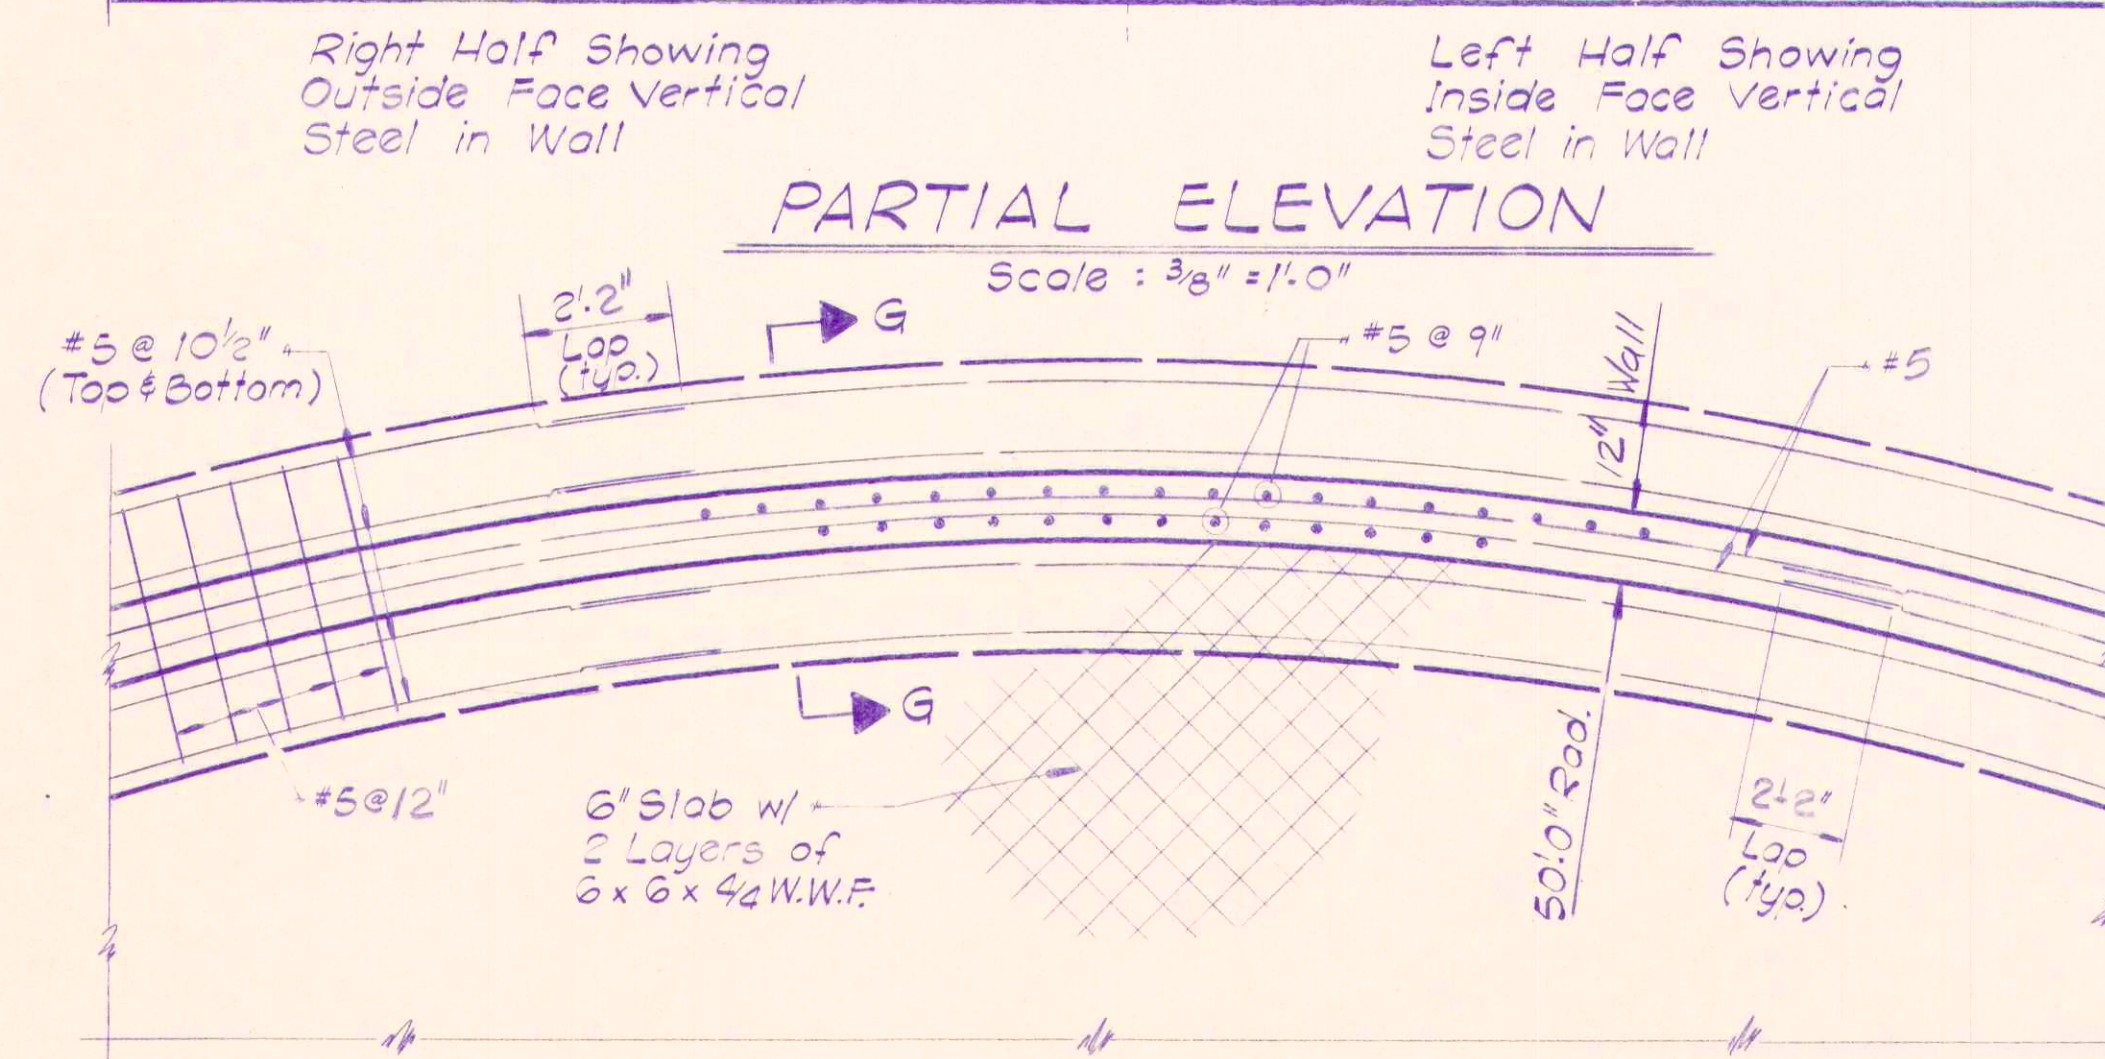
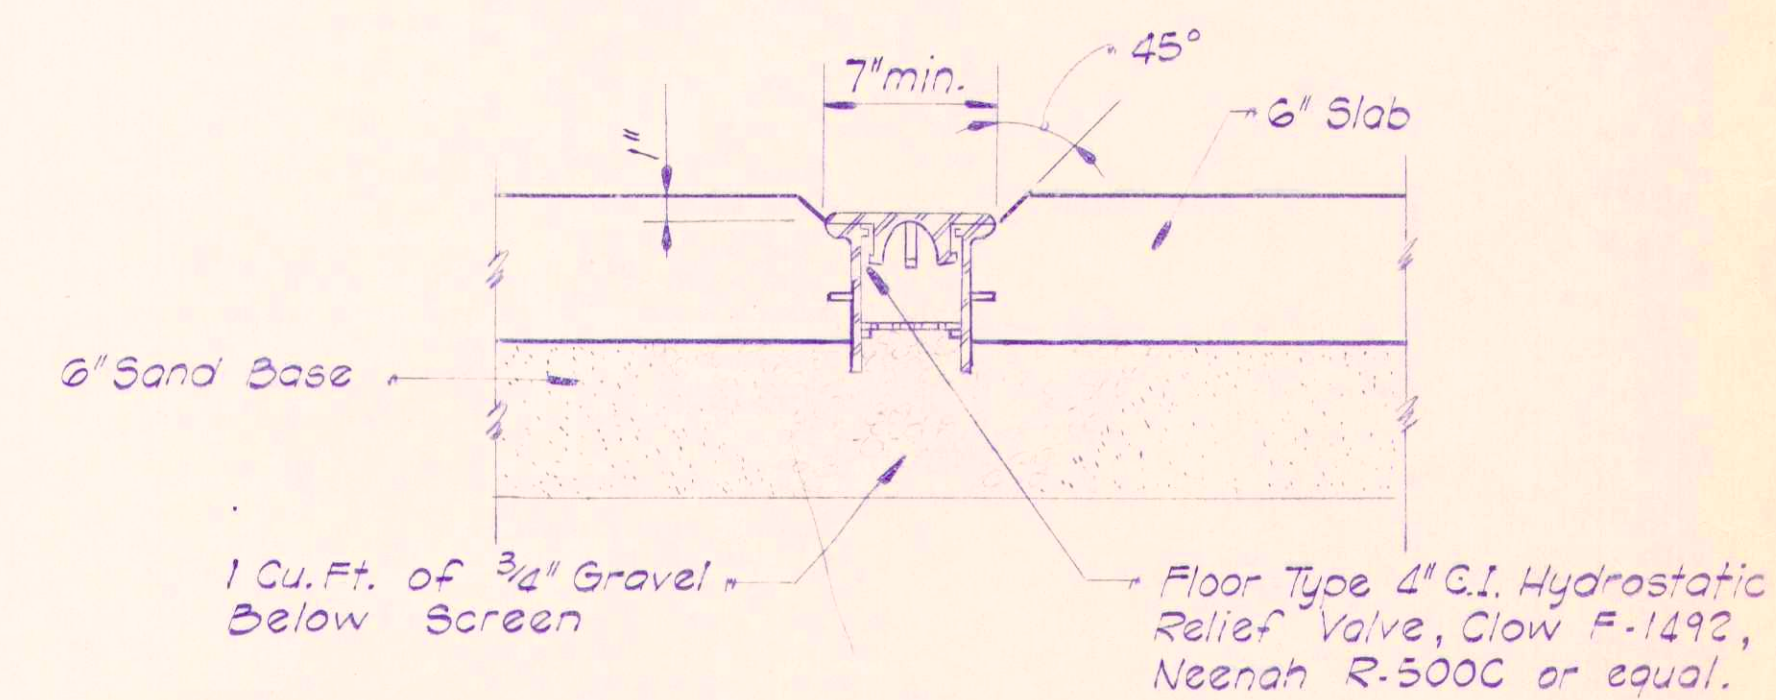
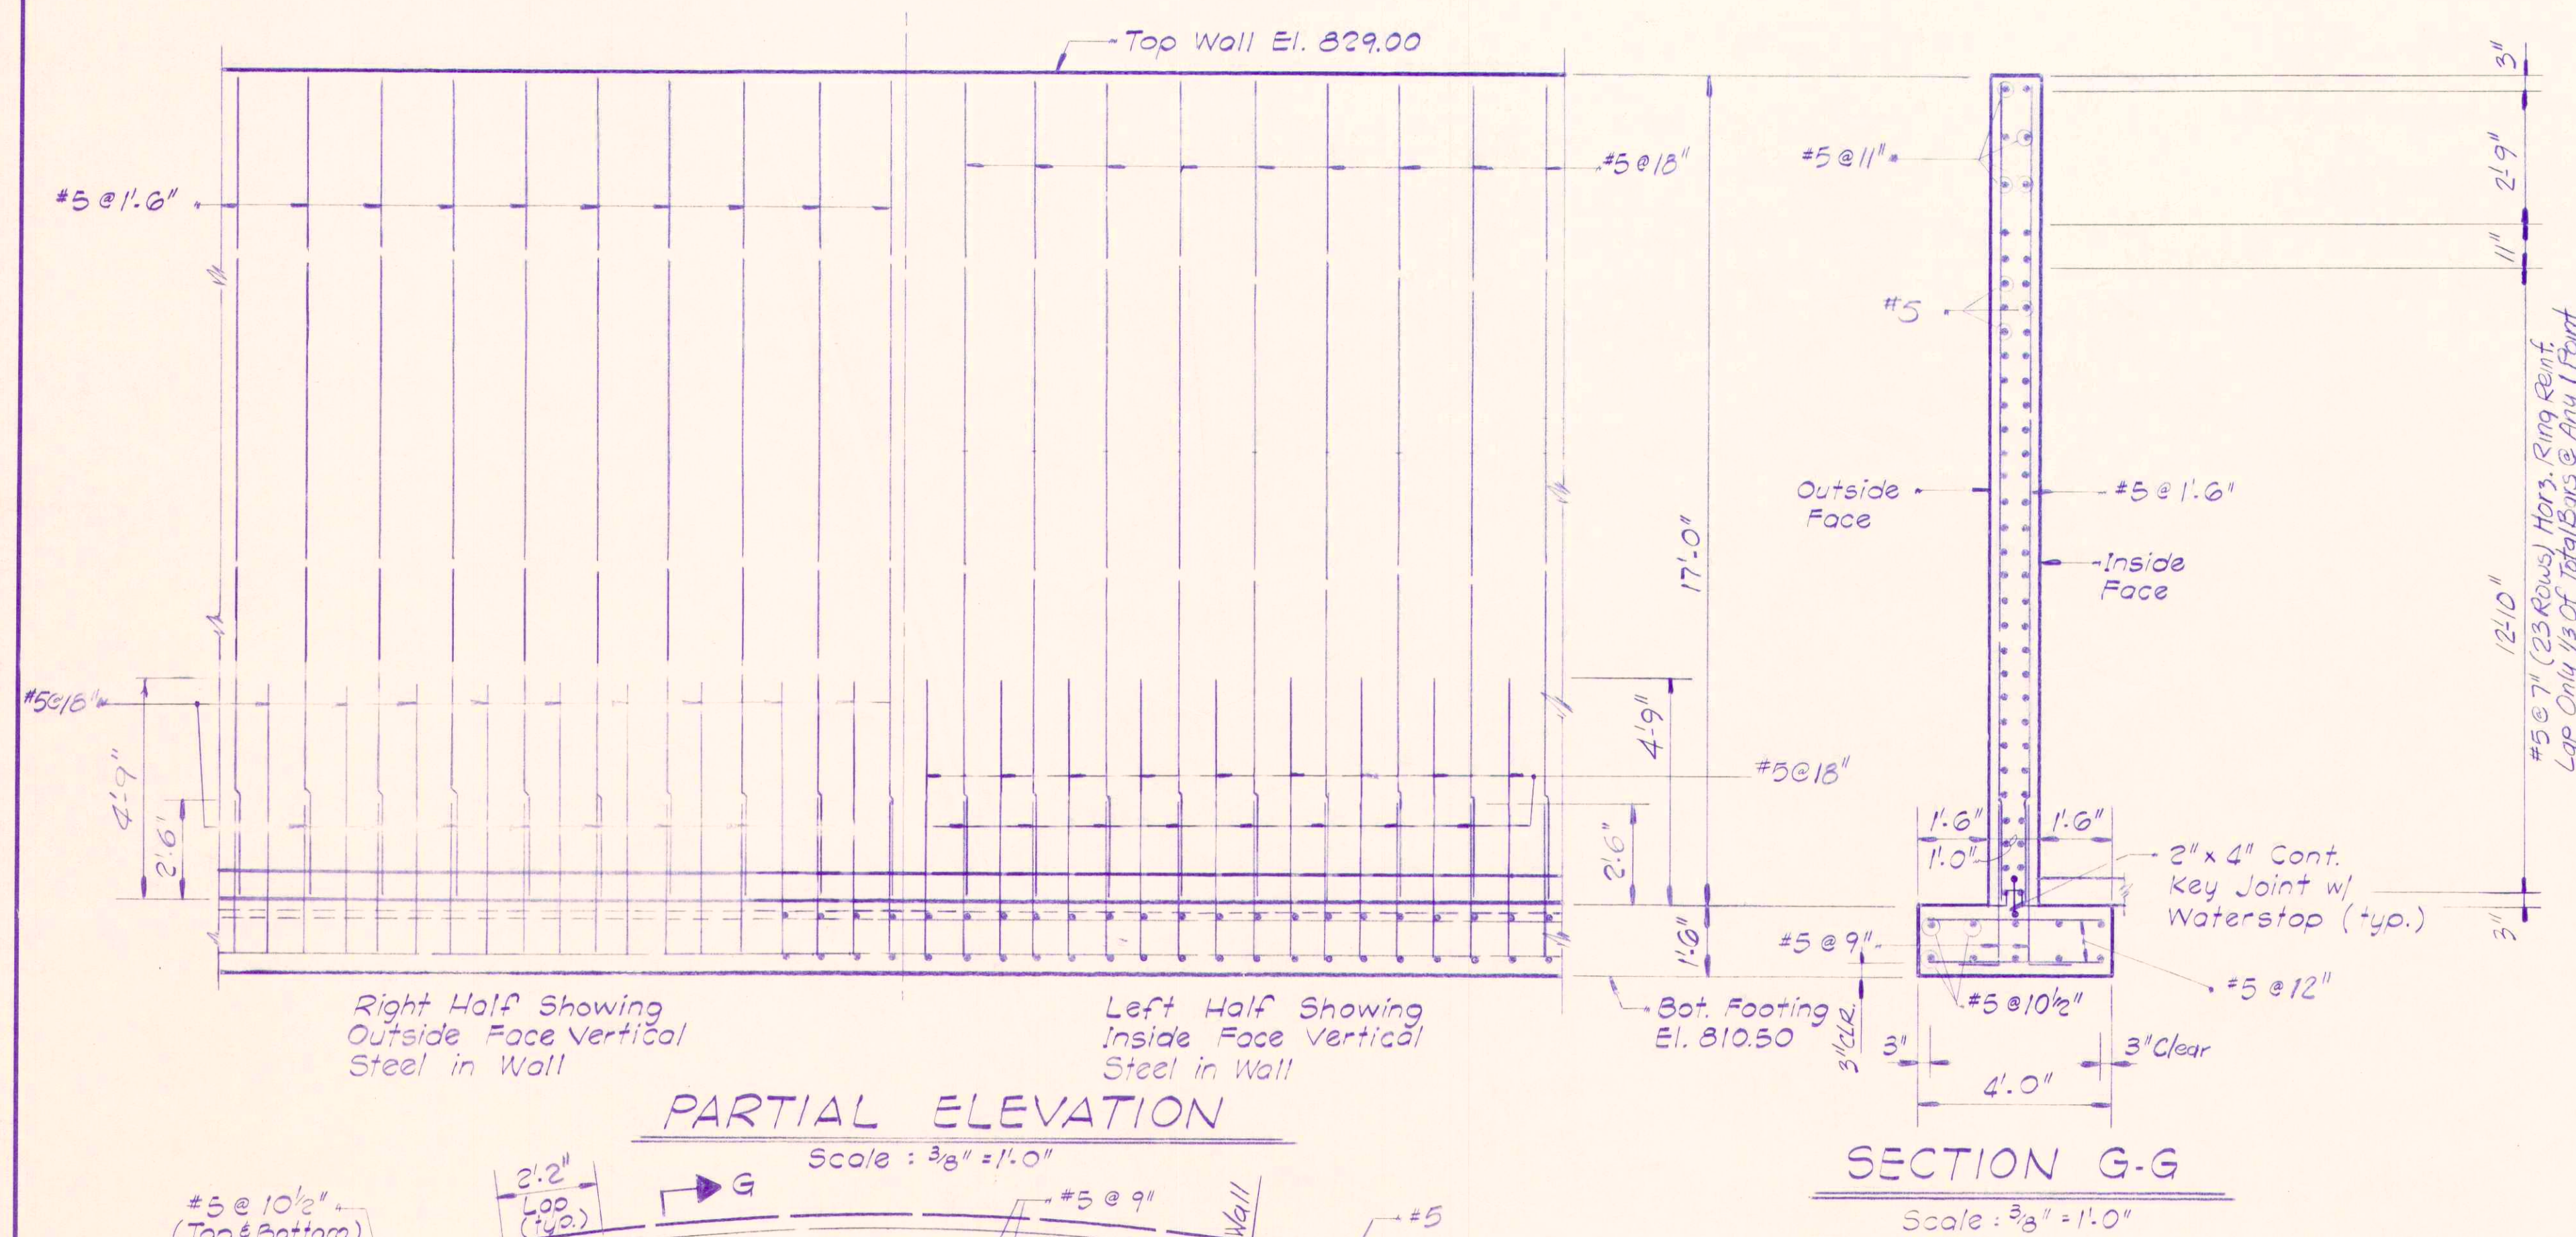
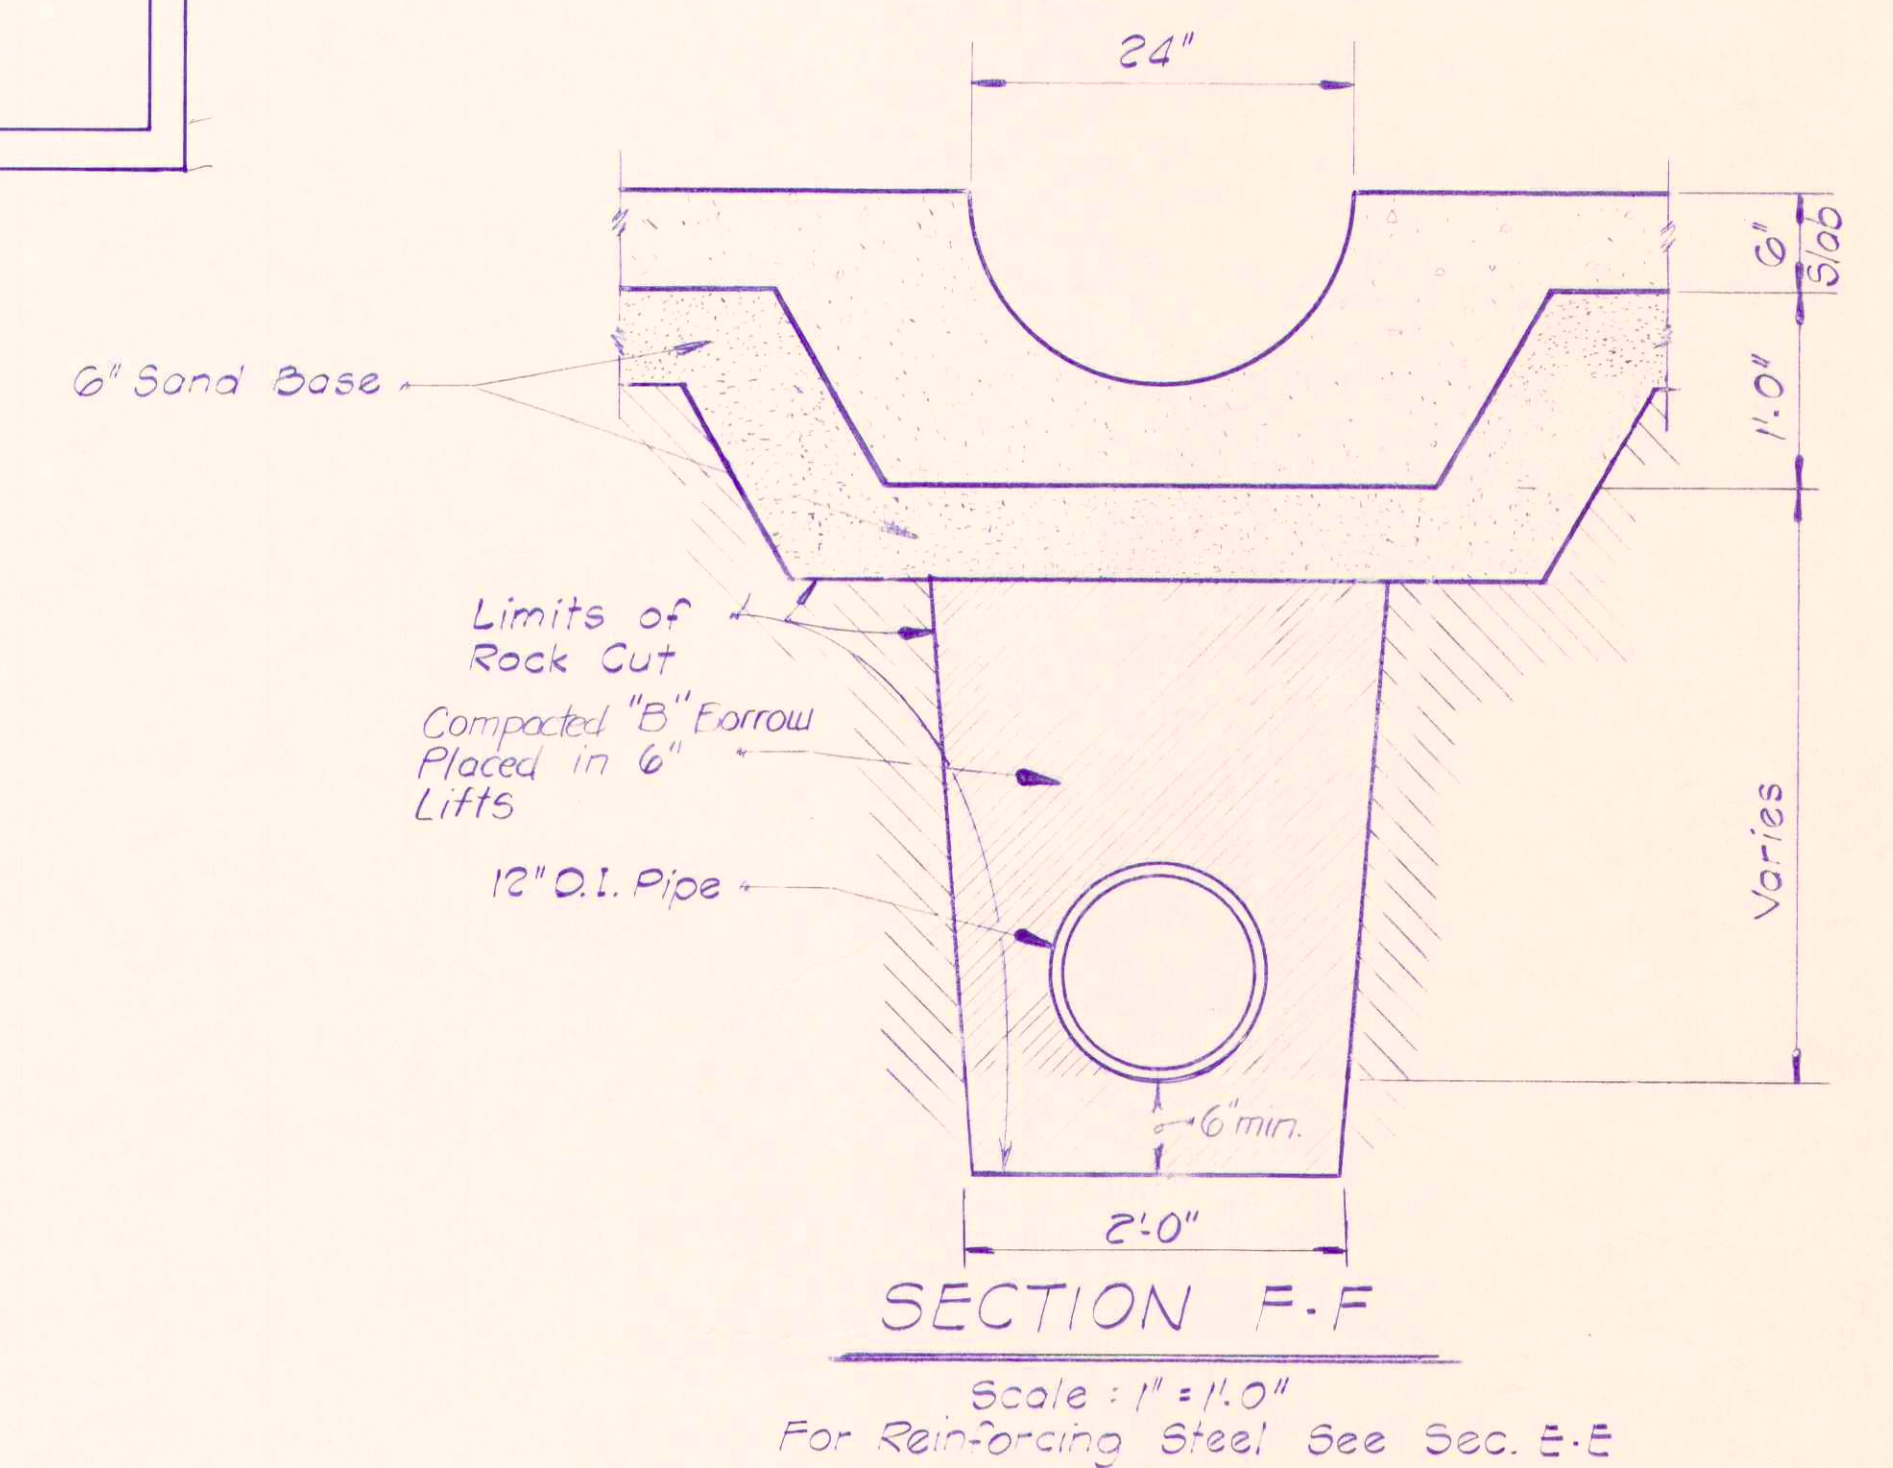
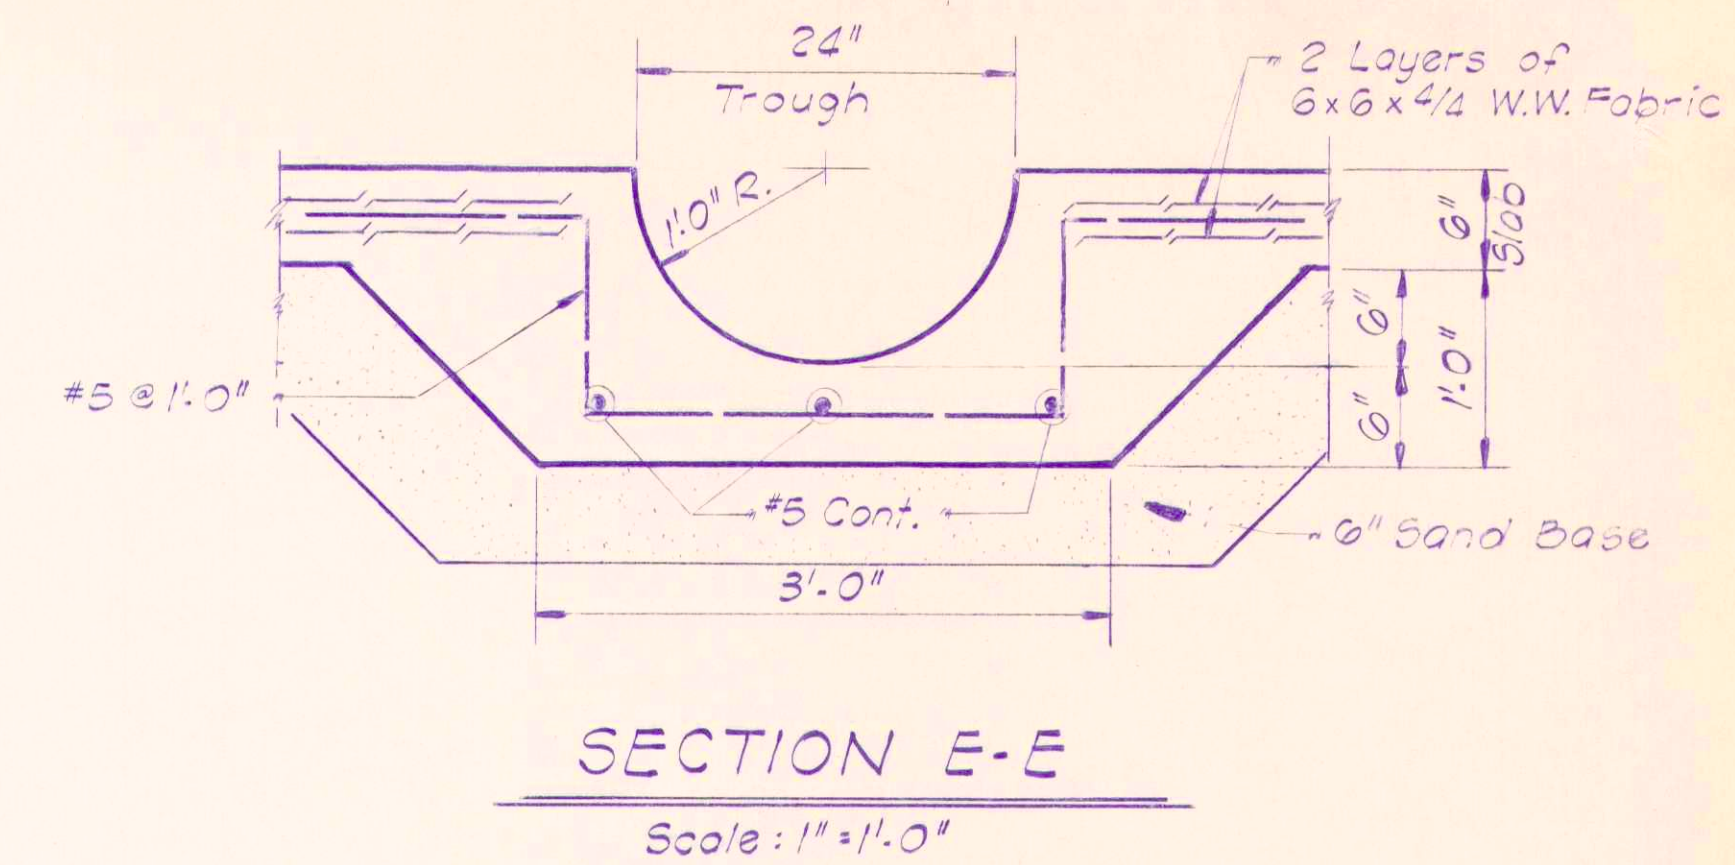


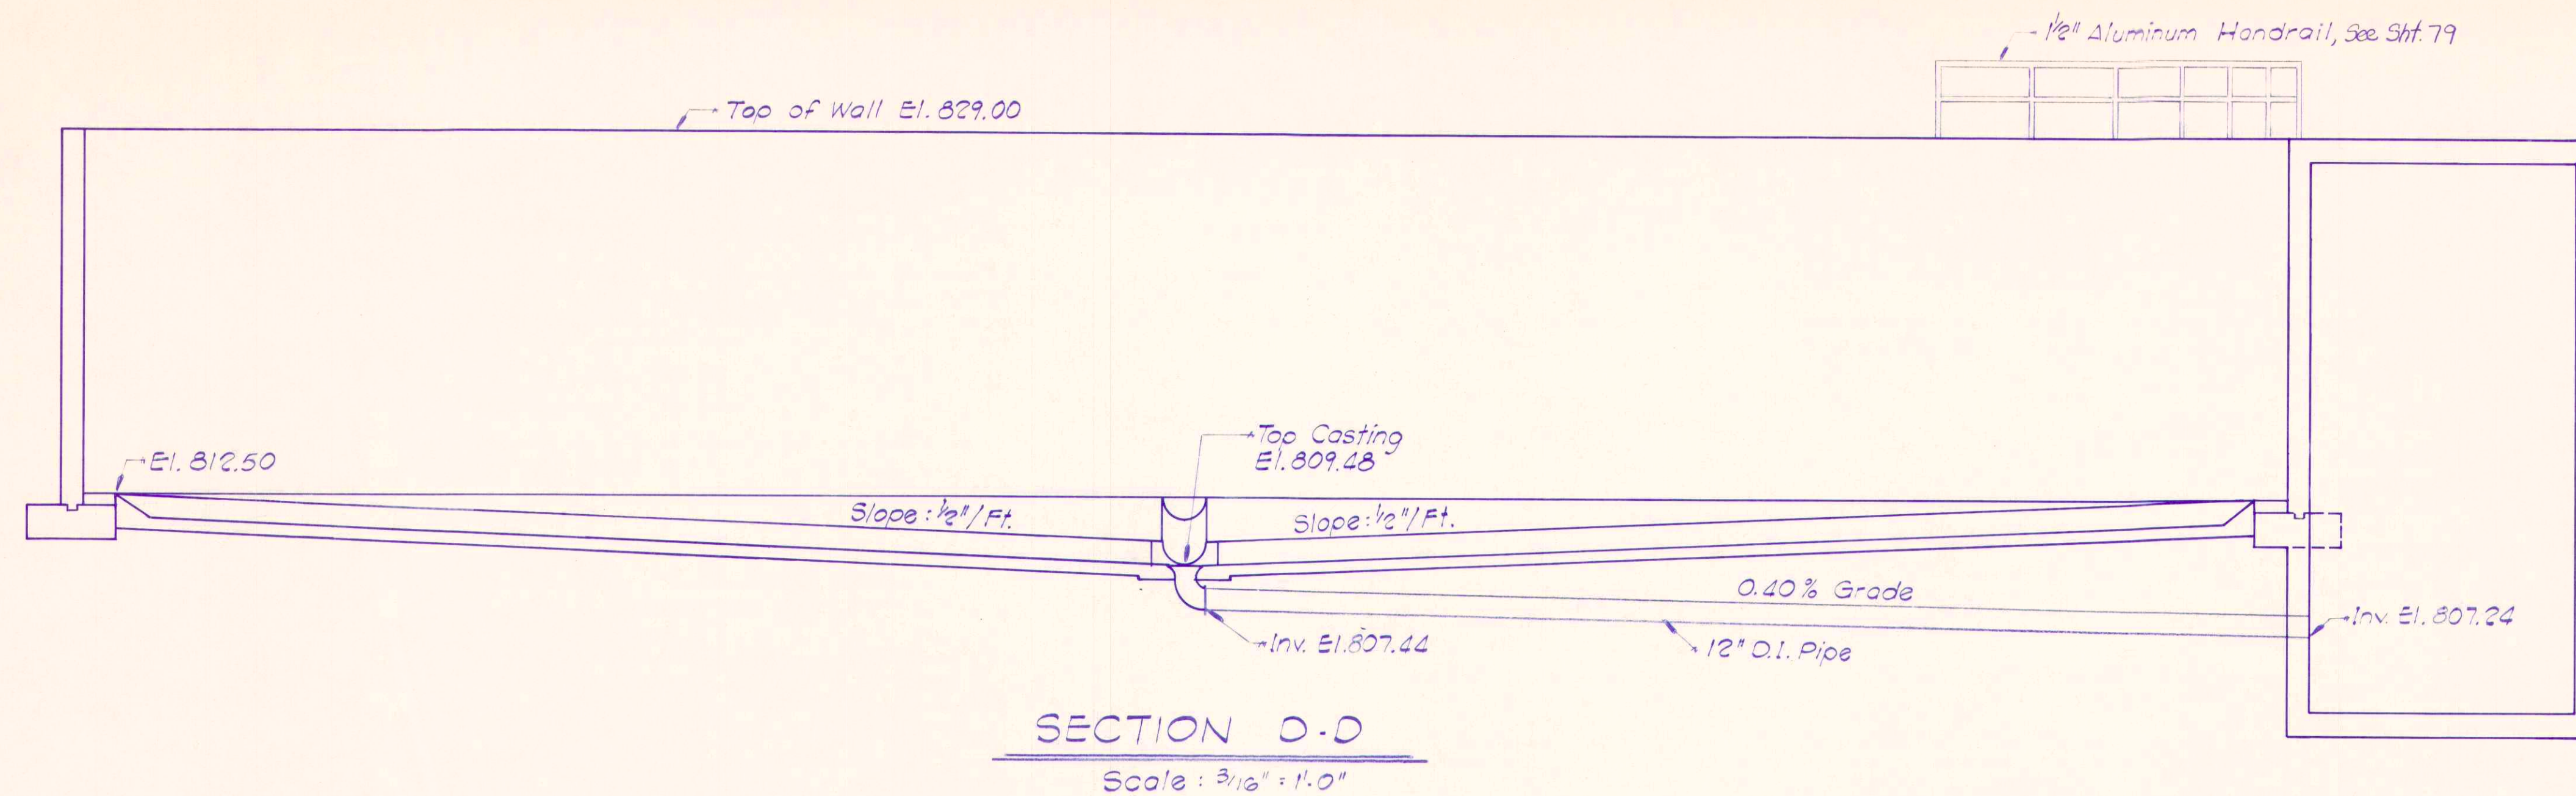

RECORD DRAWING

EQUALIZATION TANK DETAILS ~ STRUCTURAL		
Scale: <i>AS SHOWN</i>	FALL CREEK R.W.D.	Sheet
Drawn By: <i>JB</i>	BEAM, LONGEST & NEFF Consulting Engineers 8136 Castleton Road Indianapolis IN 46250	81
Designed By: <i>RFS</i>		
Certified By: <i>ER</i>		