




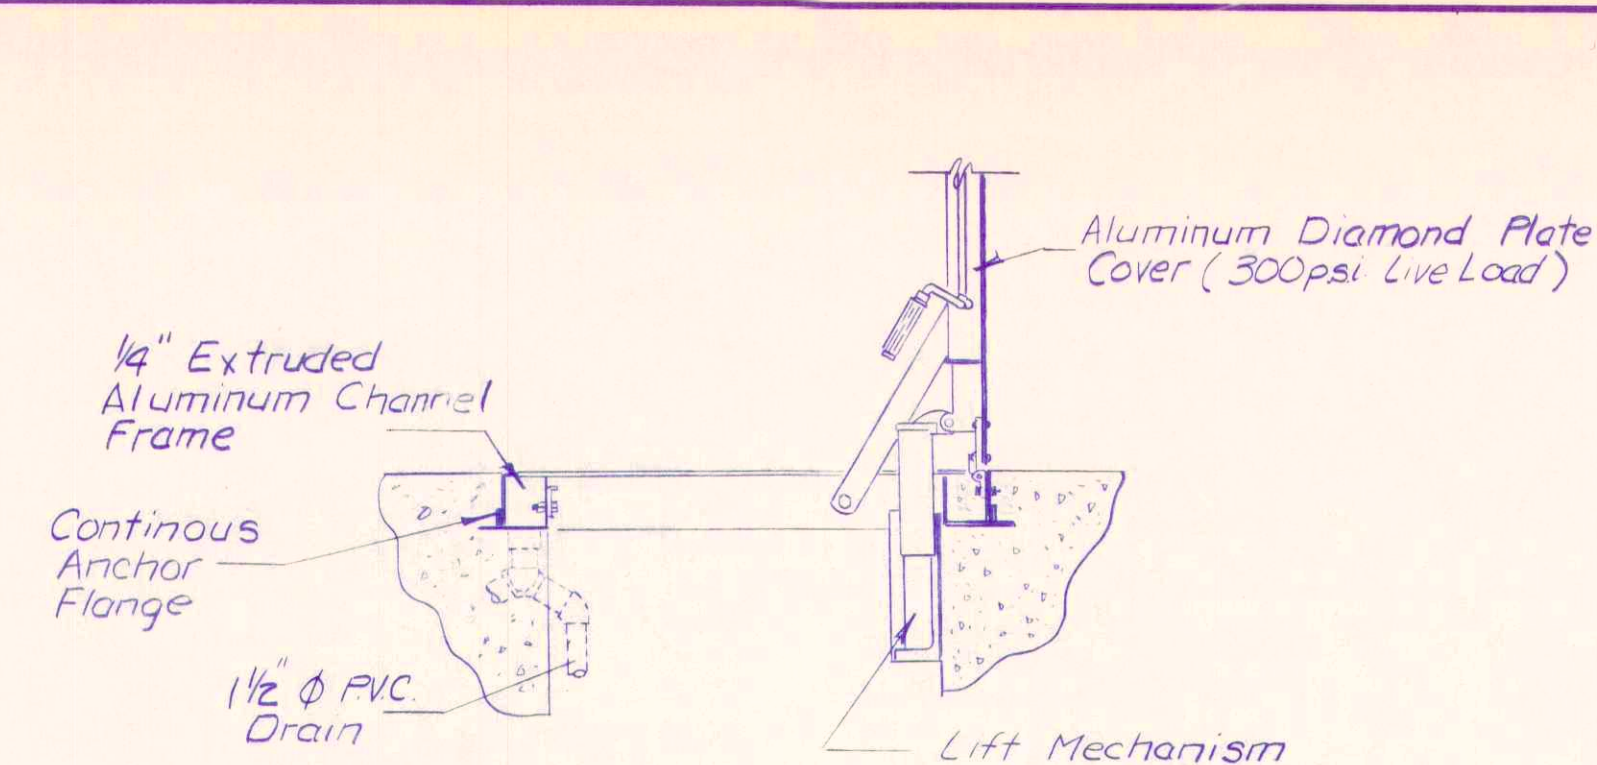


ACCESS DOOR FRAME DETAIL
No Scale

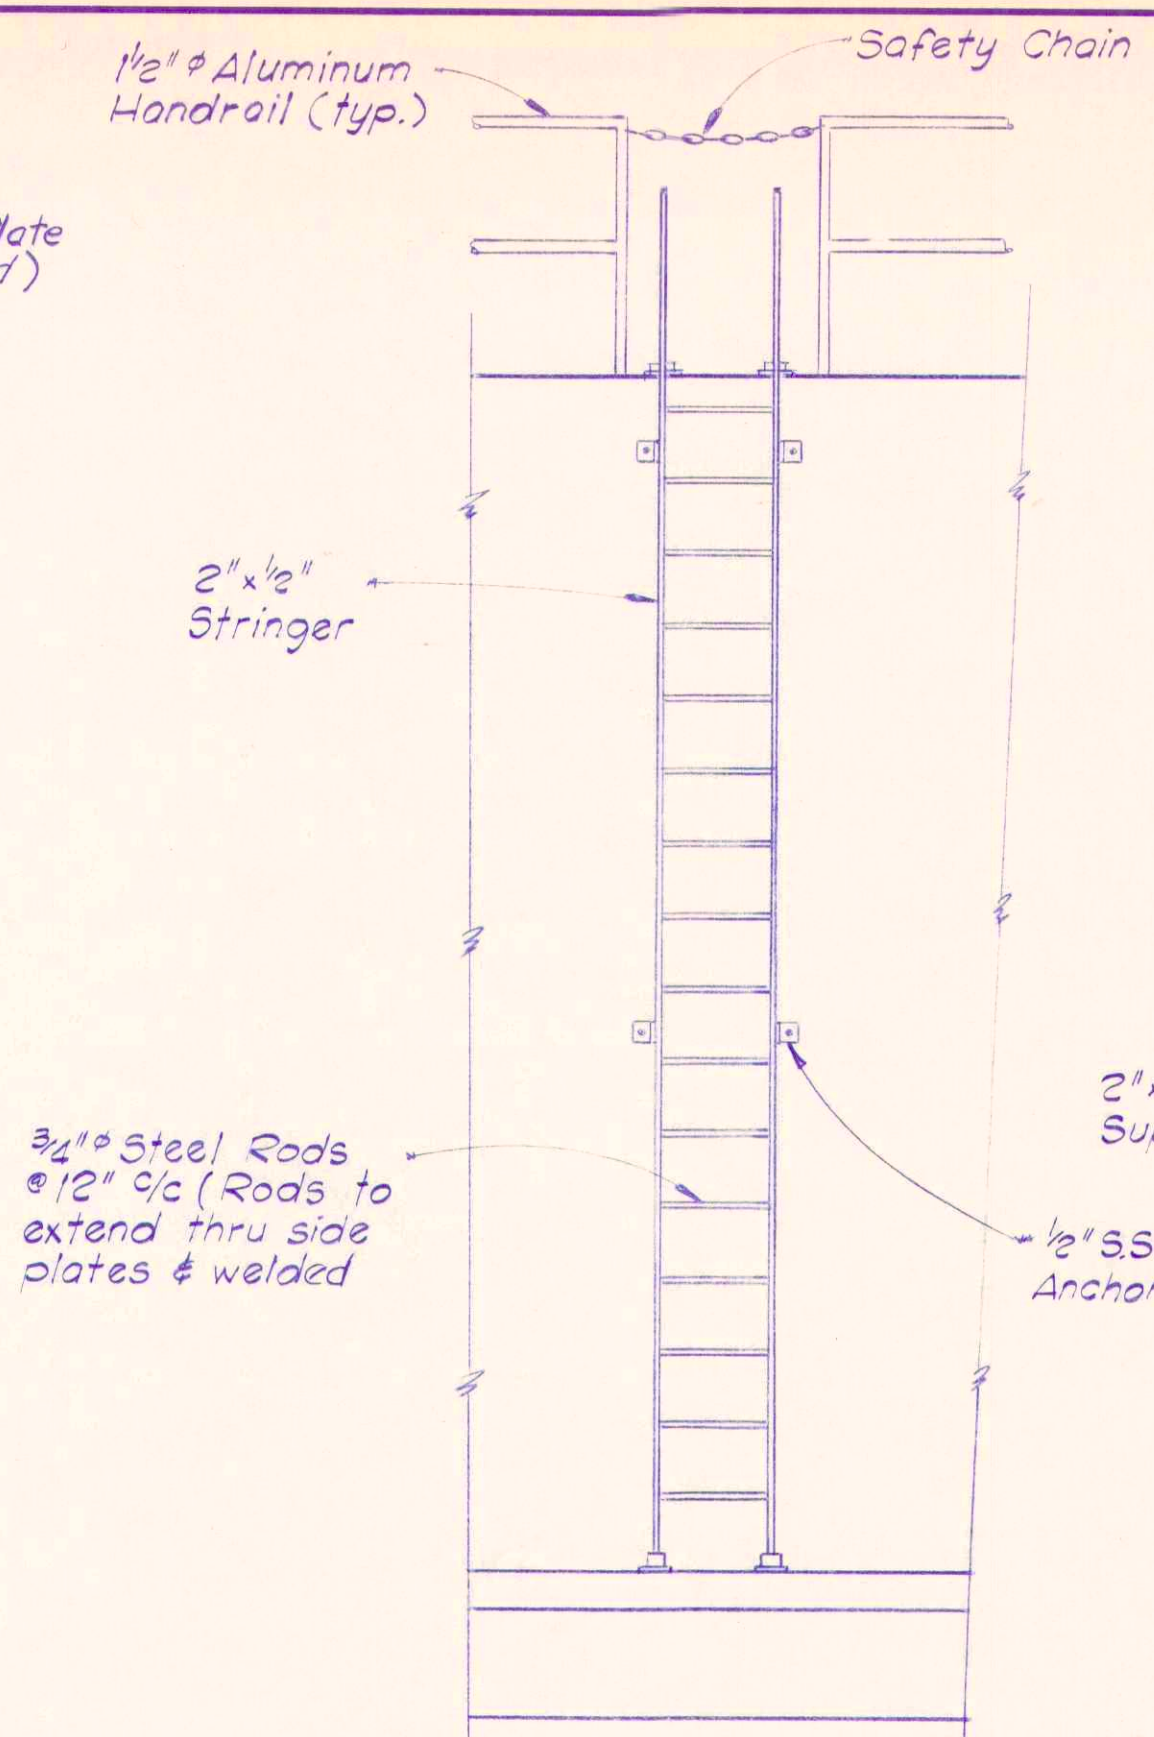


EQUALIZATION TANK LADDER DETAILS
Scale: 3/8" = 1'-0"

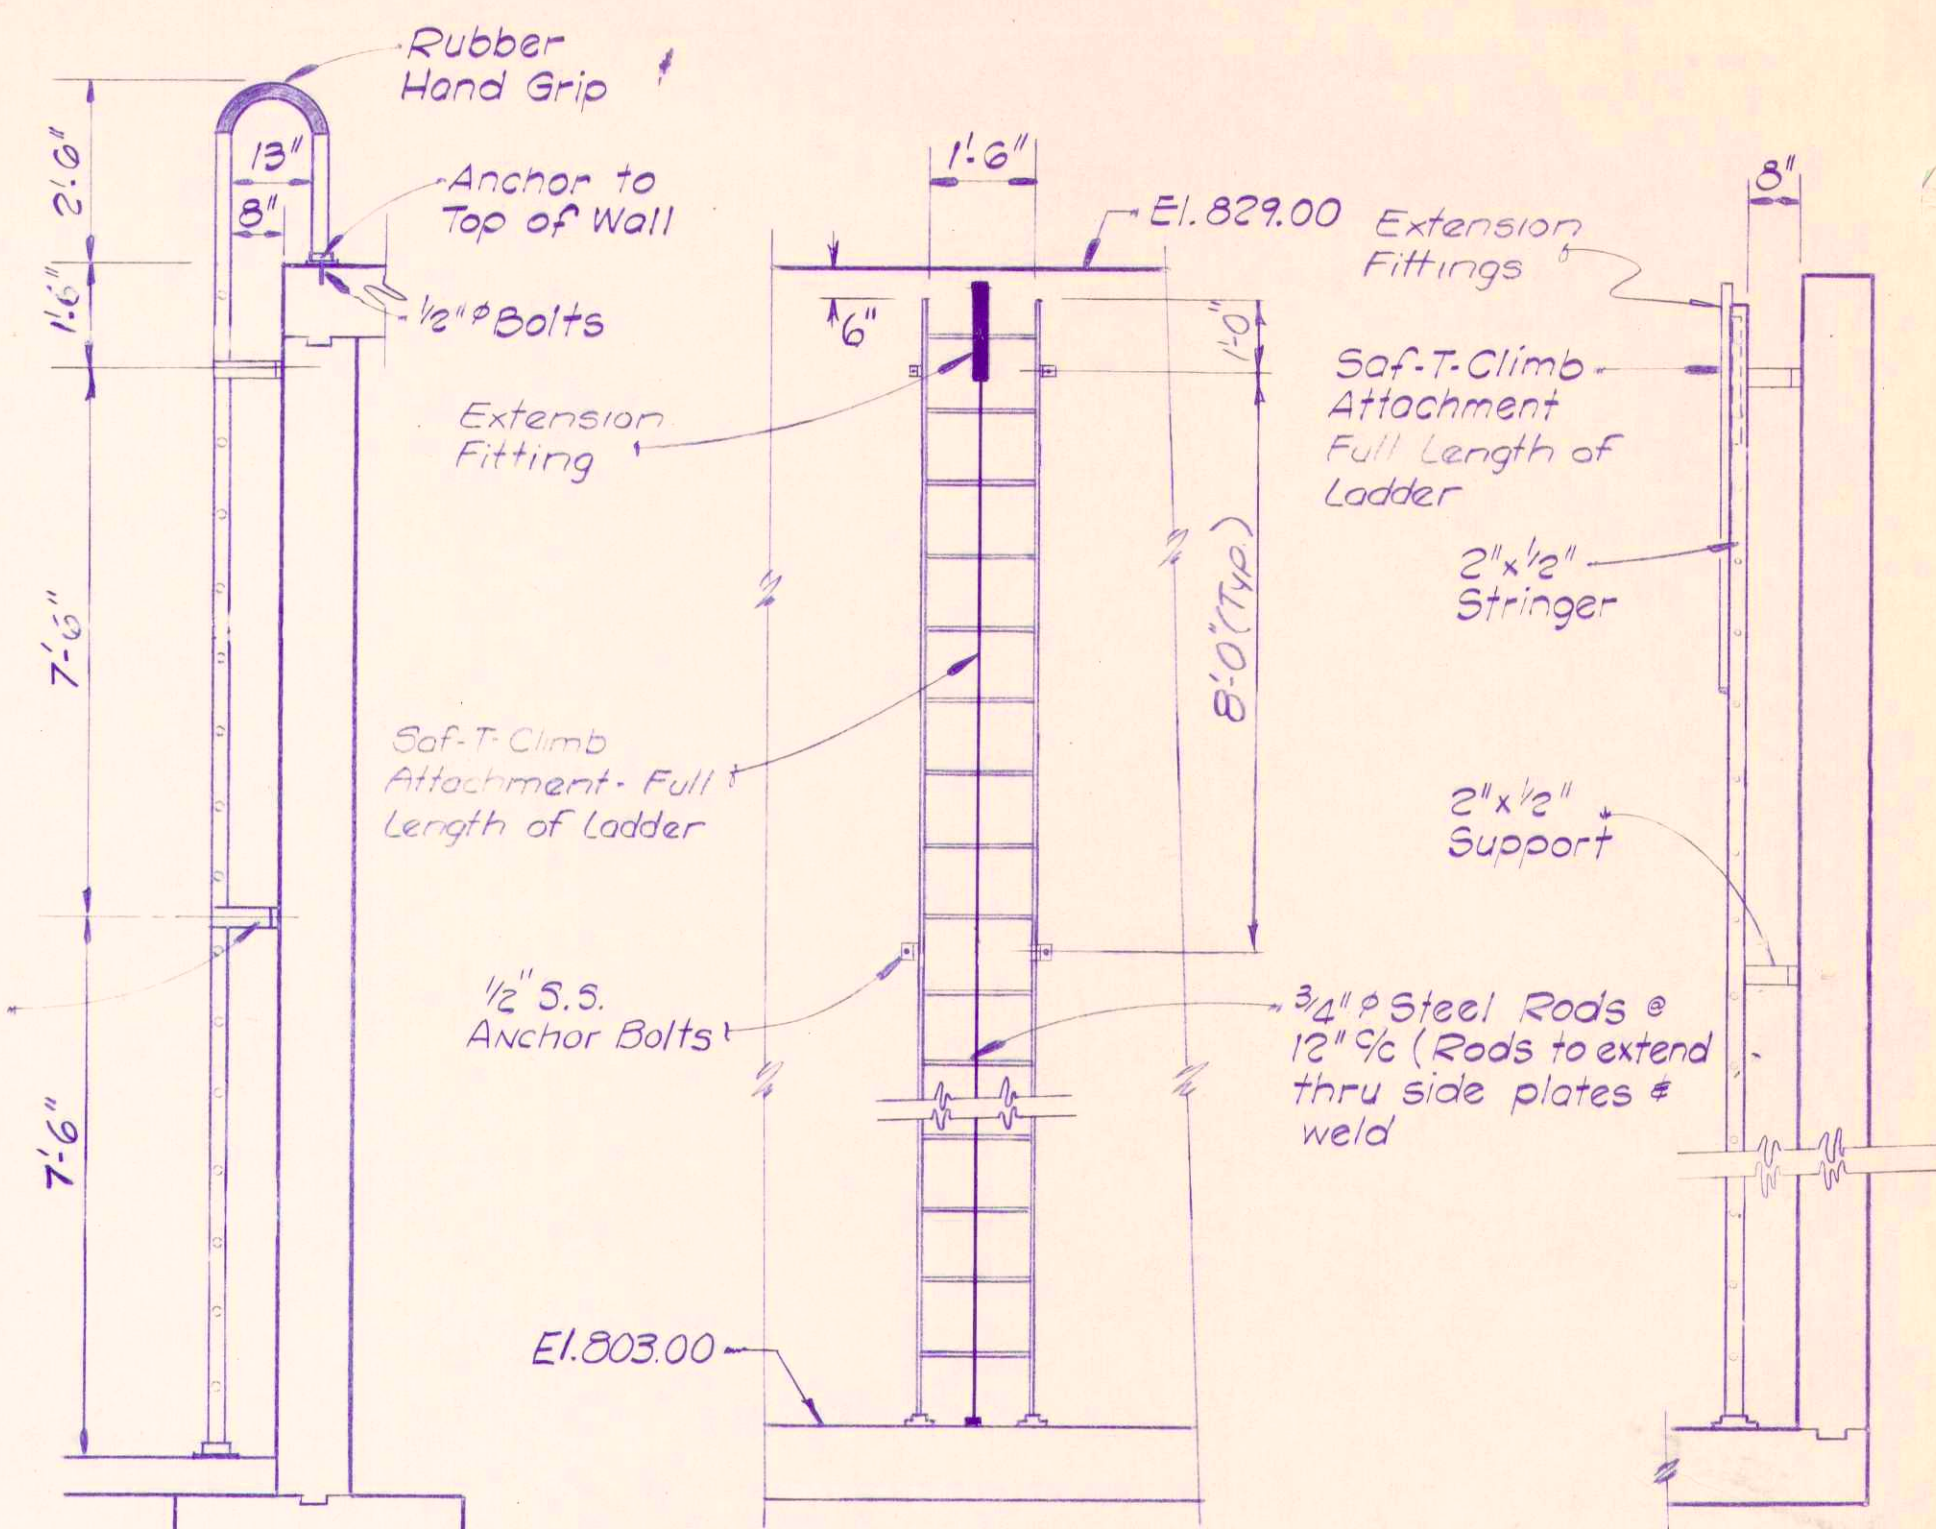


WET WELL LADDER DETAILS
Scale: 3/8" = 1'-0"

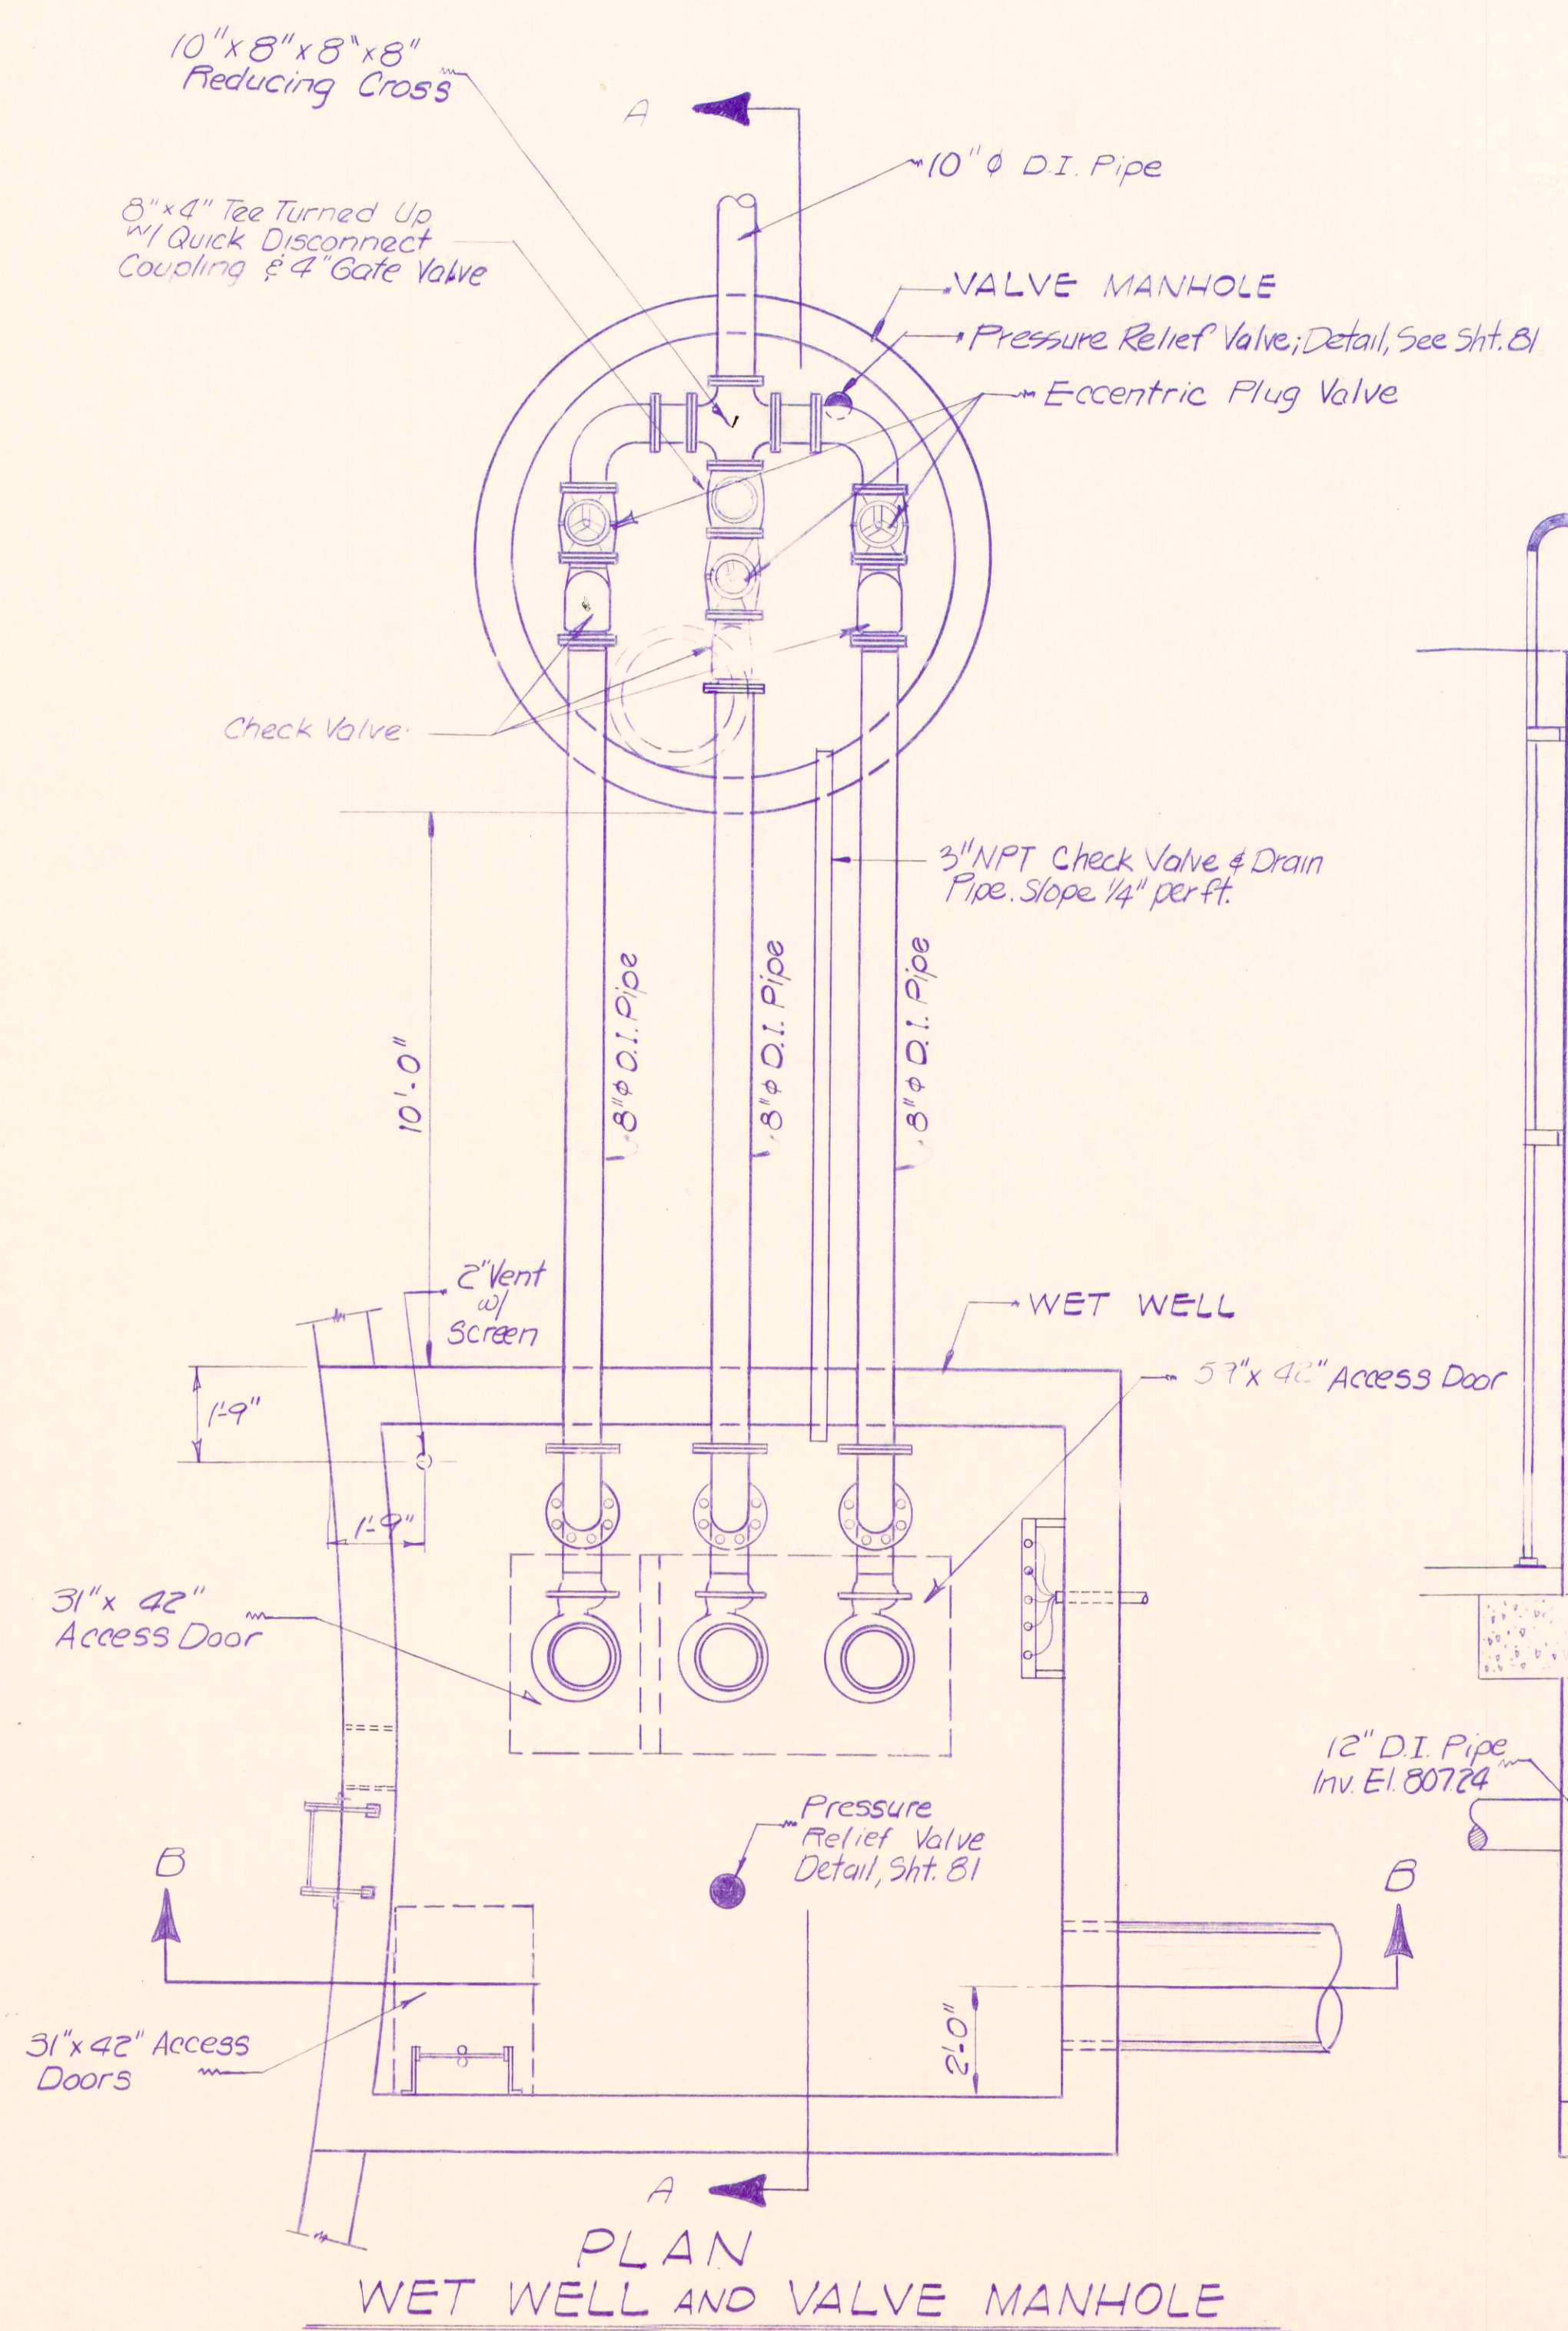

PLAN WET WELL AND VALVE MANHOLE

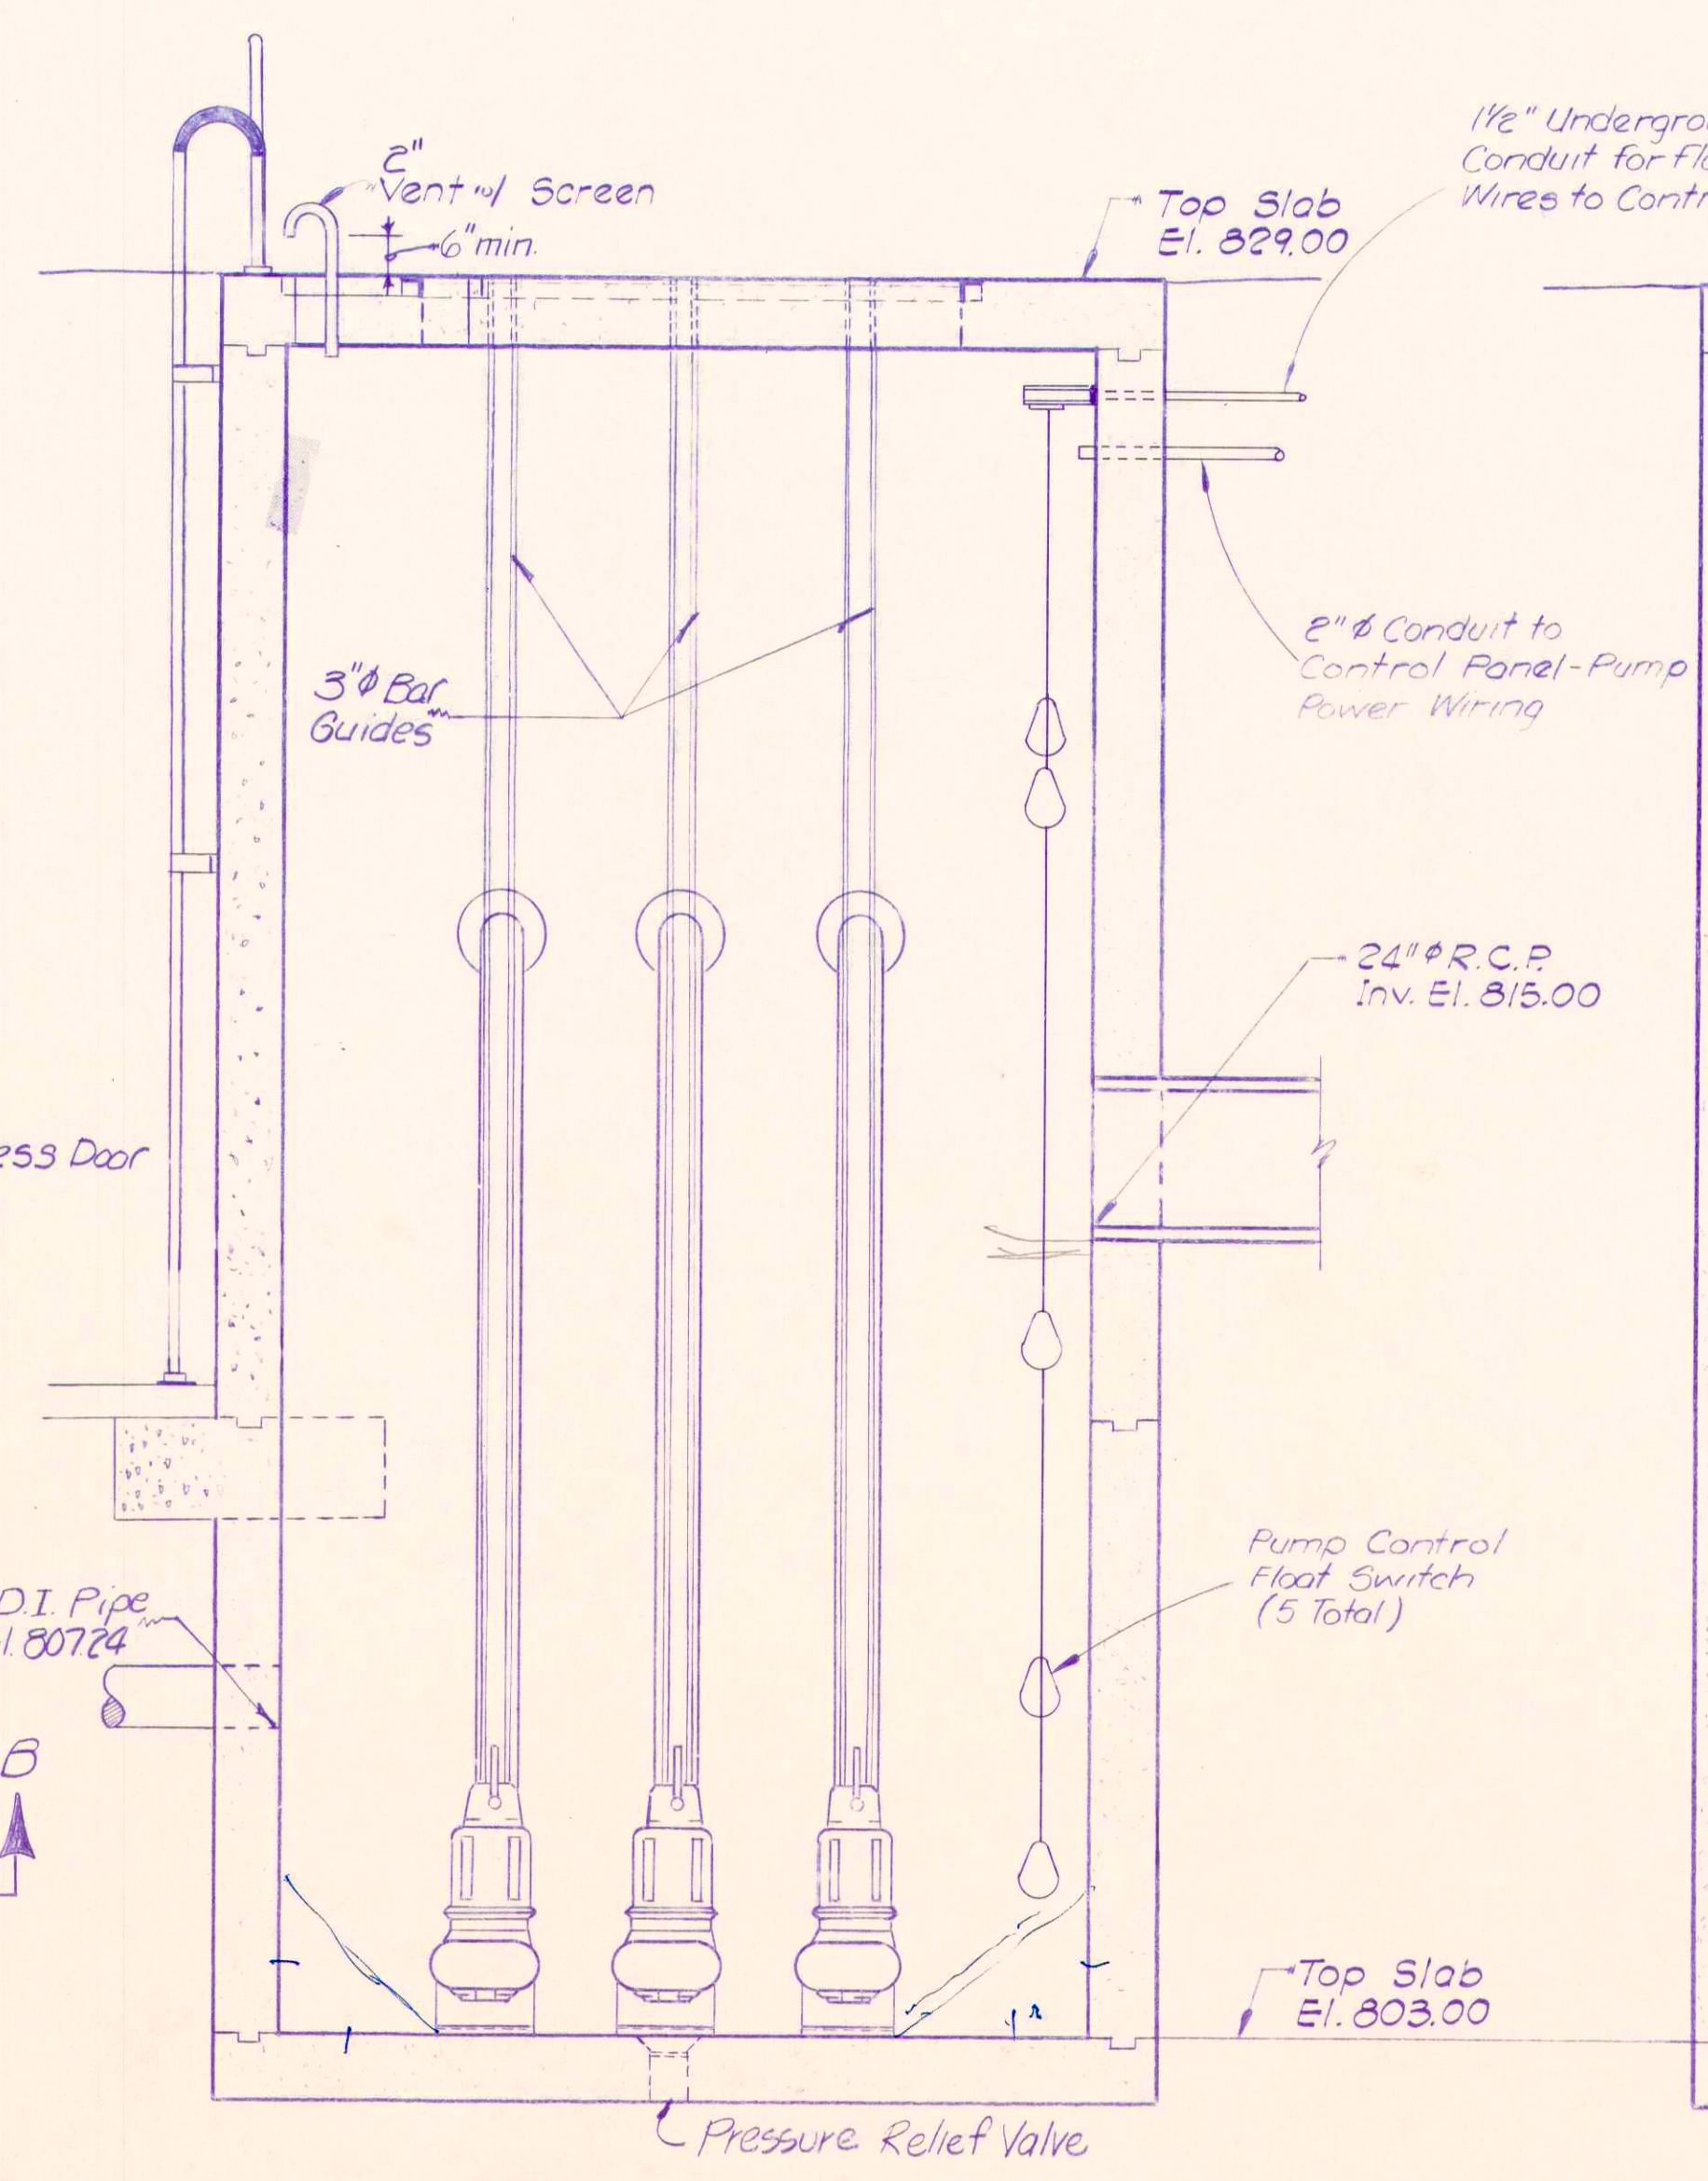

SECTION B-B

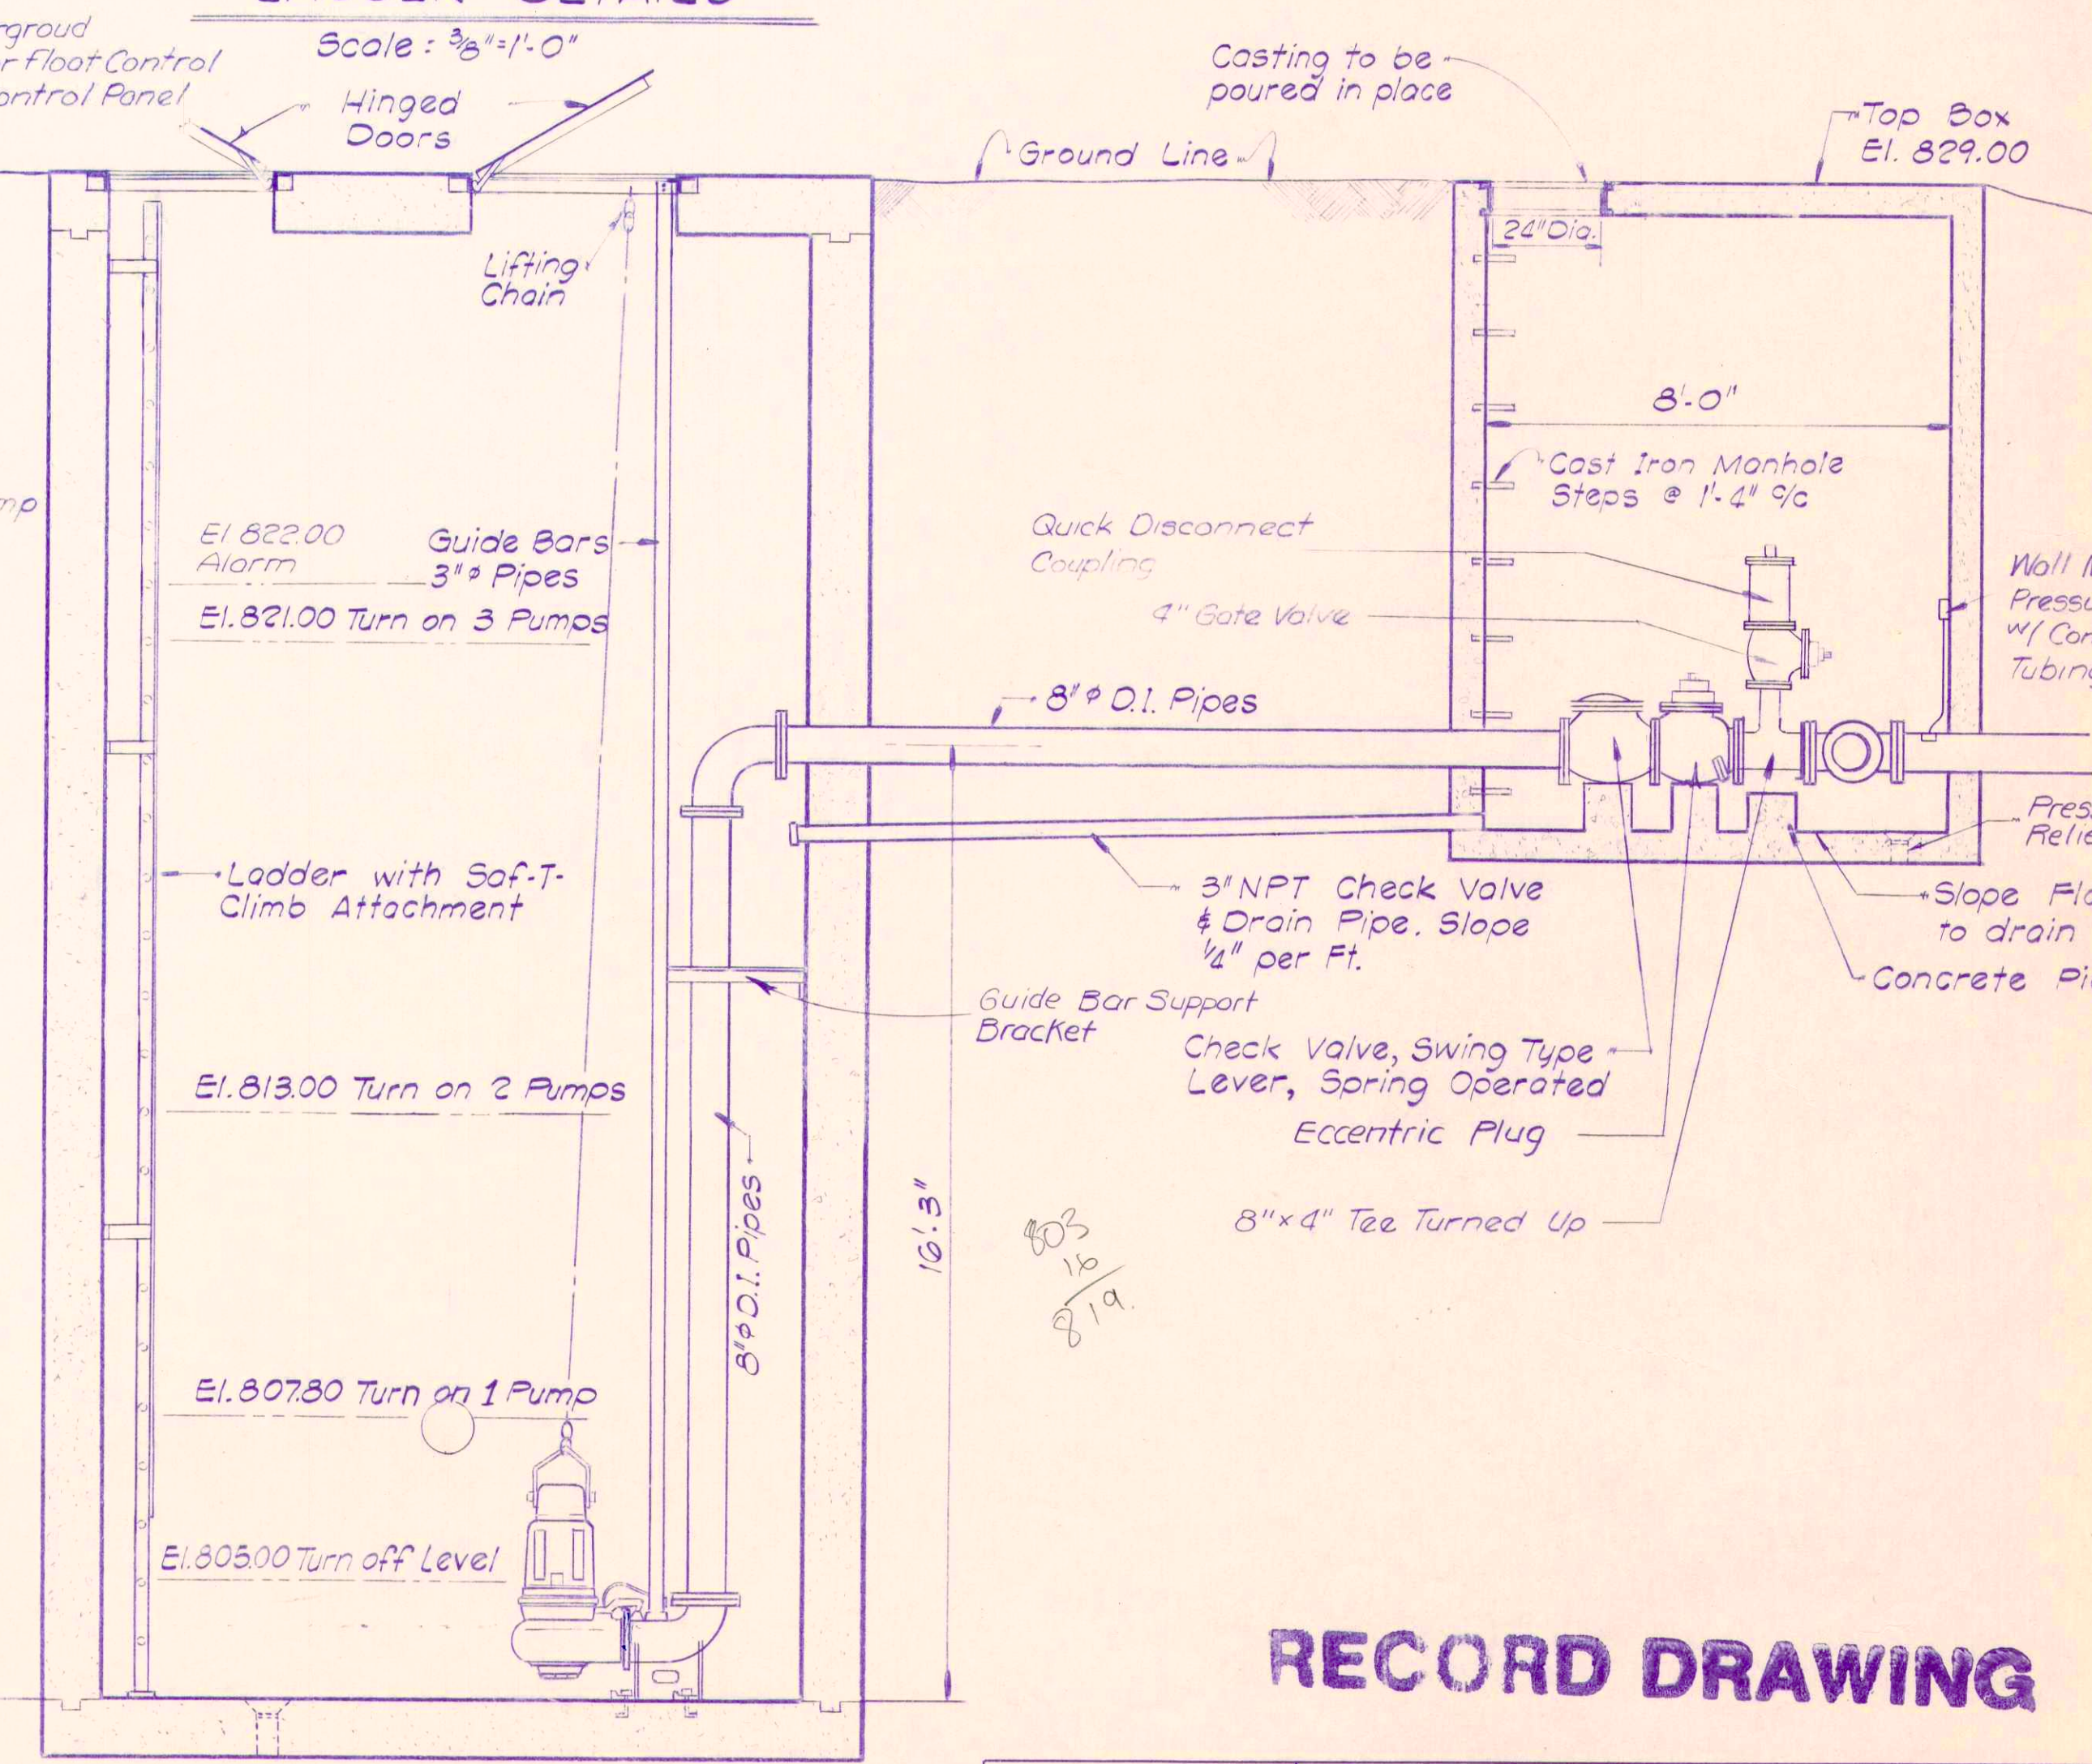

SECTION A-A

RECORD DRAWING

EQUALIZATION TANK DETAILS - MECHANICAL		
Scale: 3/8" = 1'-0"	FALL CREEK R.W.D.	Sheet
Drawn By: J.B.	BEAM, LONGEST & NEFF	82
Designed By: R.F.S.	Consulting Engineers	
Certified By: E.R.	8136 Castleton Road Indianapolis, IN 46250	