




THRUST BLOCK FOR HORIZONTAL BEND


Scale: None
(Thrust Blocks To Be Provided At All Bends In Force Mains)

THRUST BLOCK FOR VERTICAL ELBOW

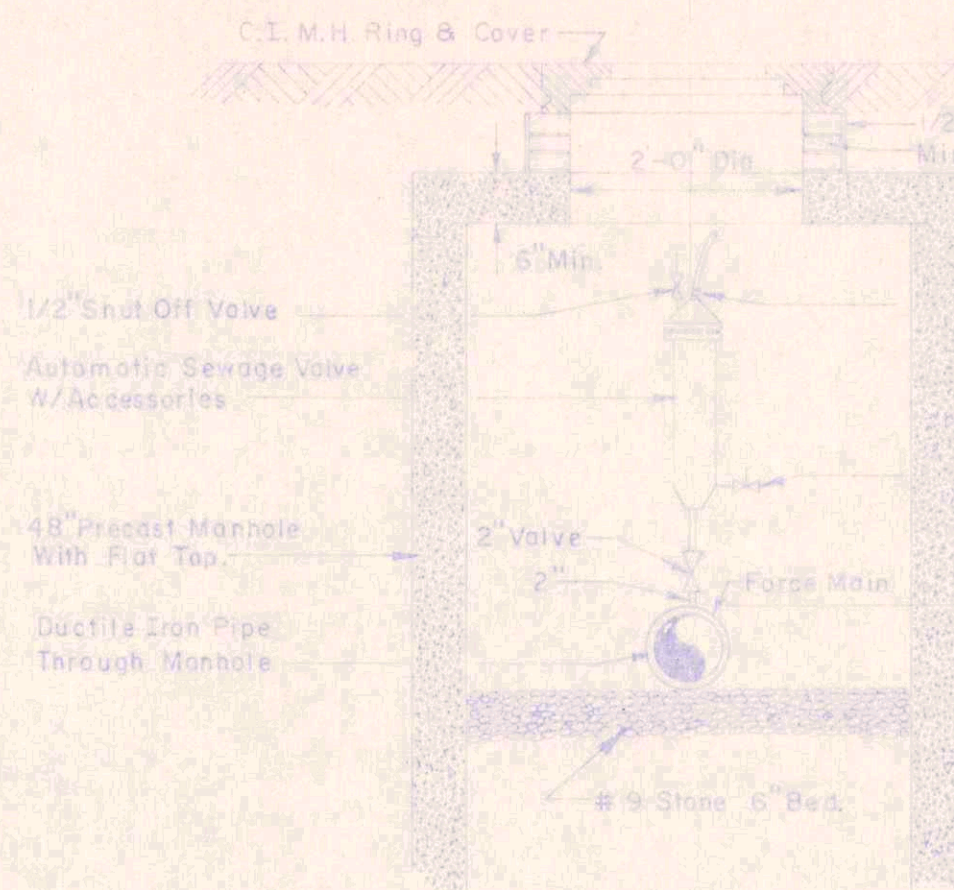


FORCE MAIN AIR RELEASE

SCALE: NONE

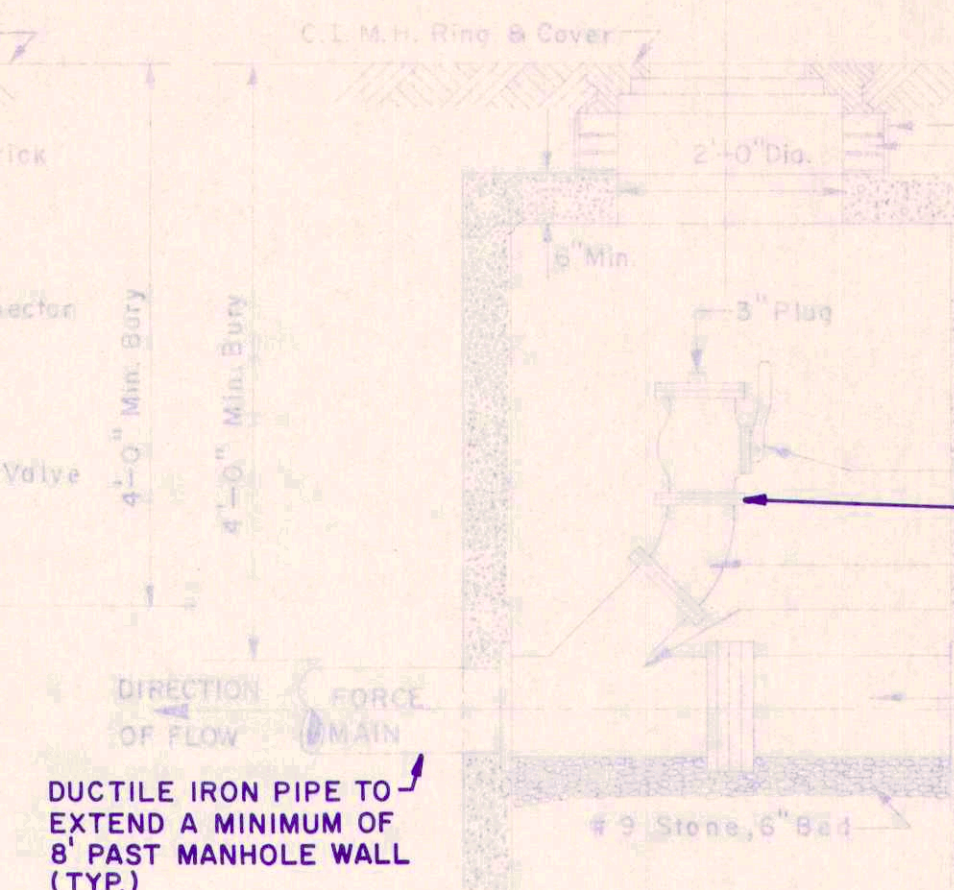


CLEANOUTS FOR FORCE MAINS

SCALE: NONE

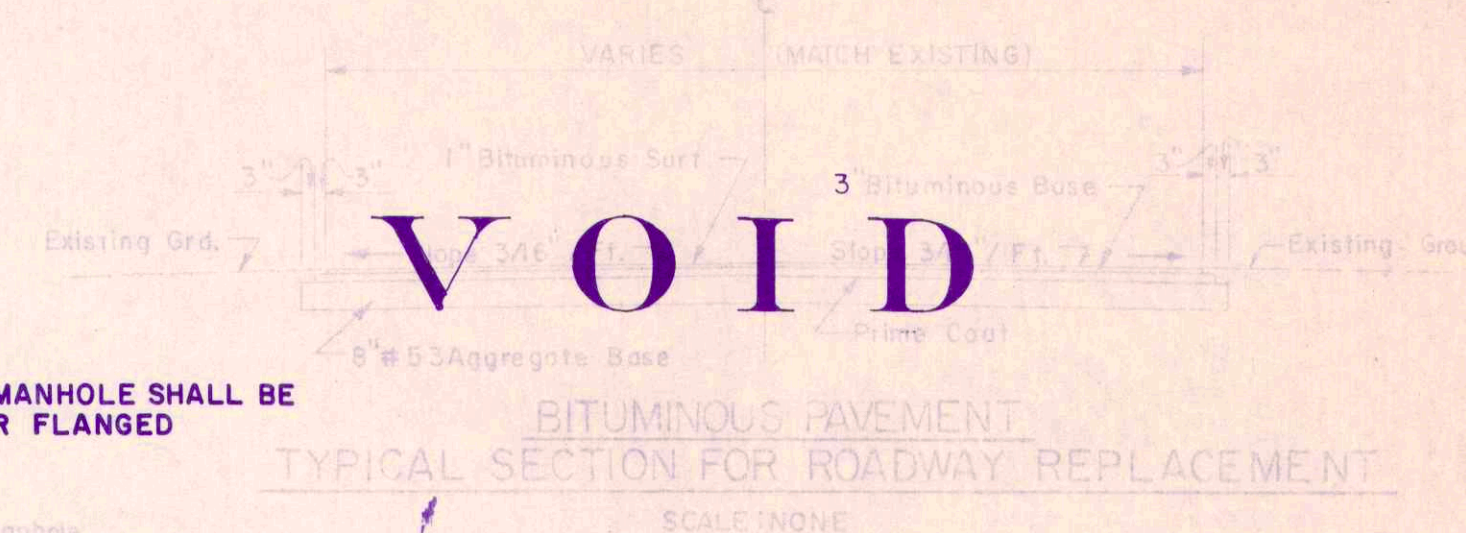


TYPICAL SECTION FOR ROADWAY REPLACEMENT

SCALE: NONE

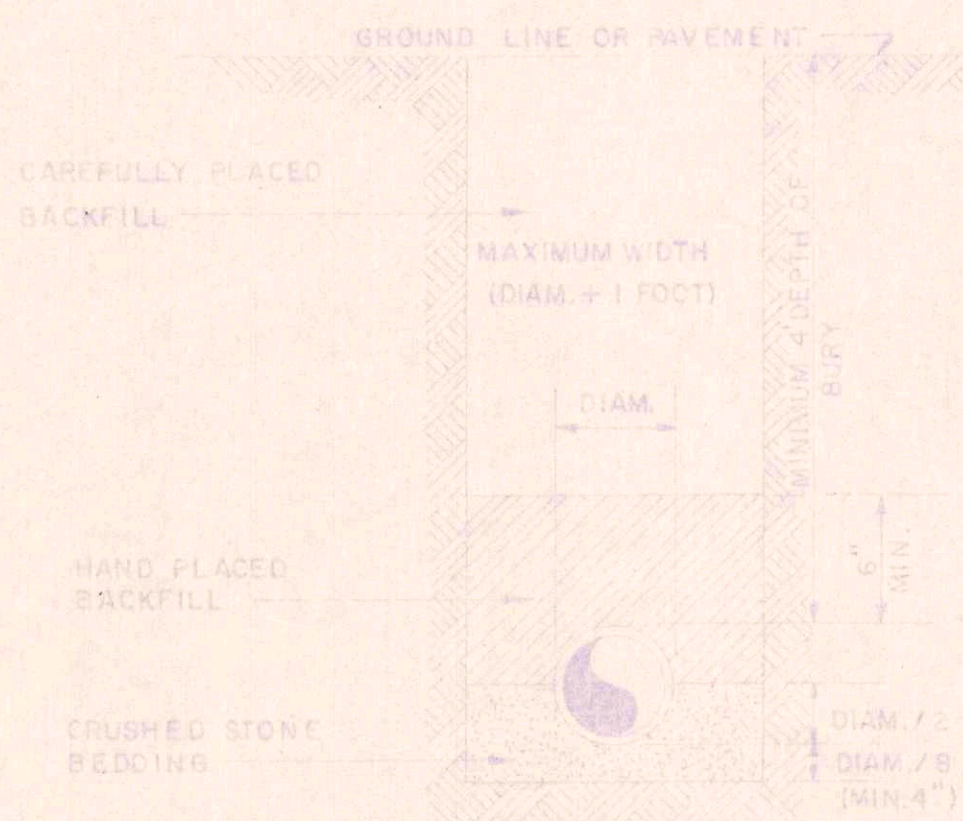


FORCE MAIN TRENCH DETAIL

SCALE: NONE

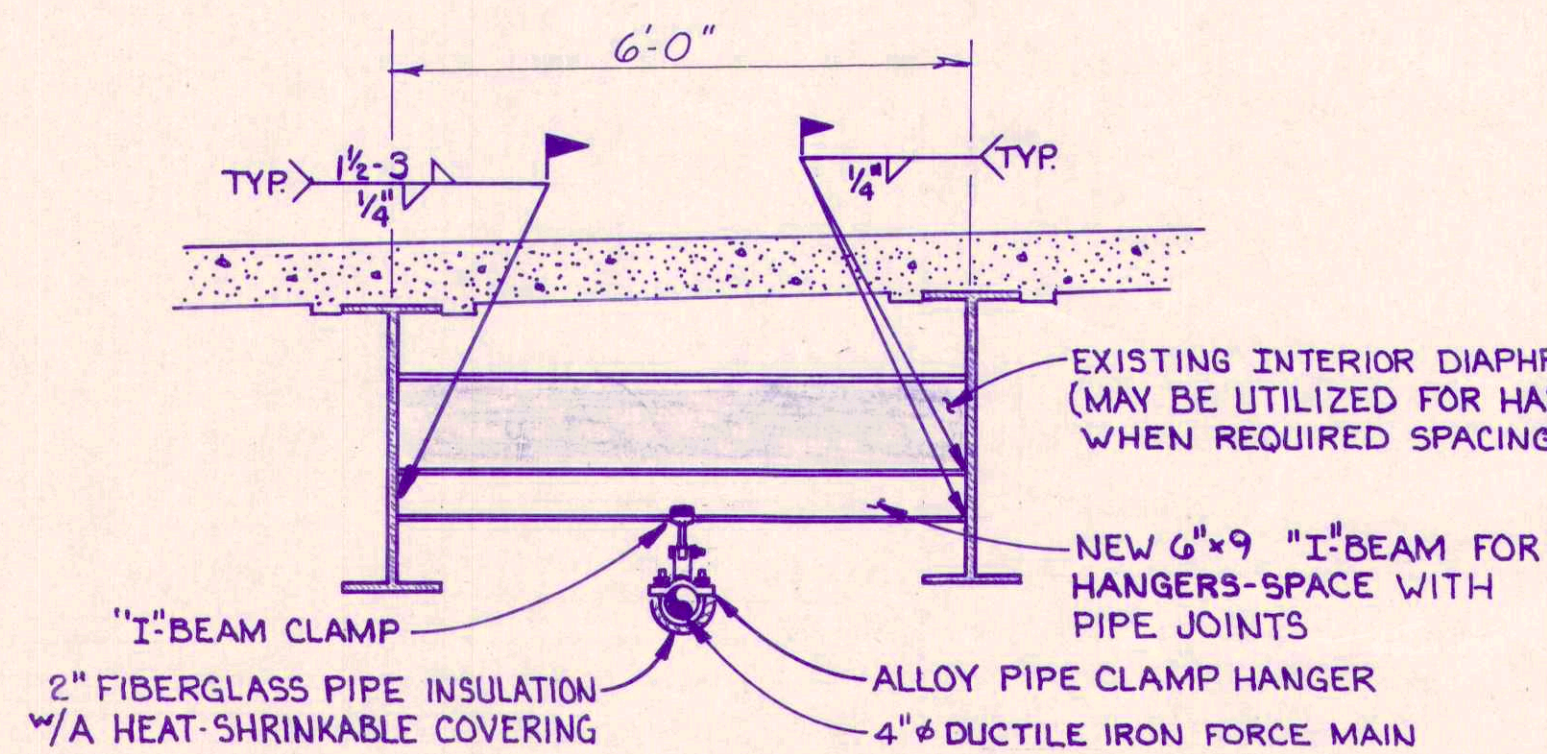


AERIAL FORCE MAIN CROSSING

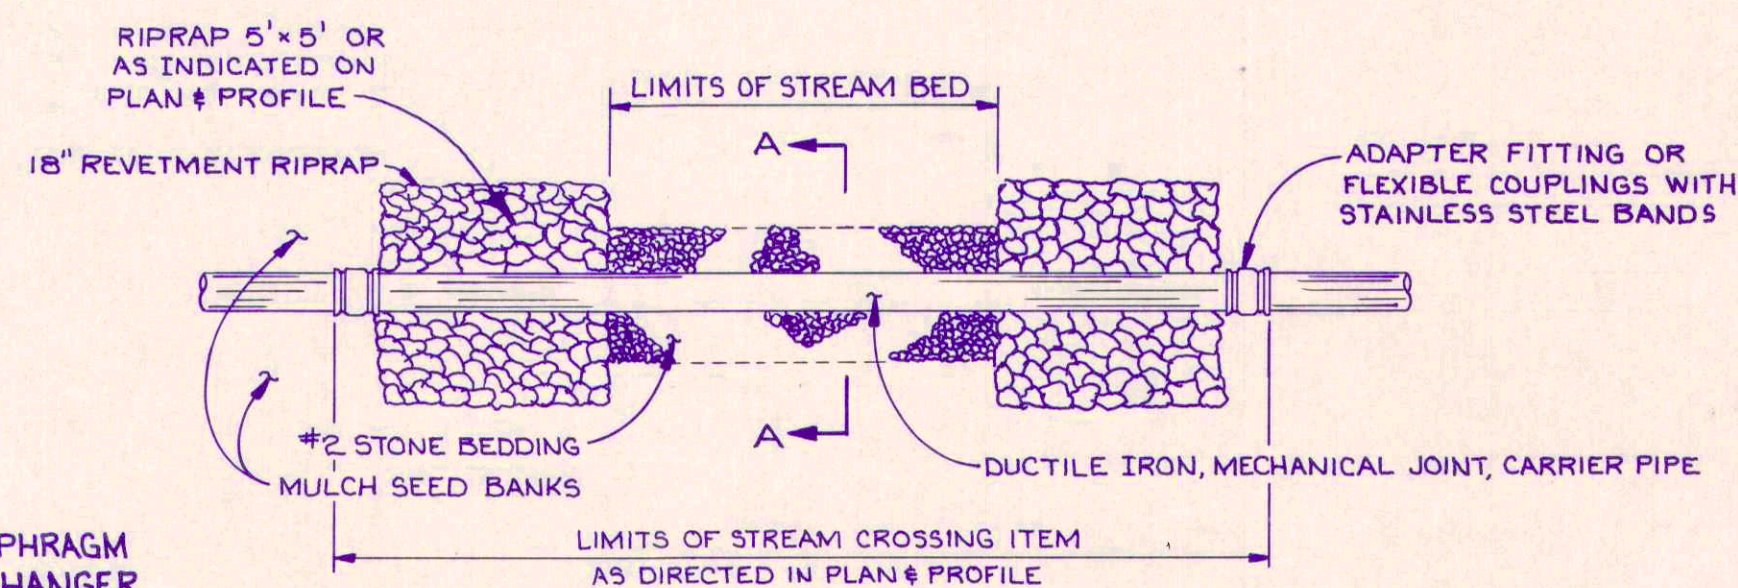

PLAN VIEW


NO SCALE

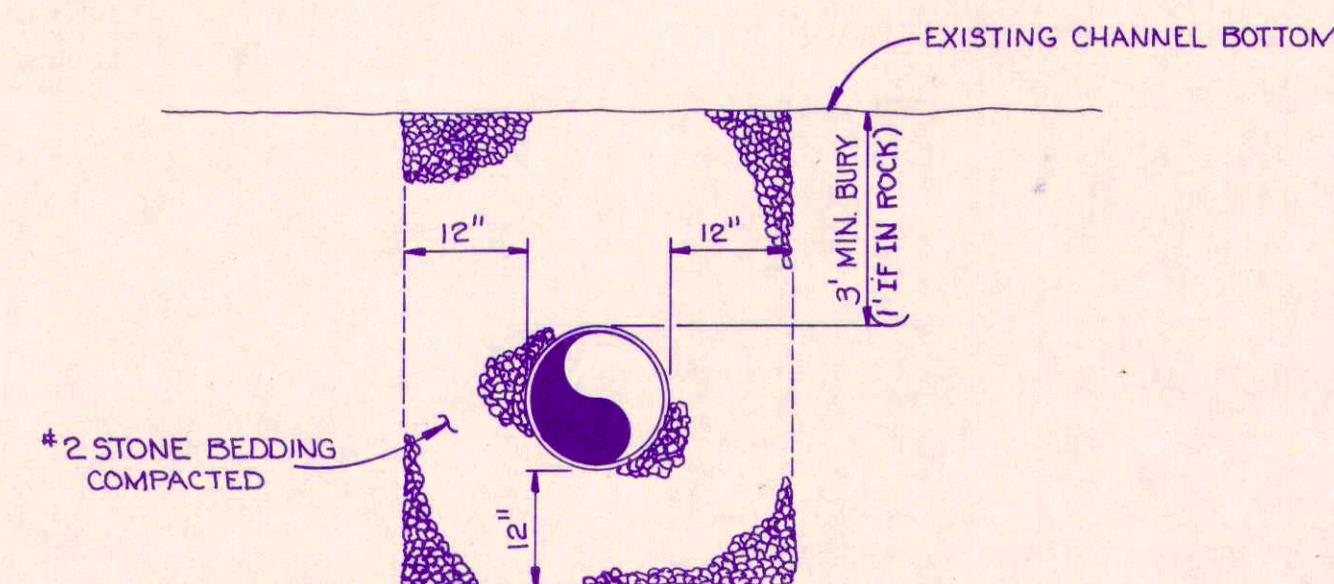


SECTION A-A

NO SCALE

STREAM CROSSING DETAIL

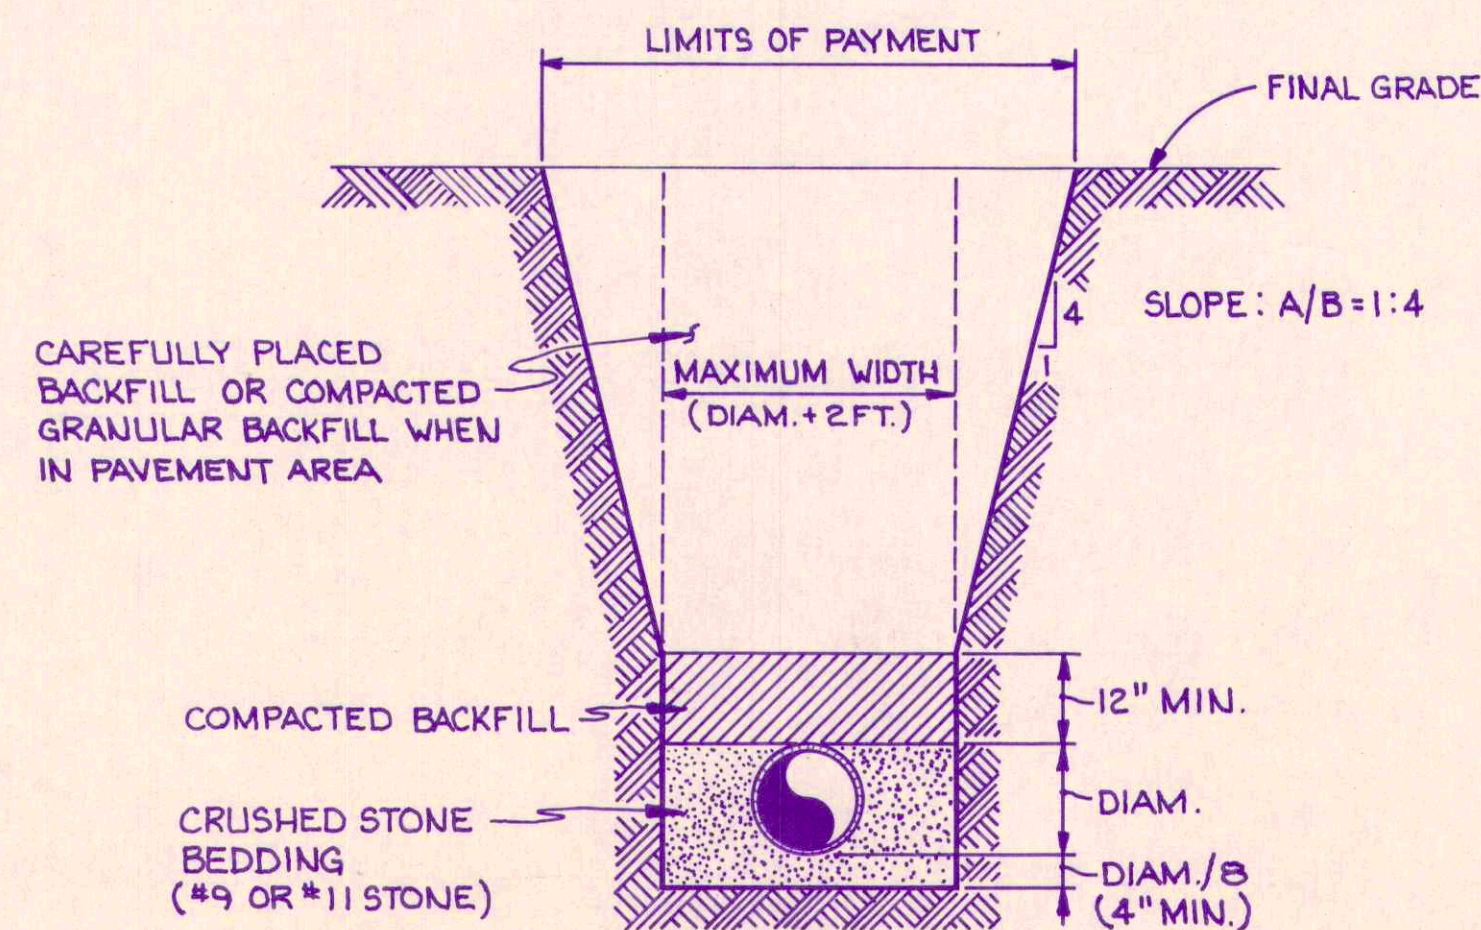

FLEXIBLE PIPE GRAVITY SEWER TYPICAL TRENCH DETAIL

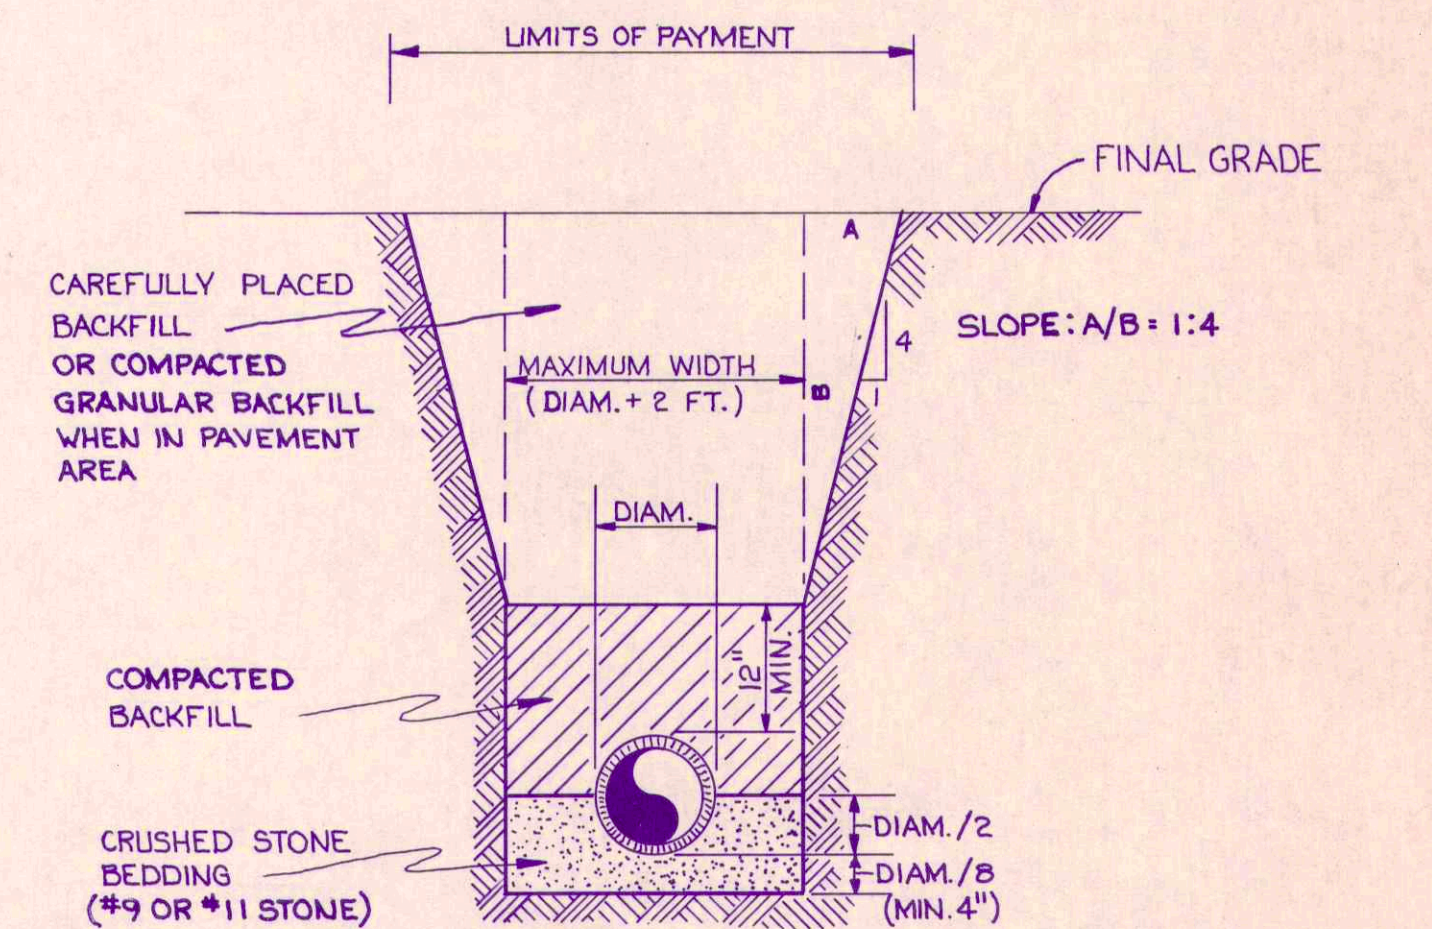

RIGID PIPE GRAVITY SEWER TYPICAL TRENCH DETAIL

RECORD DRAWING

FALL CREEK R.W.D.

JOB NO.	DATE	DR BY	CERTIFIED BY	MISC DETAILS	SHEET NO.
825	3-30-83	J.C.B.	E.R.	BEAM, LONGEST & NEFF, INC. CONSULTING ENGINEERS 8138 CASTLETON ROAD INDIANAPOLIS, INDIANA	84

