




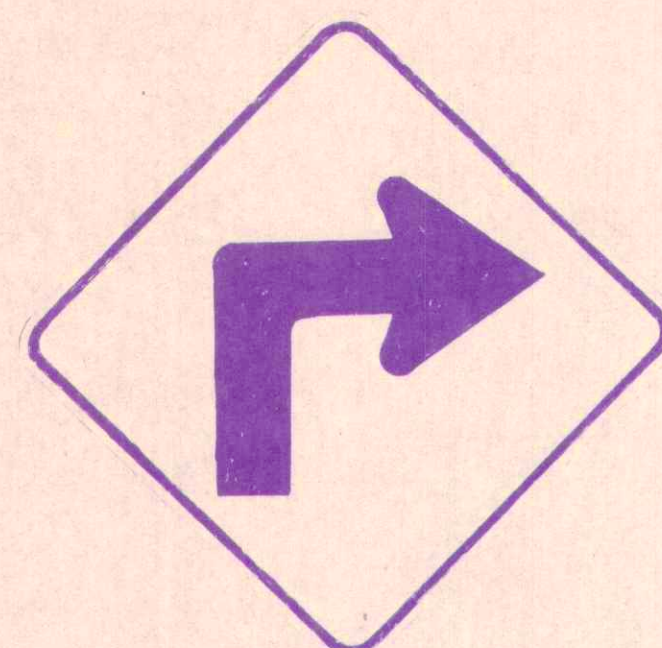


XW1-1-A(R or L)  
36" X 36"  
XW1-1-B(R or L)  
48" X 48"

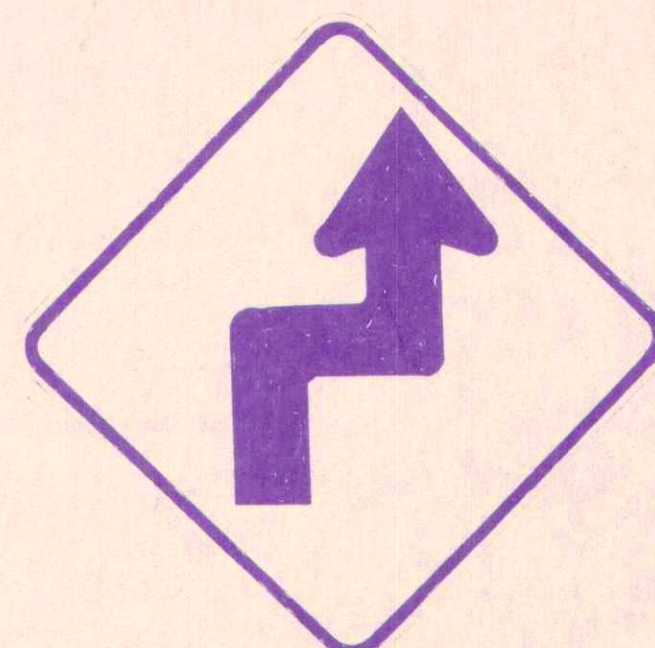


XW1-3-A(R or L)  
36" X 36"  
XW1-3-B(R or L)  
48" X 48"

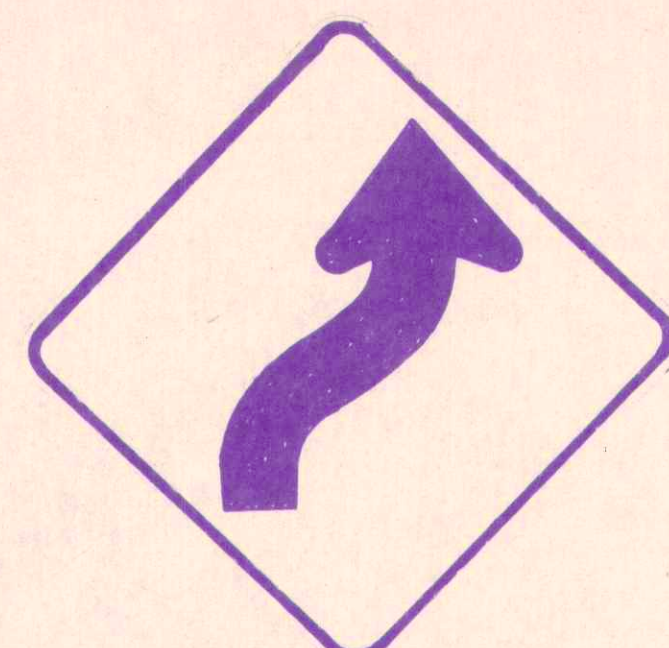

XW1-4-A(R or L)  
36" X 36"  
XW1-4-B(R or L)  
48" X 48"

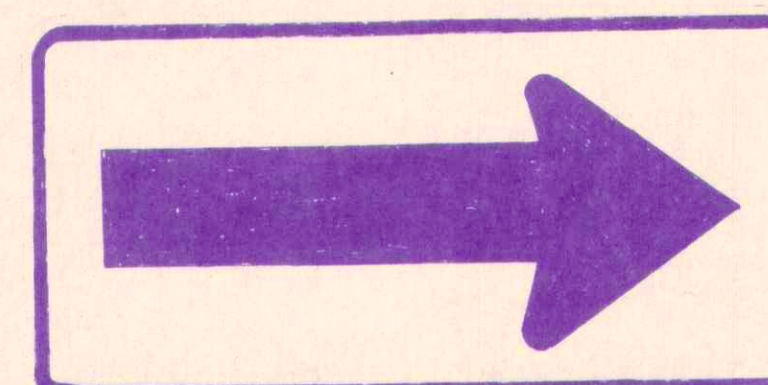


XW1-6  
48" X 24"  
XW1-6-A  
60" X 30"

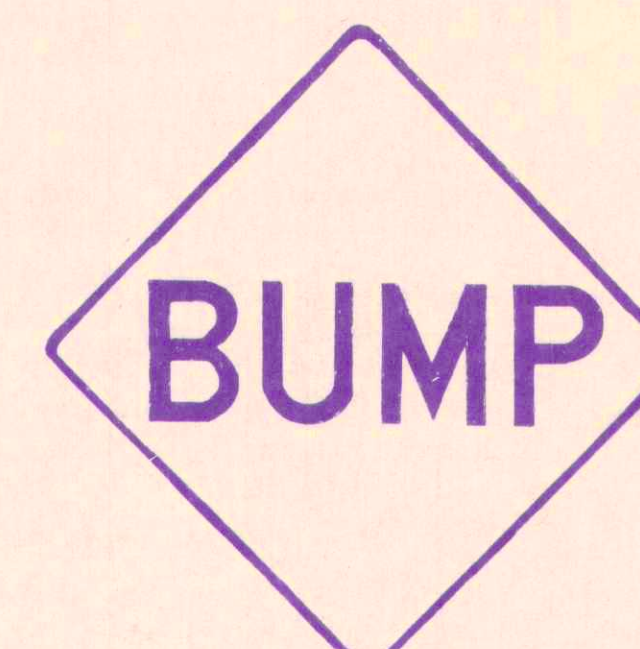

XW8-1-A  
36" X 36"  
XW8-1-B  
48" X 48"



XW8-2-A  
36" X 36"  
XW8-2-B  
48" X 48"

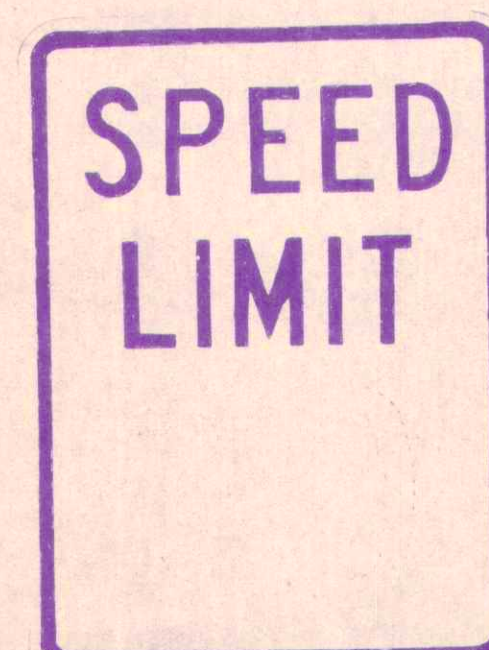


R2-1  
24" X 30"  
R2-1-A  
48" X 60"




XW6-2a-A  
36" X 36"  
XW6-2a-B  
48" X 48"




XW8-3-A  
36" X 36"

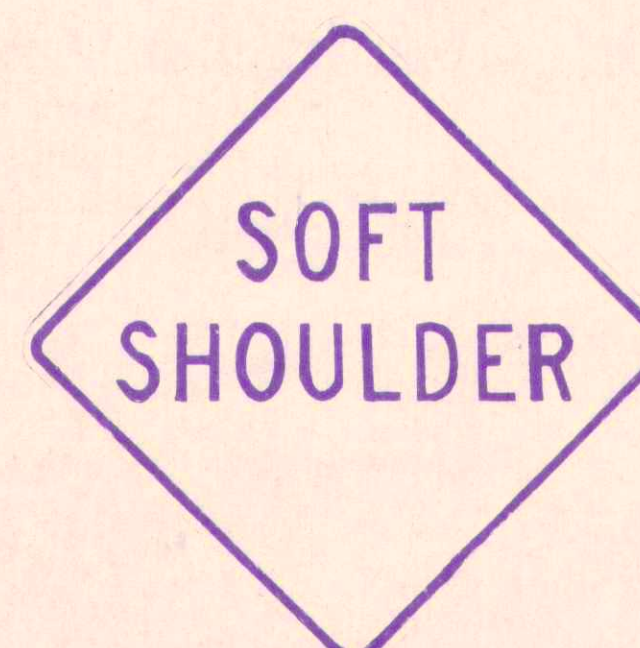


XW8-4-A  
36" X 36"  
XW8-4-B  
48" X 48"

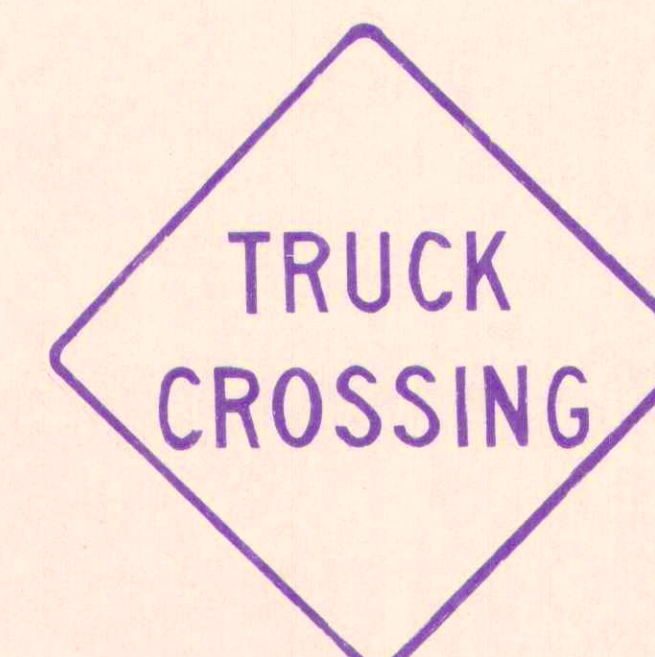

XW11-10-A  
36" X 36"  
XW11-10-B  
48" X 48"

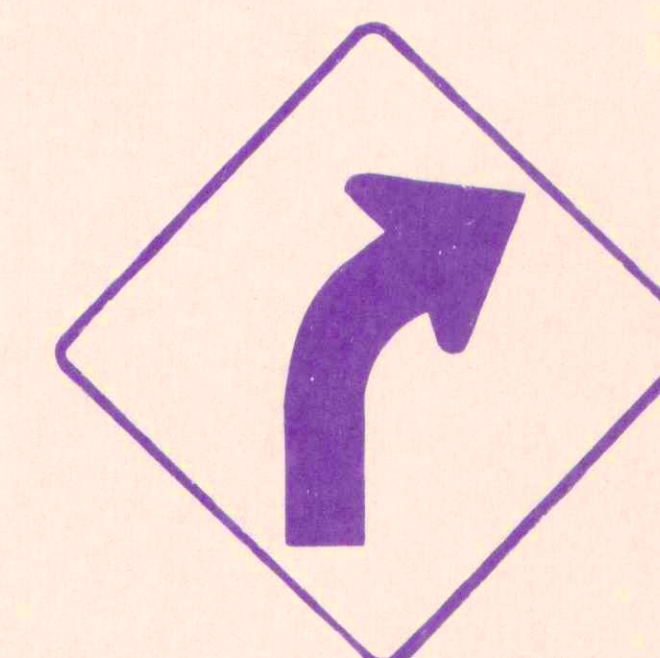


XW1-2-A(R or L)  
36" X 36"  
XW1-2-B(R or L)  
48" X 48"

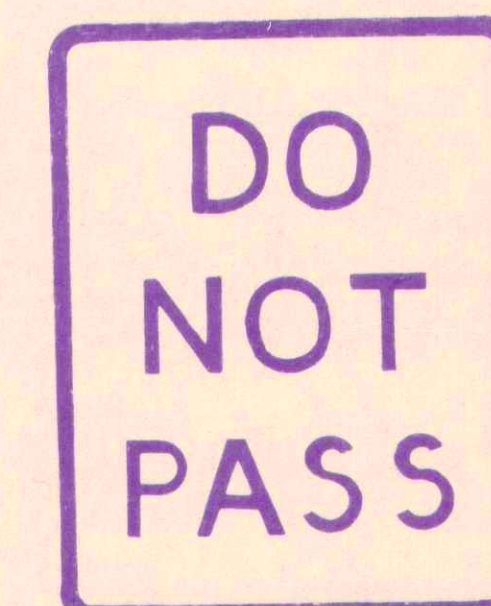


R4-1-A  
36" X 48"  
R4-1-B  
48" X 60"

LANE ENDS

|   | XW4-2 | XW4-2 A  |
|---|-------|----------|
| A | 28"   | 37 3/8"  |
| B | 4"    | 5 5/16"  |
| C | 4"    | 5 5/16"  |
| D | 1"    | 1 3/8"   |
| E | 14"   | 18 1/16" |
| F | 4"    | 5 5/16"  |
| G | 10"   | 13 5/16" |
| H | 10"   | 13 5/16" |

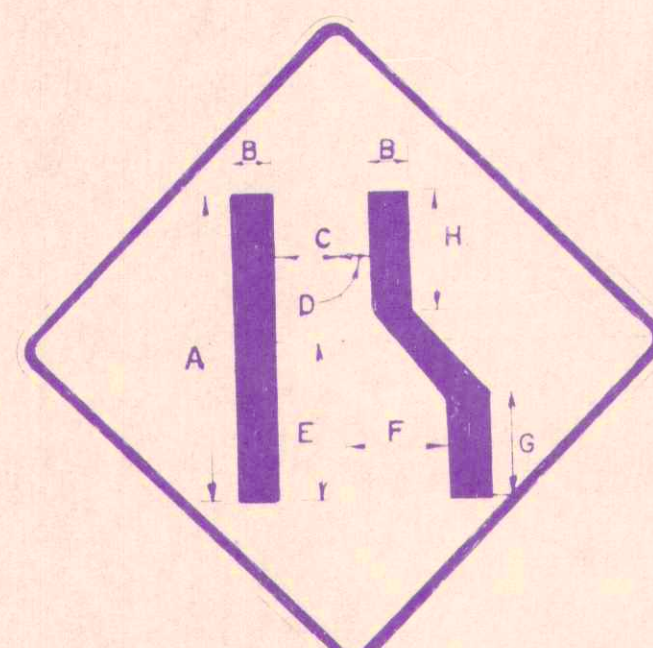

XW4-2(R or L)  
36" X 36"  
XW4-2-A(R or L)  
48" X 48"

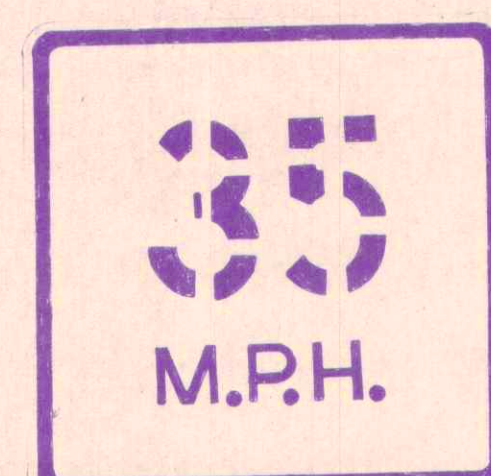

XW13-1  
18" X 18"  
XW13-1-A  
24" X 24"  
TO BE USED BELOW  
A WARNING SIGN ONLY




R6-1(R or L)  
36" X 12"  
R6-1-B(R or L)  
72" X 24"



R6-2-A(R or L)  
24" X 30"



\* R5-1  
Red Circle with white letters and  
white background  
30" X 30"  
\* R5-1-A  
36" X 36"

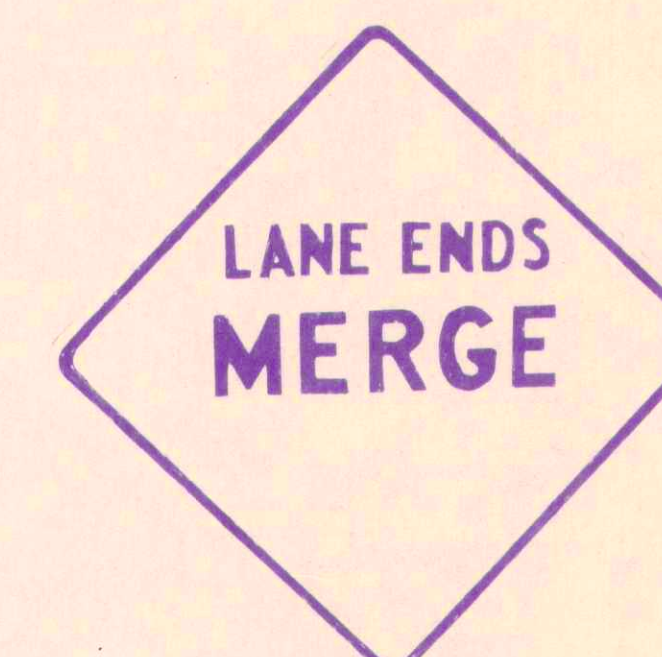

XW9-2-A(R or L)  
48" X 48"

# STANDARD DETOUR SIGNS

STATE OF INDIANA

APRIL 1972



RECOMMENDED FOR APPROVAL  
APPROVED  
APPROVED

| REVISIONS         |
|-------------------|
| 3-1-73 W-35B      |
| 4-1-73 Sign Size  |
| 6-1-74 * NOTE     |
| 6-1-74 NEW MUTCD  |
| 4-1-77 NOTES 5, 6 |
| 7-1-80 NEW MUTCD  |

SHEET  
4  
DETOUR

RECORD DRAWING Sheet No 91

SEPTEMBER 1963

65

- NOTE:
- ALL SIGNS SHALL BE MOUNTED IN SUCH A MANNER THAT THE VERTICAL DISTANCE BETWEEN THE BOTTOM OF THE SIGN AND THE EDGE OF THE PAVEMENT SHALL BE NOT LESS THAN 5 FEET AND THE HORIZONTAL DISTANCE FROM THE EDGE OF PAVEMENT TO THE EDGE OF SIGN SHALL NOT BE LESS THAN 12 FEET (R/W PERMITTING) OR 6 FEET FROM THE EDGE OF A PAVED SHOULDER.
  - ALL NOTES ON STANDARD DETOUR SIGNS SHEET (3) ALSO APPLY TO SIGNS ON THIS SHEET.
  - REFERENCE IS MADE TO "INDIANA STANDARD SPECIFICATIONS" FOR INSTALLATION AND PAYMENT PROCEDURES.
  - ALL SIGNS ARE TO BE REFLECTORIZED BY USING REFLECTIVE SHEETING, AS SPECIFIED IN "INDIANA STANDARD SPECIFICATIONS", APPLIED TO THE ENTIRE BACKGROUND AREA OF THE SIGNS. THE REFLECTIVE SHEETING SHALL BE OF THE COLOR INDICATED IN THE DESIGN DETAILS.
  - ALL SIGNS WITH ORANGE BACKGROUNDS SHALL HAVE ENCAPSULATED LENS (HIGH INTENSITY) REFLECTIVE FEDERAL ORANGE SHEETING.
  - ALL SIGNS WITH WHITE BACKGROUNDS SHALL HAVE ENCLOSED LENS REFLECTIVE SHEETING (ENGINEER GRADE.)
- \* SIGNS R5-1 AND R5-1-A TO BE HIGH INTENSITY ENCAPSULATED SHEETING.