

	CULVERT PIPE		APPROXIMATE SOLID ROCK ELEVATION—NO GUARANTEE OF ACCURACY OR ADEQUACY SEE SPECIFICATIONS
	ROAD/DRIVE RESTORATION REQUIRED		DEPTH OF SOUNDING NO ROCK ENCOUNTERED
	EXISTING BASINS & STRUCTURES TO REMAIN IN SERVICE		BENCHMARK AND NUMBER
	NEW BASINS & STRUCTURES		IRON PIPE
	NEW SIDEWALKS & CONCRETE		FIRE HYDRANT
	NEW GRAVEL/CRUSHED STONE		STORM INLET / CATCH BASIN
	NEW MANHOLE		RAILROAD SPIKE
	NEW PIPING & FLOW DIRECTION		CLEANOUT
	PIPING TO BE ABANDONED		SPECIAL BACKFILL AS SPECIFIED
	HEDGE/TREE LINE		PROPERTY LINE PIN FOUND
	STONE WALL		POST
	WALL (CONCRETE BLOCK, BRICK, ETC.)		CATV PEDESTAL
	DRAIN AND DIRECTION OF FLOW		ROADWAY SIGN
	ROAD W/ CONC. PAVING		SEPTIC CLEANOUT
	ROAD W/ ASPHALT PAVING		RIGHT OF WAY MARKER
	GUY WIRE & ANCHOR		WATER METER
	FENCE W/GATE (NEW)		MAILBOX
	FENCE W/GATE (EXISTING)		POWER POLE
	APPARENT PROPERTY LINE		LIGHT POLE
	FINISHED SPOT ELEVATION		YARD HYDRANT
	EXISTING SPOT ELEVATION		CONTROL POINT
	FINAL GRADE		MANHOLE
	EXISTING GRADE		TREE (CONIFEROUS)
	UNDERGROUND ELECTRIC		TREE (DECIDUOUS)
	RAILROAD		EDGE OF PAVEMENT
	EXIST. STORM SEWER MAIN		TELEPHONE PEDESTAL
	EXIST. SANITARY SEWER		WELL
	GAS MAIN		SOIL BORING AND NUMBER
	WATER MAIN		STUMP
	TELEPHONE LINE		GAS MARKER
	EXIST. PIPING TO REMAIN IN SERVICE		GAS METER
	GUARDRAIL		VALVE
	FIBER OPTIC COMMUNICATIONS CABLE		SIDEWALK
	FENCE LINE		AIR RELEASE VALVE
	EDGE OF PAVEMENT		
	RIGHT OF WAY		
	CENTERLINE		

INDIANA GAS COMPANY  
2001 LOUISE STREET  
ANDERSON, IN. 46016  
CONTACT: MR. MIKE JOHNSON  
TEL. (317)-592-4500

TCI CABLE  
335 EAST 10TH STREET  
ANDERSON, IN. 46016  
CONTACT: MR. ROCKEY BENNETT  
(765)-649-5228

CENTRAL INDIANA POWER  
2243 EAST MAIN ST.  
GREENFIELD, IN. 46140  
CONTACT: MR. GARY SARGENT

SPRINT  
50 NORTH JACKSON ST.  
FRANKLIN, IN. 46131  
CONTACT: MS. NANCY PICKEREL  
(317)-736-5309

1. THE FOLLOWING GENERAL NOTES ARE APPLICABLE TO THE ENTIRE SET OF PLANS, AND ARE NOT SHOWN ON EACH INDIVIDUAL SHEET. HOWEVER, THE CONTRACTOR OF ANY RESPONSIBILITY TO PROVIDE THESE ITEMS FOR ALL AREAS.
2. THE DISTRICT ASSUMES NO RESPONSIBILITY FOR THE LACK OF LOCATION OR MISSED LOCATION OF EXISTING UTILITIES.
3. THE CONTRACTOR SHOULD VERIFY THE EXISTING CONDITIONS TO HIS SATISFACTION PRIOR TO BEGINNING ANY EXCAVATION. INDIANA UNDERGROUND UTILITIES PROTECTION SERVICE SHALL BE NOTIFIED AT LEAST 72 HOURS PRIOR TO BEGINNING ANY WORK. INDIANA UNDERGROUND UTILITIES PROTECTION SERVICE TELEPHONE IS 1-800-382-5544
4. ALL DISTURBED AREAS, INCLUDING BUT NOT LIMITED TO STREETS, DRIVES, WALKS, FENCES, LAWNS, ETC. SHALL BE RESTORED TO CONDITIONS EQUAL TO OR BETTER THAN THOSE PRIOR TO CONSTRUCTION.
5. ALL MANHOLE RIM ELEVATIONS ARE APPROXIMATE. RIMS SHALL BE SET FLUSH WITH GRADE UNLESS OTHERWISE NOTED.
6. THE CONTRACTOR SHALL MAINTAIN A MINIMUM OF 10' HORIZONTAL SEPARATION BETWEEN THE PROPOSED SEWER AND EXISTING WATER LINES. CROSSING SHALL MAINTAIN A MINIMUM OF 18" VERTICAL CLEARANCE WITH THE SEWER BELOW THE WATER LINE WHEN POSSIBLE.
7. ALL AIR RELEASE STRUCTURES LOCATIONS INDICATED ON THE PLANS ARE SHOWN AS APPROXIMATE LOCATIONS AND THE EXACT LOCATIONS WILL BE DETERMINED IN THE FIELD BY THE CONTRACTOR AND APPROVED BY THE ENGINEER.
8. STREET LINES AND PROPERTY LINES SHOWN ON THIS PLAN ARE NOT THE RESULT OF DEED RESEARCH AND ARE TO BE CONSIDERED APPROXIMATE AND FOR REFERENCE ONLY.
9. BASELINE STATIONING IS ALONG THE CENTERLINE OF PROPOSED SEWER.
10. ALL EXISTING SIZES AND INVERTS OF EXISTING UTILITIES ARE BASED ON BEST INFORMATION AVAILABLE. HOWEVER, THE ENGINEER DOES NOT GUARANTEE OR ASSURE THAT SUCH INFORMATION IS TRUE OR APPROXIMATE. THE CONTRACTOR SHALL DETERMINE WHICH UTILITIES MAY CONFLICT WITH HIS WORK AND VERIFY THEIR LOCATIONS, SIZES, AND INVERTS, ETC. ADJUST HIS WORK ACCORDINGLY, AND NOTIFY THE ENGINEER OF ANY SUCH CONFLICT. THE CONTRACTOR SHALL REFER TO SPECIFICATIONS RELATIVE TO THE ABOVE.
11. ALL INFORMATION REGARDING HORIZONTAL AND VERTICAL CONTROL ARE BASED ON BEST INFORMATION AVAILABLE UTILIZING RECORD DRAWINGS OF THE SITE. THE ENGINEER DOES NOT GUARANTEE OR ASSURE THAT SUCH INFORMATION IS TRUE. THE CONTRACTOR SHALL DETERMINE WHICH CONTROLS CONFLICT WITH HIS WORK AND VERIFY THOSE ELEVATIONS, ETC. AND ADJUST HIS WORK ACCORDINGLY TO MAINTAIN PROPOSED ELEVATIONS RELATIVE TO THOSE VERIFIED, AND NOTIFY THE ENGINEER OF ANY SUCH CHANGE FOR APPROVAL.
12. THE ENGINEER SHALL BE NOTIFIED OF ANY FIELD TILES FOUND DURING CONSTRUCTION OPERATIONS. ANY SUCH TILE THAT IS DAMAGED SHALL BE REPAIRED AT CONTRACTORS EXPENSE.
13. ALL UTILITY LOCATIONS ARE APPROXIMATE. IT IS THE CONTRACTOR'S RESPONSIBILITY TO CONTACT ALL AFFECTED UTILITIES AND LOCAL UTILITIES PROTECTION SERVICE PRIOR TO EXCAVATION (SEE NOTE 3).
14. THE CONTRACTOR IS RESPONSIBLE FOR RELOCATING, ADJUSTING, AND/OR HOLDING ANY UTILITY LINE AND/OR ASSOCIATED SERVICE POLE, OR DOWN GUY AT HIS OWN EXPENSE. HE SHALL ALSO BE RESPONSIBLE TO CONTACT ANY UTILITY OWNER AS NECESSARY TO RESOLVE ALL UTILITY CONFLICTS INCURRED DURING THE COMPLETION OF HIS CONSTRUCTION OPERATIONS.
15. CONTRACTOR SHALL USE CAUTION IN THE INSTALLATION OF NEW EQUIPMENT SO AS TO NOT DAMAGE EXISTING UTILITIES, ETC. CONTRACTOR IS RESPONSIBLE FOR REPAIR AND/OR REPLACEMENT OF ANY EQUIPMENT OR UTILITIES DAMAGED AS A RESULT OF CONTRACTOR'S CONSTRUCTION OPERATIONS AND PRACTICES.
16. CONNECTIONS OF ROOF DRAINS, FOUNDATION DRAINS AND ANY OTHER CLEAN WATER CONNECTIONS TO THE SANITARY SEWER SYSTEMS ARE PROHIBITED.
17. THE CONTRACTOR IS RESPONSIBLE FOR ENSURING CONTINUED OPERATION OF THE EXISTING SEPTIC SYSTEMS DURING CONSTRUCTION.
18. LIMITS OF CONSTRUCTION SHALL BE MAINTAINED WITHIN PERMANENT AND TEMPORARY EASEMENTS AS SHOWN ON PLANS.
19. TAKE PRECAUTION AS NECESSARY TO PREVENT DAMAGE TO ANY EXISTING TREES AND THEIR ROOT SYSTEMS. IF NECESSARY, BORE UNDER ROOT SYSTEM TO PREVENT POSSIBLE FUTURE DAMAGE TO TREE GROWTH AND SURVIVAL.
20. CONTRACTOR SHALL COORDINATE BYPASS PUMPING EFFORTS WITH FALL CREEK REGIONAL WASTE DISTRICT.

1. CONTROL POINT 1000: CHISELED "X" IN NORTHSIDE OF WETWELL ON SOUTHSIDE OF REFORMATORY RD. EL. 849.27
2. TBM#1: MAG NAIL 1' UP IN UTILITY POLE ON THE NORTHEAST CORNER OF REFORMATORY RD. AND COUNTY ROAD 650 WEST. EL 864.48


**RECORD DRAWING**

This drawing has been revised from the original contract drawings to show minor / major changes made during construction. This drawing is not warranted to be complete and accurate in all respects.

GRW Engineers, Inc.


Date: 5/10/02 By: JPT

CALL TWO WORKING DAYS  
BEFORE YOU DIG  
IT'S THE LAW  
1-800-382-5544

	AS-BUILT REVISION	MAY 2006	SM
NO.	DESCRIPTION	DATE	BY
<b>REVISIONS</b>			

INDEX/GENERAL NOTES

GRW PROJECT NO. 3290

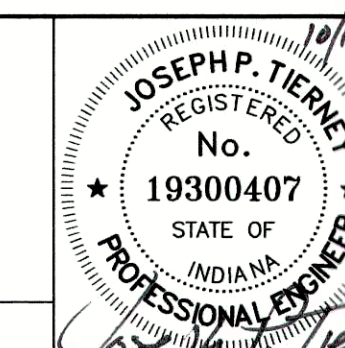

**GRW Engineers, Inc.**  
Engineers, Architects, Planners

INDIANAPOLIS, INDIANA  
LOUISVILLE & LEXINGTON, KENTUCKY  
CINCINNATI, OHIO  
NASHVILLE, TENNESSEE  
ARLINGTON, TEXAS

DRAWN: BJD	DATE: OCTOBER 2005
FILE NAME: 3290_C-02.dwg	SCALE: AS SHOWN
CHECKED: JPT	SHEET NO.  C-02
APPROVED: JPT	