


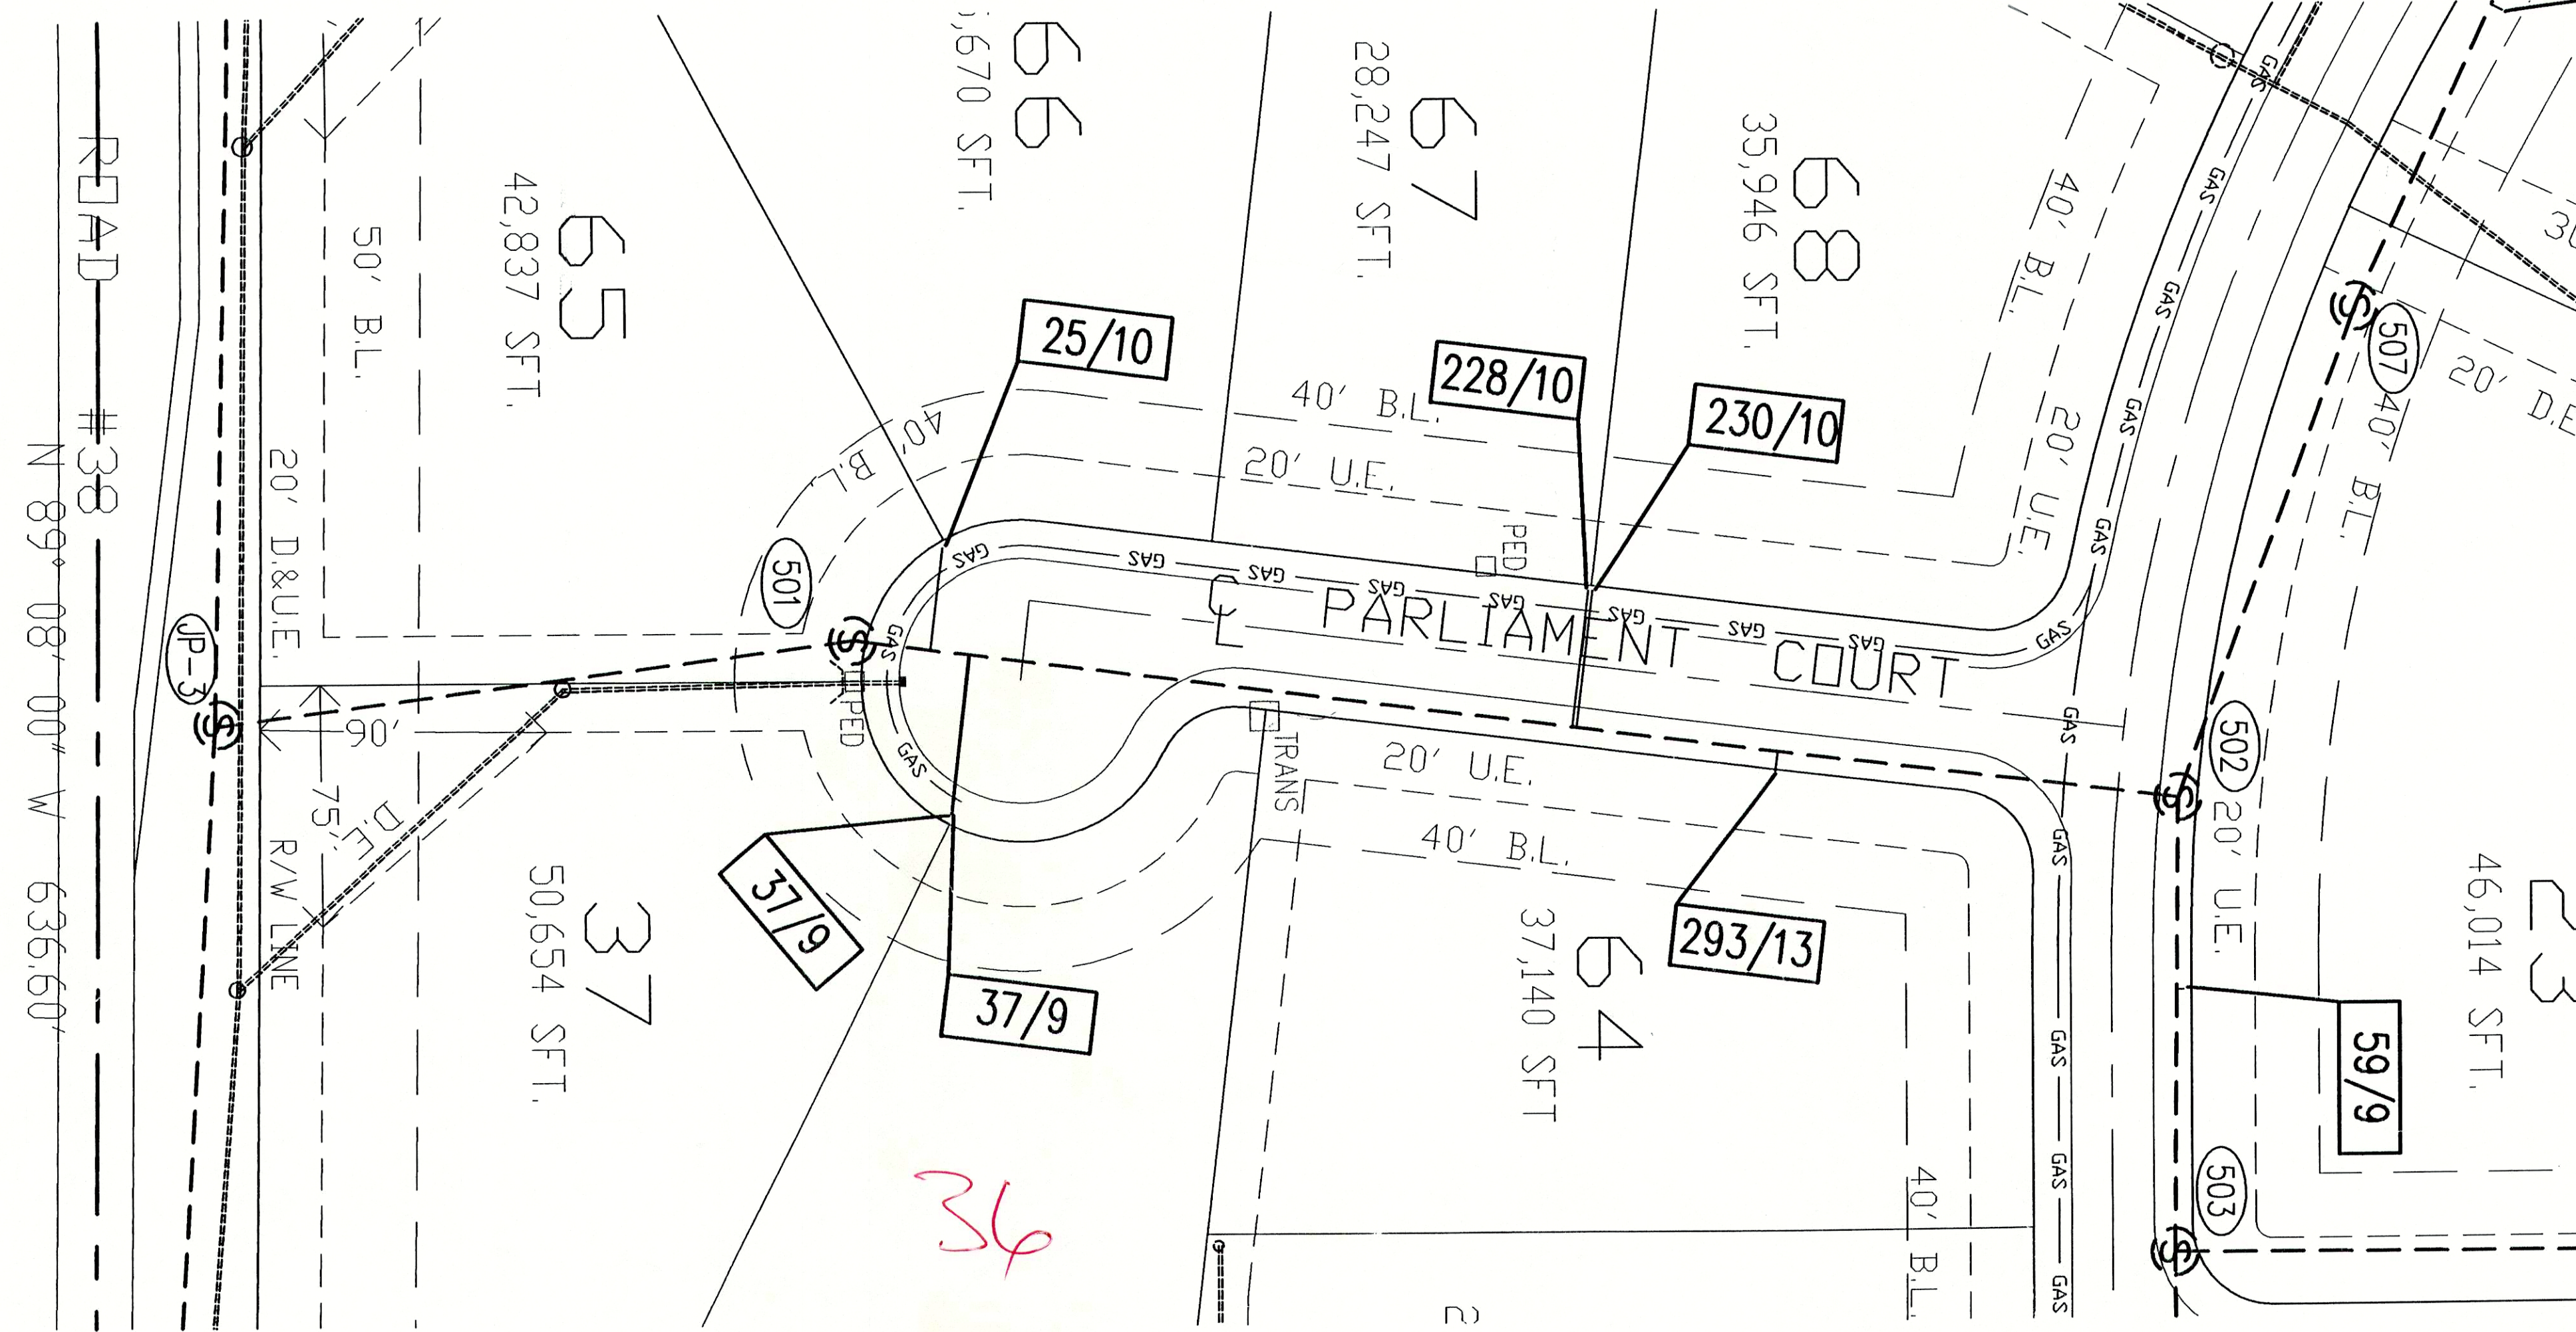

N

SCALE: HOR. 1" = 40'
VER. 1" = 4'


LEGEND

- PROPOSED SANITARY SEWER
- EXISTING STORM SEWER
- GRANULAR BACKFILL REQUIRED IF OPEN CUT

TBM #1 - RAILROAD SPIKE IN EAST SIDE OF POWER POLE #077930 AT SOUTHWEST QUADRANT OF S.R. 38 AND COUNTY ROAD 600 WEST. ELEV. 864.74

AS-BUILT DRAWING

F.B. 138, PGS. 102-125
F.B. 160, PGS. 46-49

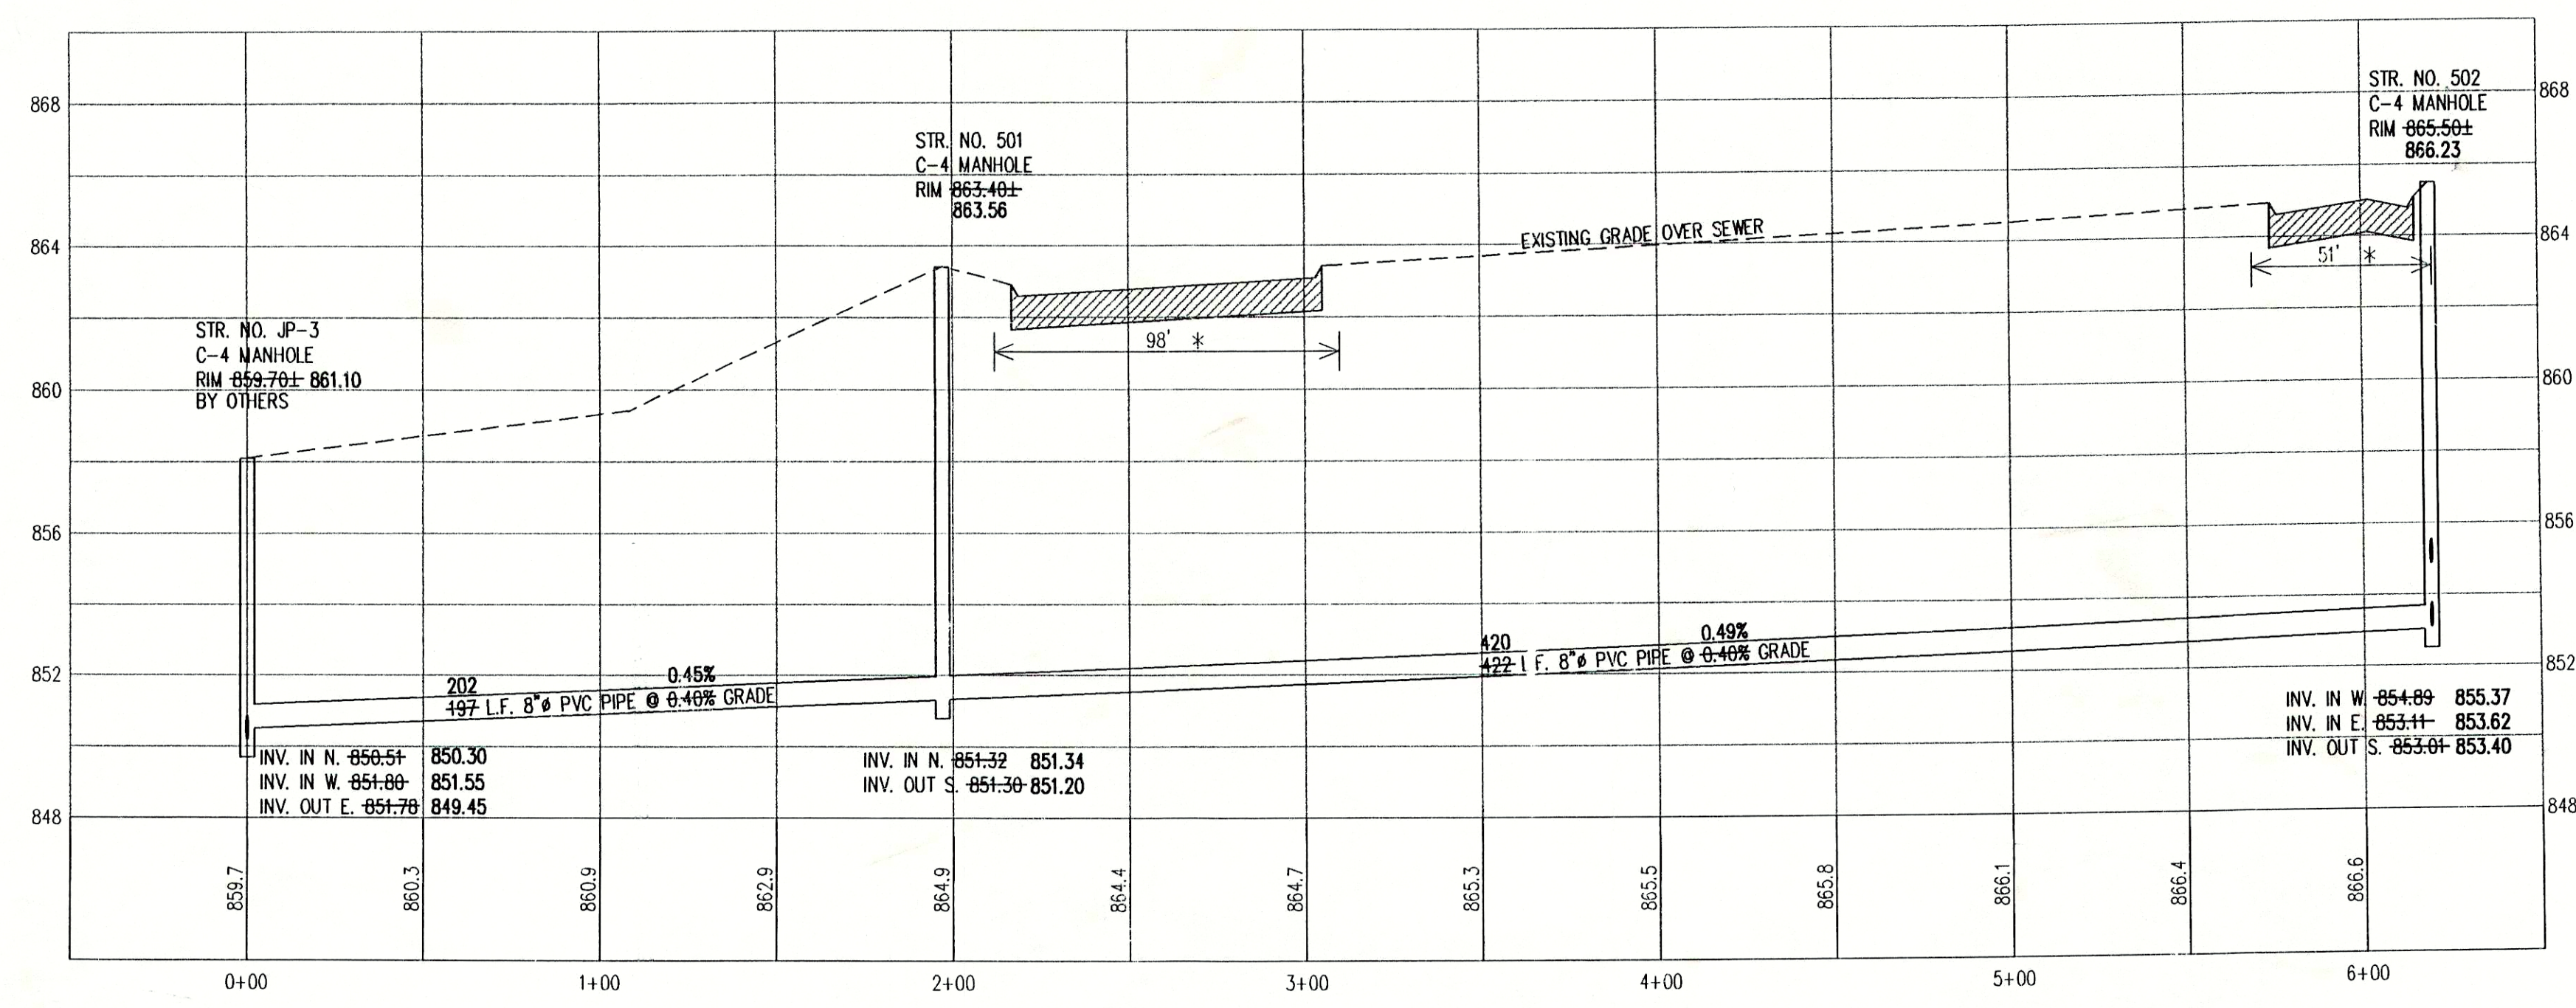

GENERAL NOTES:

- ALL STATIONING IS FROM THE NEAREST DOWNSTREAM MANHOLE (M.H.)
- ALL PIPE LENGTHS ARE FROM THE CENTER OF STRUCTURE TO CENTER OF STRUCTURE.
- LATERALS FIELD MARKED WITH 2"x4" 'S' PAINTED GREEN. NONE FOUND ON LOTS 25, 27, & 65.

AS-BUILT SANITARY LATERALS

214/14

DISTANCE FROM DOWNSTREAM MANHOLE

DISTANCE FROM BACK OF CURB

1940 E. 59RD STREET
ANDERSON, INDIANA 46013
PH. (765) 643-5614
FAX (765) 643-1874

RAYL
SURVEYING & ENGINEERING, INC.

AS-BUILT SANITARY SEWER PLAN & PROFILE

REVISIONS:

**JEFFERSON PLACE
GREEN TOWNSHIP
MADISON COUNTY, INDIANA**

DRAWN BY: J. ANDERSON DATE: 5-9-00

BY: *Bradley A. Rayl*

DATE: 5-9-00

SHEET

1 OF 6

F:\SDSK\PROJ\658\DWG\AB-SAN1.DWG