


**AS-BUILT SANITARY SEWER
PLAN & PROFILE**

REVISIONS:

**JEFFERSON PLACE
GREEN TOWNSHIP
MADISON COUNTY, INDIANA**


DRAWN BY: J. ANDERSON DATE: 5-9-00

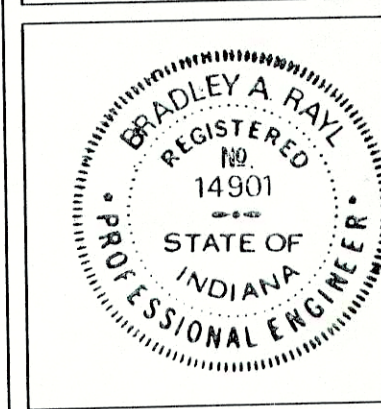

By: *Bradley A. Rayl*
DATE: 5-9-00

SHEET

2 OF 6

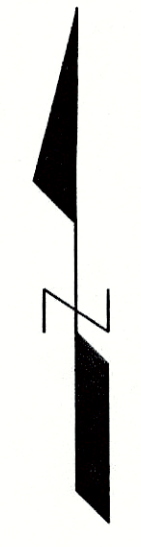

SCALE: HOR. 1" = 40'
VER. 1" = 4'

LEGEND

- PROPOSED SANITARY SEWER
- EXISTING STORM SEWER
- GRANULAR BACKFILL REQUIRED IF OPEN CUT

TBM #1 - RAILROAD SPIKE IN EAST SIDE OF POWER POLE #077930 AT SOUTHWEST QUADRANT OF S.R. 38 AND COUNTY ROAD 600 WEST. ELEV. 864.74

GENERAL NOTES:

- ALL STATIONING IS FROM THE NEAREST DOWNSTREAM MANHOLE (M.H.)
- ALL PIPE LENGTHS ARE FROM THE CENTER OF STRUCTURE TO CENTER OF STRUCTURE.
- LATERALS FIELD MARKED WITH 2"x4" 'S PAINTED GREEN. NONE FOUND ON LOTS 25, 27, & 65.

AS-BUILT SANITARY LATERALS

DISTANCE FROM DOWNSTREAM MANHOLE

DISTANCE FROM BACK OF CURB

**AS-BUILT
DRAWING**

F.B. 138, P.G.S. 102-125
F.B. 160, P.G.S. 46-49

