


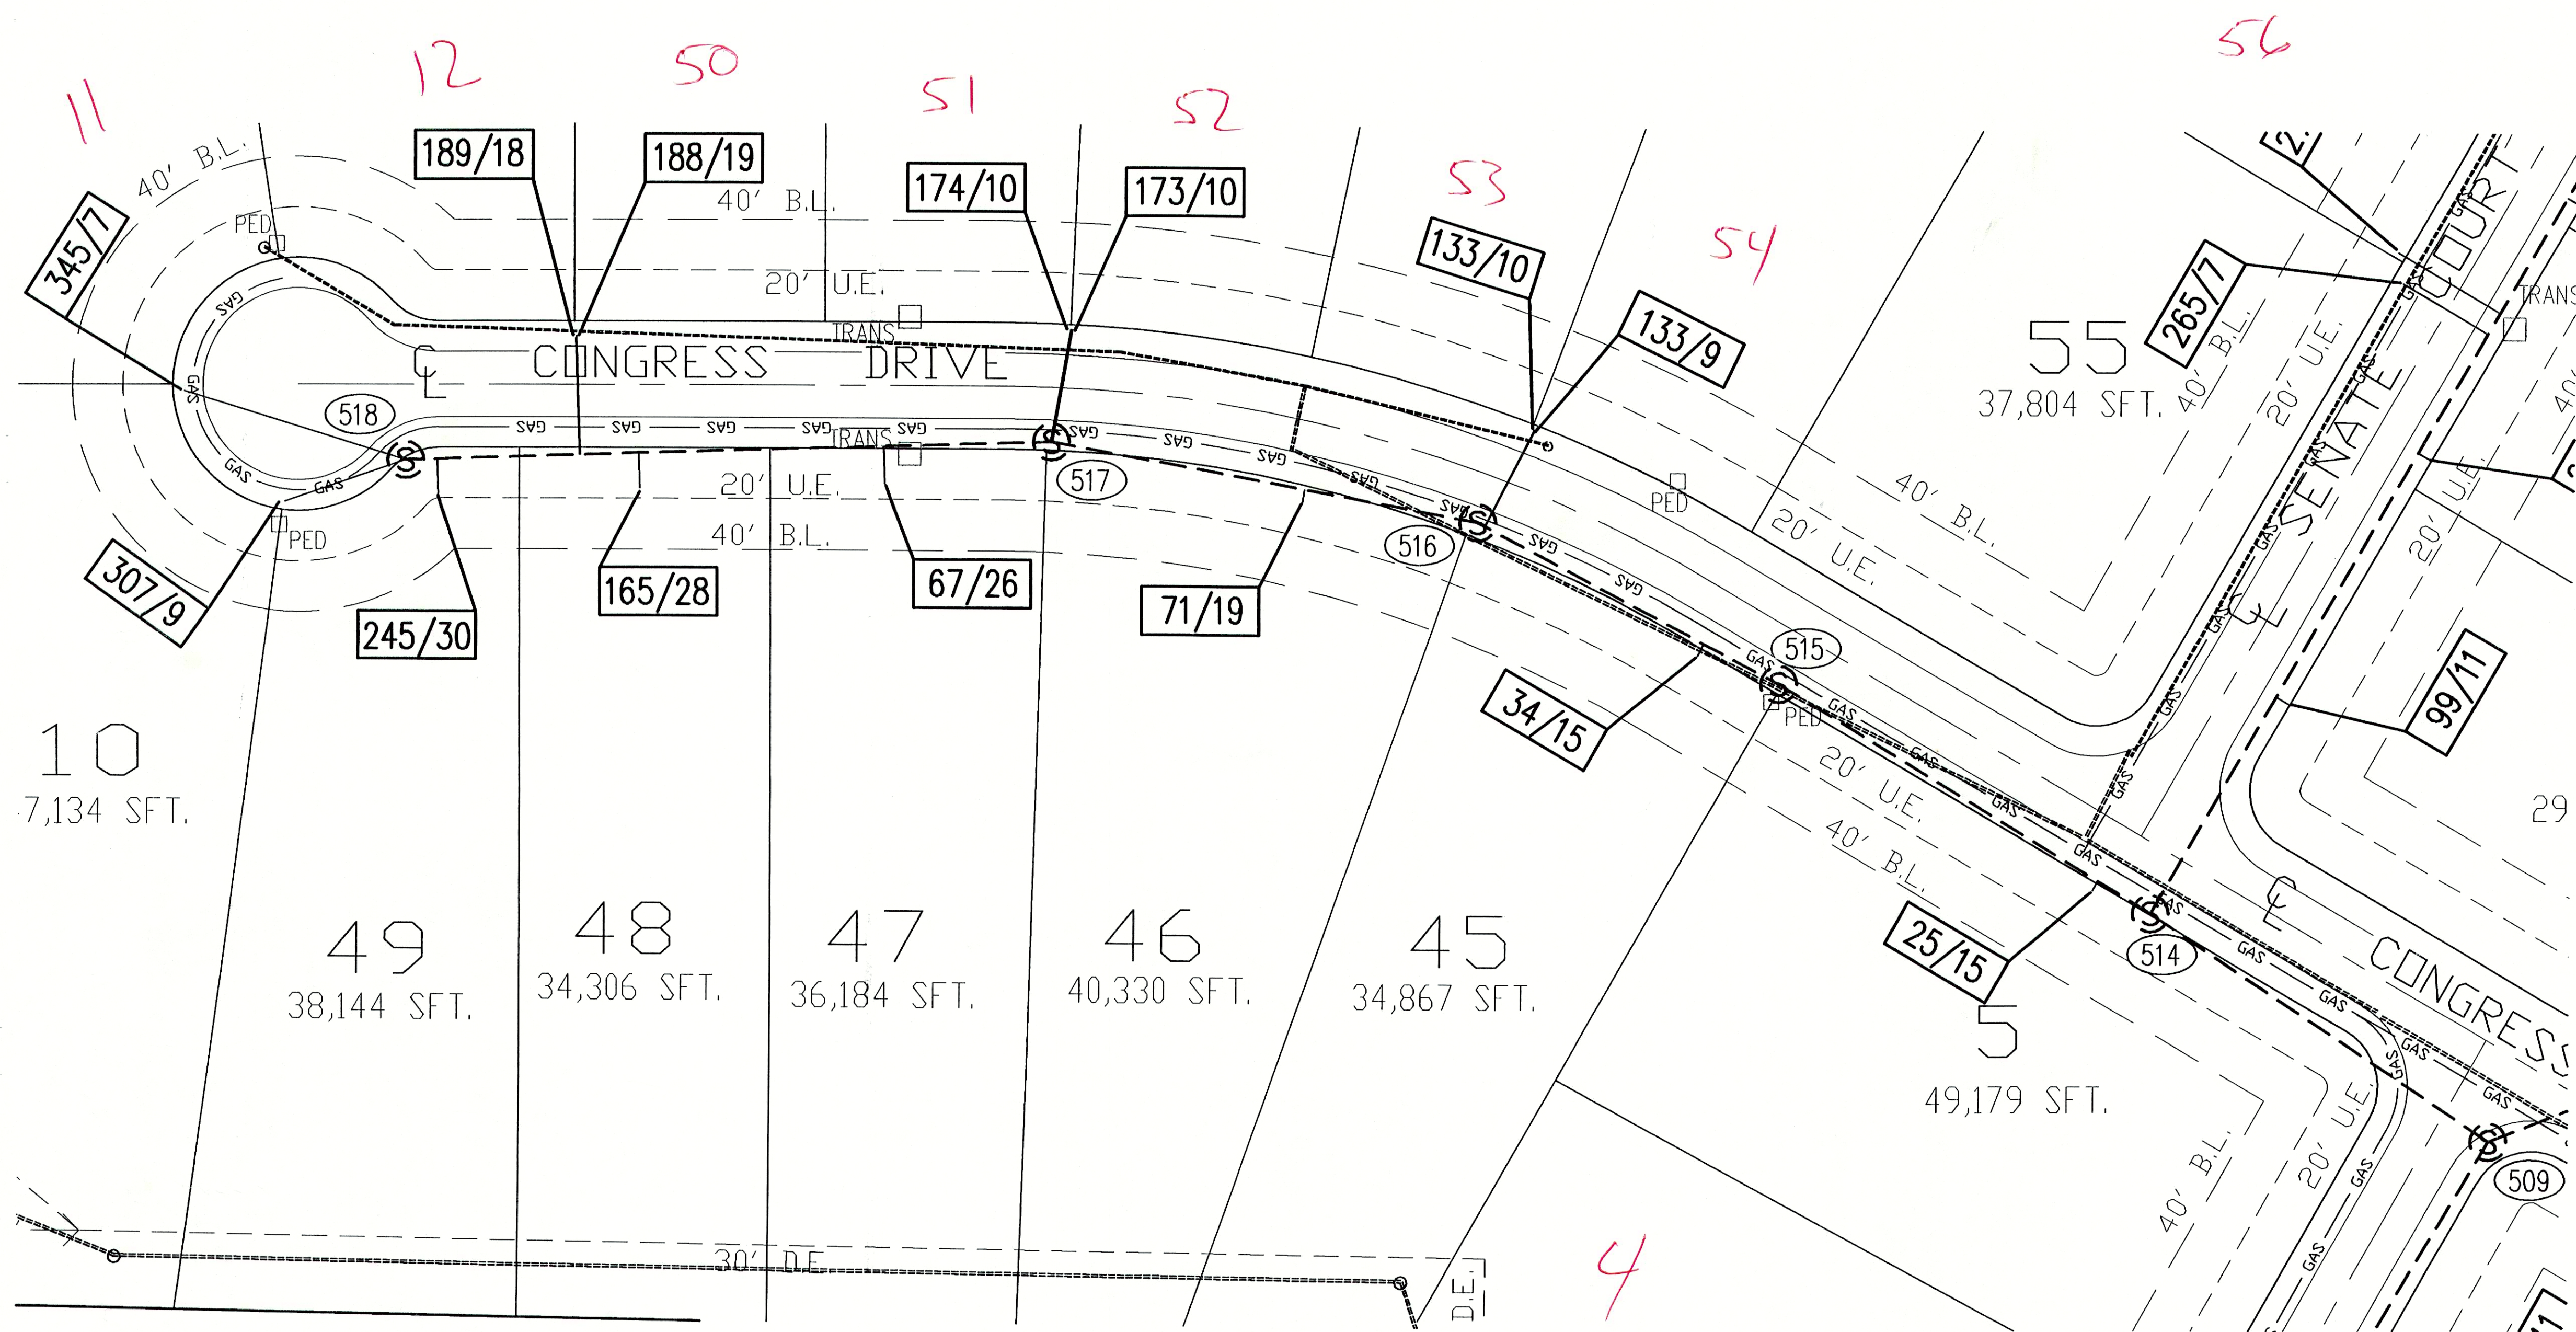

SCALE: HOR. 1" = 40'
VER. 1" = 4'

LEGEND

- S --- PROPOSED SANITARY SEWER
- O --- EXISTING STORM SEWER
- * GRANULAR BACKFILL REQUIRED IF OPEN CUT


TBM #1 - RAILROAD SPIKE IN EAST SIDE OF POWER POLE #077930 AT SOUTHWEST QUADRANT OF S.R. 38 AND COUNTY ROAD 600 WEST. ELEV. 864.74

GENERAL NOTES:

- ALL STATIONING IS FROM THE NEAREST DOWNSTREAM MANHOLE (M.H.).
- ALL PIPE LENGTHS ARE FROM THE CENTER OF STRUCTURE TO CENTER OF STRUCTURE.
- LATERALS FIELD MARKED WITH 2"x4" 'S' PAINTED GREEN. NONE FOUND ON LOTS 25, 27, & 65.


AS-BUILT SANITARY LATERALS

DISTANCE FROM DOWNSTREAM MANHOLE
DISTANCE FROM BACK OF CURB

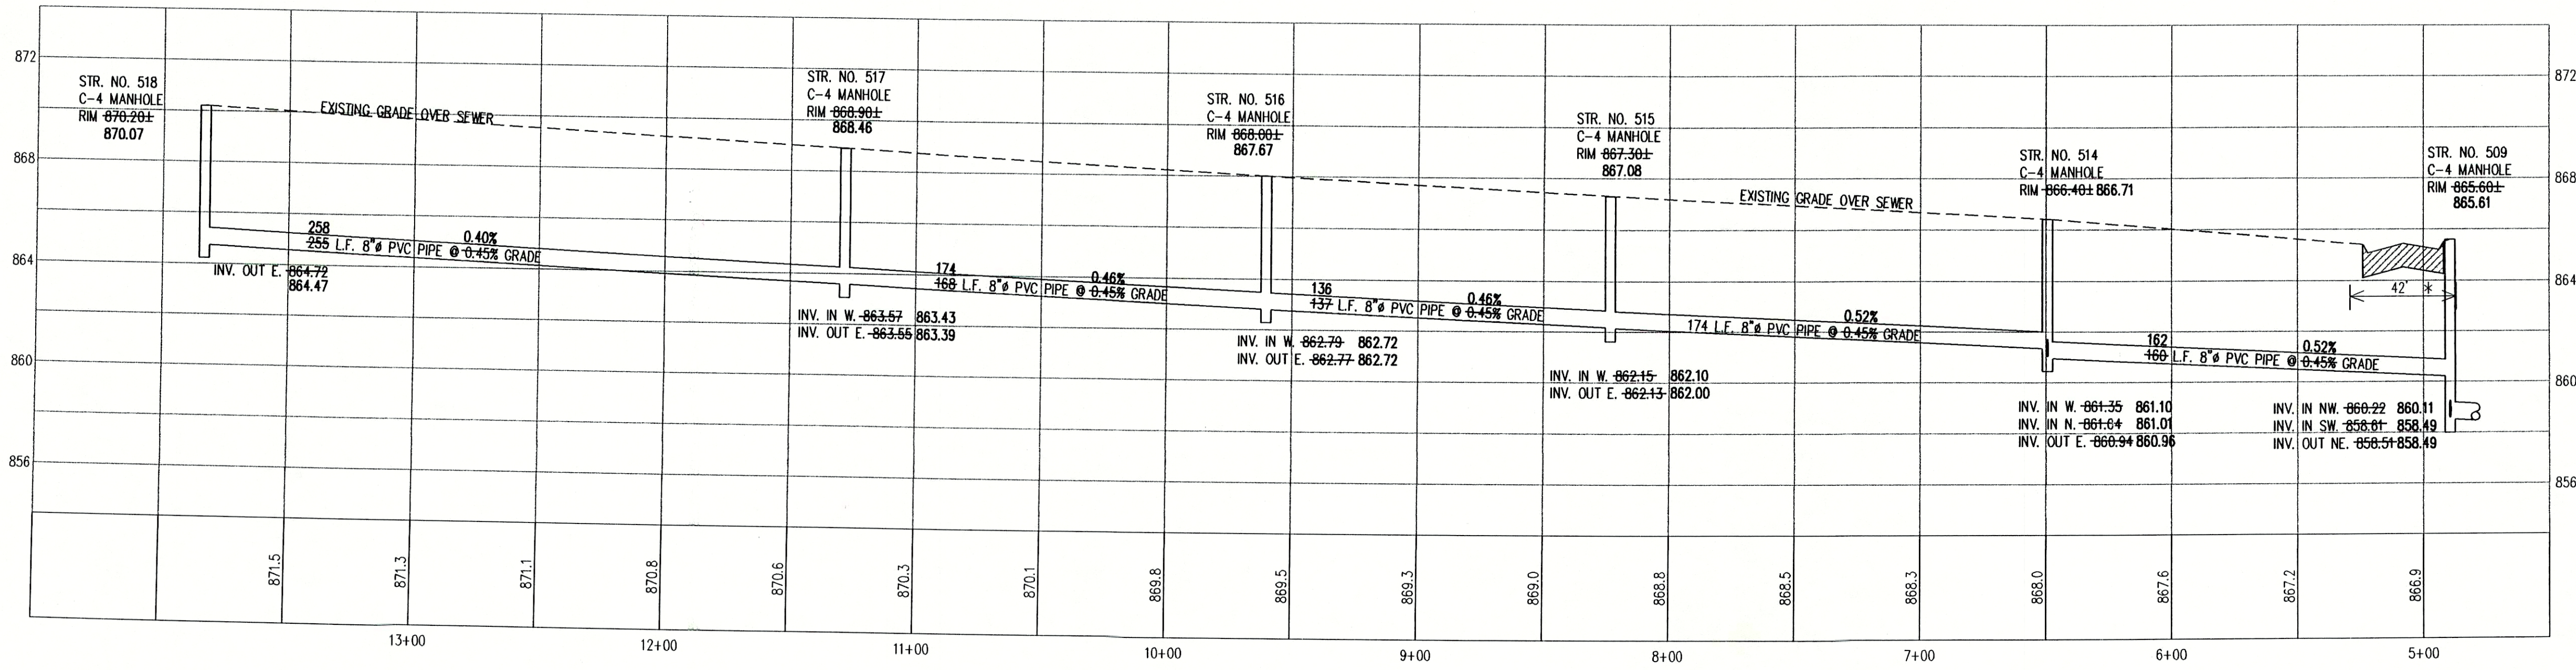

AS-BUILT SANITARY SEWER
PLAN & PROFILE

JEFFERSON PLACE
GREEN TOWNSHIP
MADISON COUNTY, INDIANA

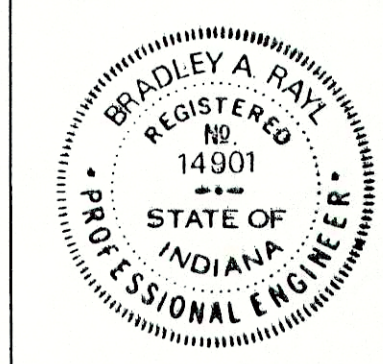

BY: *Bradley A. Rayl*
DATE: 5-9-00

SHEET

3 OF 6

1940 E. 53RD STREET
ANDERSON, INDIANA 46013
PH. (765) 643-5614
FAX (765) 643-1674

RAYL
SURVEYING
&
ENGINEERING, INC.

REVISIONS:

DATE: 5-9-00

DRAWN BY: J. ANDERSON