

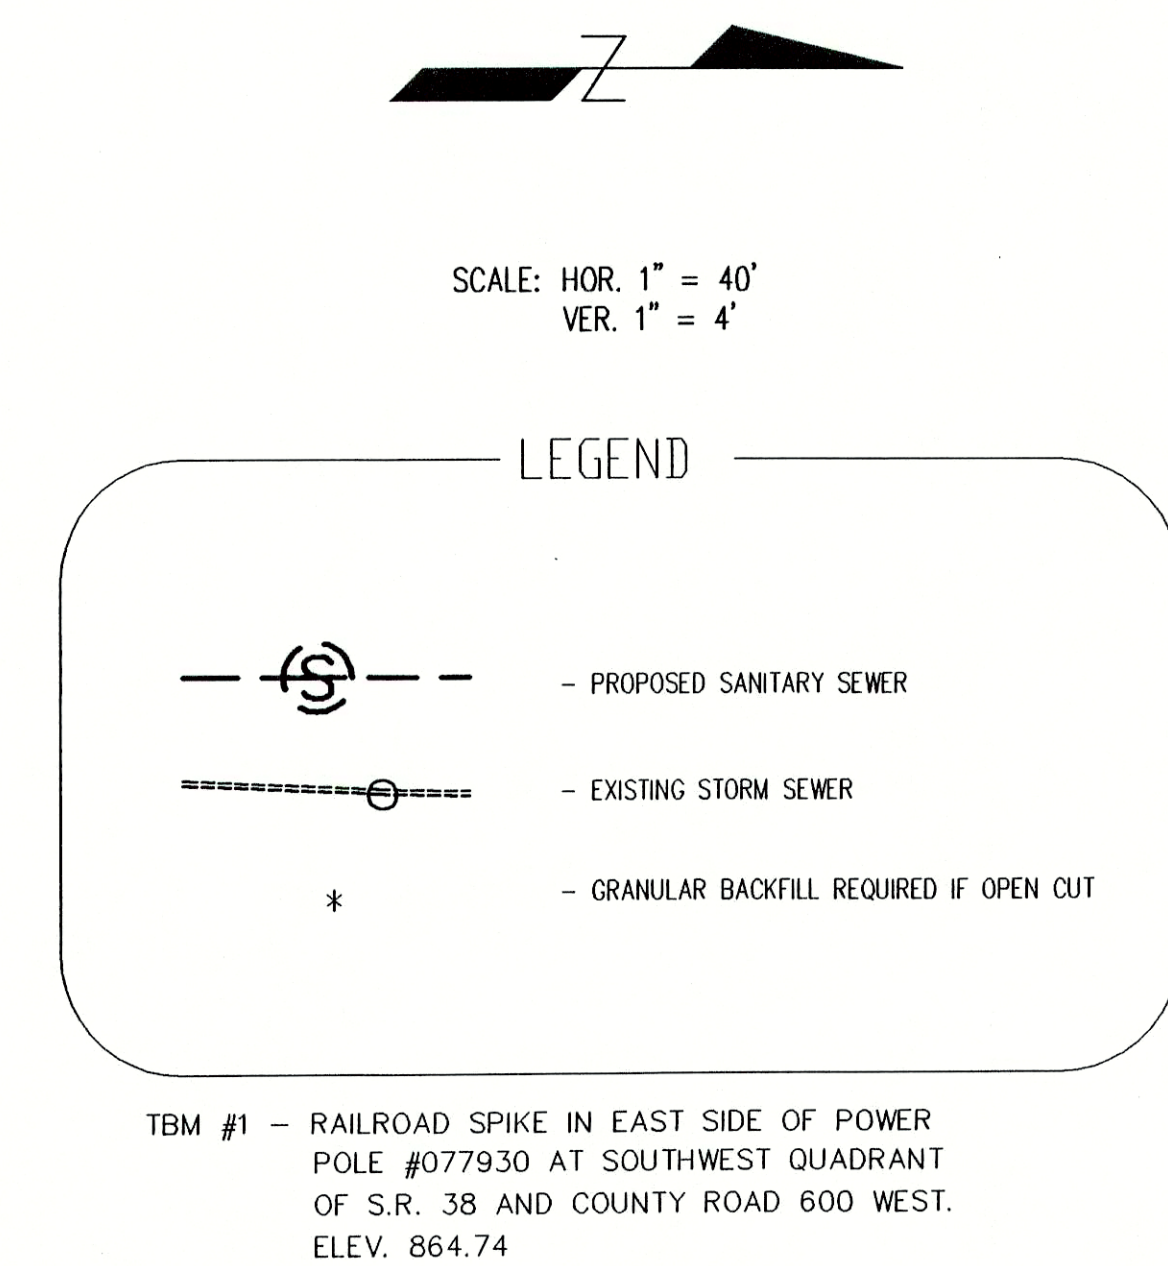


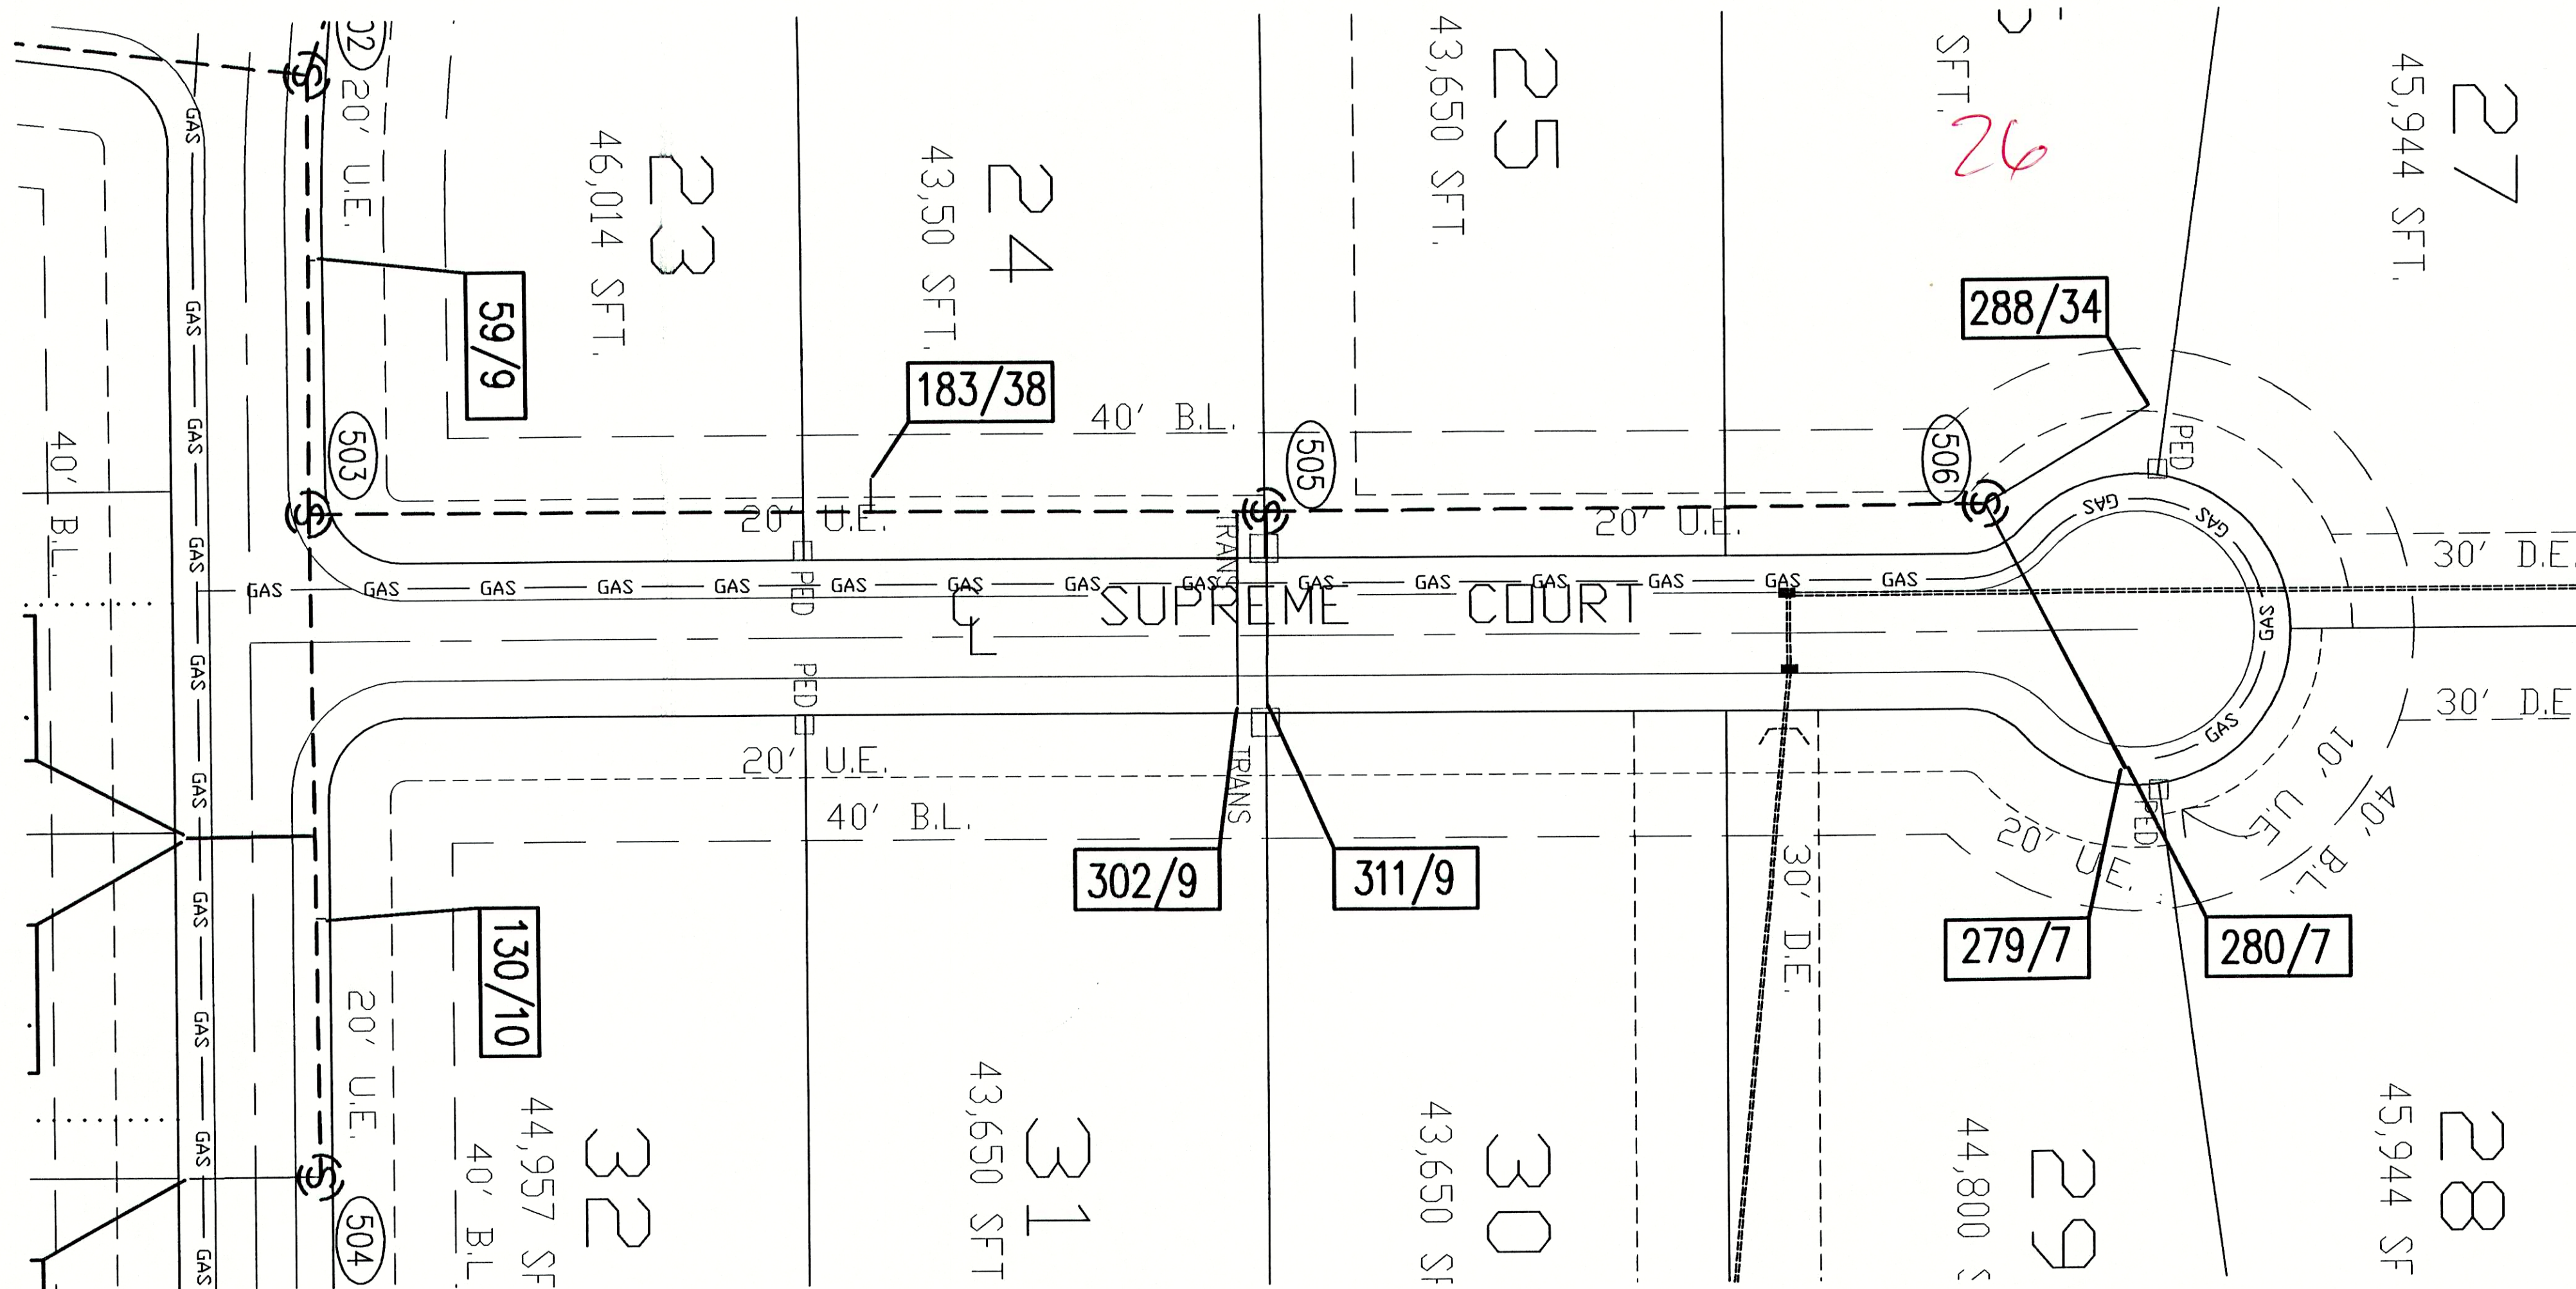

AS-BUILT
DRAWING

F.B. 138, PGS. 102-125
F.B. 160, PGS. 46-49

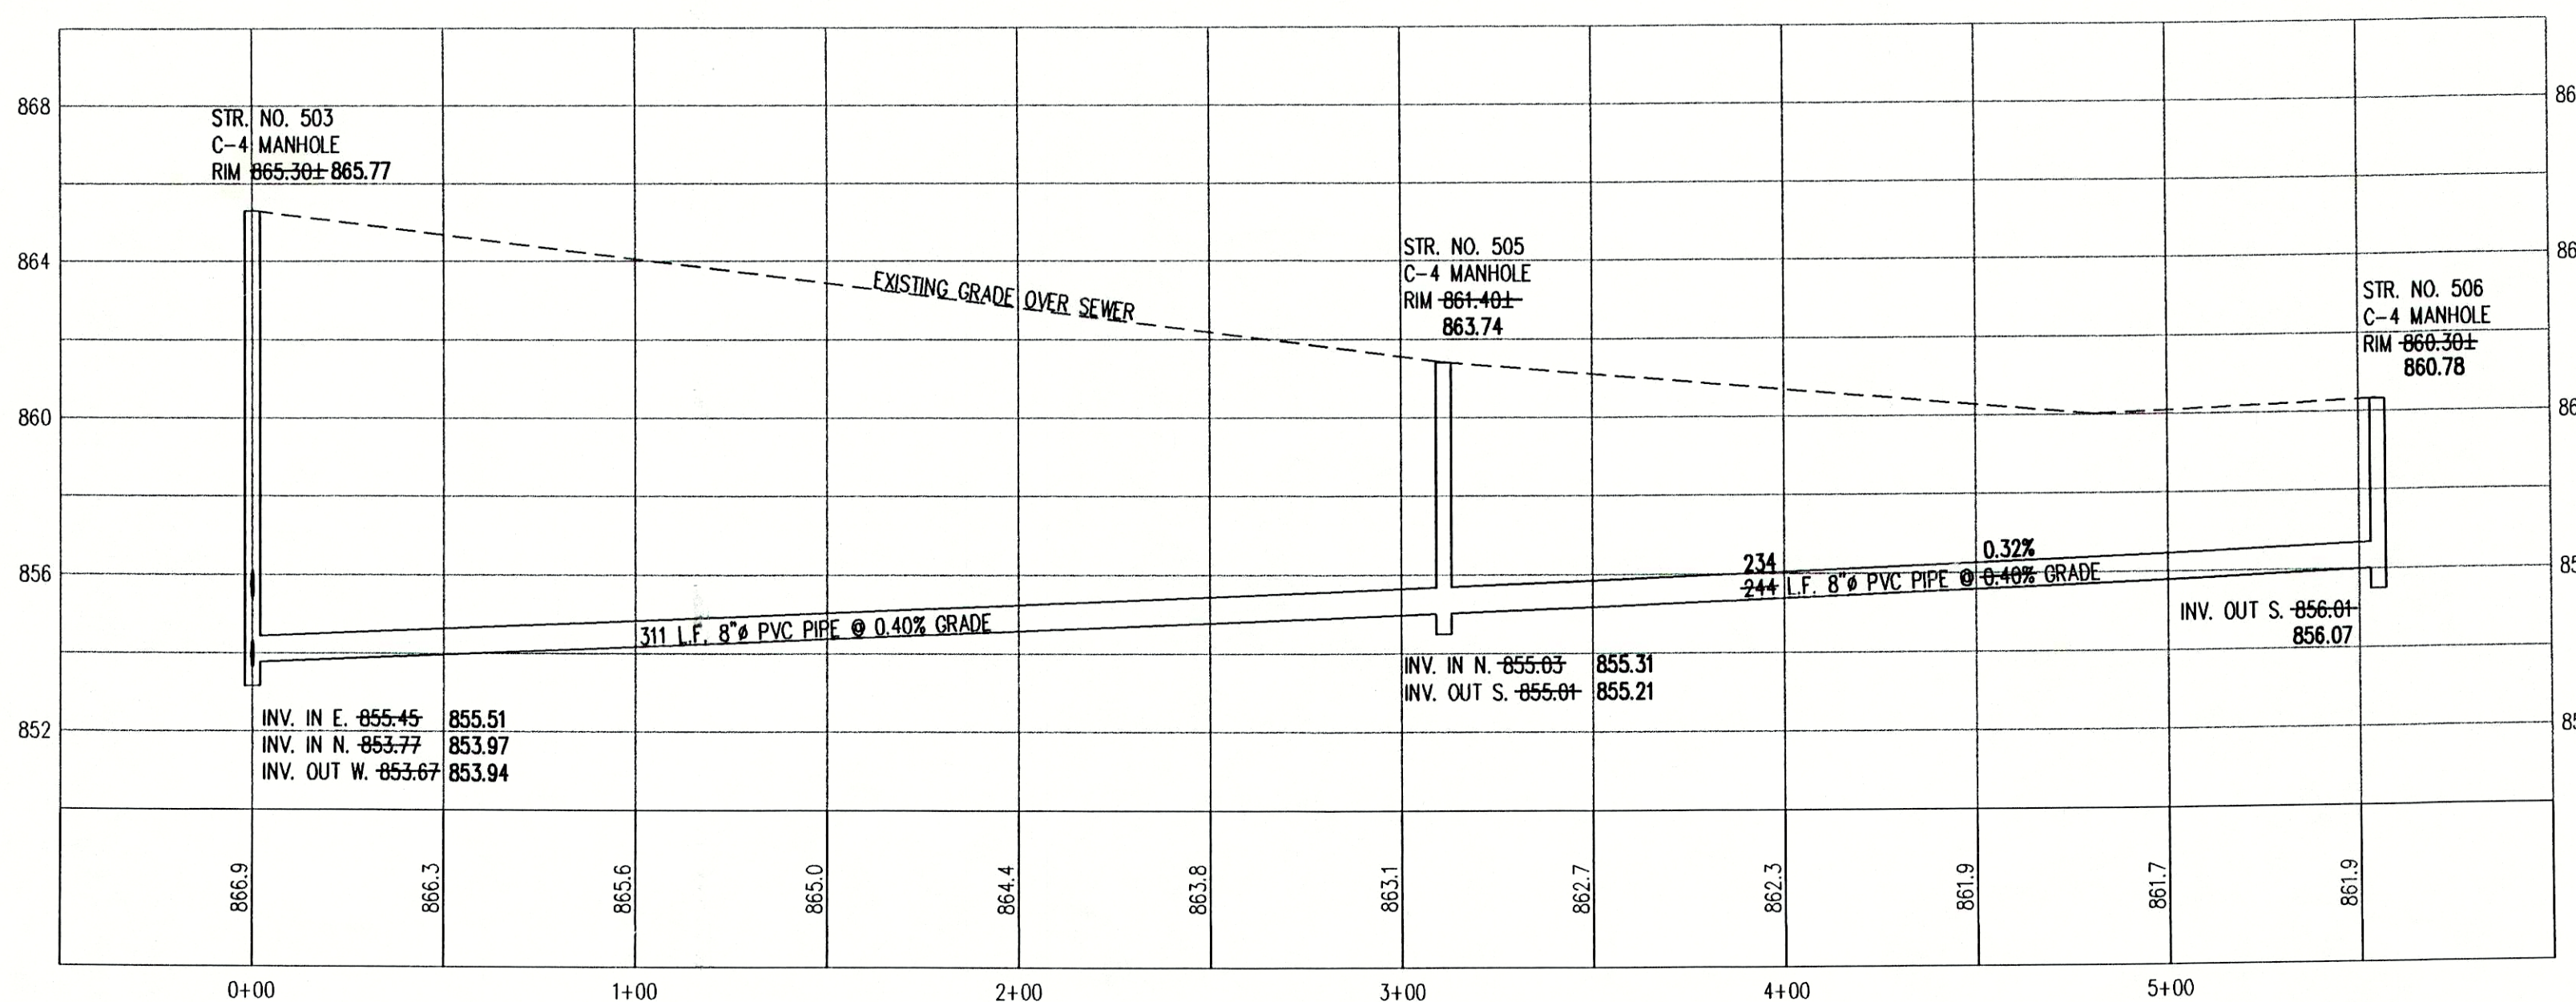

GENERAL NOTES:

1. ALL STATIONING IS FROM THE NEAREST DOWNSTREAM MANHOLE (M.H.)
2. ALL PIPE LENGTHS ARE FROM THE CENTER OF STRUCTURE TO CENTER OF STRUCTURE.
3. LATERALS FIELD MARKED WITH 2"x4" 'S' PAINTED GREEN. NONE FOUND ON LOTS 25, 27, & 65.

AS-BUILT SANITARY LATERALS

DISTANCE FROM
DOWNSTREAM
MANHOLE


214/14

DISTANCE FROM
BACK OF CURB

AS-BUILT SANITARY SEWER PLAN & PROFILE

REVISIONS:

JEFFERSON PLACE
GREEN TOWNSHIP
MADISON COUNTY, INDIANA

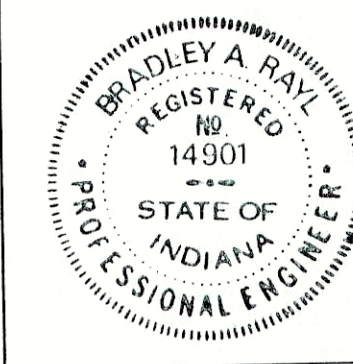

BY: *Bradley A. Rayl*
DATE: 5-9-00

SHEET

4 OF 6