


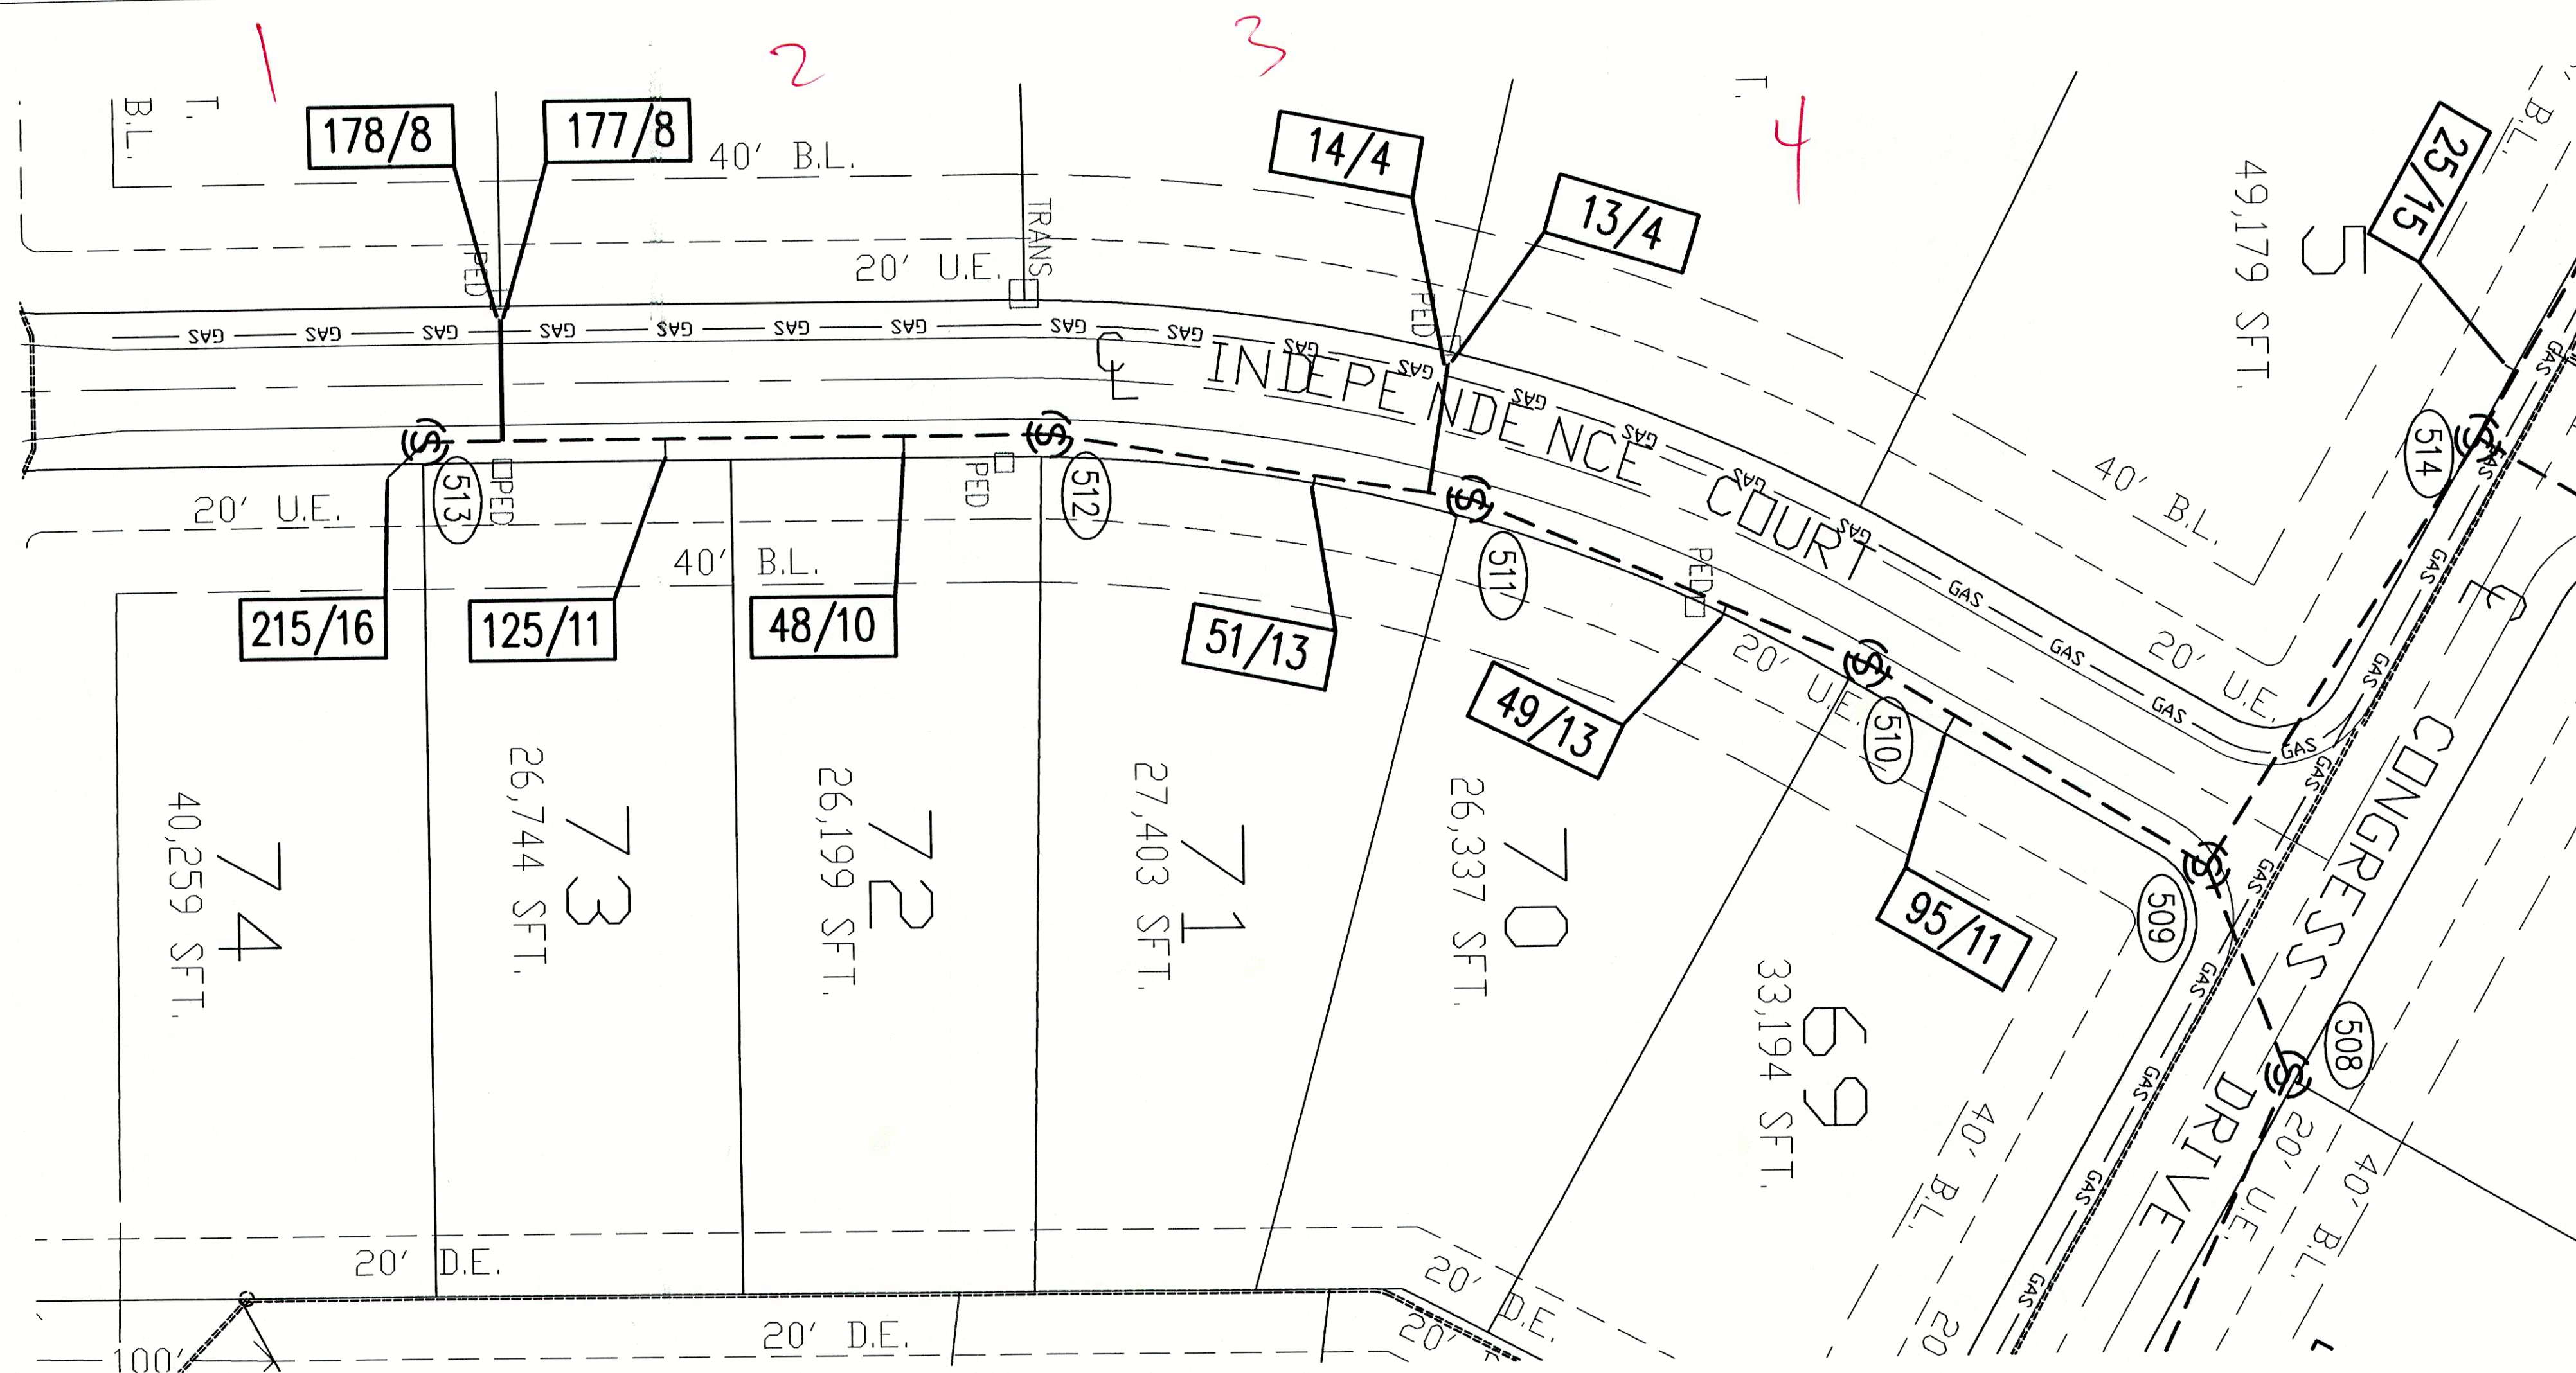

SCALE: HOR. 1" = 40'
VER. 1" = 4'


LEGEND

- (S) — PROPOSED SANITARY SEWER
- (S) --- EXISTING STORM SEWER
- * GRANULAR BACKFILL REQUIRED IF OPEN CUT

TBM #1 - RAILROAD SPIKE IN EAST SIDE OF POWER POLE #077930 AT SOUTHWEST QUADRANT OF S.R. 38 AND COUNTY ROAD 600 WEST. ELEV. 864.74

AS-BUILT
DRAWING

F.B. 138, PGS. 102-125
F.B. 160, PGS. 46-49

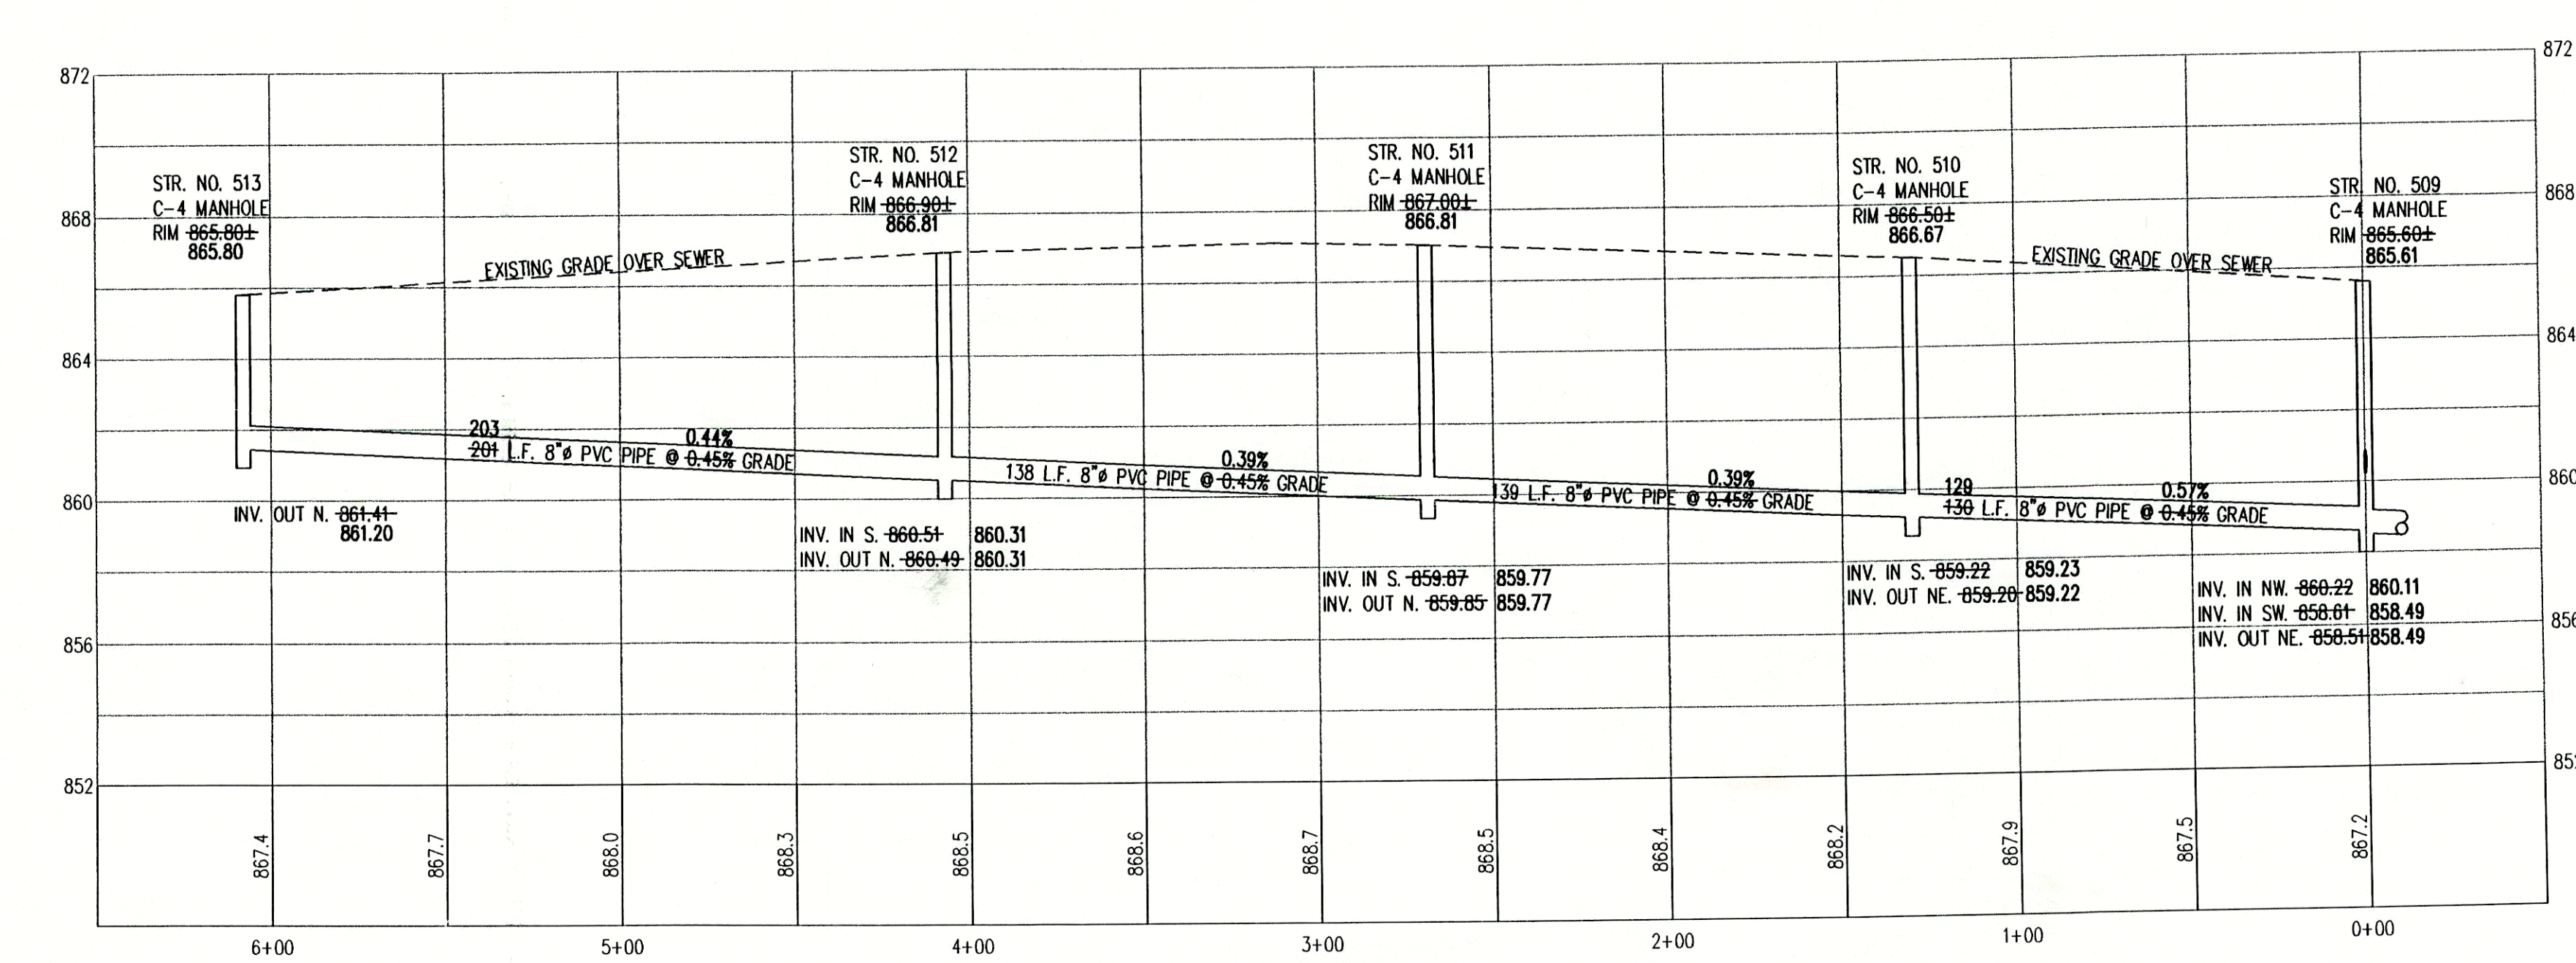

GENERAL NOTES:

- ALL STATIONING IS FROM THE NEAREST DOWNSTREAM MANHOLE (M.H.)
- ALL PIPE LENGTHS ARE FROM THE CENTER OF STRUCTURE TO CENTER OF STRUCTURE.
- LATERALS FIELD MARKED WITH 2"x4" 'S PAINTED GREEN. NONE FOUND ON LOTS 25, 27, & 65.

AS-BUILT SANITARY LATERALS

214/14

DISTANCE FROM DOWNSTREAM MANHOLE

DISTANCE FROM BACK OF CURB

RAYL SURVEYING & ENGINEERING, INC.
1440 E. 59RD STREET
ANDERSON, INDIANA 46013
PH. (765) 643-5614
FAX (765) 643-1814

AS-BUILT SANITARY SEWER PLAN & PROFILE

JEFFERSON PLACE GREEN TOWNSHIP MADISON COUNTY, INDIANA

DATE: 5-9-00

DRAWN BY: J. ANDERSON

BY: Bradley A. Rayl
DATE: 5-9-00

SHEET 5 OF 6

F:\SDSK\PROJ\658\DWG\AB-SAN5.DWG