



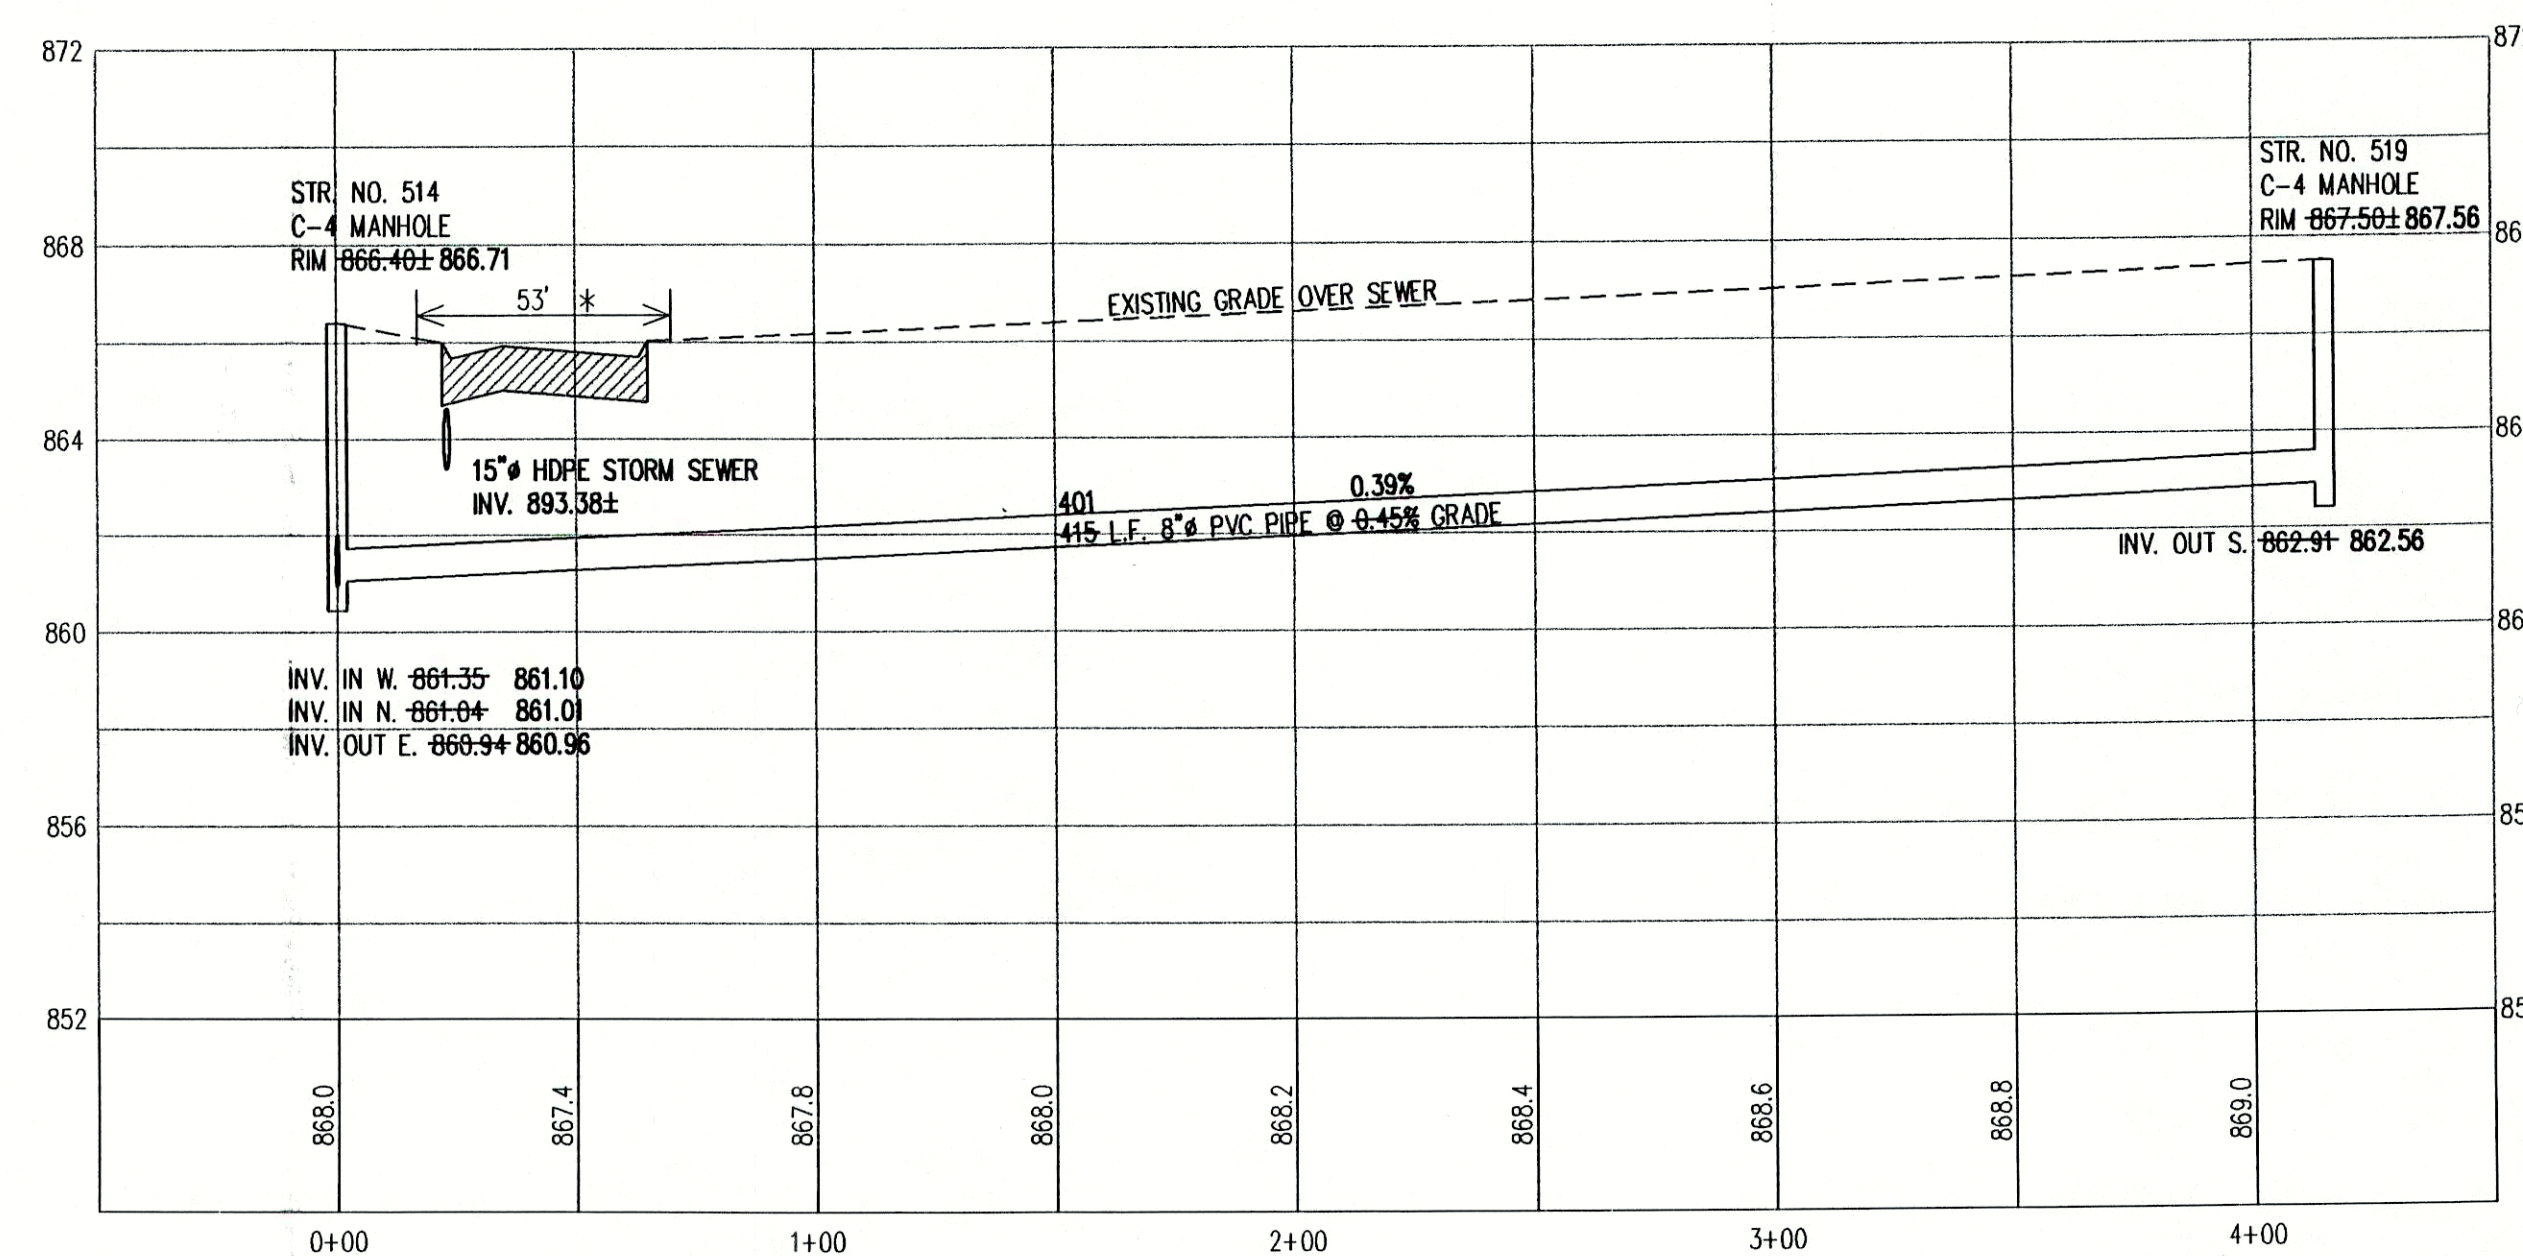

SCALE: HOR. 1" = 40'
VER. 1" = 4'

- LEGEND

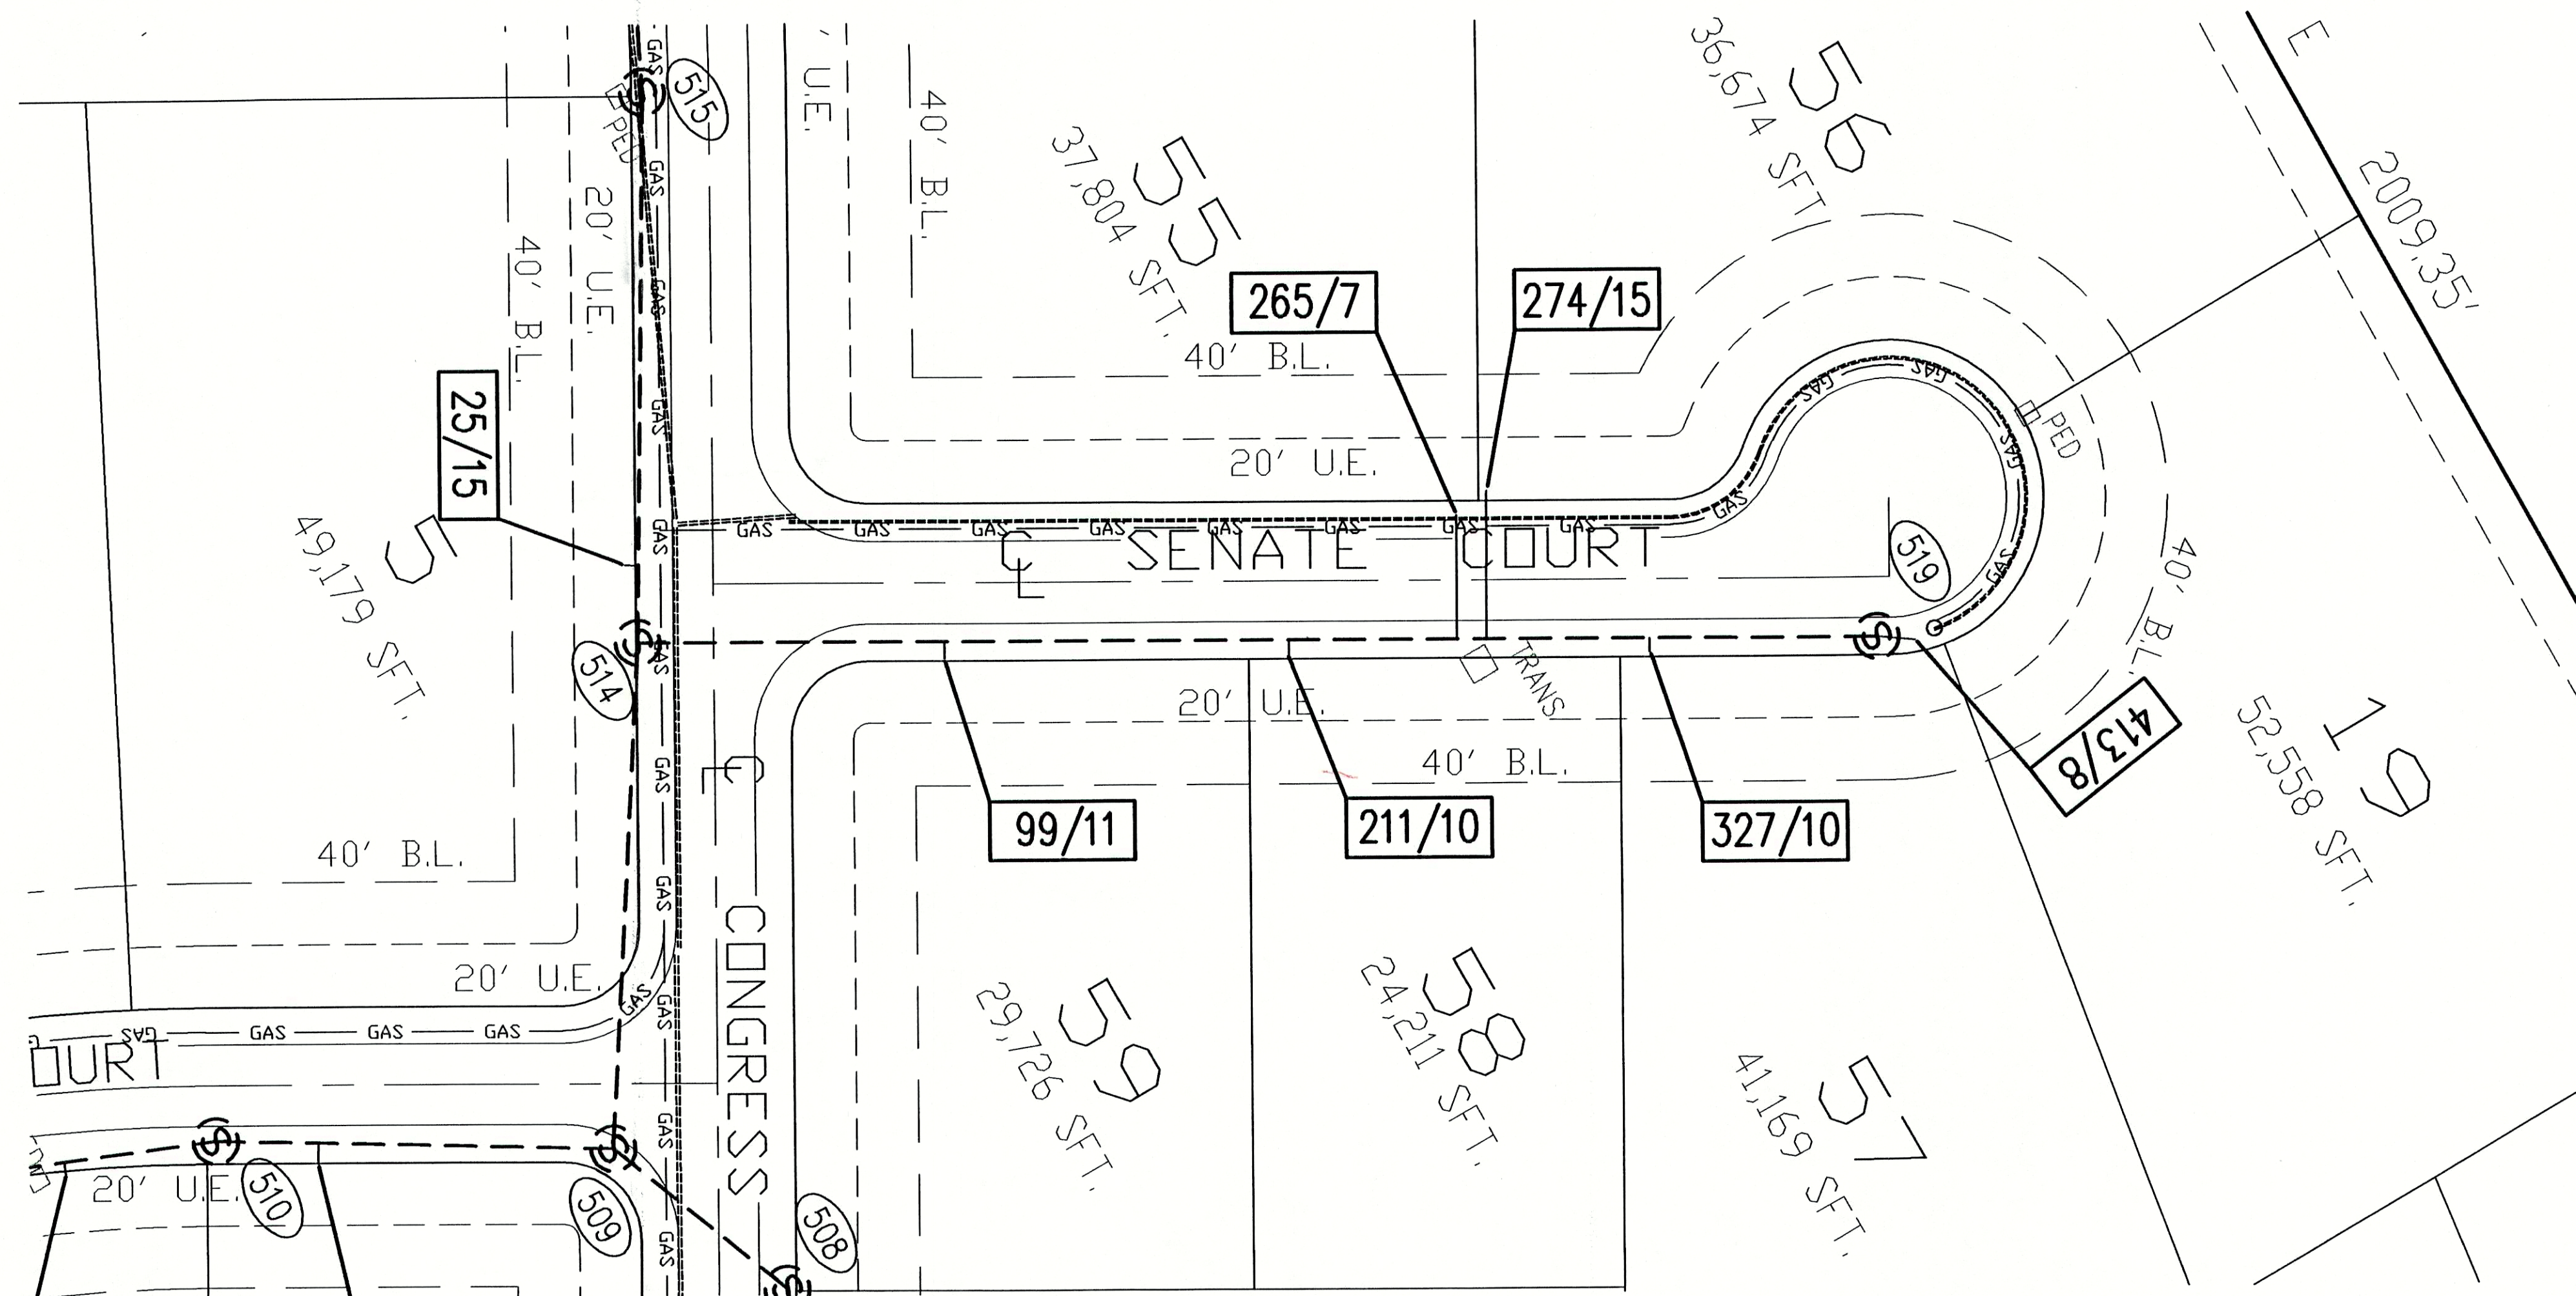

- (S) - PROPOSED SANITARY SEWER
- (O) ----- EXISTING STORM SEWER
- * - GRANULAR BACKFILL REQUIRED IF OPEN CUT

TBM #1 - RAILROAD SPIKE IN EAST SIDE OF POWER
POLE #077930 AT SOUTHWEST QUADRANT
OF S.R. 38 AND COUNTY ROAD 600 WEST.
ELEV. 864.74

AS-BUILT
DRAWING

F.B. 138, PGS. 102-125
F.B. 160, PGS. 46-49

GENERAL NOTES:

1. ALL STATIONING IS FROM THE NEAREST DOWNSTREAM MANHOLE (M.H.)
2. ALL PIPE LENGTHS ARE FROM THE CENTER OF STRUCTURE TO CENTER OF STRUCTURE.
3. LATERSALS FIELD MARKED WITH 2"x4" 'S PAINTED GREEN. NONE FOUND ON LOTS 25, 27, & 65.

AS-BUILT SANITARY LATERALS

214/14

DISTANCE FROM
DOWNSTREAM
MANHOLE

DISTANCE FROM
BACK OF CURB


AS-BUILT SANITARY SEWER PLAN & PROFILE

REVISIONS:

**JEFFERSON PLACE
GREEN TOWNSHIP
MADISON COUNTY, INDIANA**

DATE: 5 - 9 - 00

DRAWN BY: I. ANDERSON

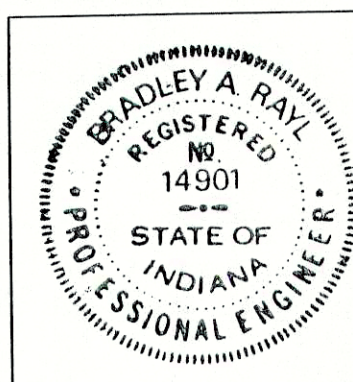

BY: Bradley A. Ray
DATE: 5-9-00

SHEET

6 OF 6

F:\SDSK\PROJ\658\DWG\AB-SAN6.DWG