


JEFFERSON PLACE

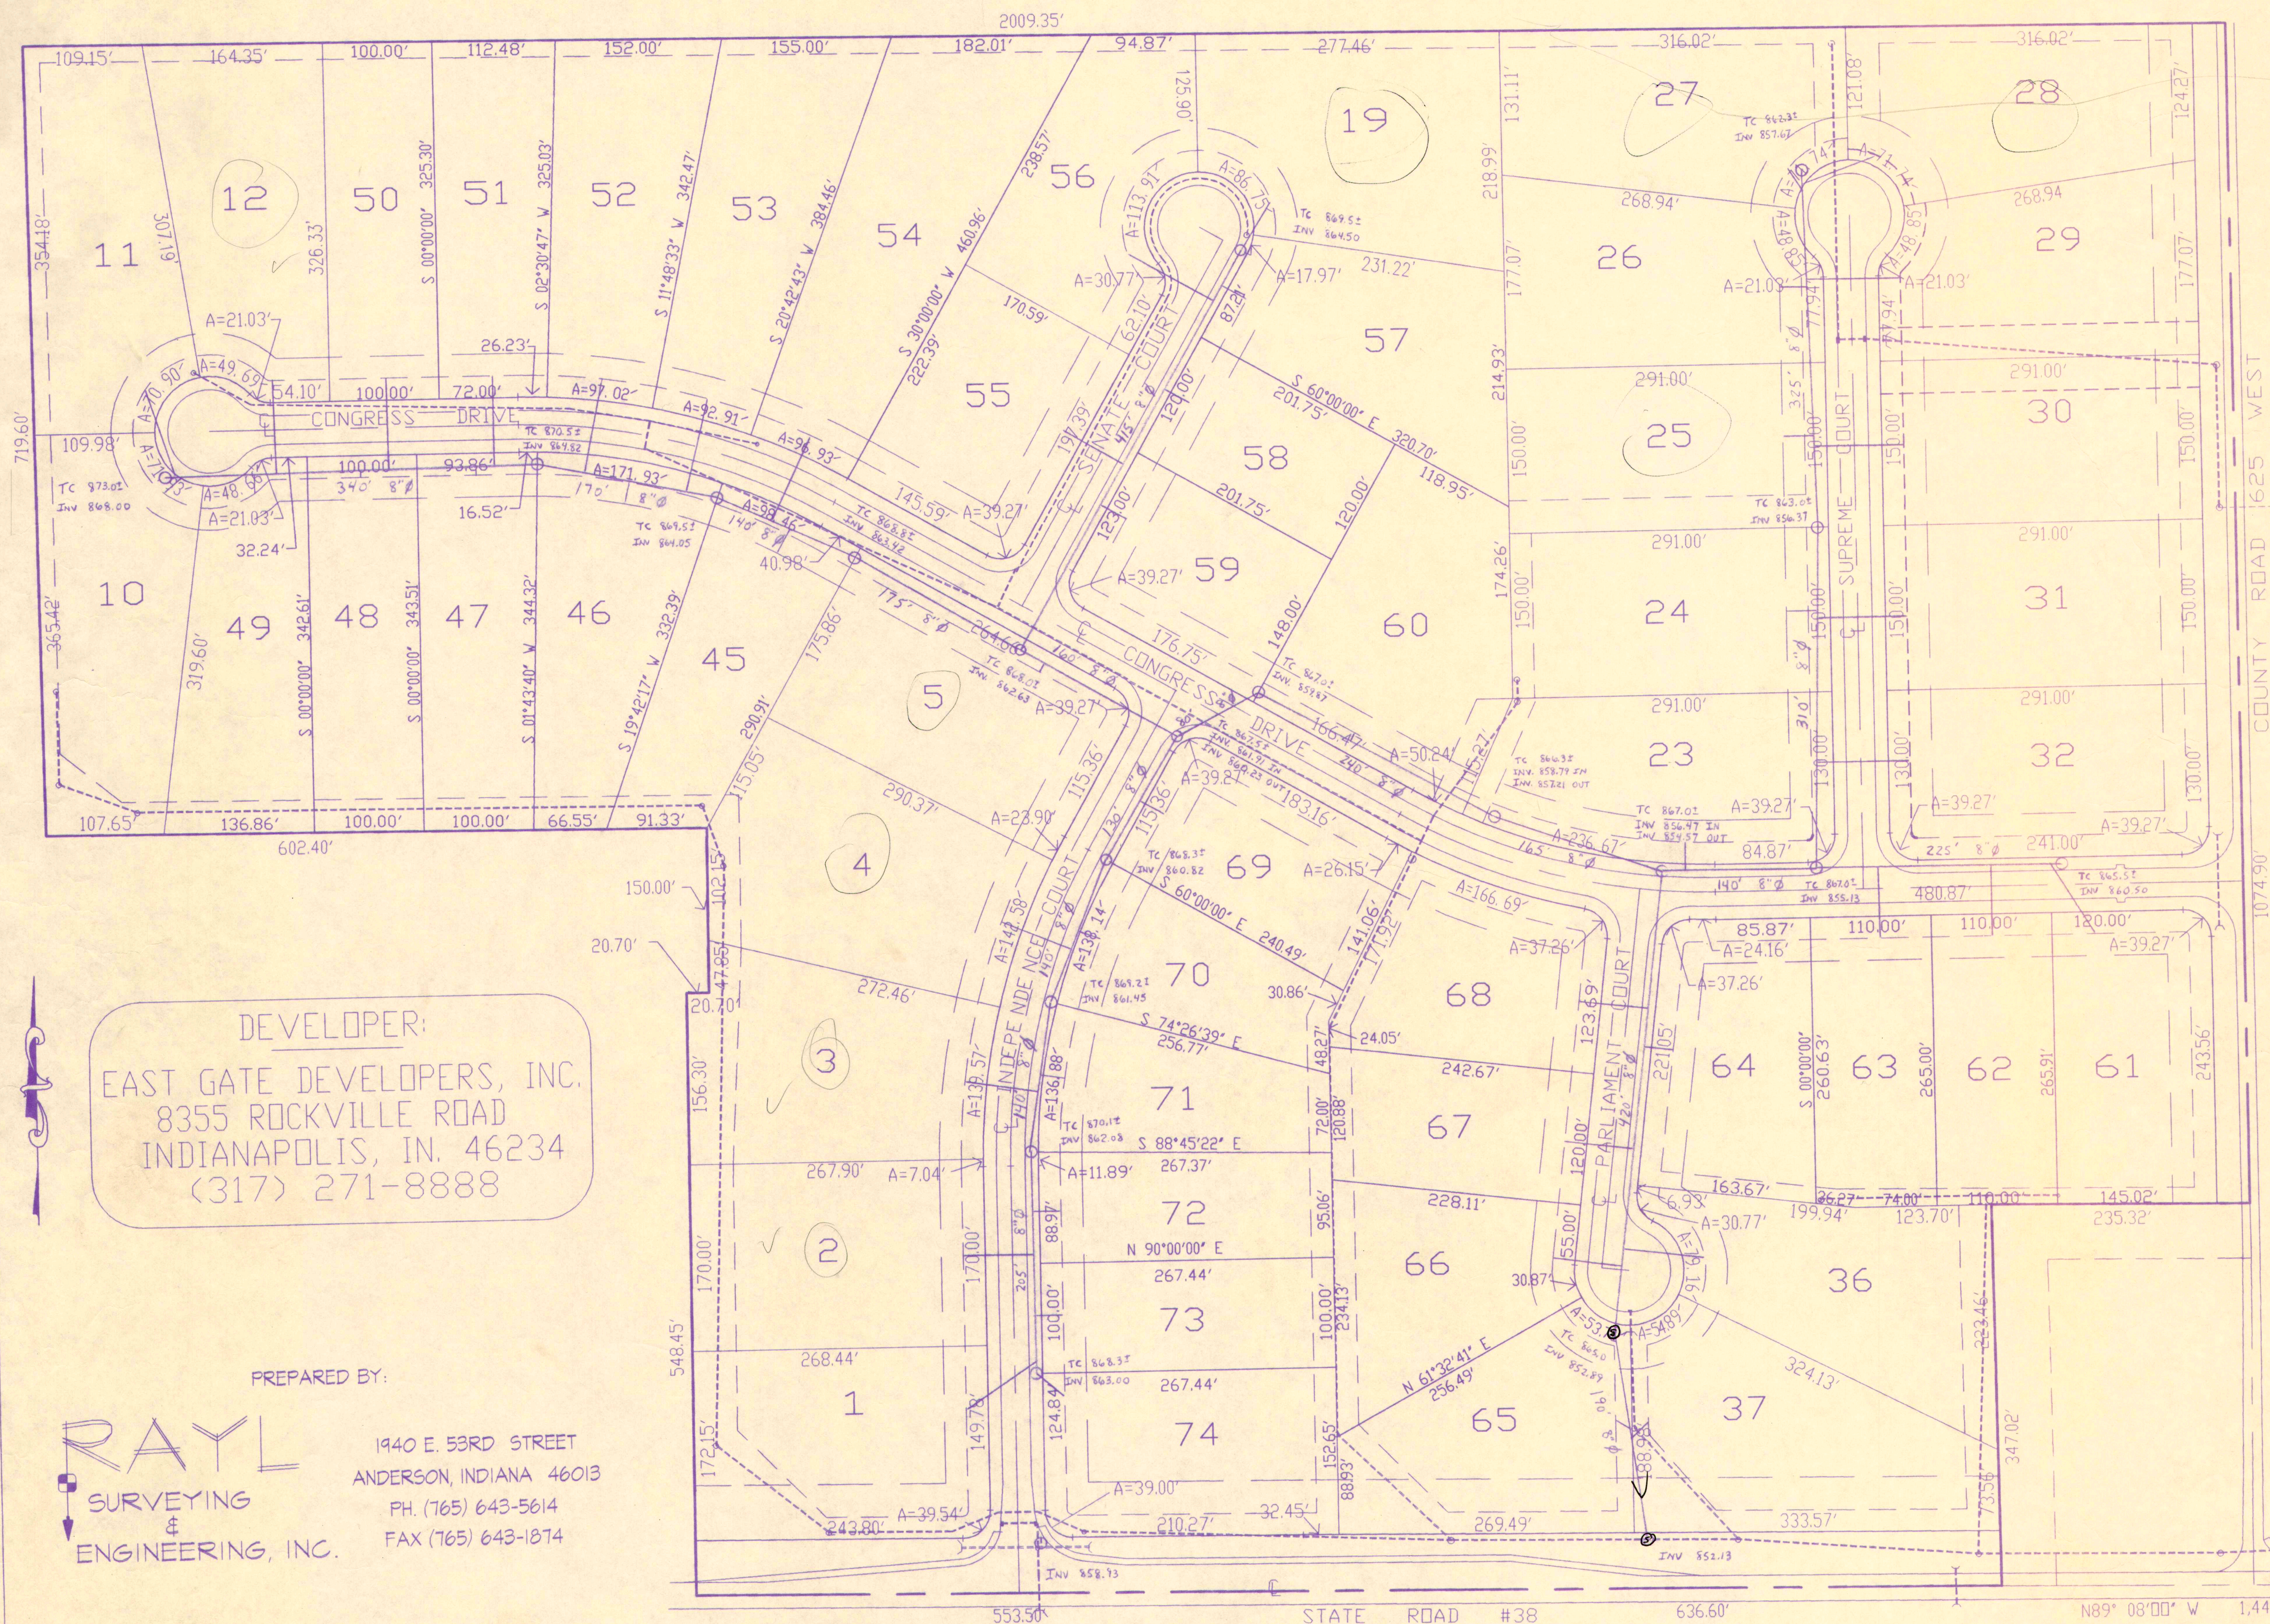

DEVELOPER:
EAST GATE DEVELOPERS, INC.
8355 ROCKVILLE ROAD
INDIANAPOLIS, IN. 46234
(317) 271-8888



PREPARED BY:

RAYL
SURVEYING
&
ENGINEERING, INC.

1940 E. 53RD STREET
ANDERSON, INDIANA 46013
PH. (765) 643-5614
FAX (765) 643-1874

SE CORNER OF THE NE 1/4
OF SECTION 13, T18 N, R6 E

PRINTED
MAR 05 1999

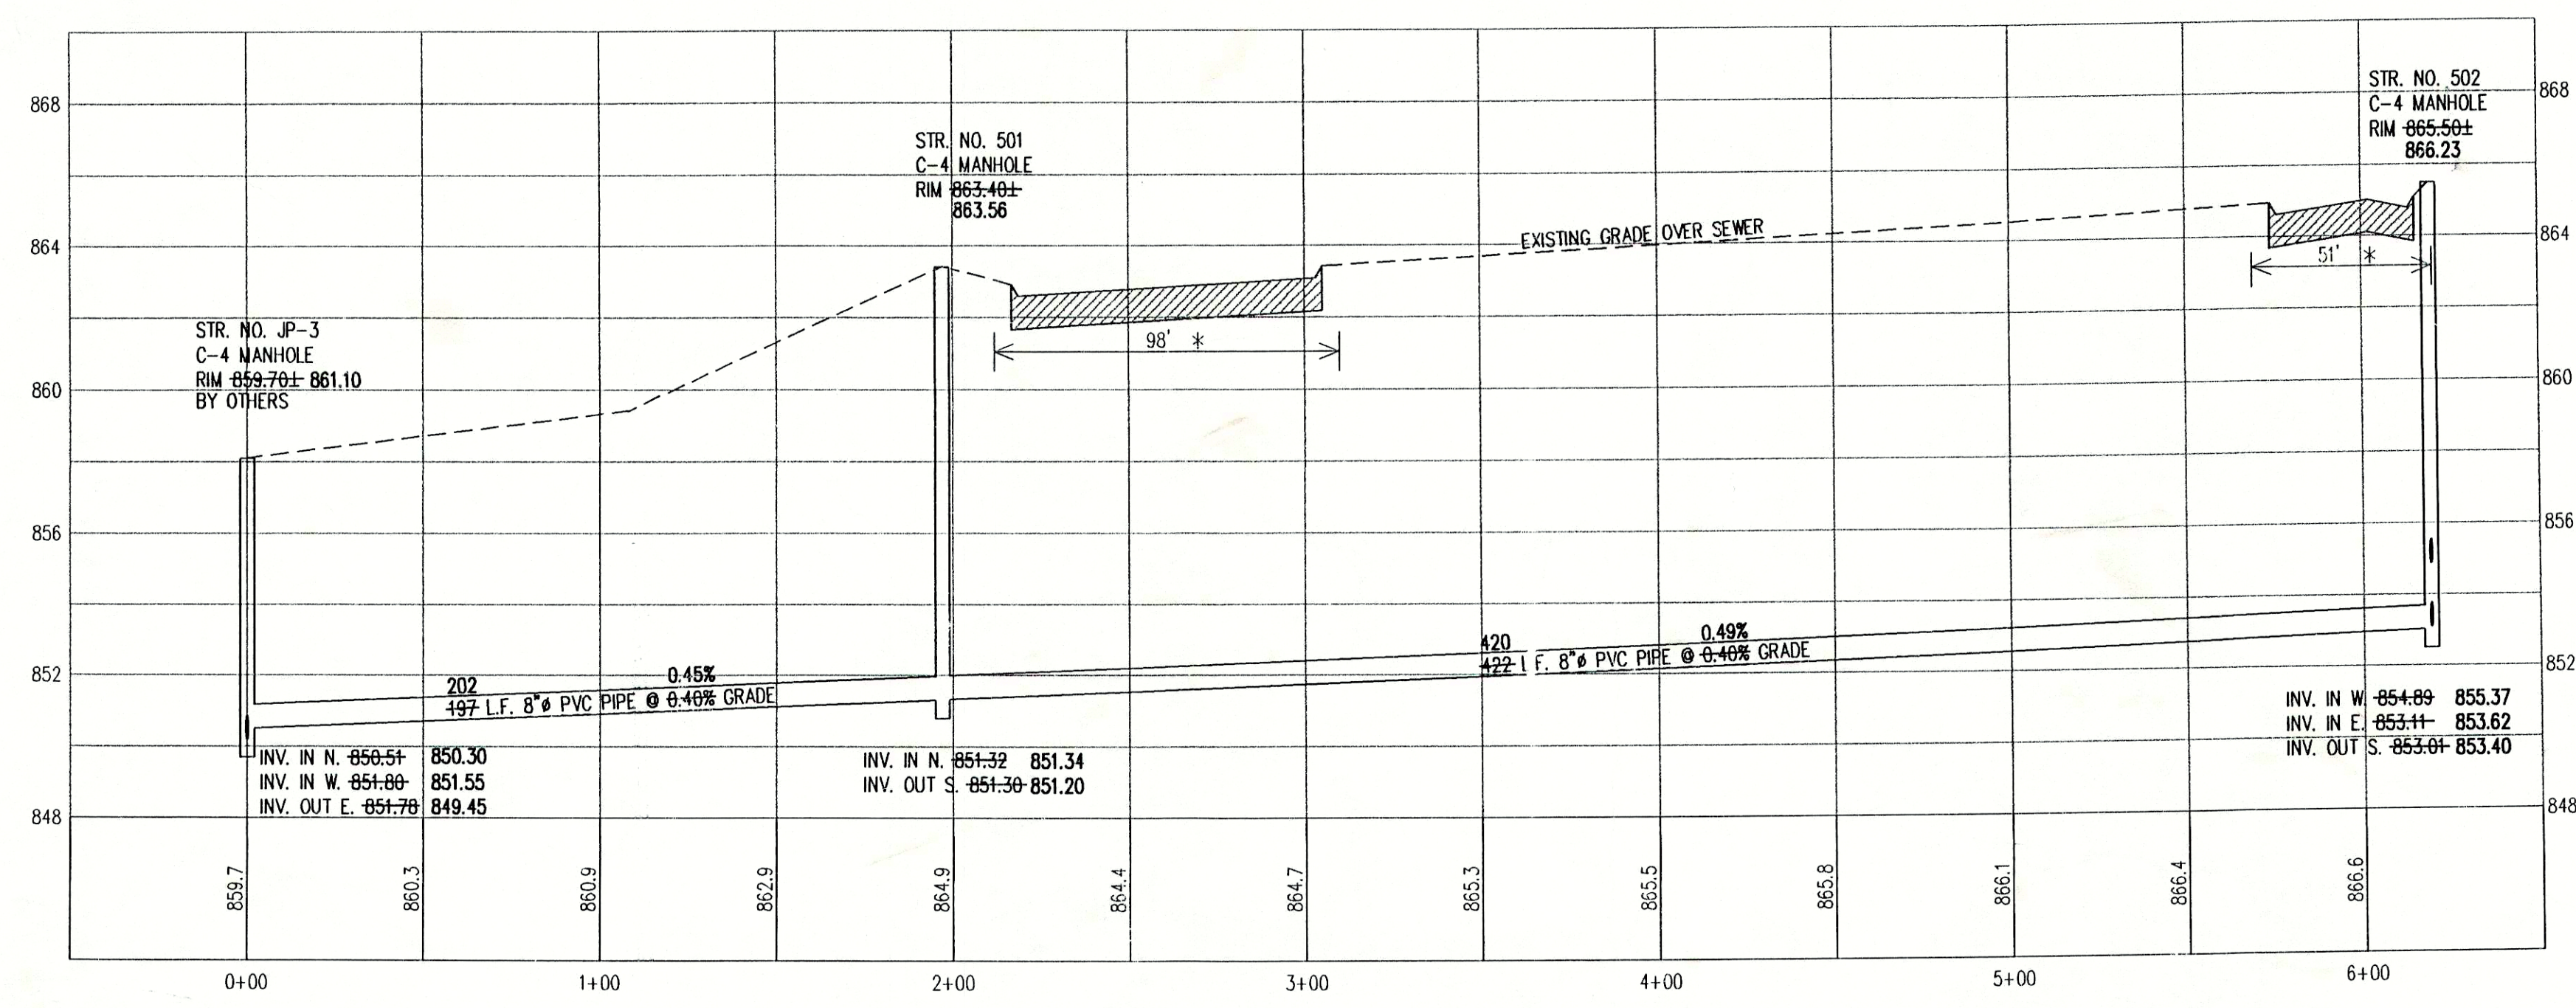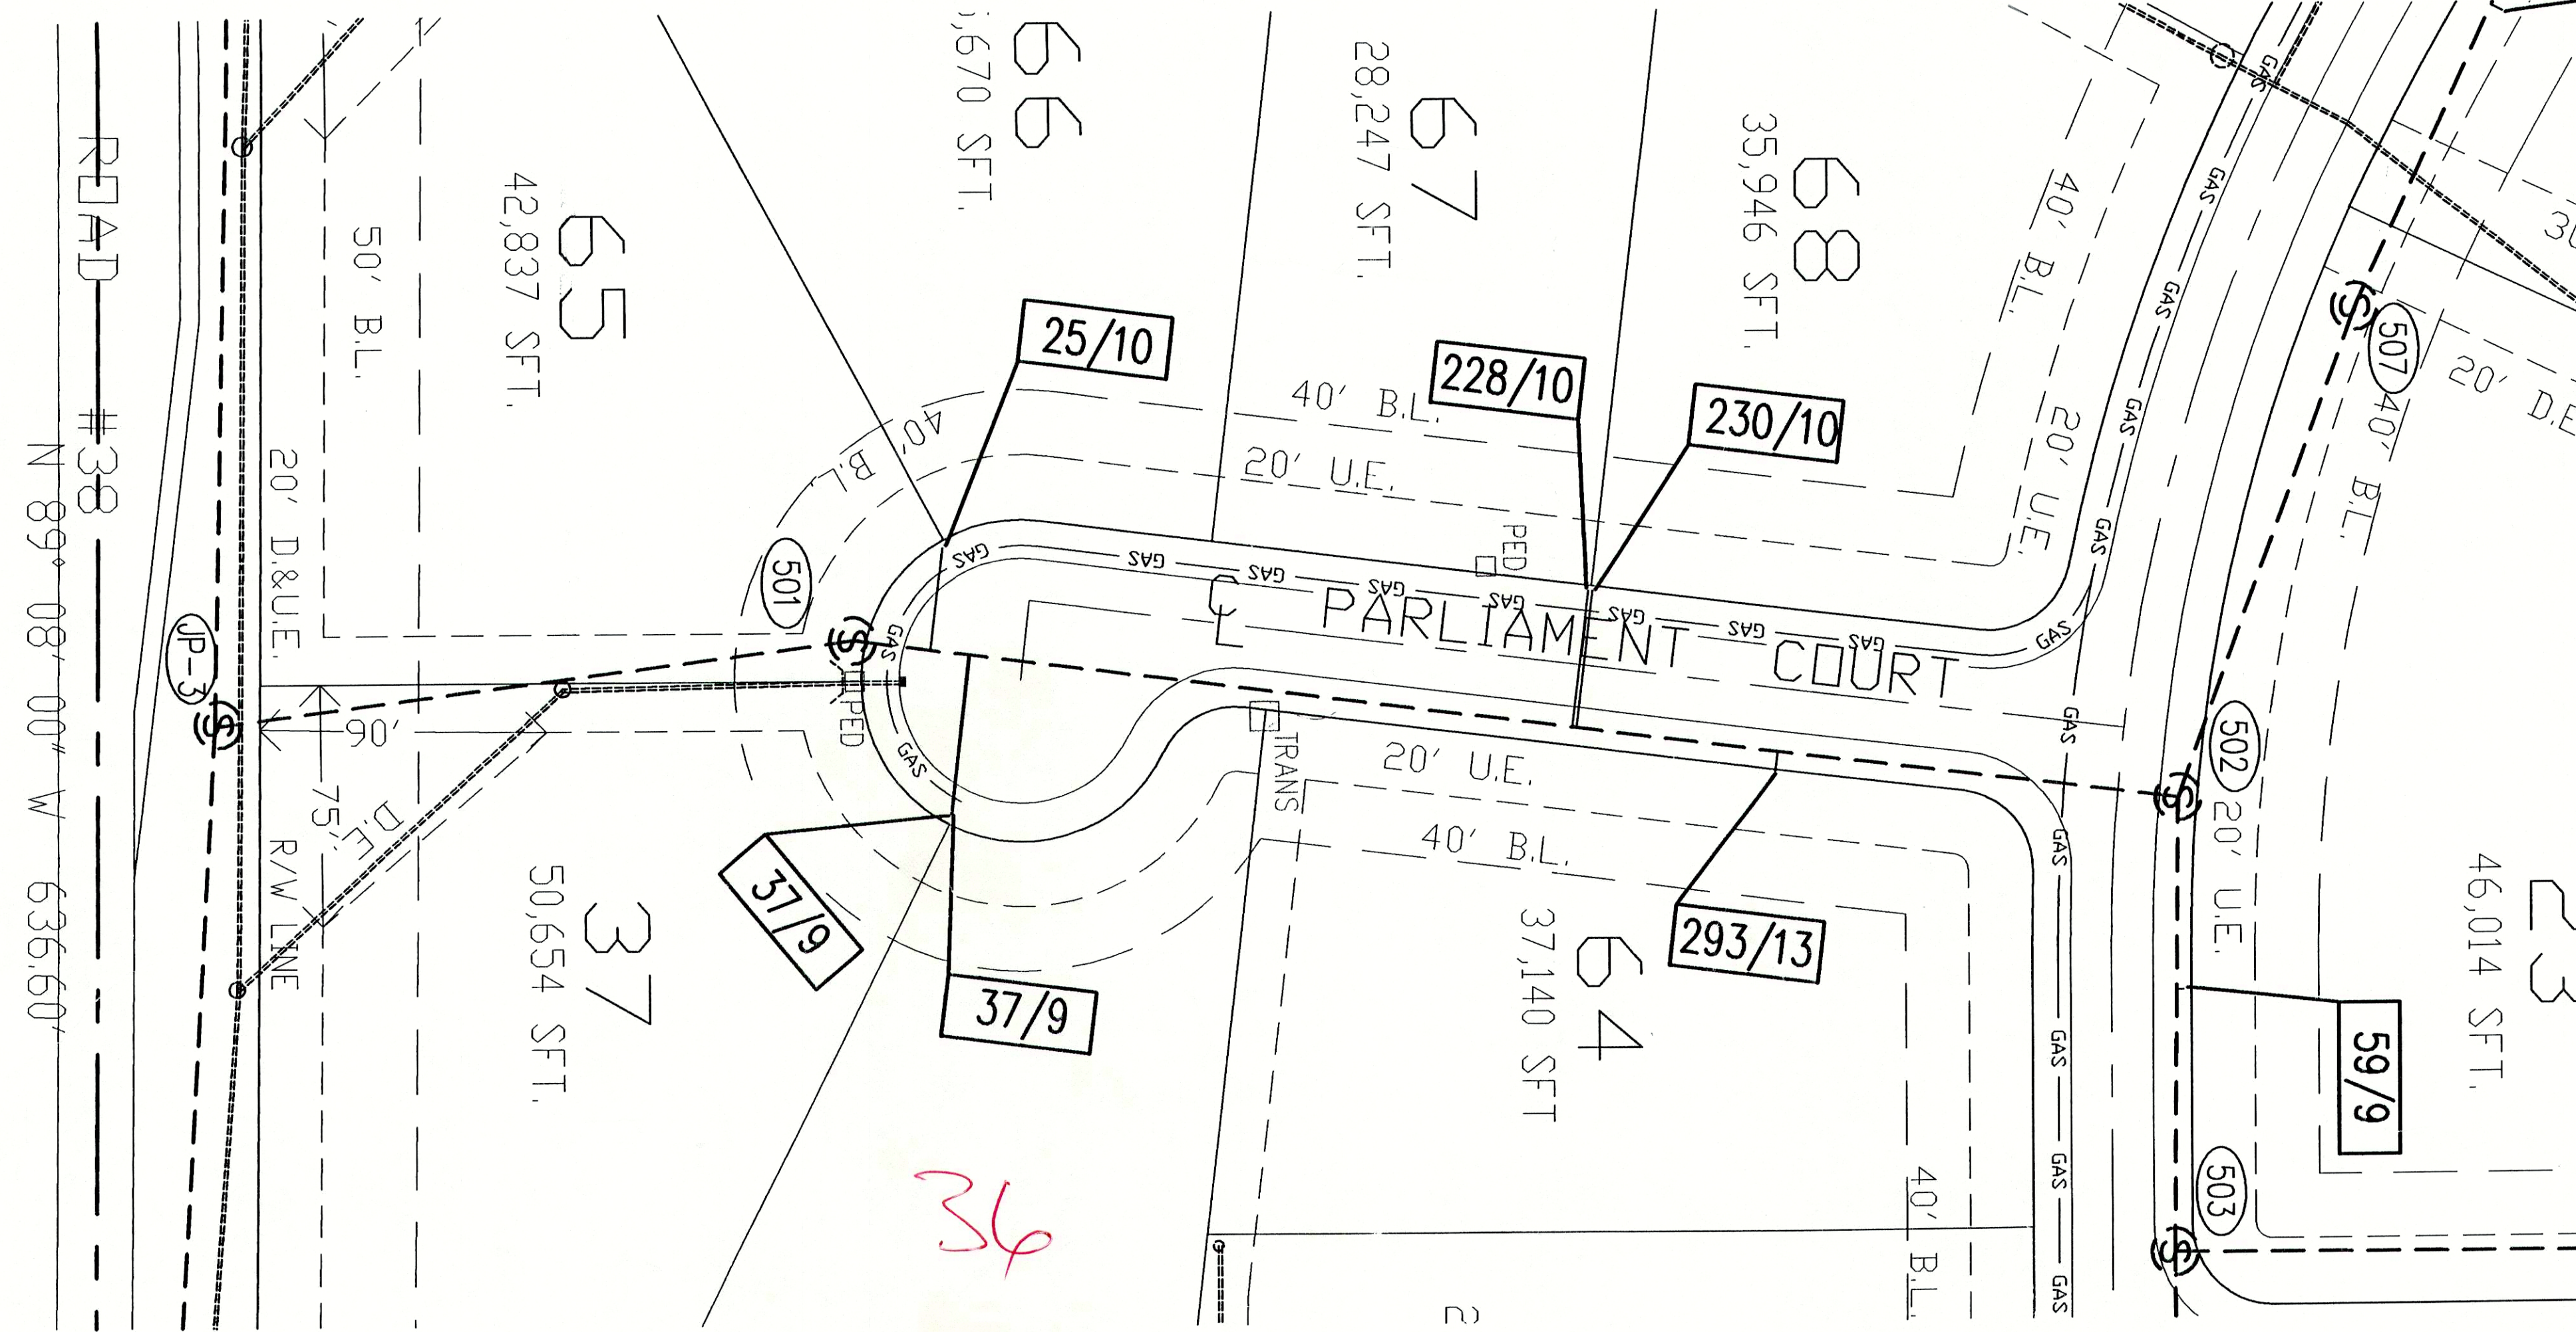

SCALE: HOR. 1" = 40'
VER. 1" = 4'

LEGEND

- (S) — PROPOSED SANITARY SEWER
- (S) — EXISTING STORM SEWER
- * GRANULAR BACKFILL REQUIRED IF OPEN CUT

TBM #1 - RAILROAD SPIKE IN EAST SIDE OF POWER POLE #077930 AT SOUTHWEST QUADRANT OF S.R. 38 AND COUNTY ROAD 600 WEST. ELEV. 864.74

AS-BUILT DRAWING

FB. 138, PGS. 102-125
FB. 160, PGS. 46-49

- GENERAL NOTES:
- ALL STATIONING IS FROM THE NEAREST DOWNSTREAM MANHOLE (M.H.)
 - ALL PIPE LENGTHS ARE FROM THE CENTER OF STRUCTURE TO CENTER OF STRUCTURE.
 - LATERALS FIELD MARKED WITH 2"x4" 'S' PAINTED GREEN. NONE FOUND ON LOTS 25, 27, & 65.
- AS-BUILT SANITARY LATERALS
- 214/14
- DISTANCE FROM DOWNSTREAM MANHOLE
- DISTANCE FROM BACK OF CURB

1940 E. 59RD STREET
ANDERSON, INDIANA 46013
PH. (765) 643-5614
FAX (765) 643-1814

RAYL
SURVEYING &
ENGINEERING, INC.

AS-BUILT SANITARY SEWER
PLAN & PROFILE

REVISIONS:

JEFFERSON PLACE
GREEN TOWNSHIP
MADISON COUNTY, INDIANA

DRAWN BY: J. ANDERSON
DATE: 5-9-00

BY: *Barley A. Rayl*
DATE: 5-9-00

SHEET
1 OF 6


F:\SDSK\PROJ\658\DWG\AB-SAN1.DWG

**AS-BUILT SANITARY SEWER
PLAN & PROFILE**

REVISIONS:

**JEFFERSON PLACE
GREEN TOWNSHIP
MADISON COUNTY, INDIANA**


DRAWN BY: J. ANDERSON DATE: 5-9-00

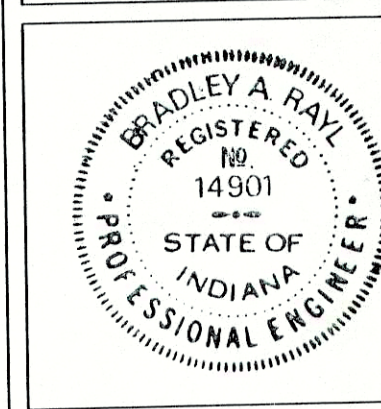

By: *Bradley A. Rayl*
DATE: 5-9-00

SHEET

2 OF 6

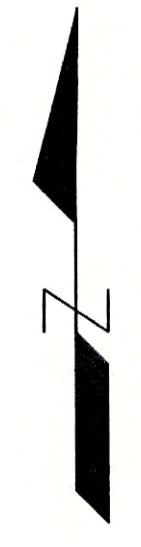

SCALE: HOR. 1" = 40'
VER. 1" = 4'

LEGEND

- PROPOSED SANITARY SEWER
- EXISTING STORM SEWER
- GRANULAR BACKFILL REQUIRED IF OPEN CUT




TBM #1 - RAILROAD SPIKE IN EAST SIDE OF POWER POLE #077930 AT SOUTHWEST QUADRANT OF S.R. 38 AND COUNTY ROAD 600 WEST. ELEV. 864.74


GENERAL NOTES:

- ALL STATIONING IS FROM THE NEAREST DOWNSTREAM MANHOLE (M.H.)
- ALL PIPE LENGTHS ARE FROM THE CENTER OF STRUCTURE TO CENTER OF STRUCTURE.
- LATERALS FIELD MARKED WITH 2"x4" 'S PAINTED GREEN. NONE FOUND ON LOTS 25, 27, & 65.

AS-BUILT SANITARY LATERALS

DISTANCE FROM DOWNSTREAM MANHOLE
DISTANCE FROM BACK OF CURB

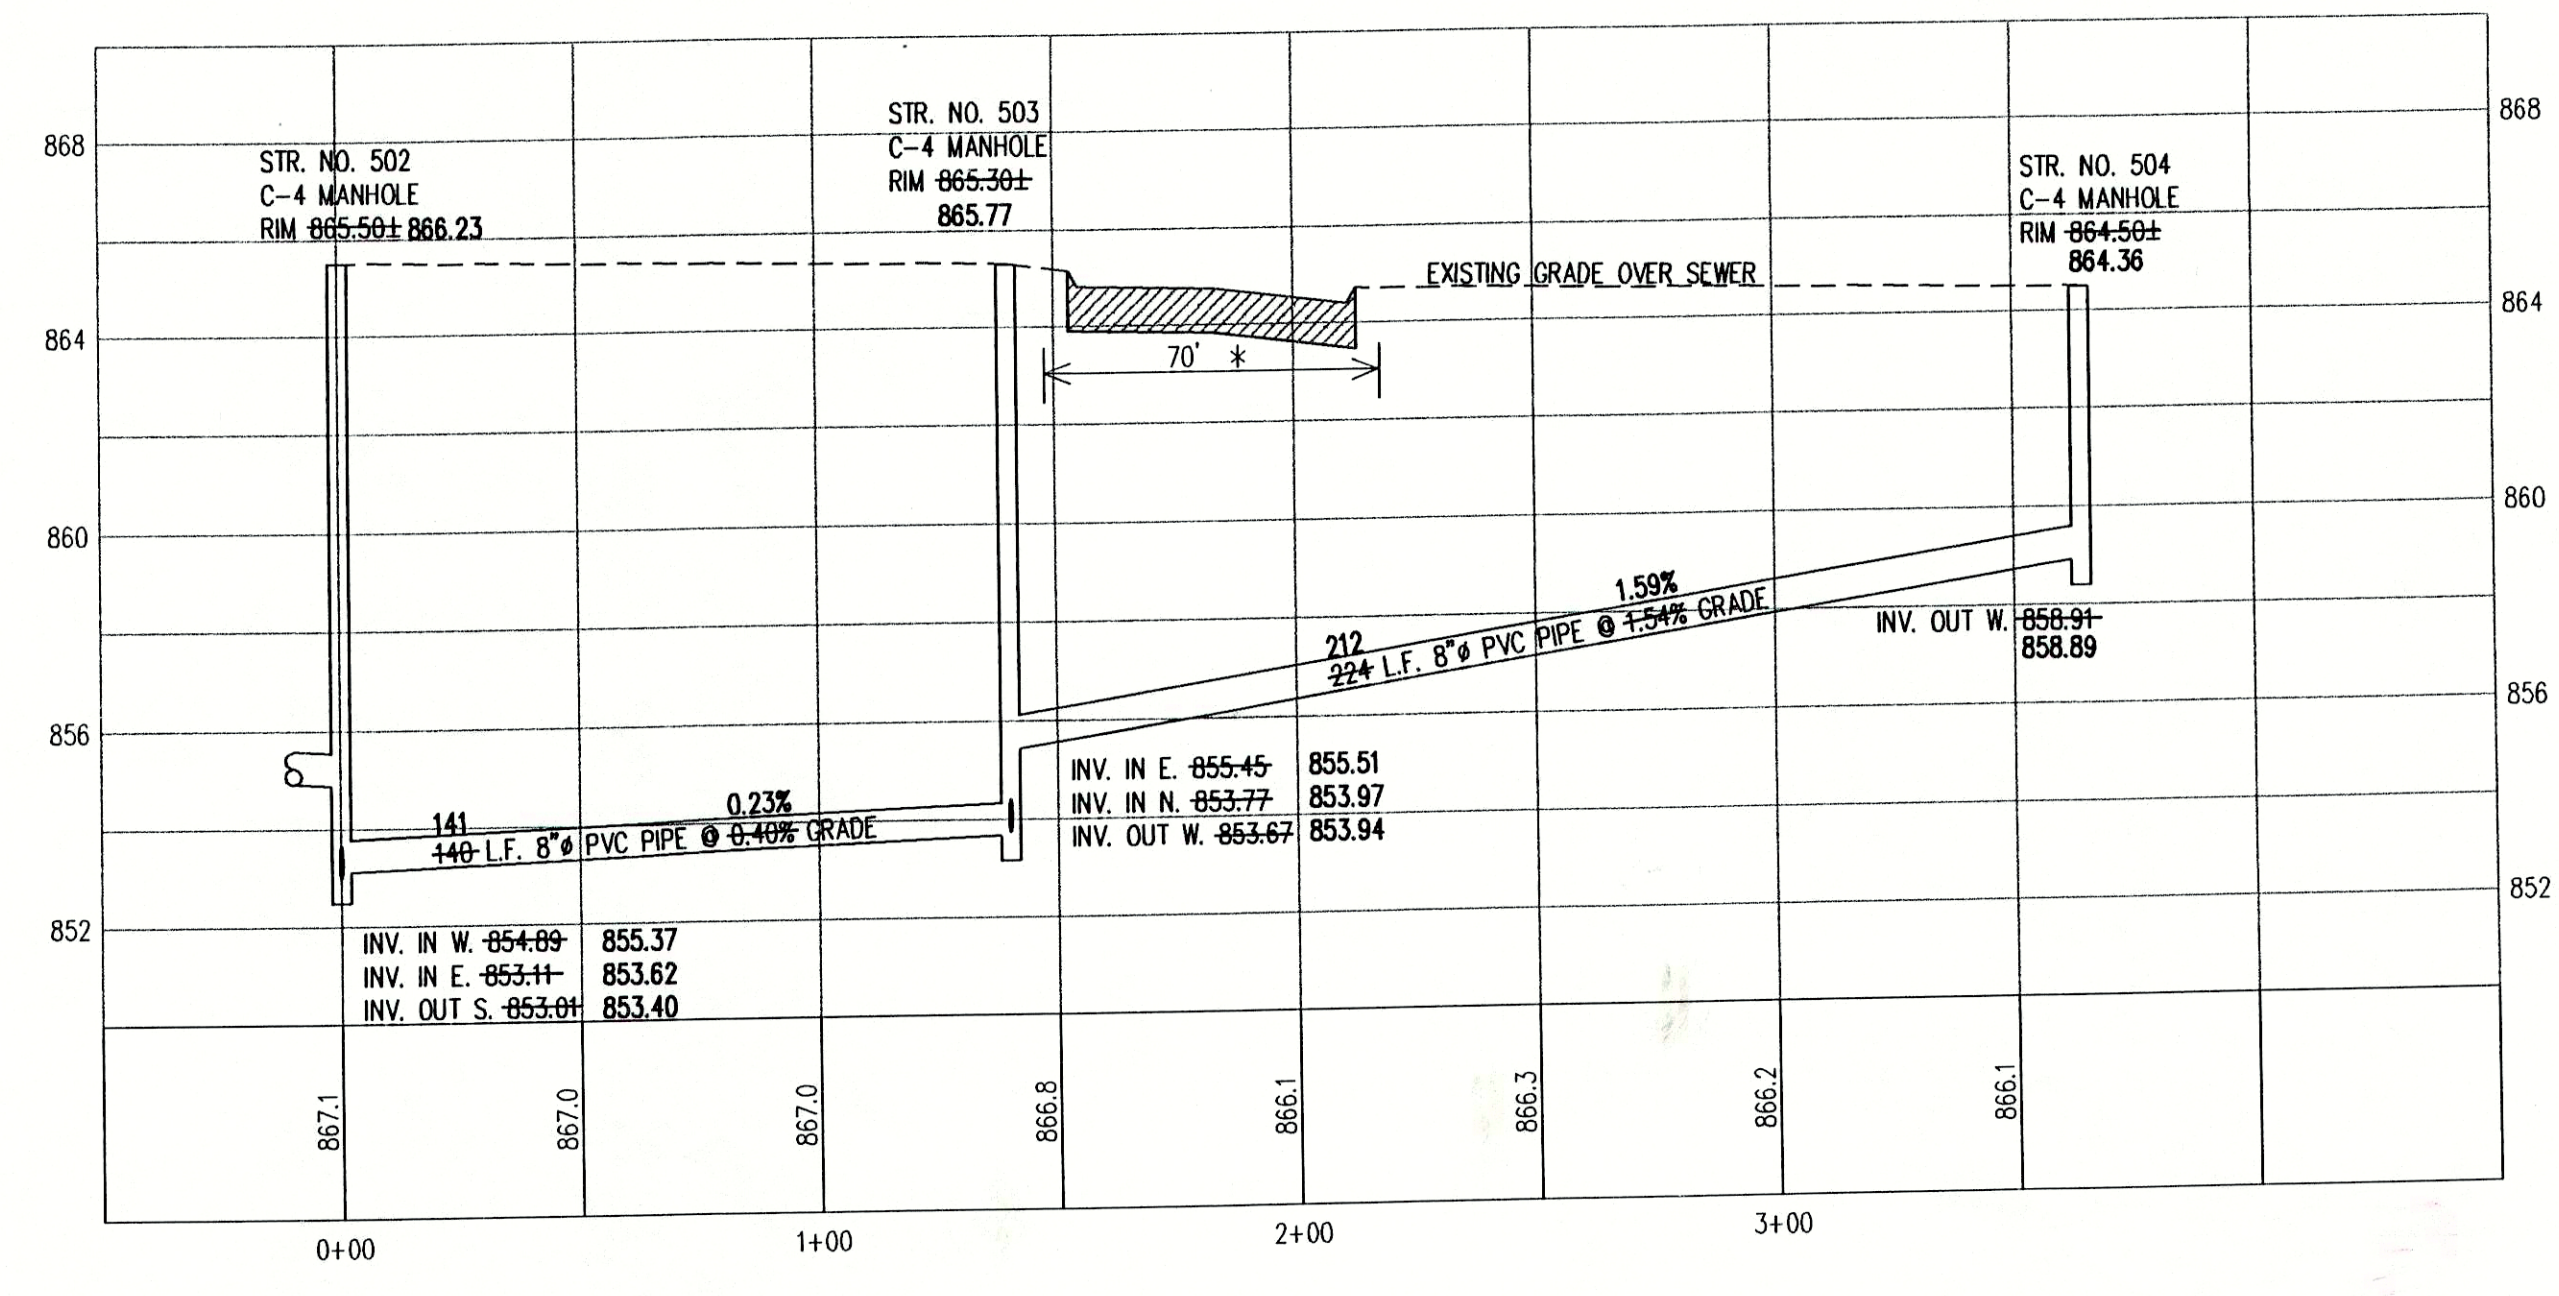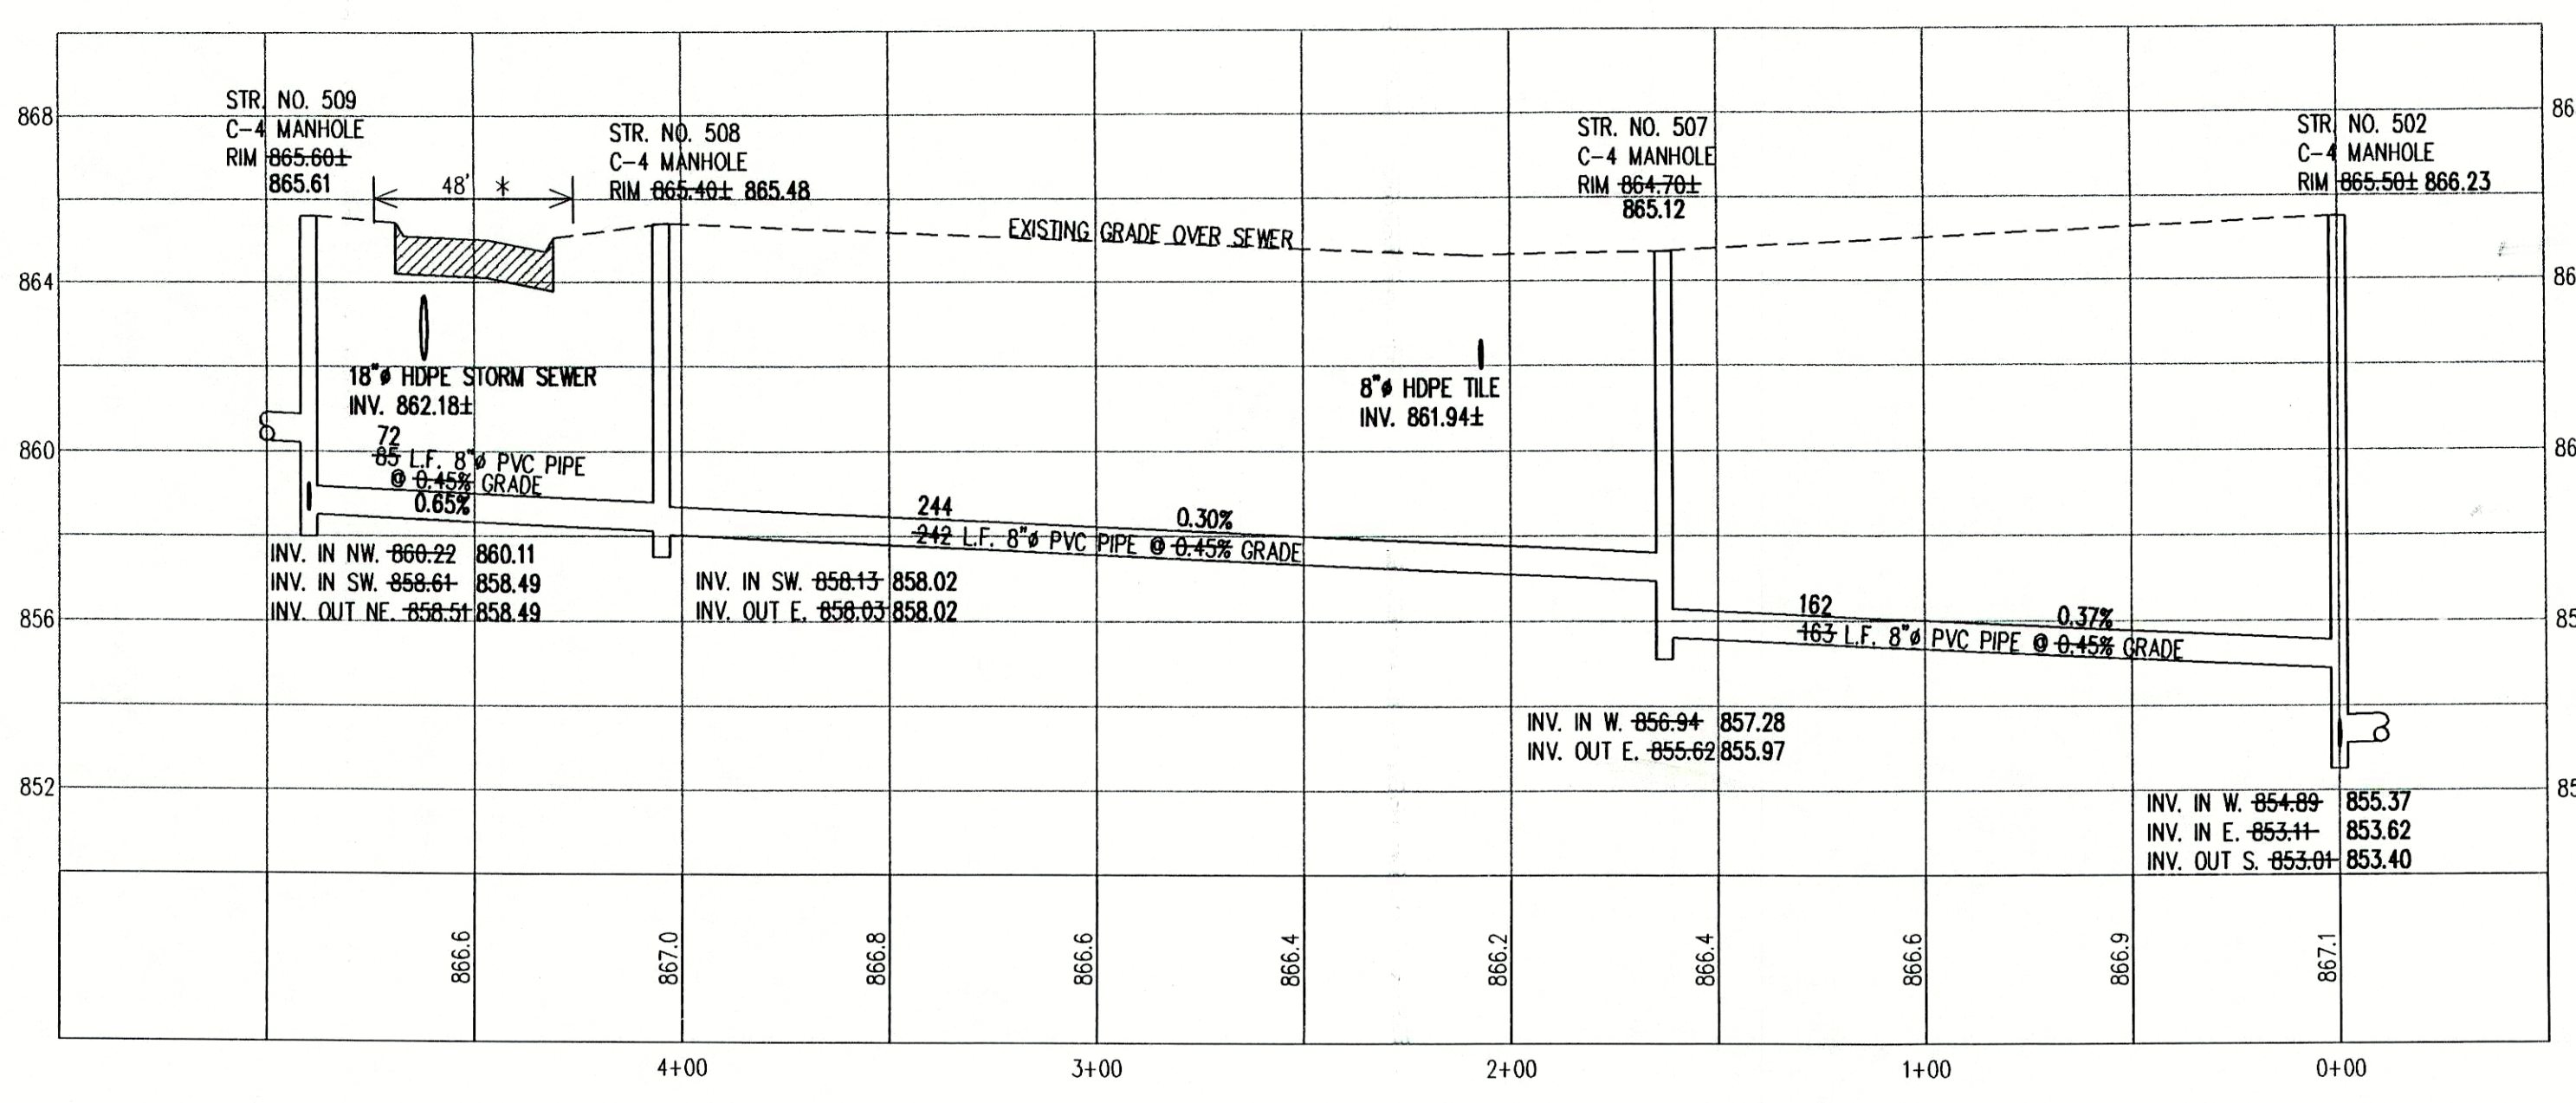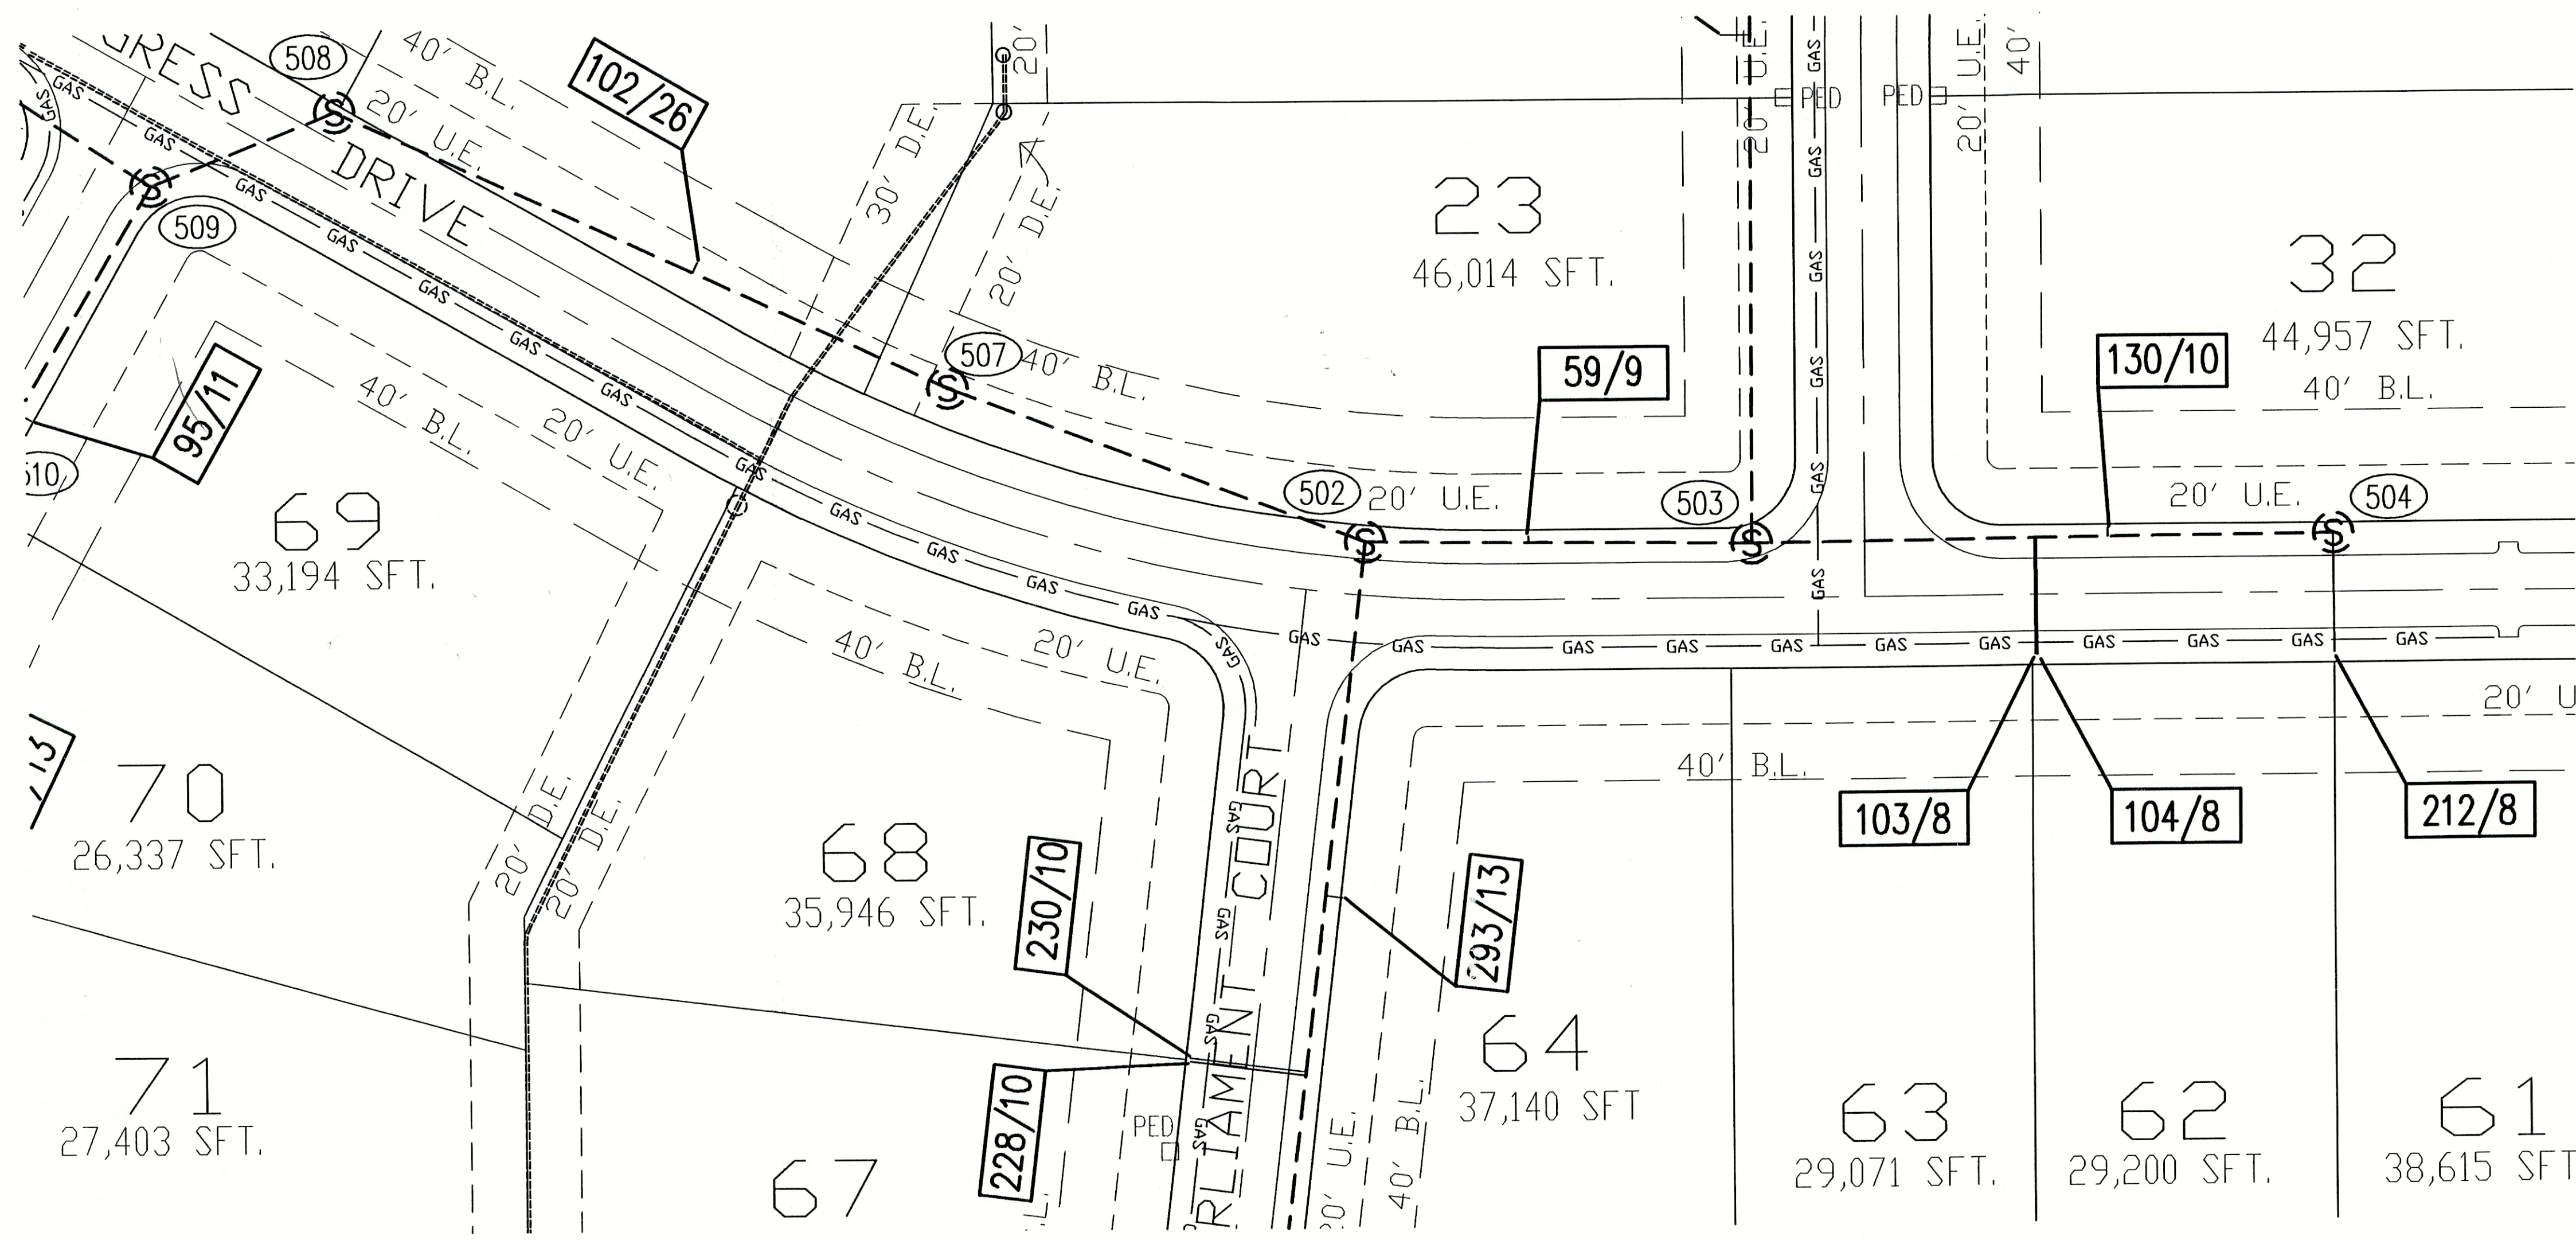

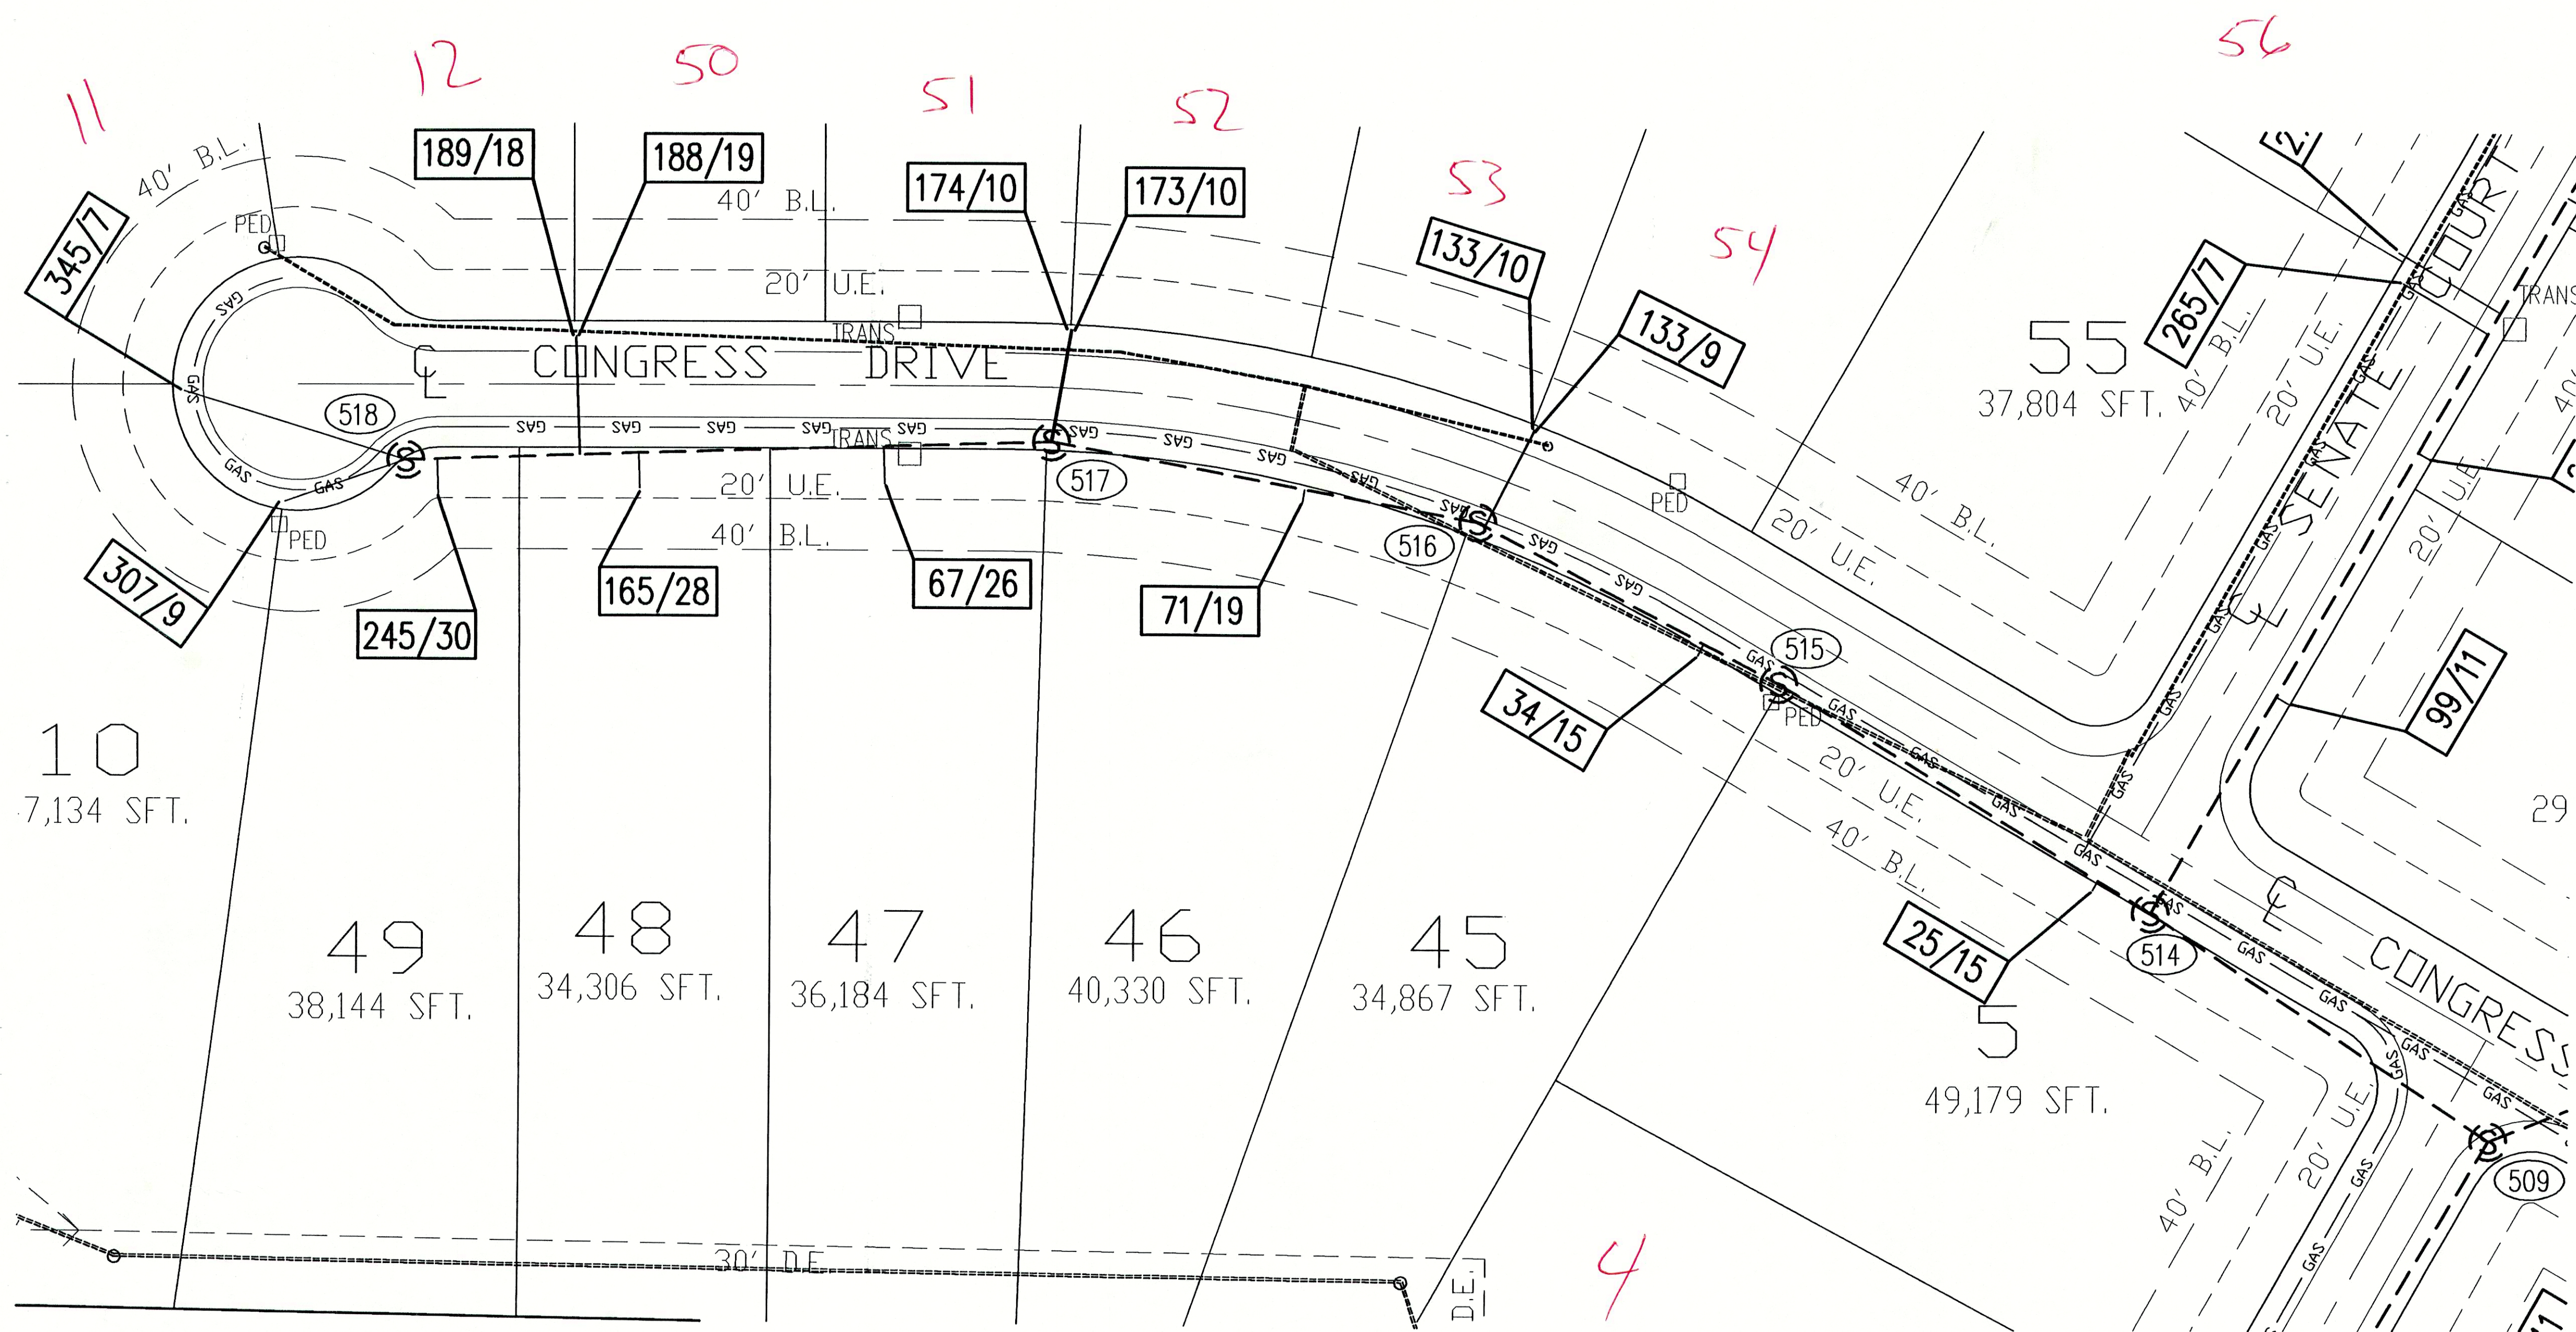

SCALE: HOR. 1" = 40'
VER. 1" = 4'

LEGEND

- S --- PROPOSED SANITARY SEWER
- S --- EXISTING STORM SEWER
- * GRANULAR BACKFILL REQUIRED IF OPEN CUT


TBM #1 - RAILROAD SPIKE IN EAST SIDE OF POWER POLE #077930 AT SOUTHWEST QUADRANT OF S.R. 38 AND COUNTY ROAD 600 WEST. ELEV. 864.74

GENERAL NOTES:

- ALL STATIONING IS FROM THE NEAREST DOWNSTREAM MANHOLE (M.H.).
- ALL PIPE LENGTHS ARE FROM THE CENTER OF STRUCTURE TO CENTER OF STRUCTURE.
- LATERALS FIELD MARKED WITH 2"x4" 'S' PAINTED GREEN. NONE FOUND ON LOTS 25, 27, & 65.


AS-BUILT SANITARY LATERALS

DISTANCE FROM DOWNSTREAM MANHOLE
DISTANCE FROM BACK OF CURB

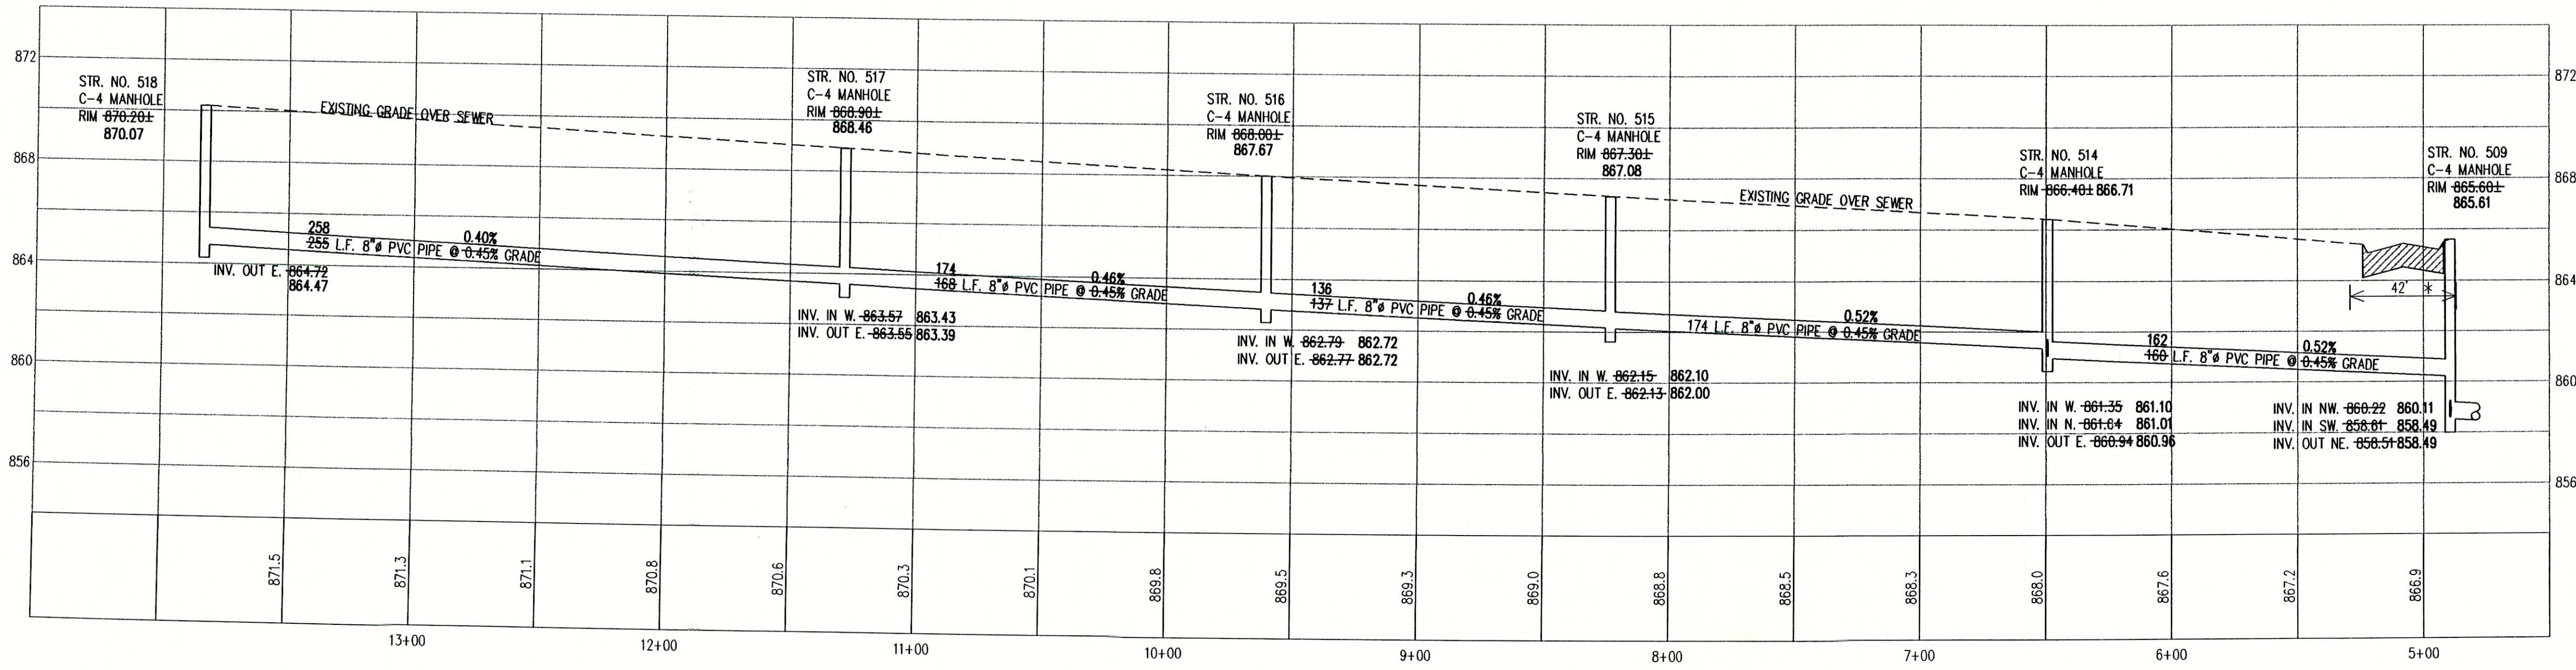

AS-BUILT SANITARY SEWER
PLAN & PROFILE

JEFFERSON PLACE
GREEN TOWNSHIP
MADISON COUNTY, INDIANA

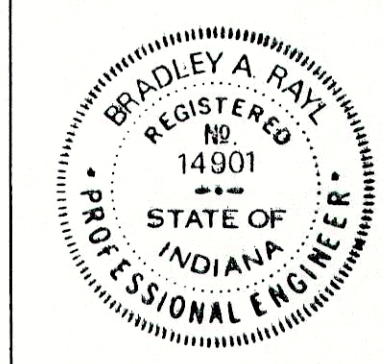

BY: *Bradley A. Rayl*
DATE: 5-9-00

SHEET


1940 E. 53RD STREET
ANDERSON, INDIANA 46013
PH. (765) 643-5614
FAX (765) 643-1674

RAYL
SURVEYING
&
ENGINEERING, INC.

REVISIONS:

DATE: 5-9-00

DRAWN BY: J. ANDERSON

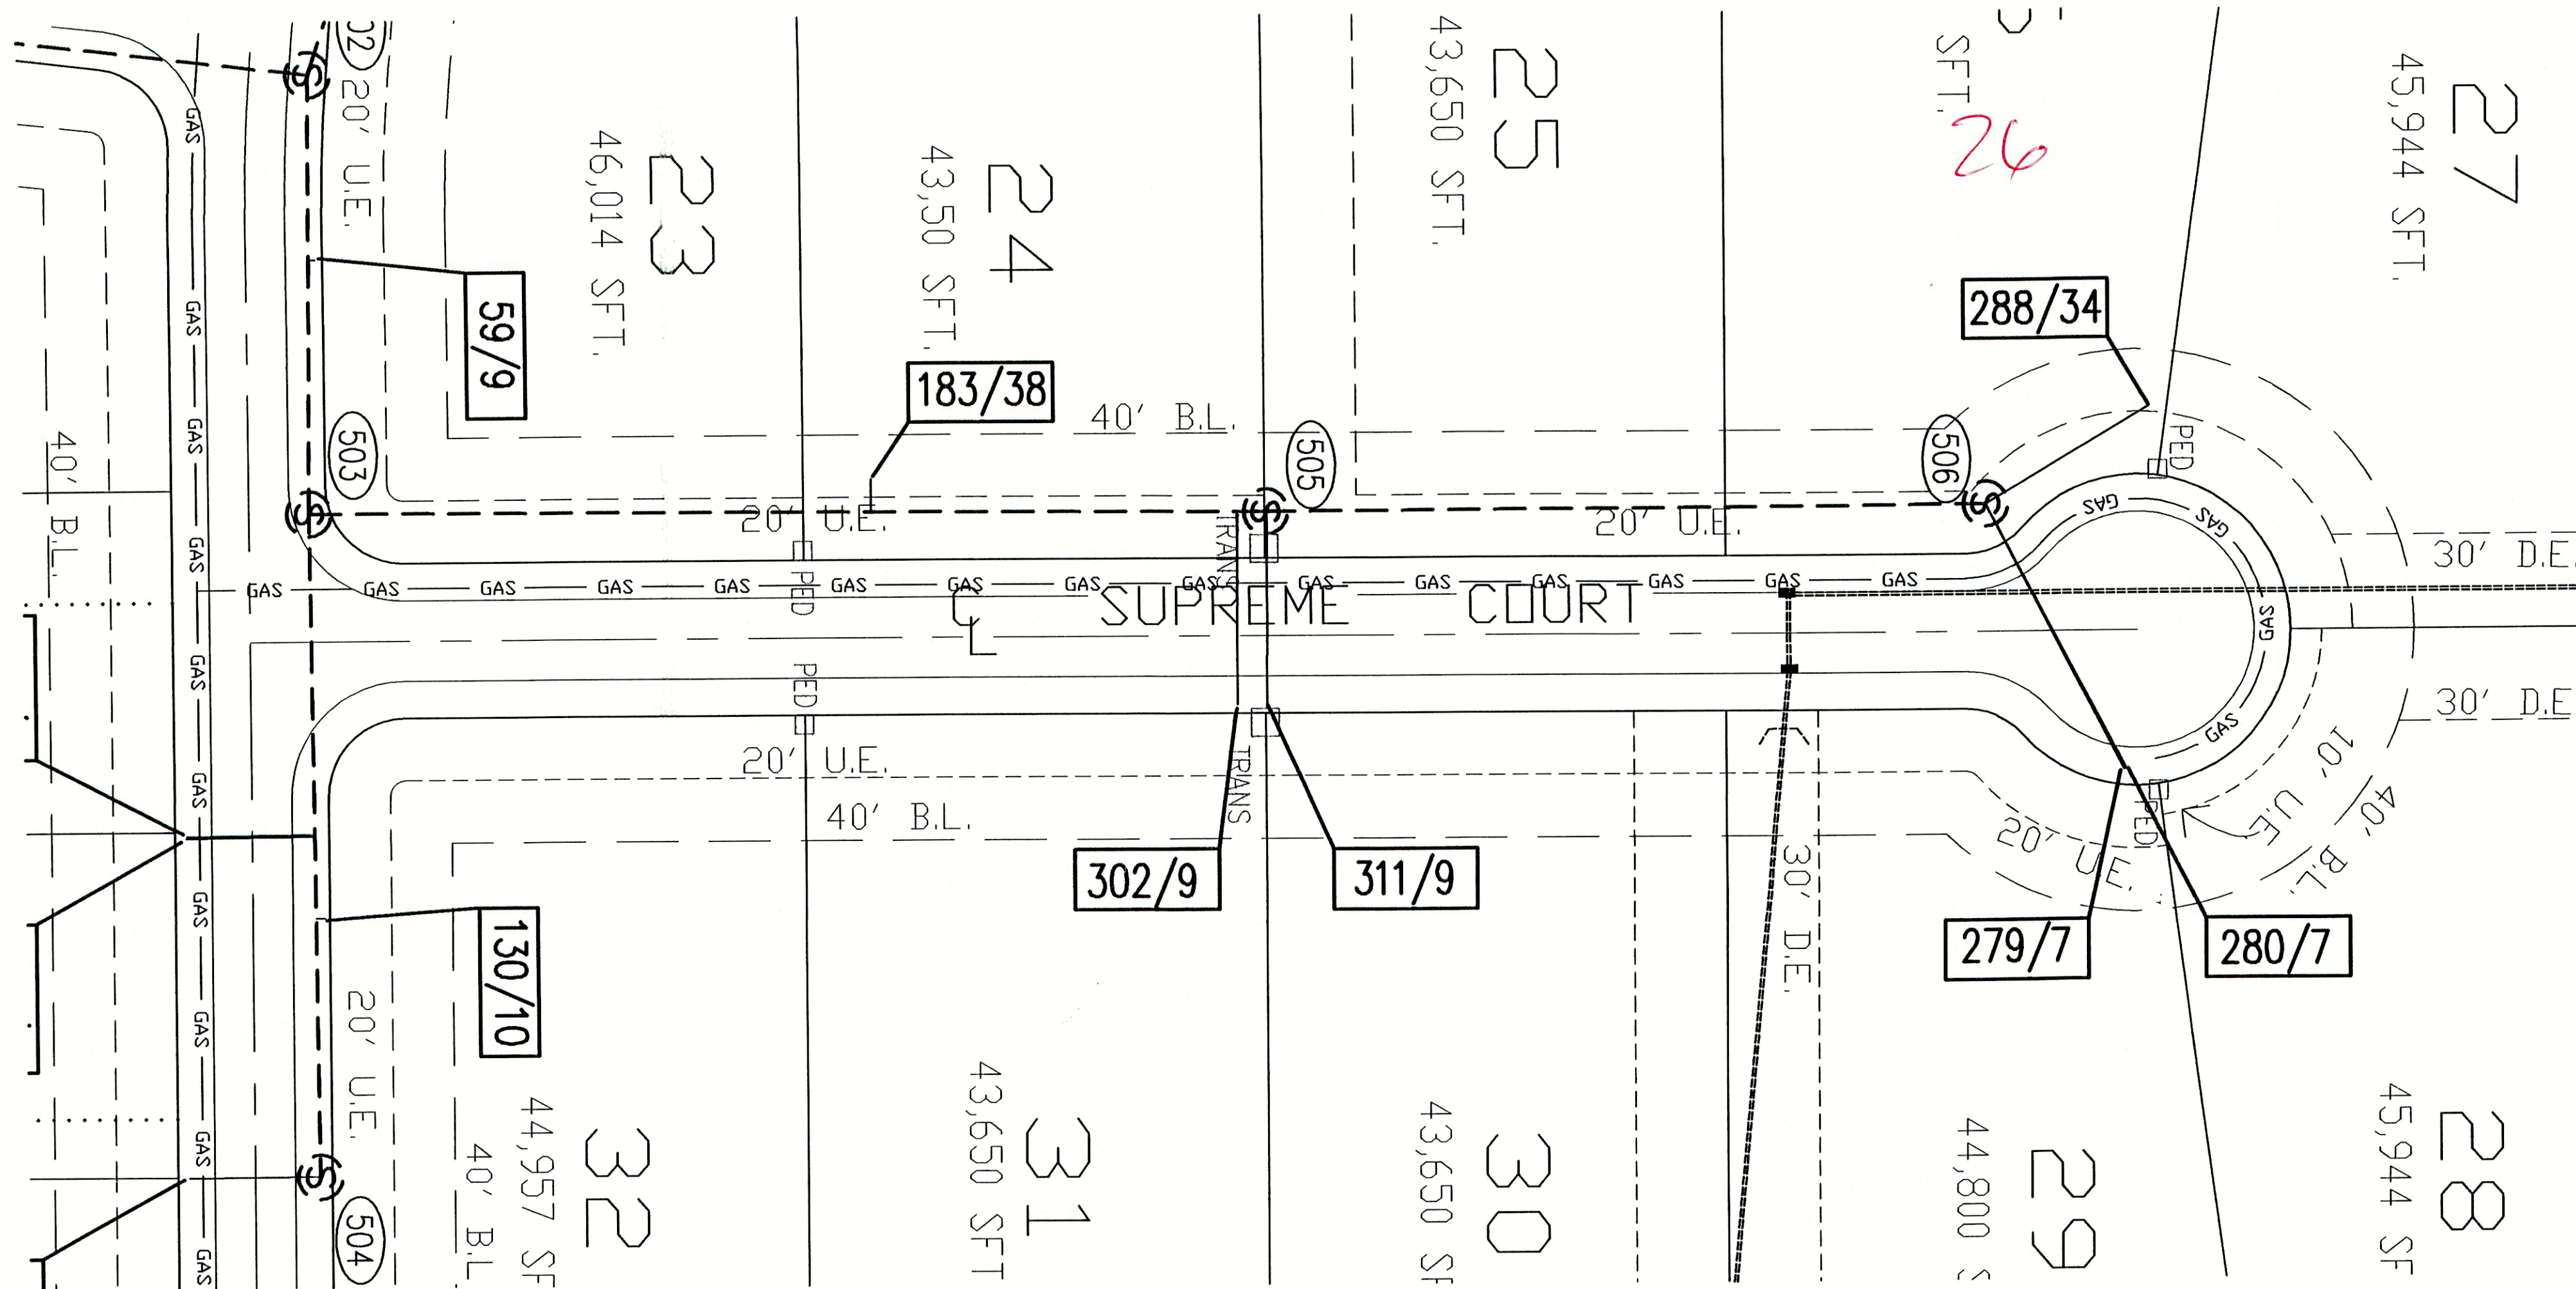

Z

SCALE: HOR. 1" = 40'
VER. 1" = 4'


LEGEND

- PROPOSED SANITARY SEWER
- EXISTING STORM SEWER
- GRANULAR BACKFILL REQUIRED IF OPEN CUT

TBM #1 - RAILROAD SPIKE IN EAST SIDE OF POWER POLE #077930 AT SOUTHWEST QUADRANT OF S.R. 38 AND COUNTY ROAD 600 WEST. ELEV. 864.74

AS-BUILT DRAWING

F.B. 138, PGS. 102-125
F.B. 160, PGS. 46-49

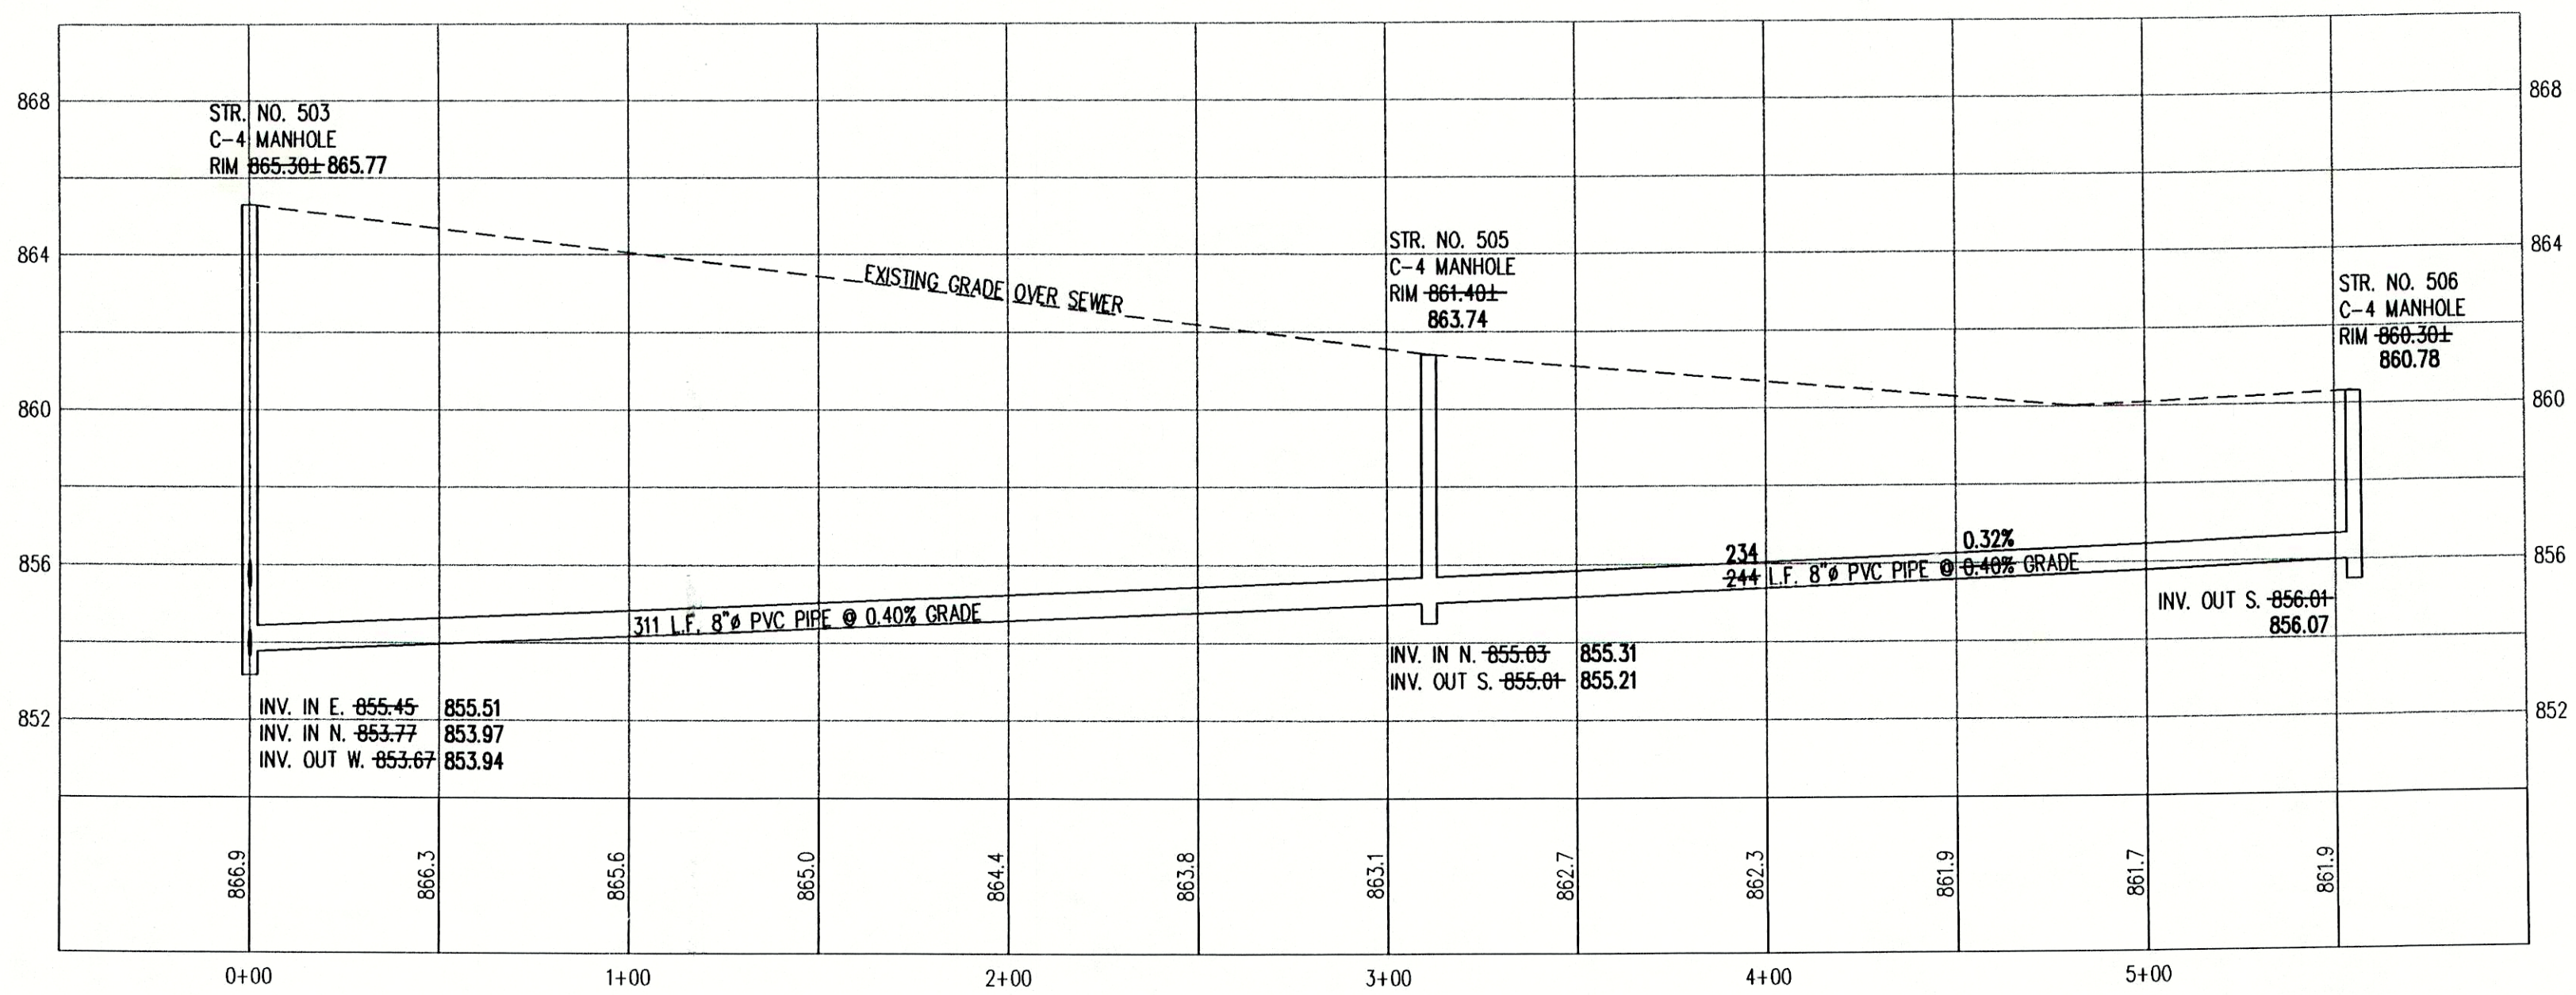

- GENERAL NOTES:
- ALL STATIONING IS FROM THE NEAREST DOWNSTREAM MANHOLE (M.H.)
 - ALL PIPE LENGTHS ARE FROM THE CENTER OF STRUCTURE TO CENTER OF STRUCTURE.
 - LATERALS FIELD MARKED WITH 2"x4" 'S' PAINTED GREEN. NONE FOUND ON LOTS 25, 27, & 65.

AS-BUILT SANITARY LATERALS

214/14

DISTANCE FROM DOWNSTREAM MANHOLE

DISTANCE FROM BACK OF CURB

1940 E. 53RD STREET
ANDERSON, INDIANA 46013
PH. (765) 643-5614
FAX (765) 643-1874

RAYL
SURVEYING & ENGINEERING, INC.

AS-BUILT SANITARY SEWER PLAN & PROFILE

REVISIONS:

**JEFFERSON PLACE
GREEN TOWNSHIP
MADISON COUNTY, INDIANA**

DRAWN BY: J. ANDERSON


DATE: 5-9-00

BY: *Bradley A. Rayl*

DATE: 5-9-00

SHEET

4 OF 6

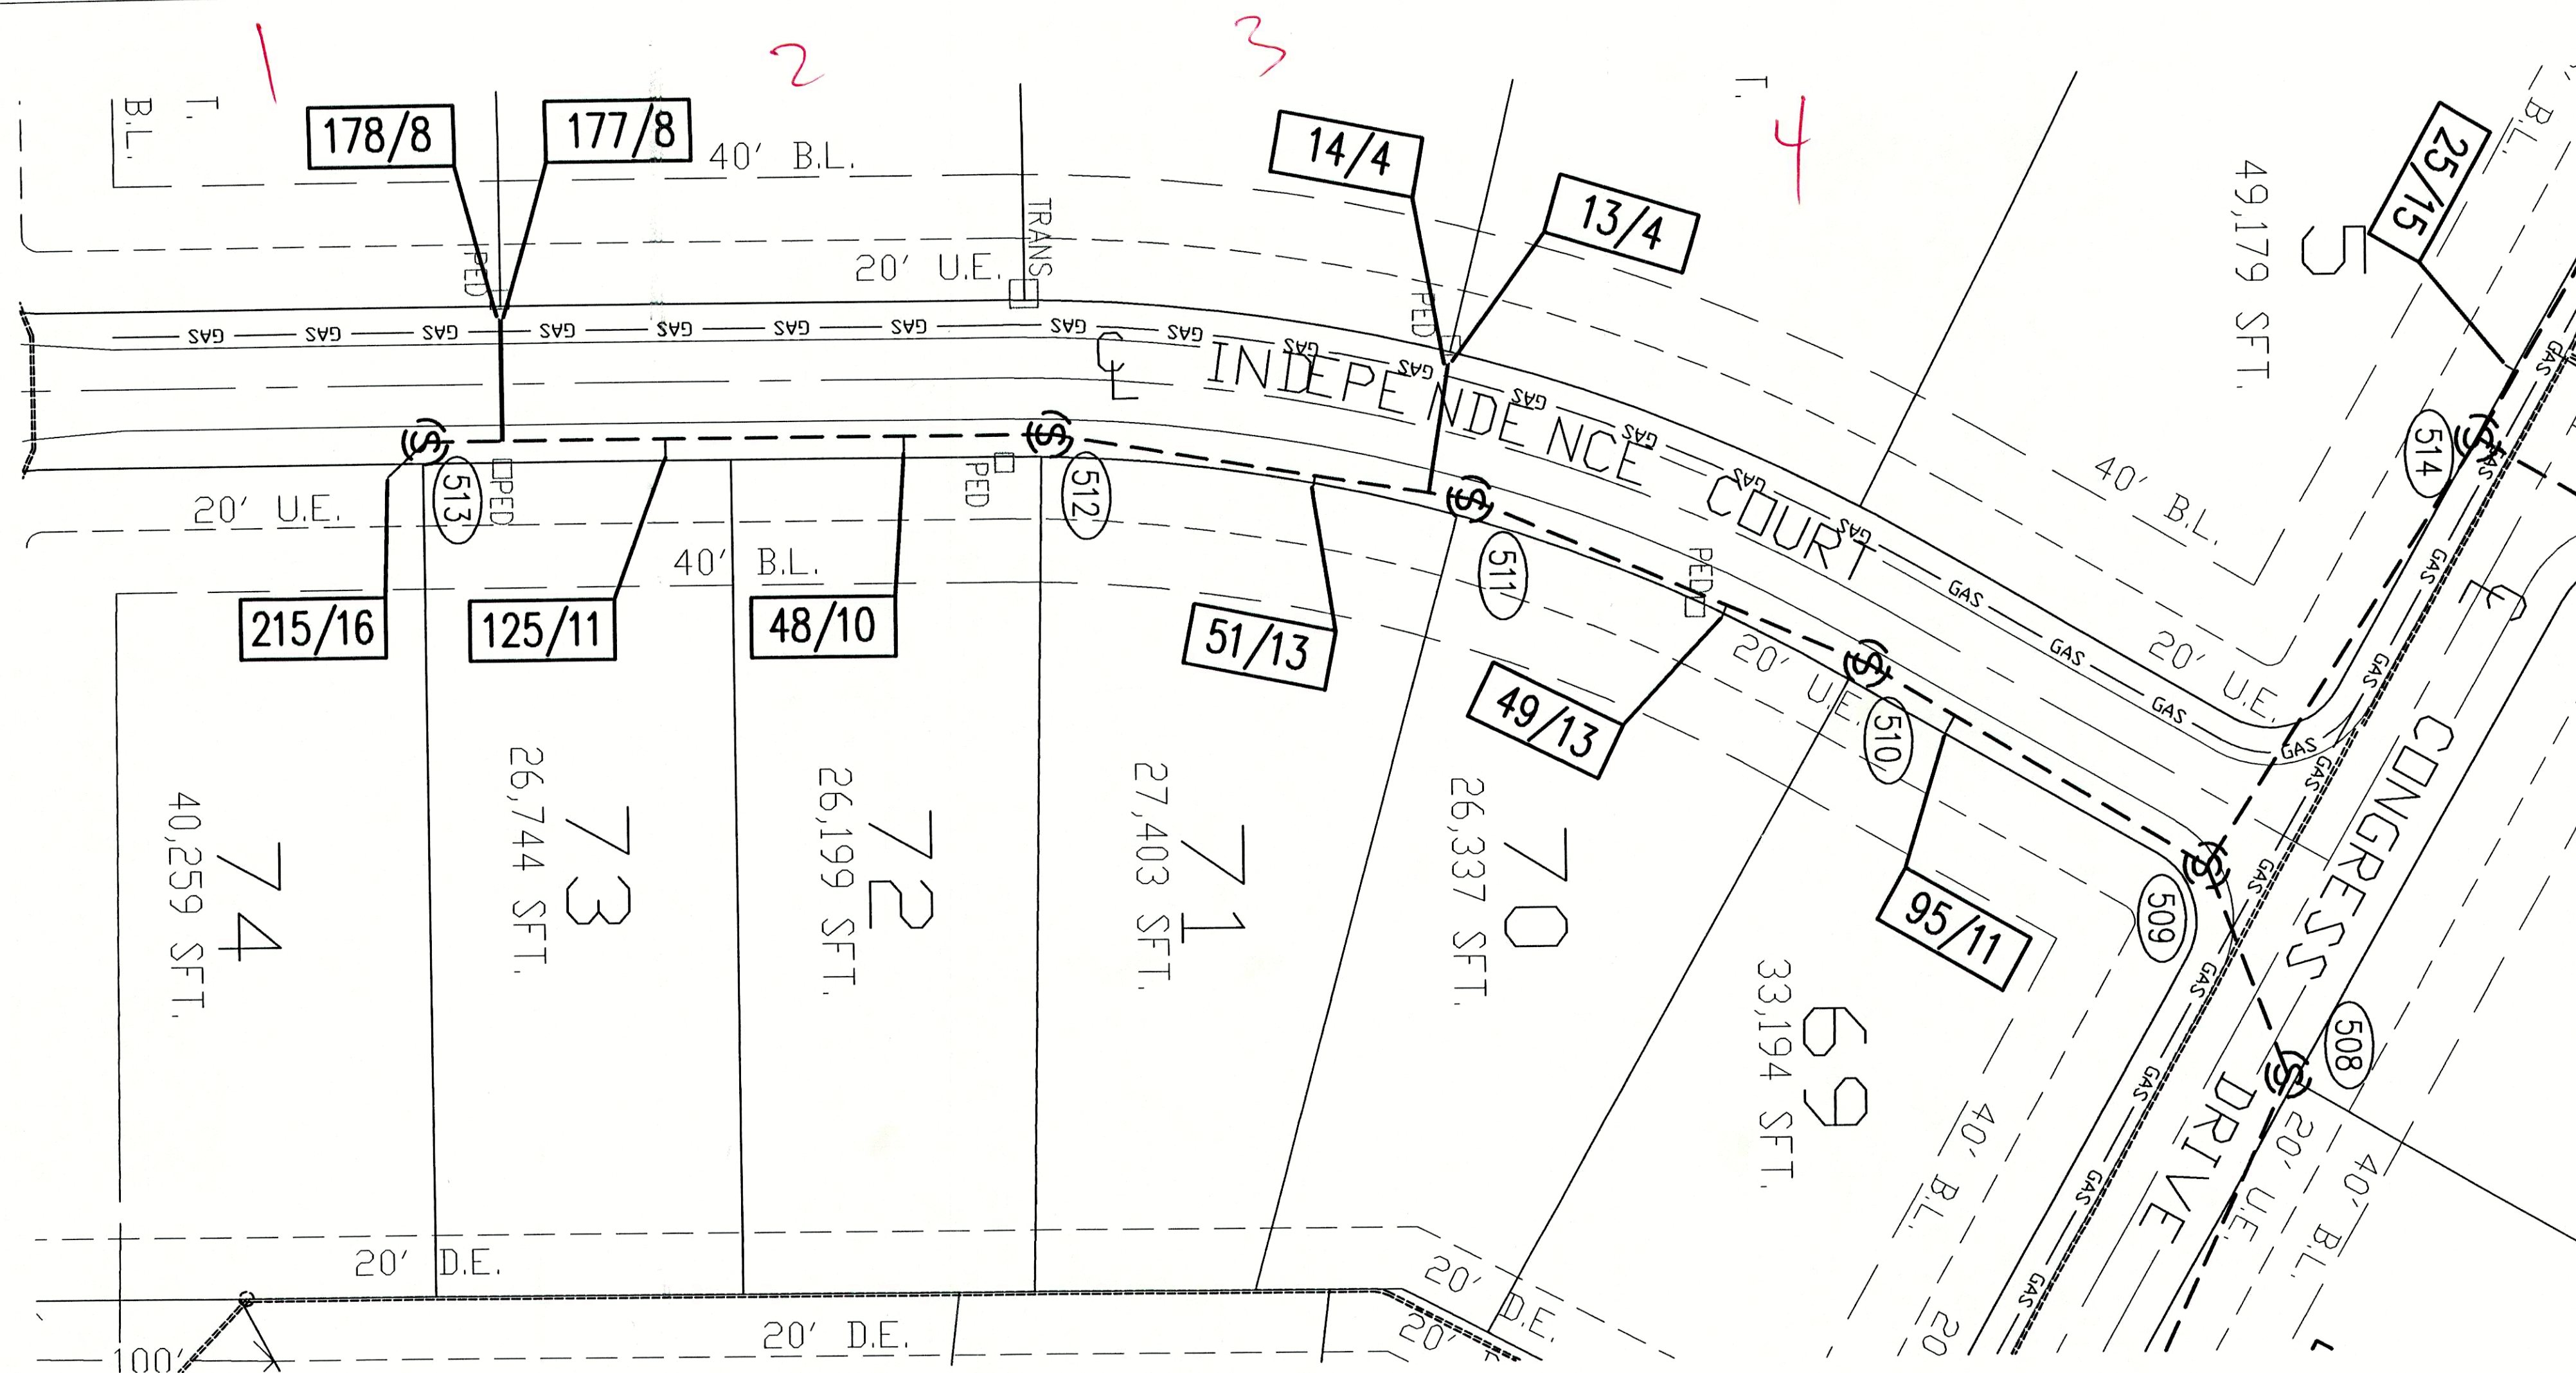

N

SCALE: HOR. 1" = 40'
VER. 1" = 4'


LEGEND

- PROPOSED SANITARY SEWER
- EXISTING STORM SEWER
- GRANULAR BACKFILL REQUIRED IF OPEN CUT

TBM #1 - RAILROAD SPIKE IN EAST SIDE OF POWER POLE #077930 AT SOUTHWEST QUADRANT OF S.R. 38 AND COUNTY ROAD 600 WEST. ELEV. 864.74

AS-BUILT
DRAWING

F.B. 138, PGS. 102-125
F.B. 160, PGS. 46-49

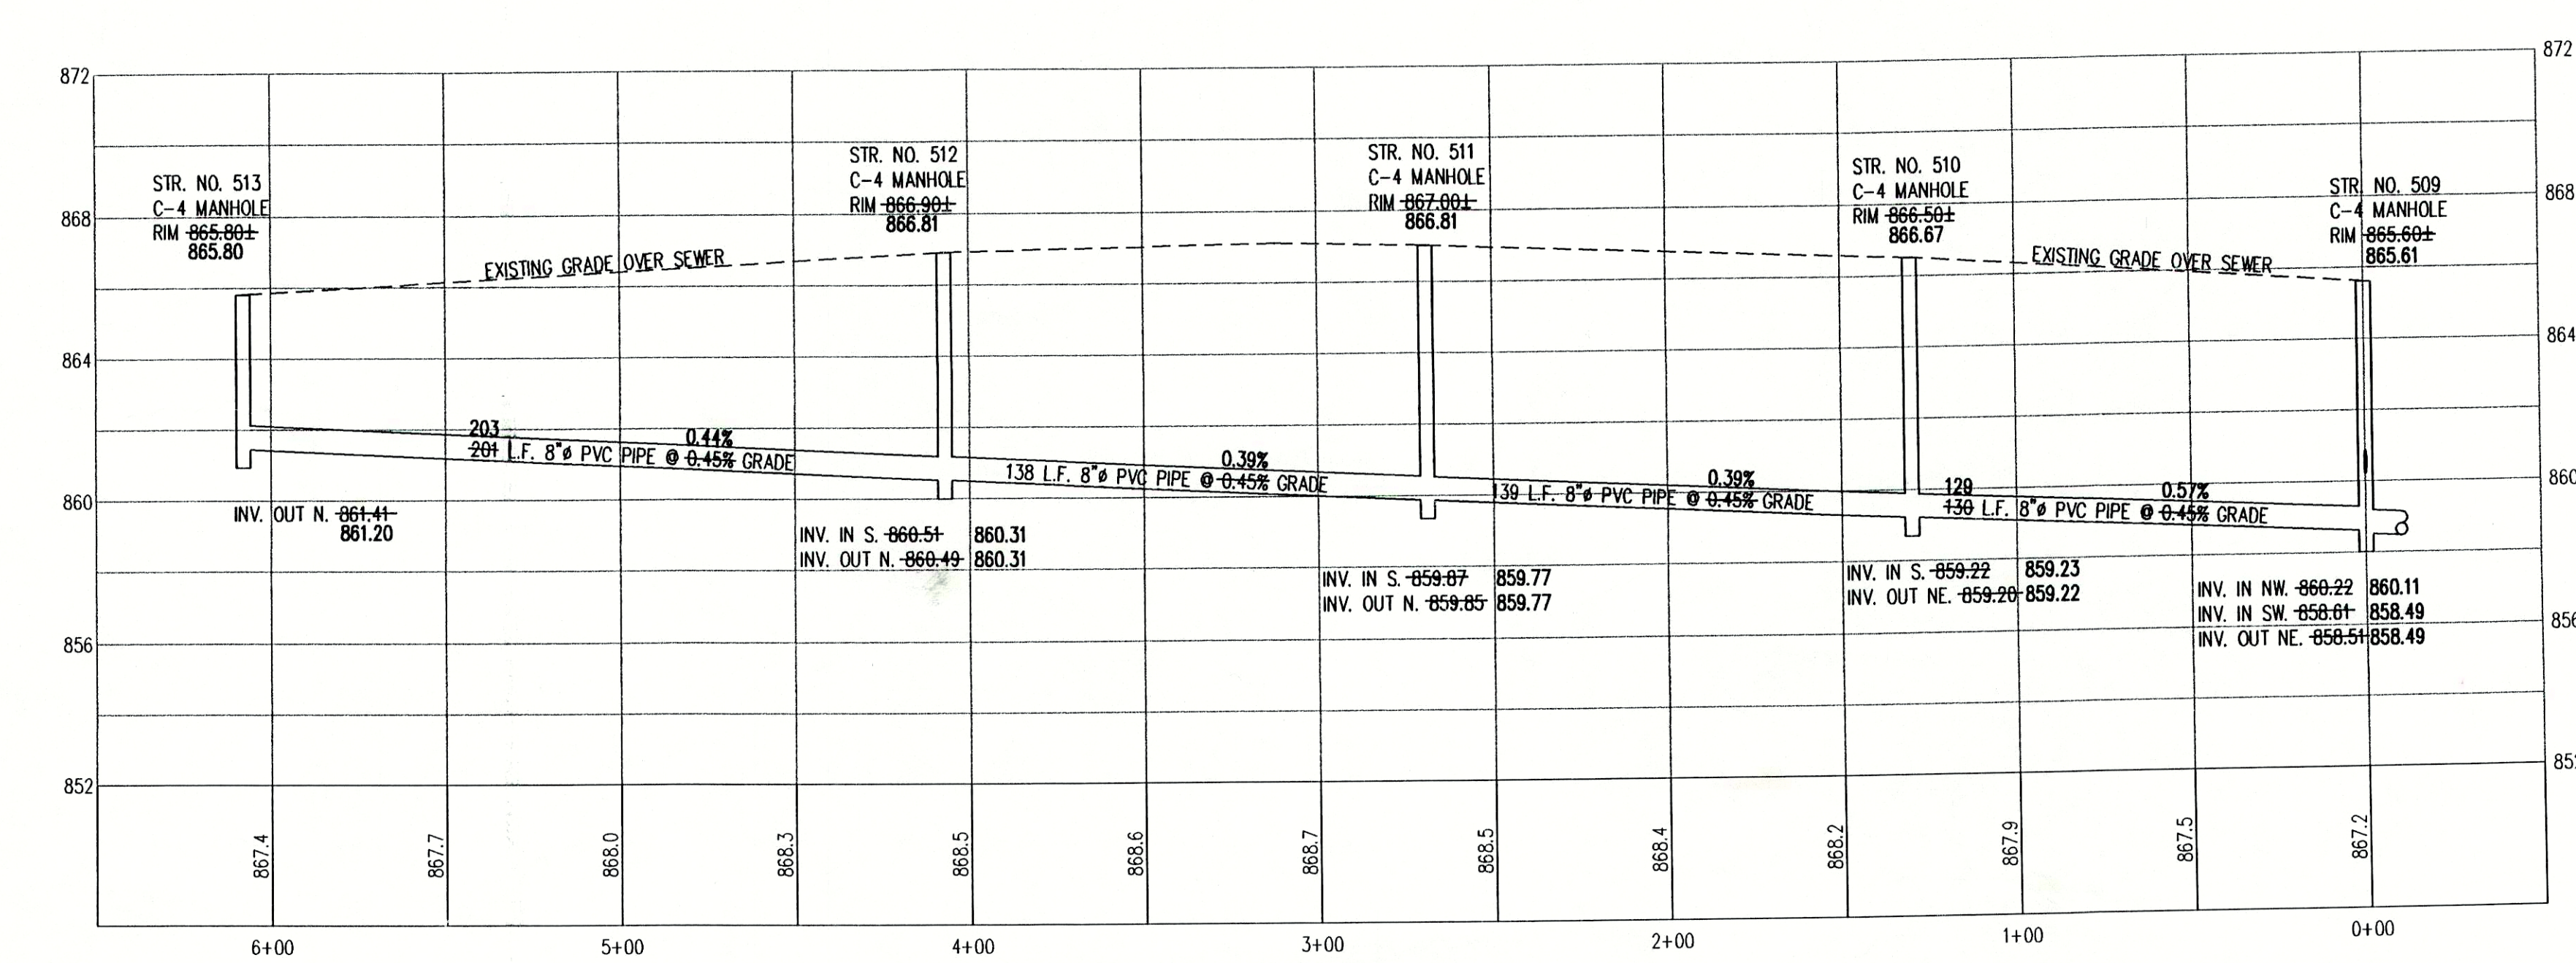

GENERAL NOTES:

- ALL STATIONING IS FROM THE NEAREST DOWNSTREAM MANHOLE (M.H.)
- ALL PIPE LENGTHS ARE FROM THE CENTER OF STRUCTURE TO CENTER OF STRUCTURE.
- LATERALS FIELD MARKED WITH 2"x4" 'S PAINTED GREEN. NONE FOUND ON LOTS 25, 27, & 65.

AS-BUILT SANITARY LATERALS

214/14

DISTANCE FROM DOWNSTREAM MANHOLE

DISTANCE FROM BACK OF CURB

1440 E. 59RD STREET
ANDERSON, INDIANA 46013
PH. (765) 643-5614
FAX (765) 643-1874

RAYL
SURVEYING & ENGINEERING, INC.

AS-BUILT SANITARY SEWER
PLAN & PROFILE

JEFFERSON PLACE
GREEN TOWNSHIP
MADISON COUNTY, INDIANA

DATE: 5-9-00

DRAWN BY: J. ANDERSON

BY: *Bradley A. Rayl*

DATE: 5-9-00


SHEET

5 OF 6

REGISTERED PROFESSIONAL ENGINEER

STATE OF INDIANA

NO. 14901

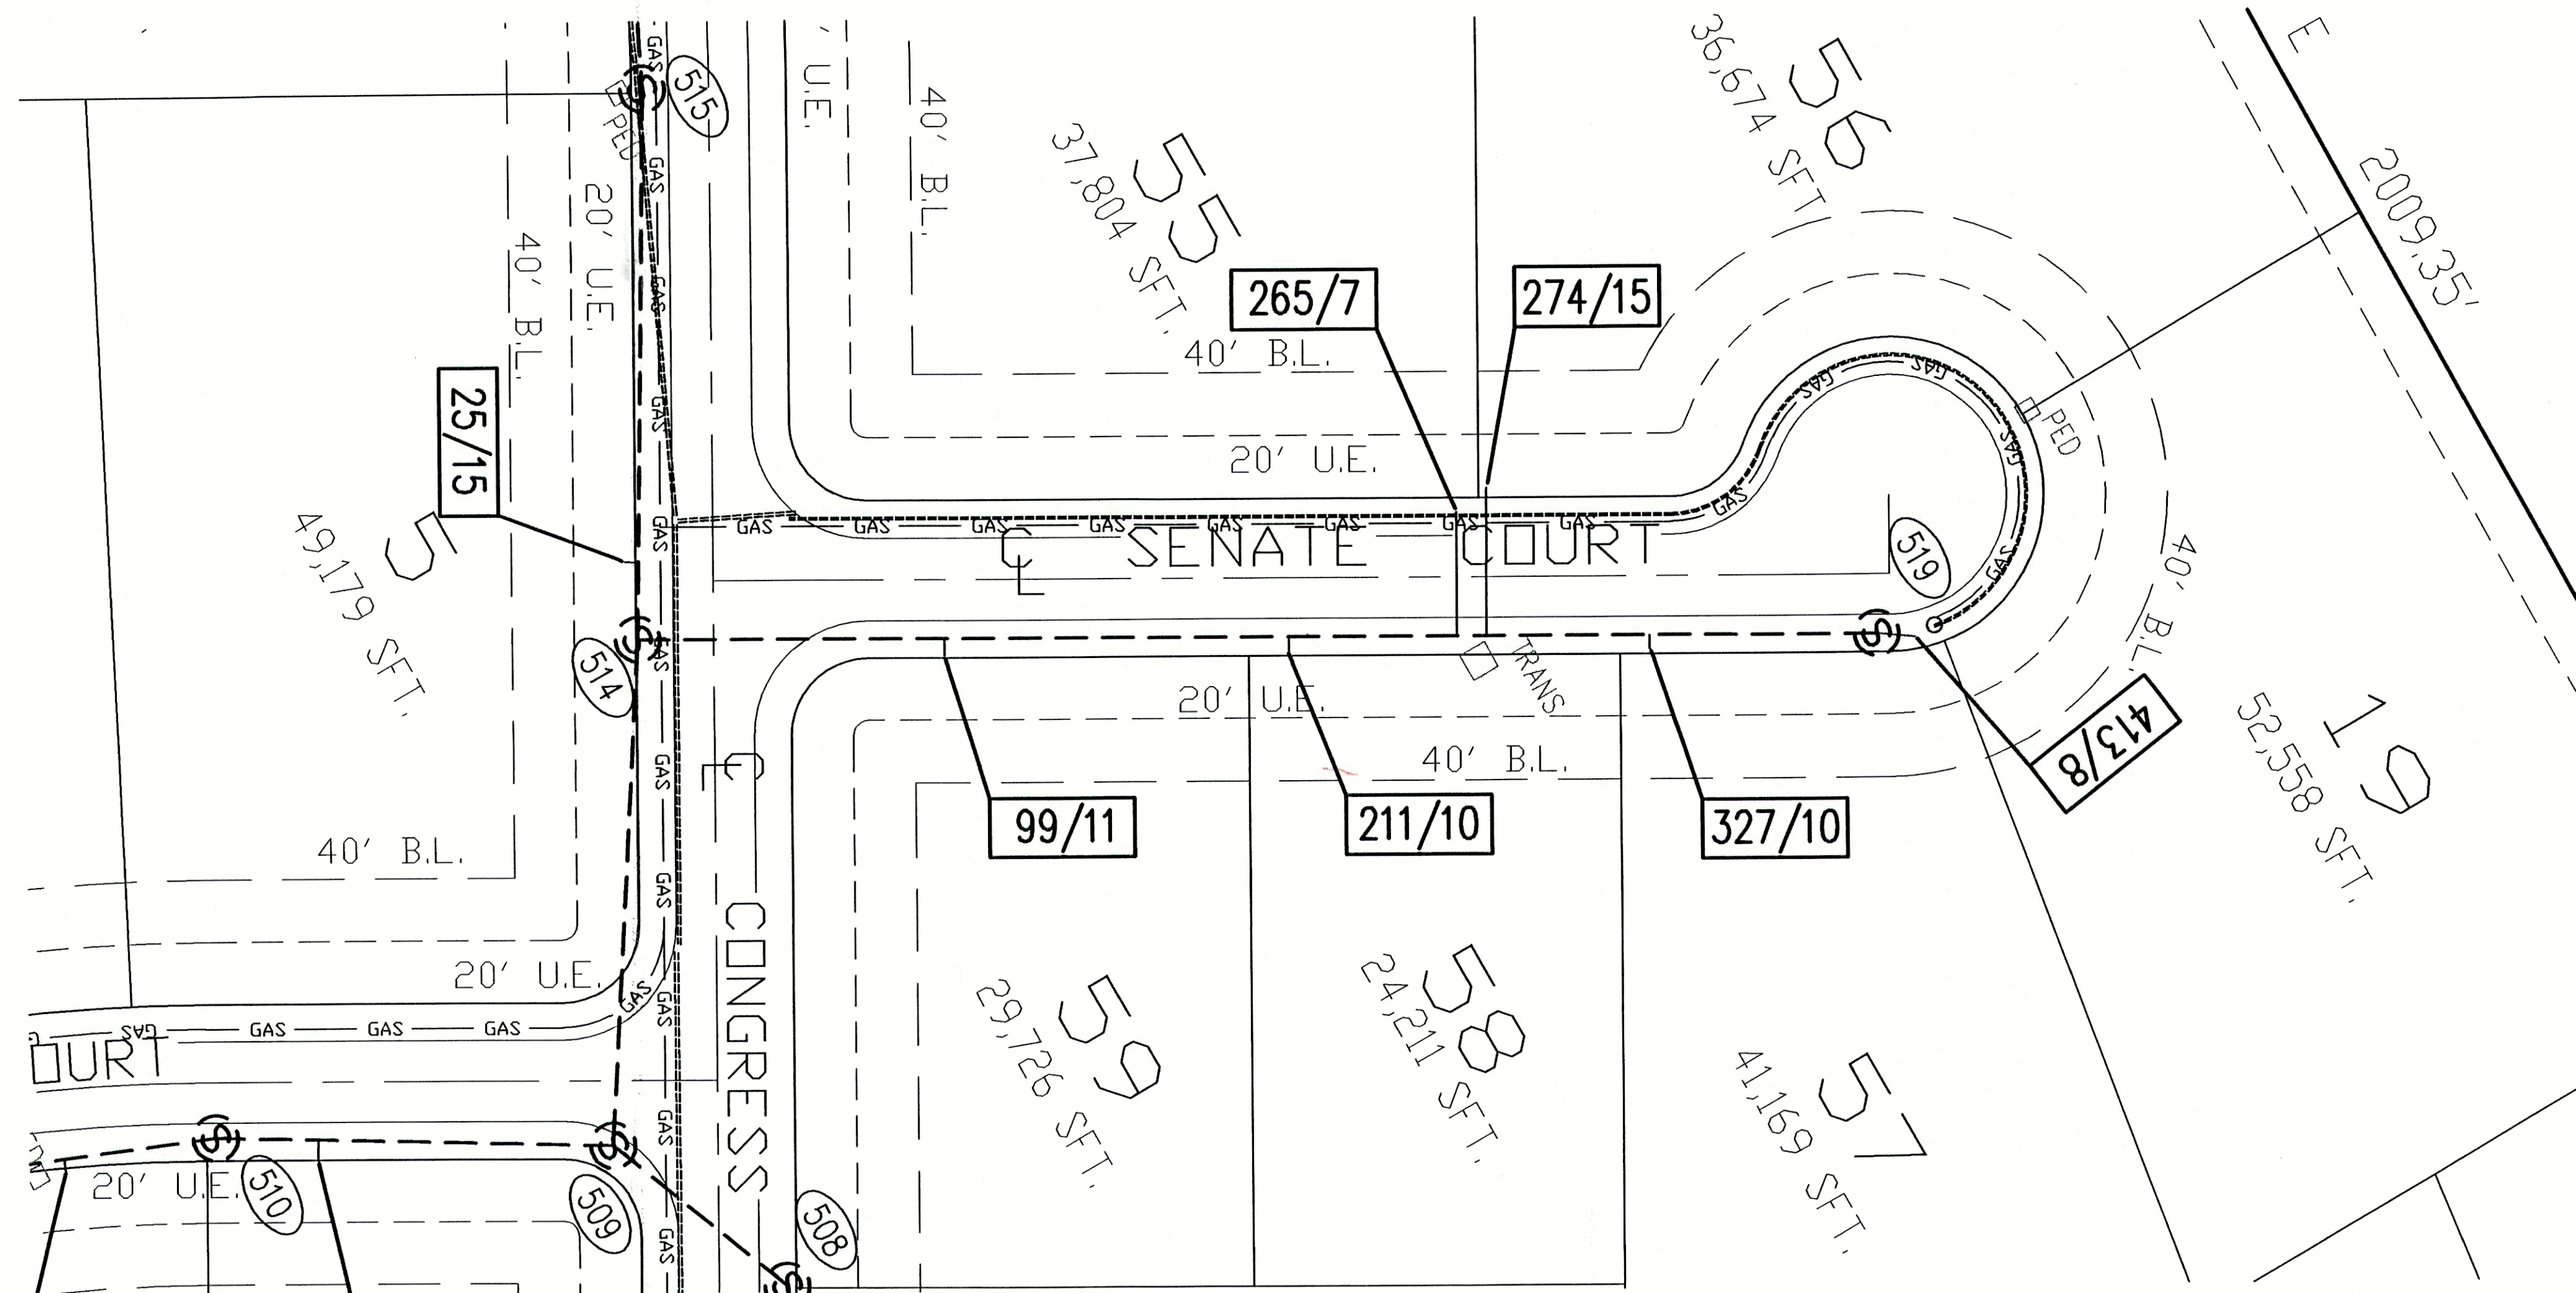

SCALE: HOR. 1" = 40'
VER. 1" = 4'


LEGEND

- (S) — PROPOSED SANITARY SEWER
- (S) — EXISTING STORM SEWER
- * GRANULAR BACKFILL REQUIRED IF OPEN CUT

TBM #1 - RAILROAD SPIKE IN EAST SIDE OF POWER POLE #077930 AT SOUTHWEST QUADRANT OF S.R. 38 AND COUNTY ROAD 600 WEST. ELEV. 864.74

AS-BUILT
DRAWING

F.B. 138, PGS. 102-125
F.B. 160, PGS. 46-49

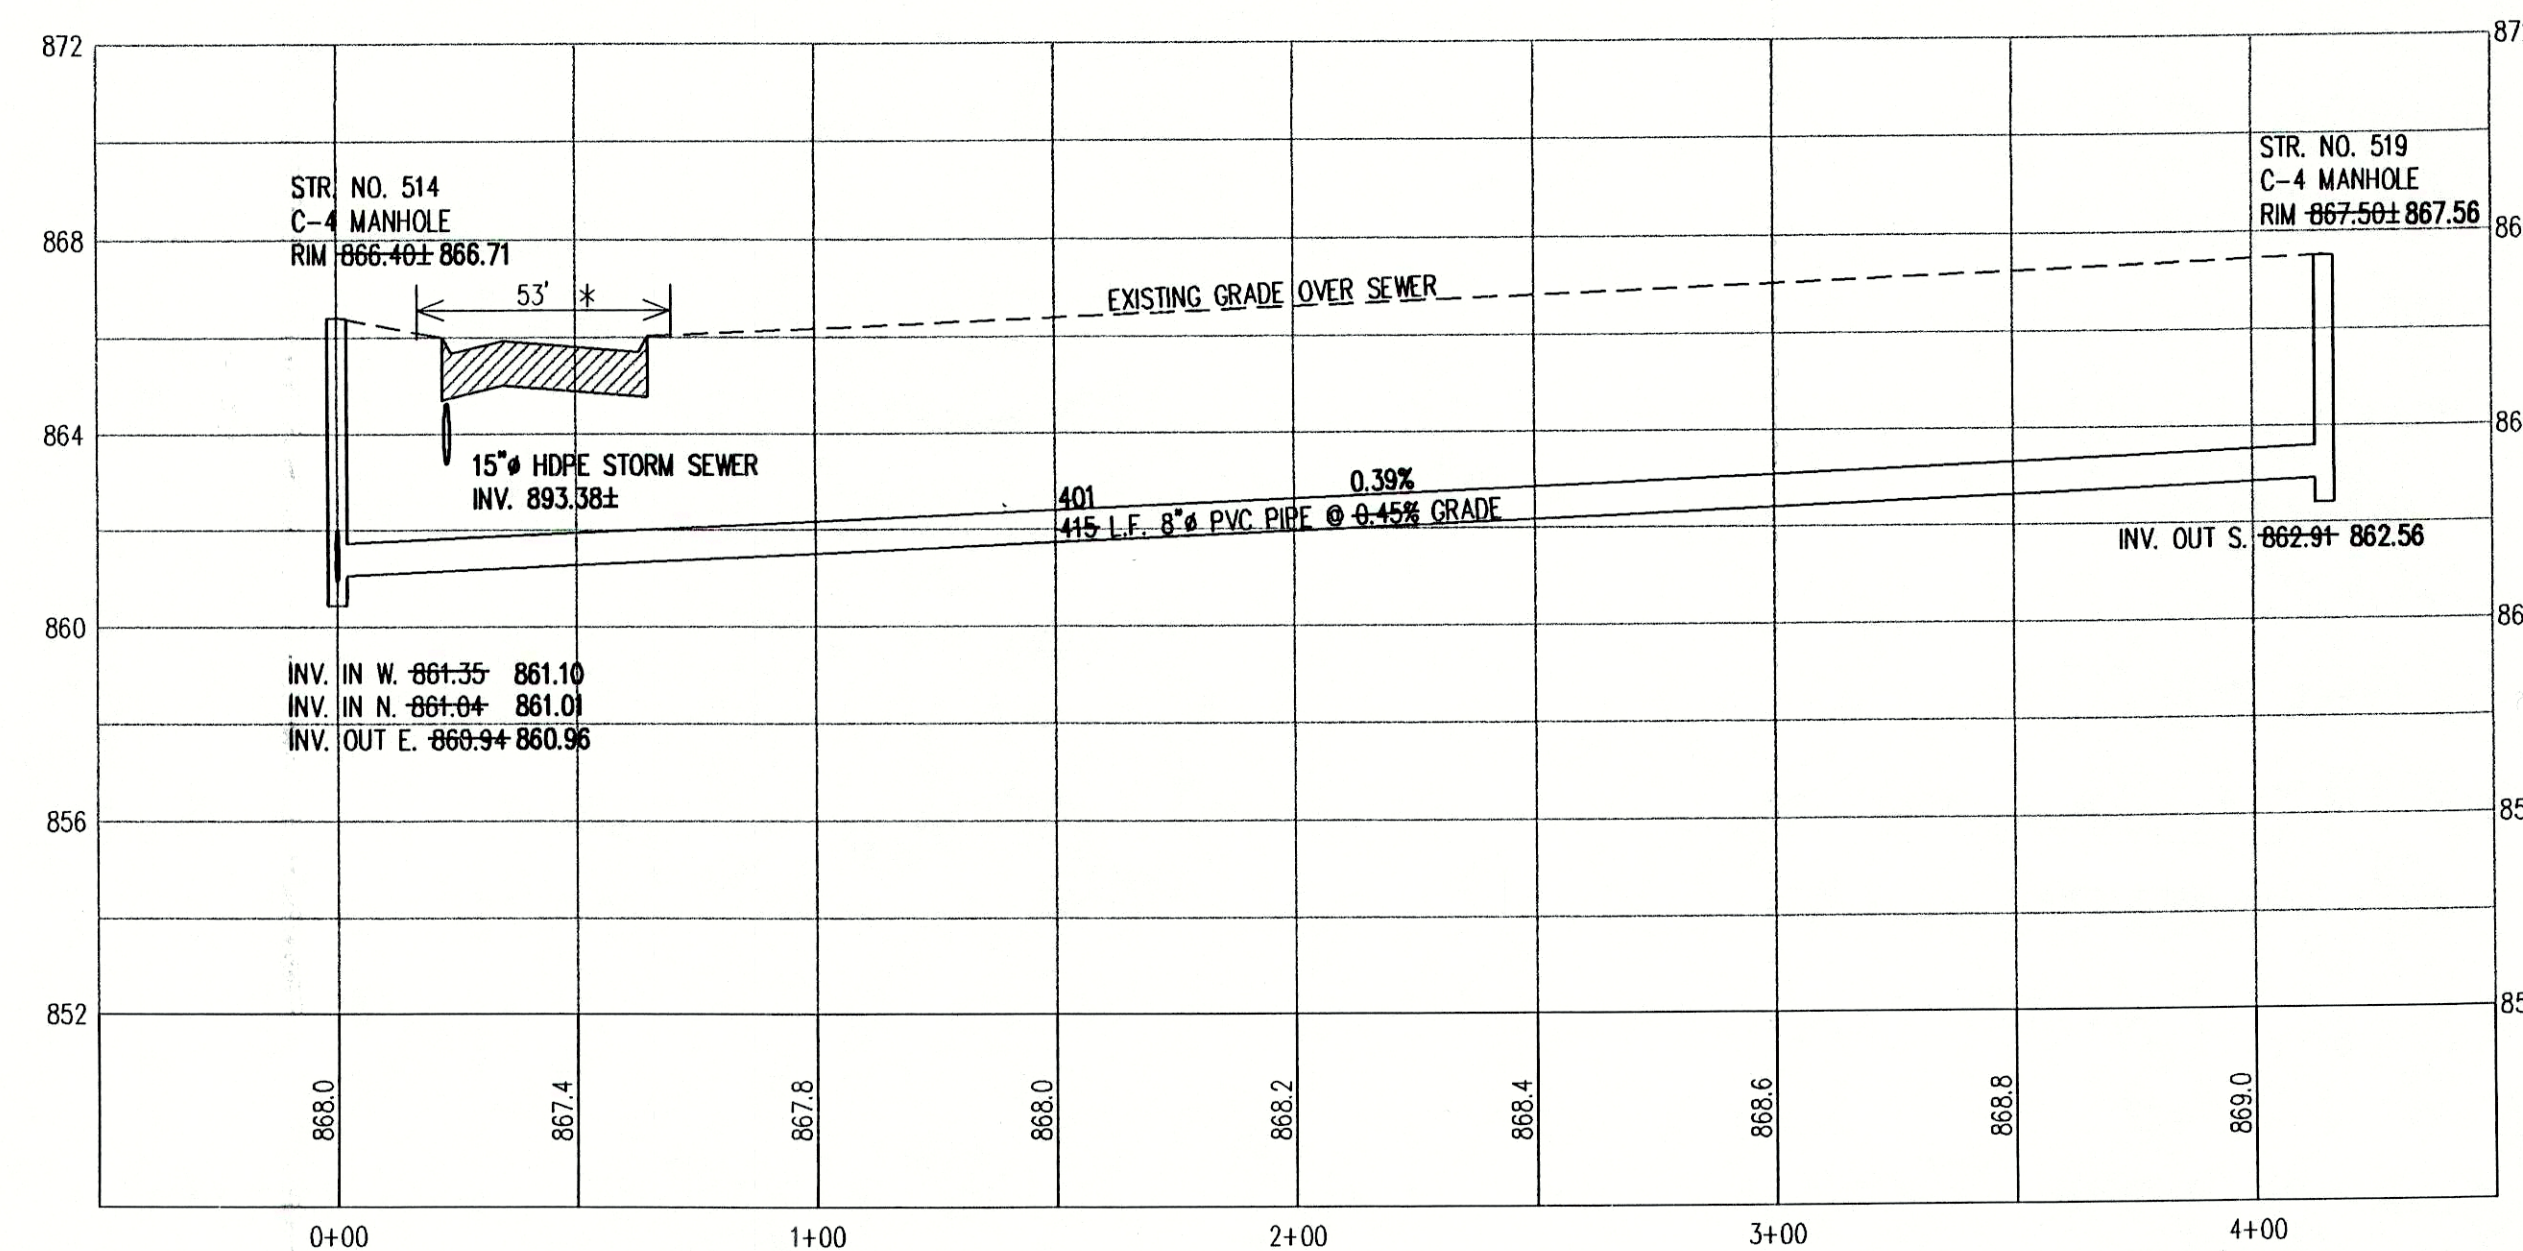

GENERAL NOTES:

- ALL STATIONING IS FROM THE NEAREST DOWNSTREAM MANHOLE (M.H.)
- ALL PIPE LENGTHS ARE FROM THE CENTER OF STRUCTURE TO CENTER OF STRUCTURE.
- LATERALS FIELD MARKED WITH 2"x4" 'S' PAINTED GREEN. NONE FOUND ON LOTS 25, 27, & 65.

AS-BUILT SANITARY LATERALS

214/14
DISTANCE FROM DOWNSTREAM MANHOLE
DISTANCE FROM BACK OF CURB


AS-BUILT SANITARY SEWER PLAN & PROFILE

REVISIONS:

JEFFERSON PLACE
GREEN TOWNSHIP
MADISON COUNTY, INDIANA

DATE: 5 - 9 - 00

DRAWN BY: J. ANDERSON

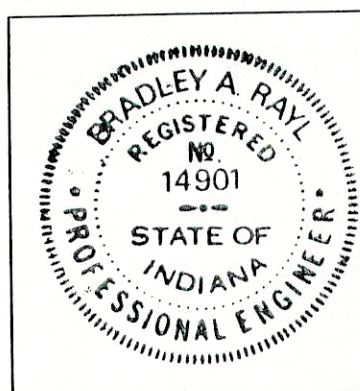

BY: *Bradley A. Ray*
DATE: 5-9-00

SHEET

6 OF 6