


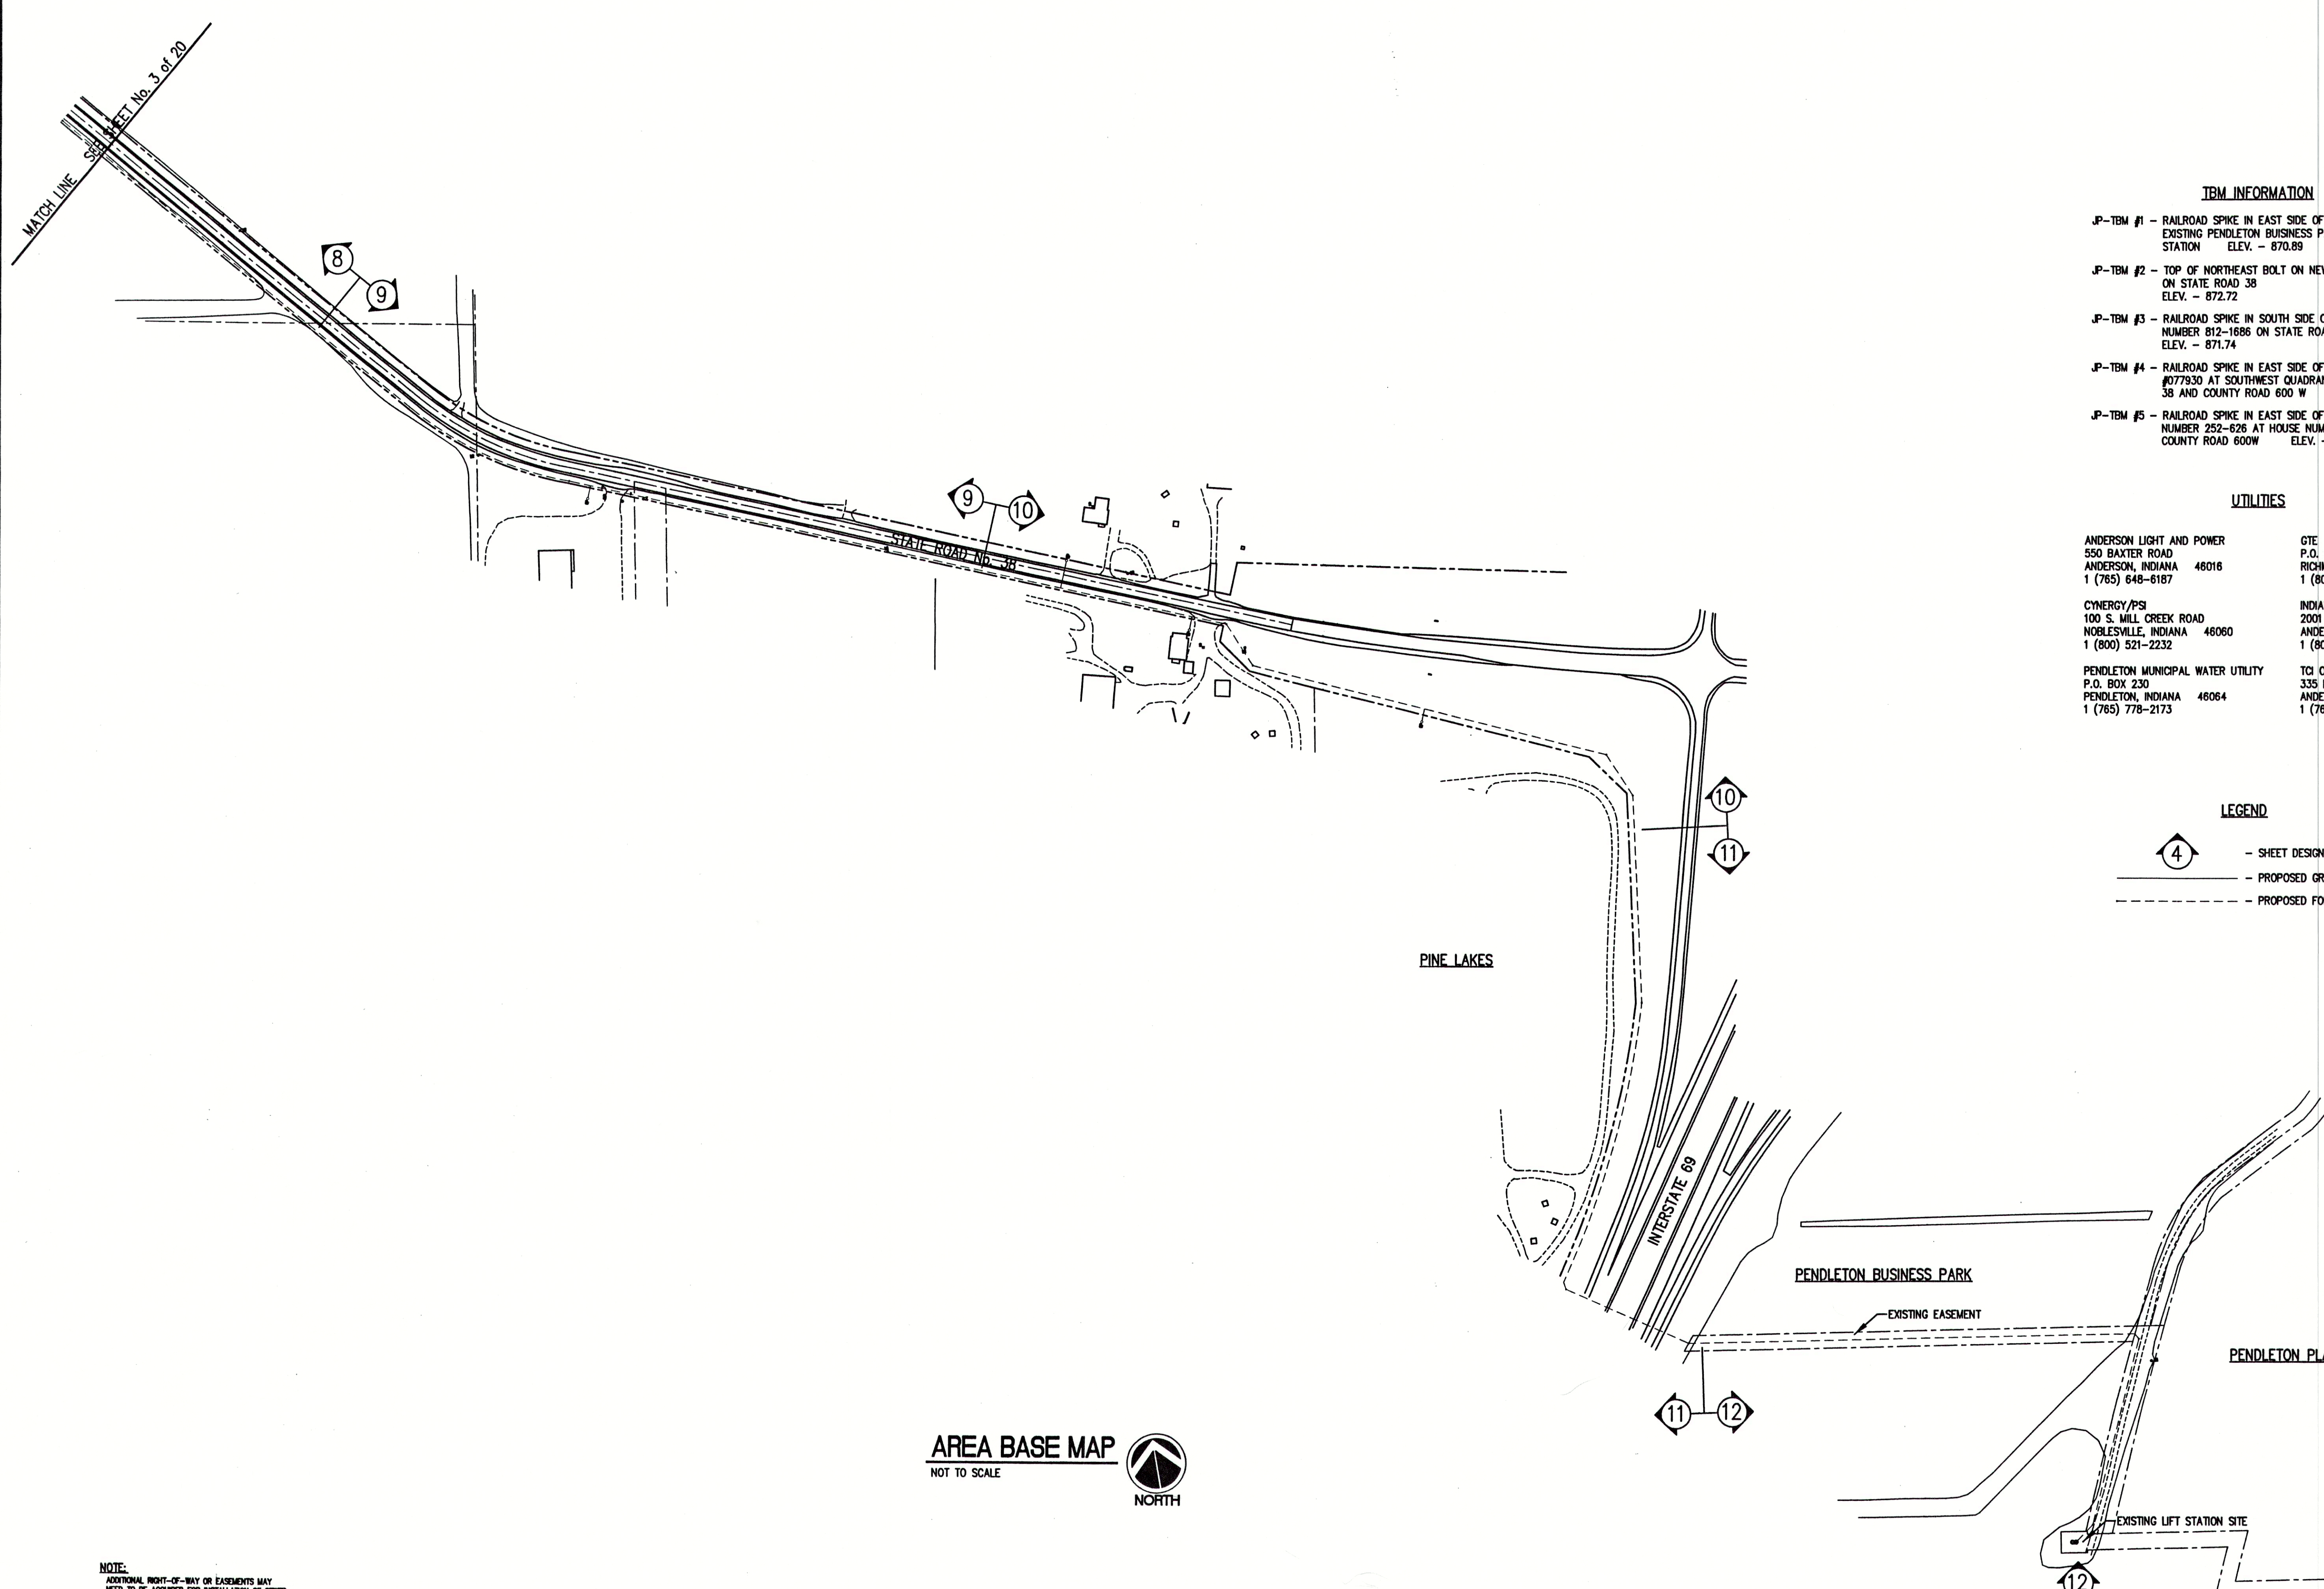

TBM INFORMATION

- JP-TBM #1 - RAILROAD SPIKE IN EAST SIDE OF POWERPOLE AT EXISTING PENDLETON BUSINESS PARK LIFT STATION ELEV. - 870.89
- JP-TBM #2 - TOP OF NORTHEAST BOLT ON NEW HOLLAND SIGN ON STATE ROAD 38 ELEV. - 872.72
- JP-TBM #3 - RAILROAD SPIKE IN SOUTH SIDE OF POWERPOLE NUMBER 812-1686 ON STATE ROAD 38 ELEV. - 871.74
- JP-TBM #4 - RAILROAD SPIKE IN EAST SIDE OF POWERPOLE #077930 AT SOUTHWEST QUADRANT OF STATE ROAD 38 AND COUNTY ROAD 600 W ELEV. - 864.74
- JP-TBM #5 - RAILROAD SPIKE IN EAST SIDE OF POWERPOLE NUMBER 252-626 AT HOUSE NUMBER 7117 ON COUNTY ROAD 600W ELEV. - 866.15

UTILITIES

ANDERSON LIGHT AND POWER
550 BAXTER ROAD
ANDERSON, INDIANA 46016
1 (765) 648-6187

GTE
P.O. BOX 1406
RICHMOND, INDIANA 47375
1 (800) 483-5600

CYNERGY/PSI
100 S. MILL CREEK ROAD
NOBLESVILLE, INDIANA 46060
1 (800) 521-2232

INDIANA GAS COMPANY, INC.
2001 LOUISE STREET
ANDERSON, INDIANA 46016
1 (800) 777-2060

PENDLETON MUNICIPAL WATER UTILITY
P.O. BOX 230
PENDLETON, INDIANA 46064
1 (765) 778-2173

TCI OF CENTRAL INDIANA
335 E. 10th STREET
ANDERSON, INDIANA 46016
1 (765) 649-0407

LEGEND

- 4 - SHEET DESIGNATION
- PROPOSED GRAVITY SEWER
- PROPOSED FORCEMAIN

AREA BASE MAP
NOT TO SCALE

NOTE:
ADDITIONAL RIGHT-OF-WAY OR EASEMENTS MAY
NEED TO BE ACCURATE FOR INSTALLATION OF SEWER.

DON'T DIG BLIND
CALL BEFORE YOU DIG
1-800-367-5544
1-800-426-5200

FOR REMAINING SEE LINE 80-80-1000, IT IS
ADJUSTED THE LINE TO EXISTING RECORD
REVIEWING THE UNDERGROUND LOCATIONS
TWO (2) WEEKS BEFORE COMMENCING WORK.

NOTE: CONTRACTOR TO VERIFY ALL UTILITY LOCATIONS
PRIOR TO THE START OF CONSTRUCTION

FILE NAME: JEFFBAS2-REC PLOT SCALE: 1=150 PLOT DATE: 04/02				TRIAD ASSOCIATES INC. INDIANAPOLIS, INDIANA		APPROVED BY: Thomas M. Schubert, P.E.			
NO. DATE DESCRIPTION BY						JEFFERSON PL., CO. RD. 600W & CO. RD. 675W FALL CREEK REGIONAL WASTE DISTRICT			
						PROJECT BASE MAP			
						DRAWN BY: DAP DATE: 04/12/98 PROJECT No.: 98008A SHEET No.: 2 OF 20			
						DESIGNED BY: D.A. Pauling			
						CHECKED BY: James W. Frazell, P.E.			