


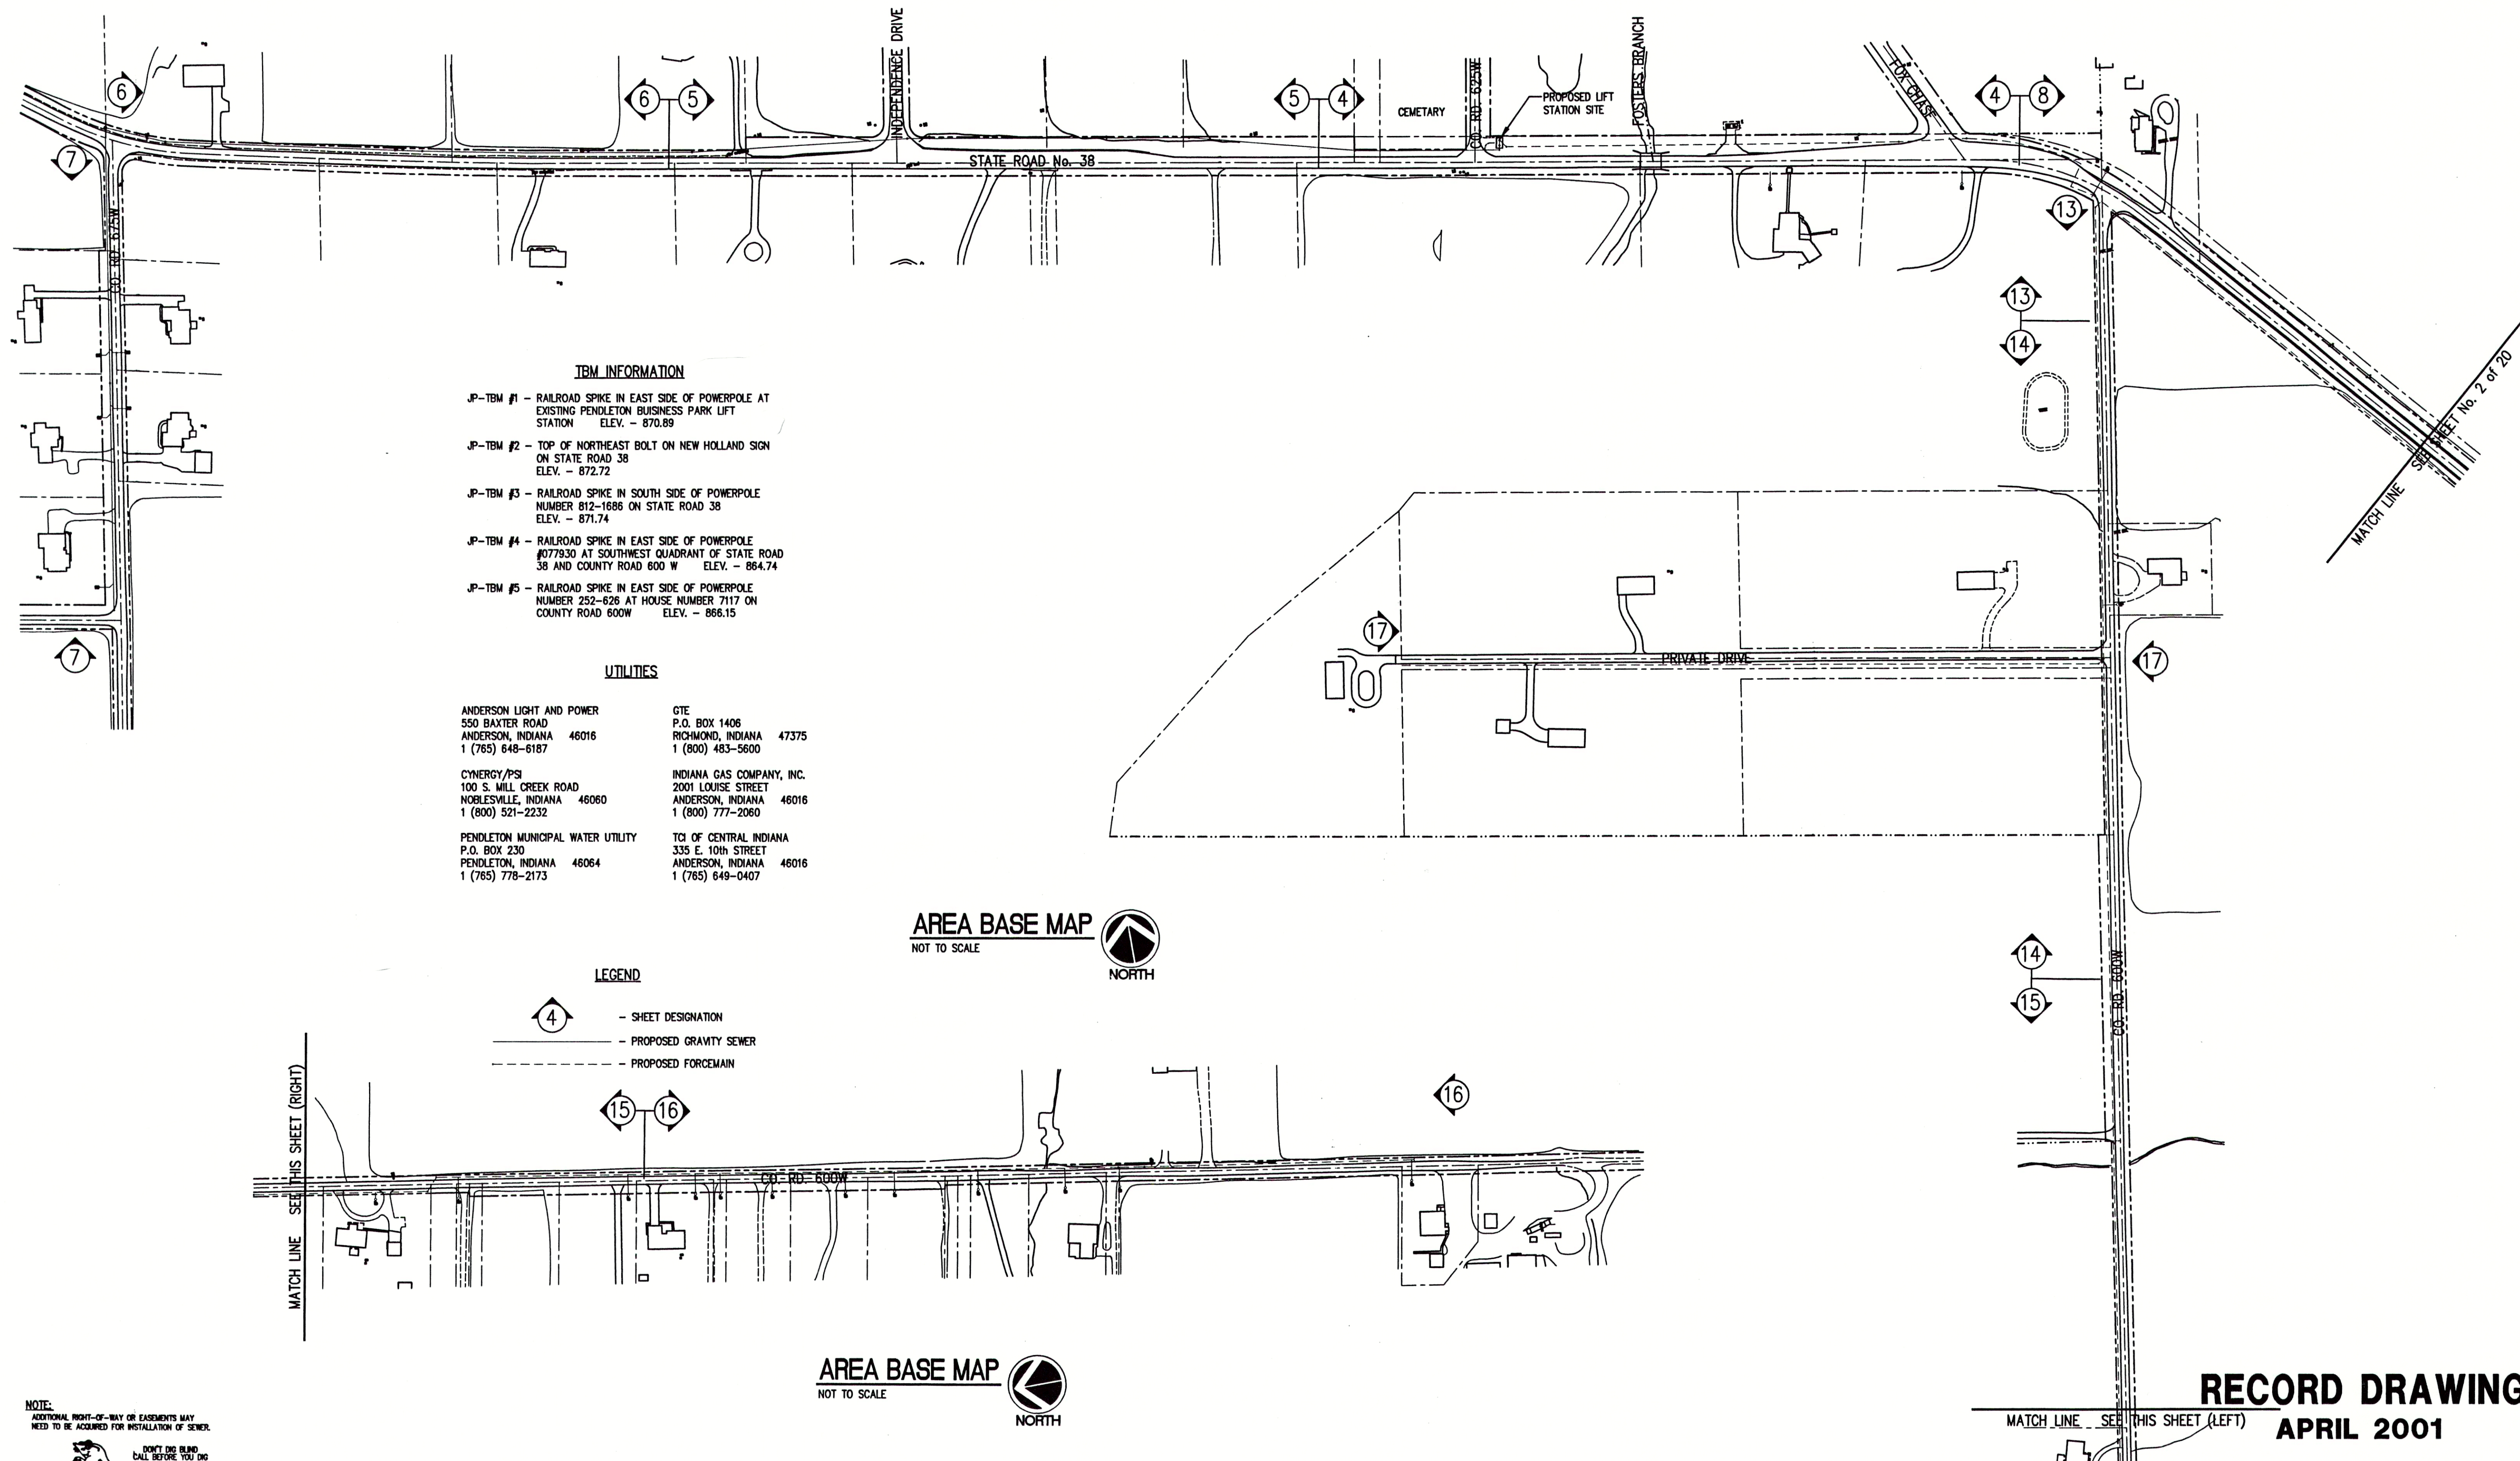

TBM INFORMATION

- JP-TBM #1 - RAILROAD SPIKE IN EAST SIDE OF POWERPOLE AT EXISTING PENDLETON BUSINESS PARK LIFT STATION ELEV. - 870.89
- JP-TBM #2 - TOP OF NORTHEAST BOLT ON NEW HOLLAND SIGN ON STATE ROAD 38 ELEV. - 872.72
- JP-TBM #3 - RAILROAD SPIKE IN SOUTH SIDE OF POWERPOLE NUMBER 812-1686 ON STATE ROAD 38 ELEV. - 871.74
- JP-TBM #4 - RAILROAD SPIKE IN EAST SIDE OF POWERPOLE #077930 AT SOUTHWEST QUADRANT OF STATE ROAD 38 AND COUNTY ROAD 600 W ELEV. - 864.74
- JP-TBM #5 - RAILROAD SPIKE IN EAST SIDE OF POWERPOLE NUMBER 252-626 AT HOUSE NUMBER 7117 ON COUNTY ROAD 600W ELEV. - 866.15

UTILITIES

- ANDERSON LIGHT AND POWER
550 BAXTER ROAD
ANDERSON, INDIANA 46016
1 (765) 646-6187
- GTE
P.O. BOX 1406
RICHMOND, INDIANA 47375
1 (800) 463-5600
- CYNERGY/PSI
100 S. MILL CREEK ROAD
NOBLESVILLE, INDIANA 46060
1 (800) 521-2232
- INDIANA GAS COMPANY, INC.
2001 LOUISE STREET
ANDERSON, INDIANA 46016
1 (800) 777-2060
- PENDLETON MUNICIPAL WATER UTILITY
P.O. BOX 230
PENDLETON, INDIANA 46064
1 (765) 778-2173
- TCI OF CENTRAL INDIANA
335 E. 10th STREET
ANDERSON, INDIANA 46016
1 (765) 649-0407

AREA BASE MAP
NOT TO SCALE



LEGEND

- 4 - SHEET DESIGNATION
- PROPOSED GRAVITY SEWER
- - - - - PROPOSED FORCEMAIN

AREA BASE MAP
NOT TO SCALE



NOTE:
ADDITIONAL RIGHT-OF-WAY OR EASEMENTS MAY
NEED TO BE ACCURATE FOR INSTALLATION OF SEWER.



FOR INDIANA STATE LAW 15-18-1991, IT IS
AGAINST THE LAW TO EXCAVATE WITHOUT
NOTIFYING THE UNDERGROUND LOCATIONS SERVICE
THAT IS WORKING DAYS BEFORE COMMENCING WORK.

NOTE: CONTRACTOR TO VERIFY ALL UTILITY LOCATIONS
PRIOR TO THE START OF CONSTRUCTION


RECORD DRAWING
APRIL 2001

MATCH LINE SEE THIS SHEET (LEFT)

FILE NAME: JEFFBAS1-REC		PLOT SCALE: 1=150	PLOT DATE: 04/0
NO.	DATE	DESCRIPTION	BY

TRIAD
ASSOCIATES
INC.

INDIANAPOLIS, INDIANA

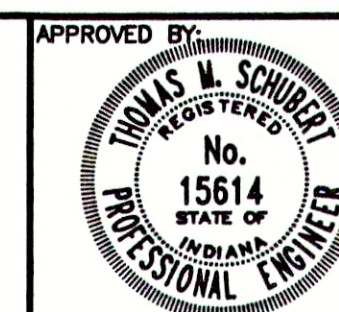

Thomas M. Schubert, P.E.

JEFFERSON PL., CO. RD. 600W & CO. RD. 675W FALL CREEK REGIONAL WASTE DISTRICT			
PROJECT BASE MAP			
DRAWN BY:	DATE	PROJECT No.	SHEET No.
DAP	04/12/98	98008A	3
DESIGNED BY:	D.A. Pauling		
CHECKED BY:	James W. Frazell, P.E.		
			20