




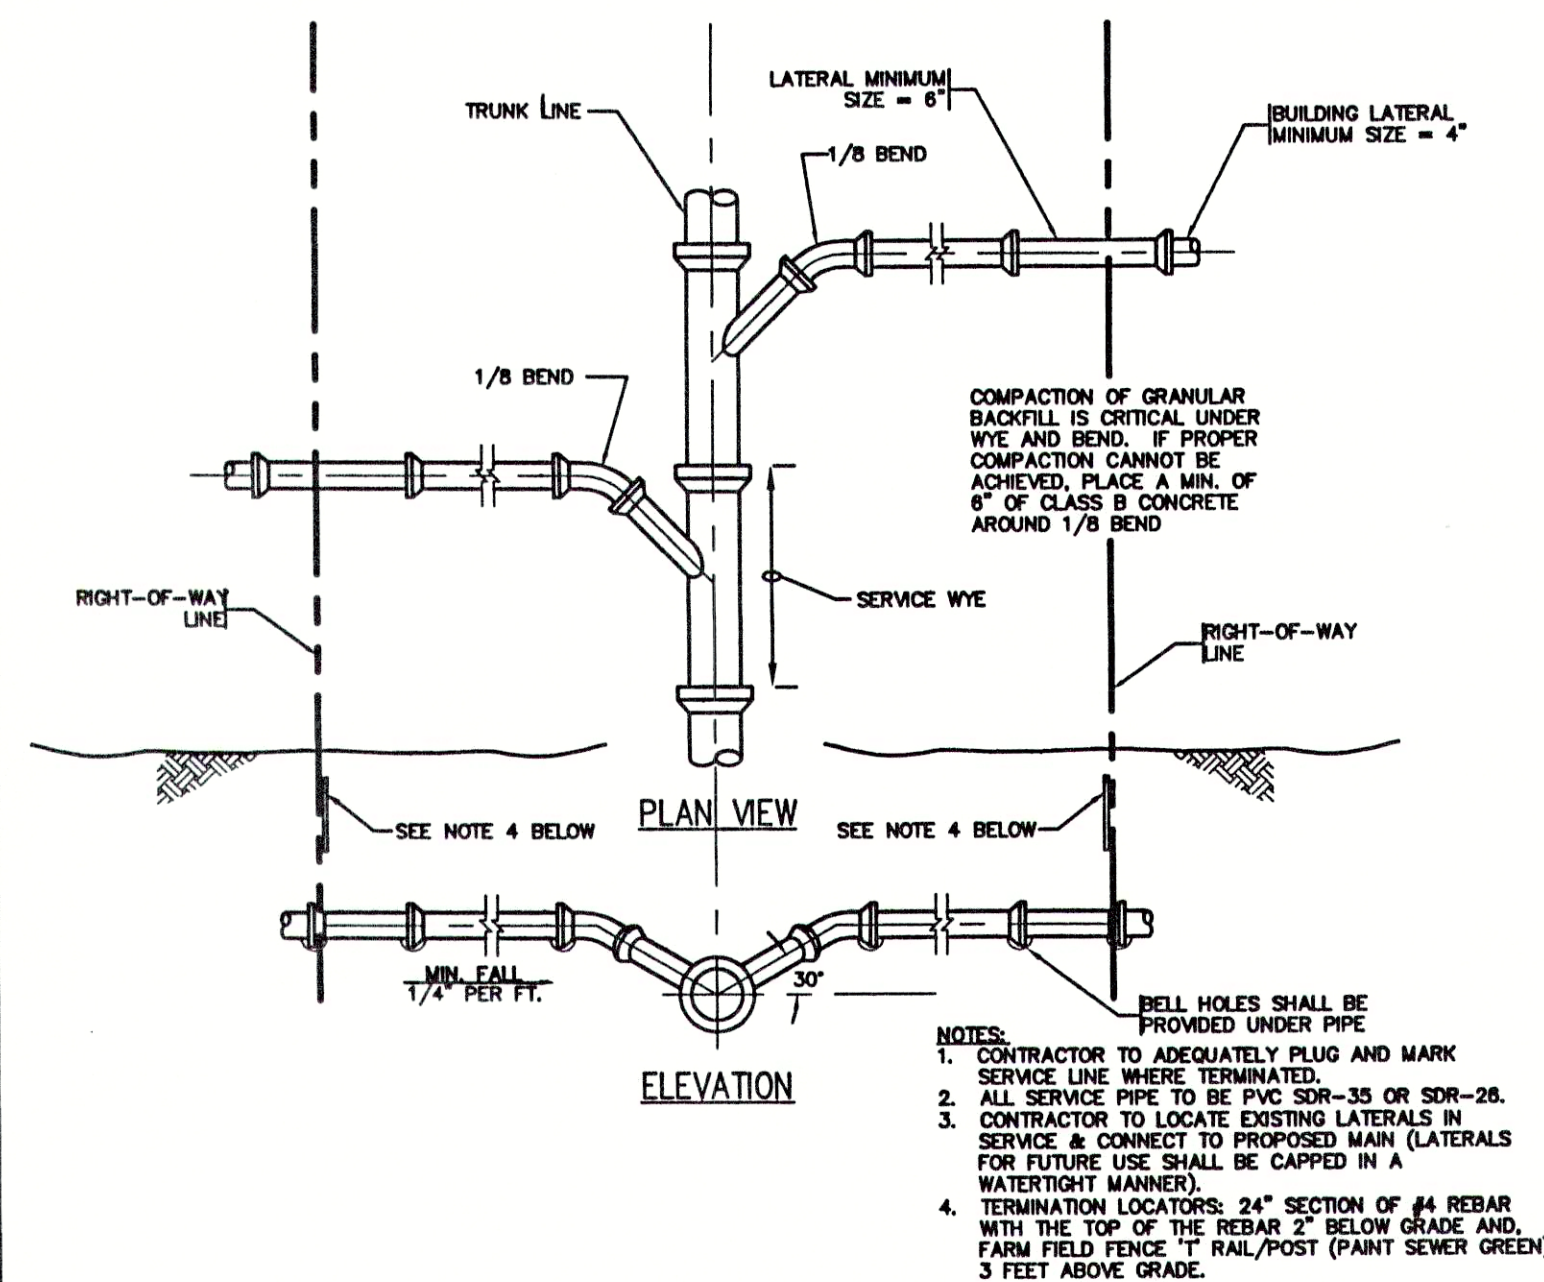


1 SERVICE CONNECTION DETAIL
SCALE: N.T.S.

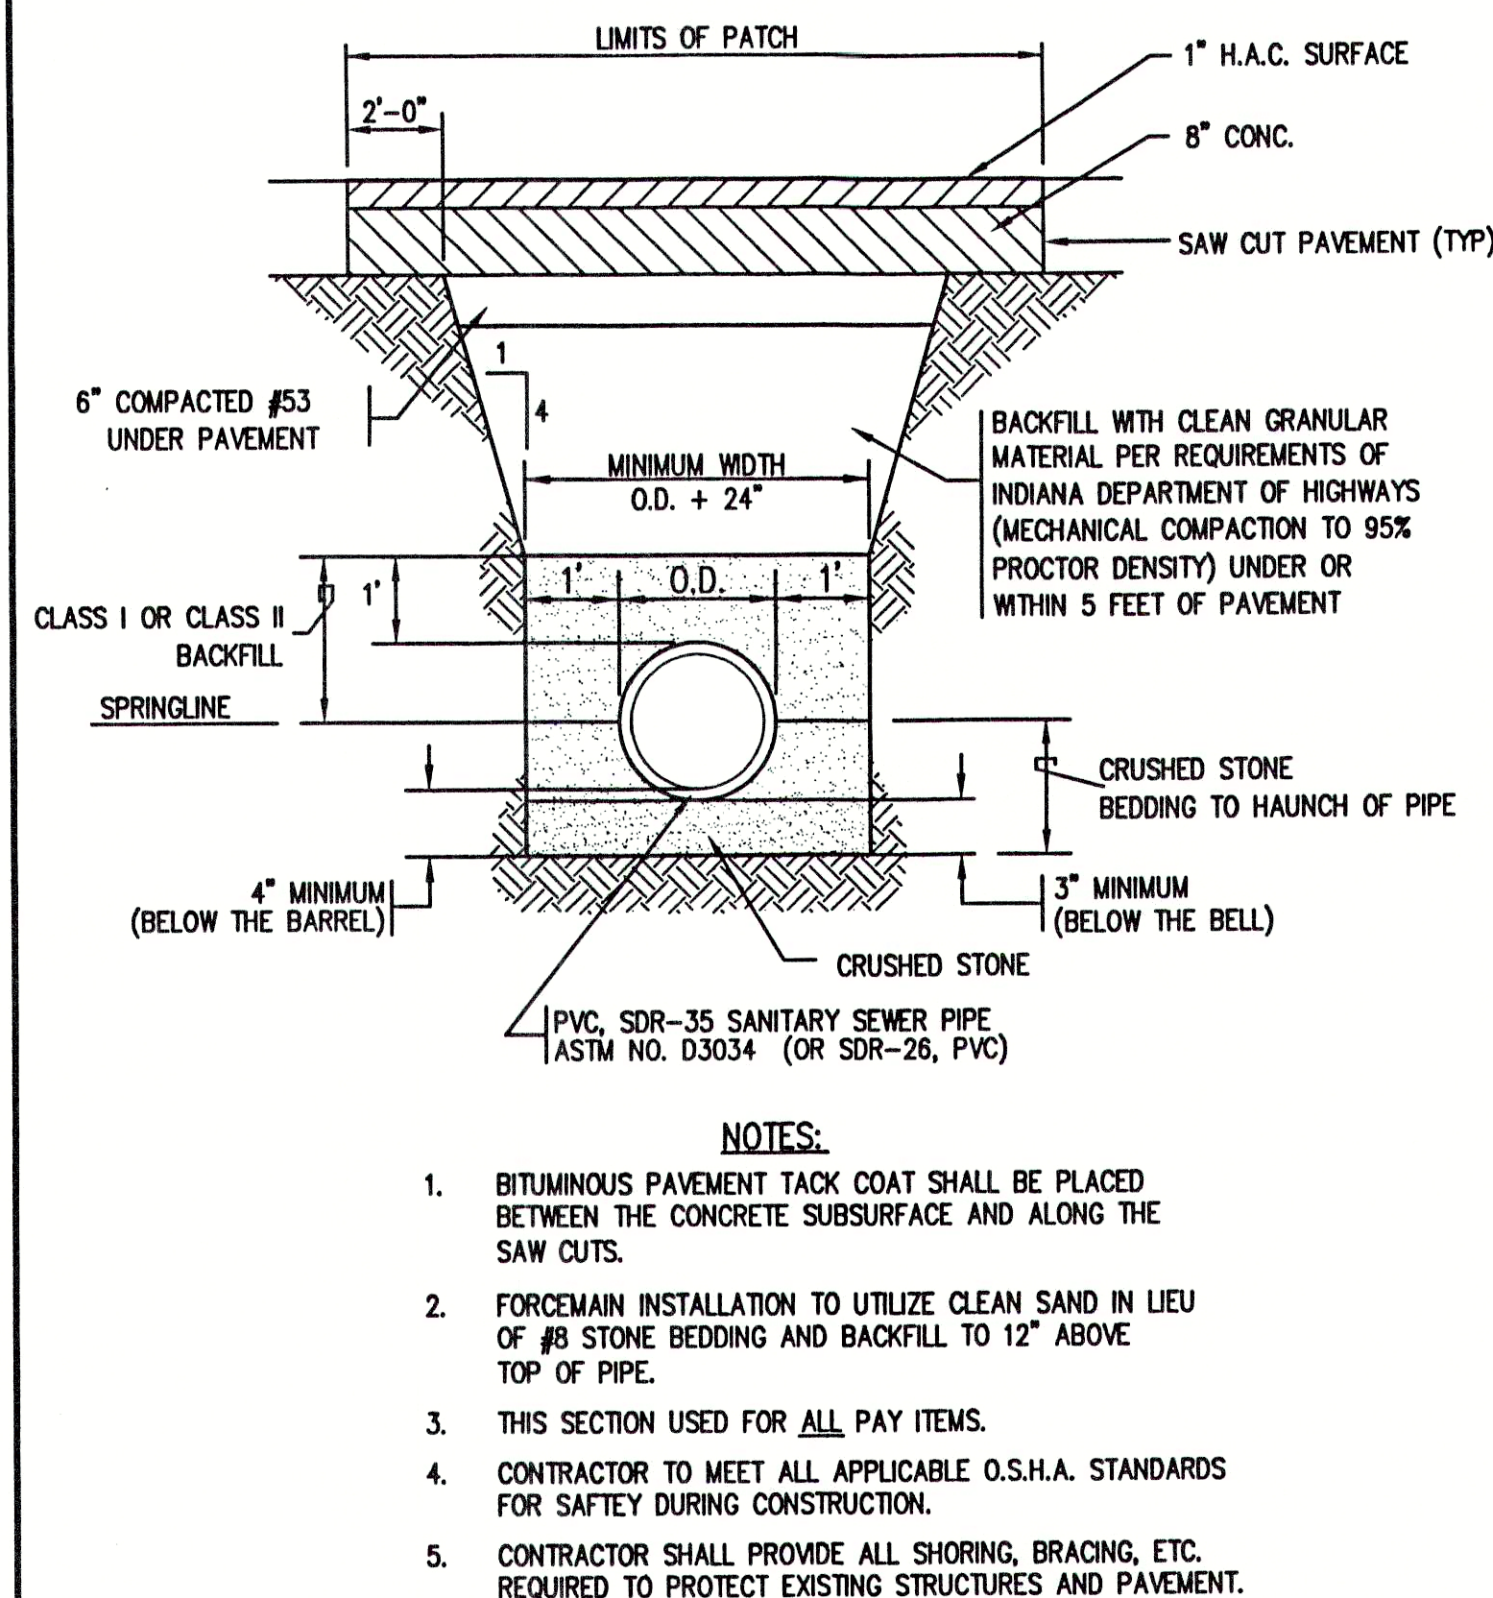


2 TYPICAL TRENCH AND PAVEMENT PATCH DETAIL
SCALE: N.T.S.

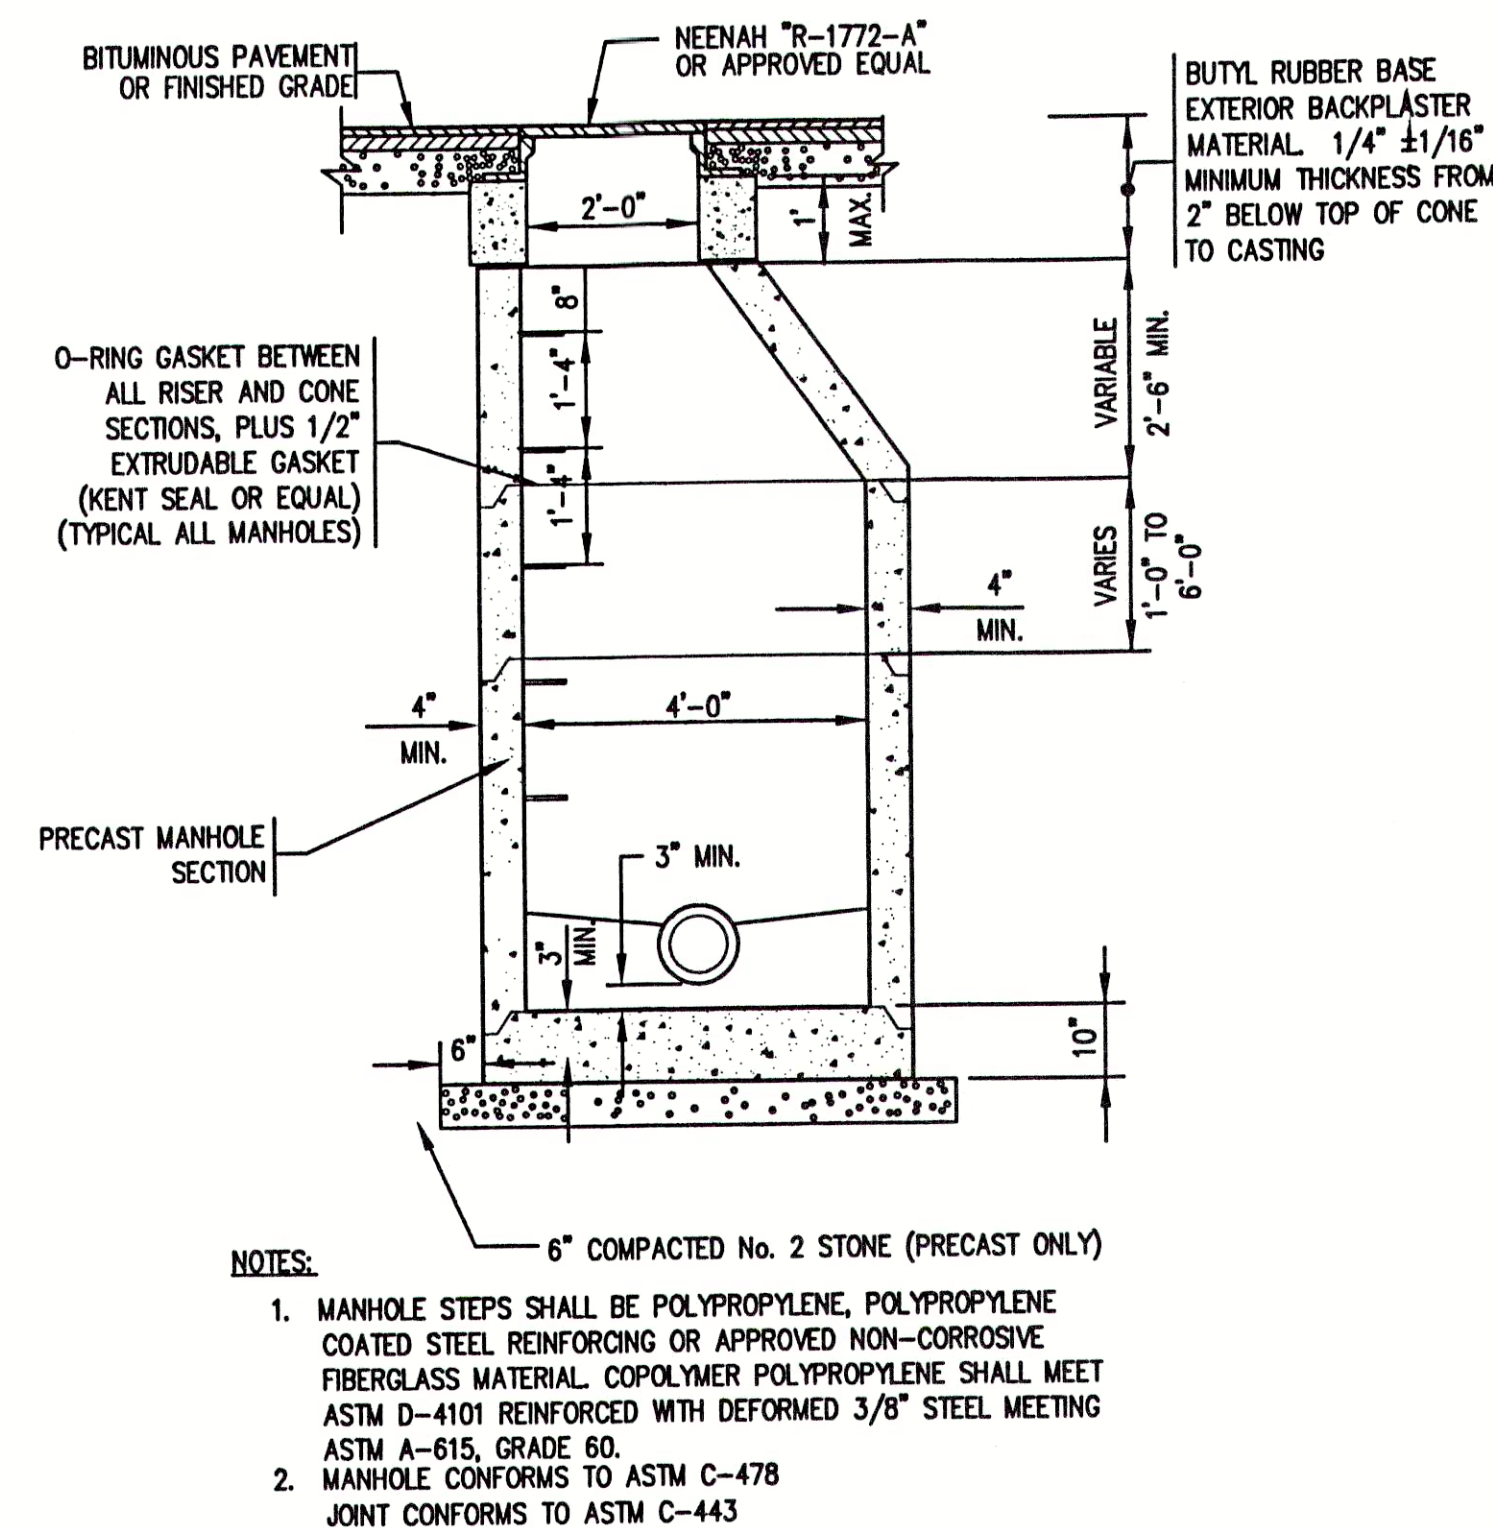


3 SANITARY MANHOLE
SCALE: N.T.S.

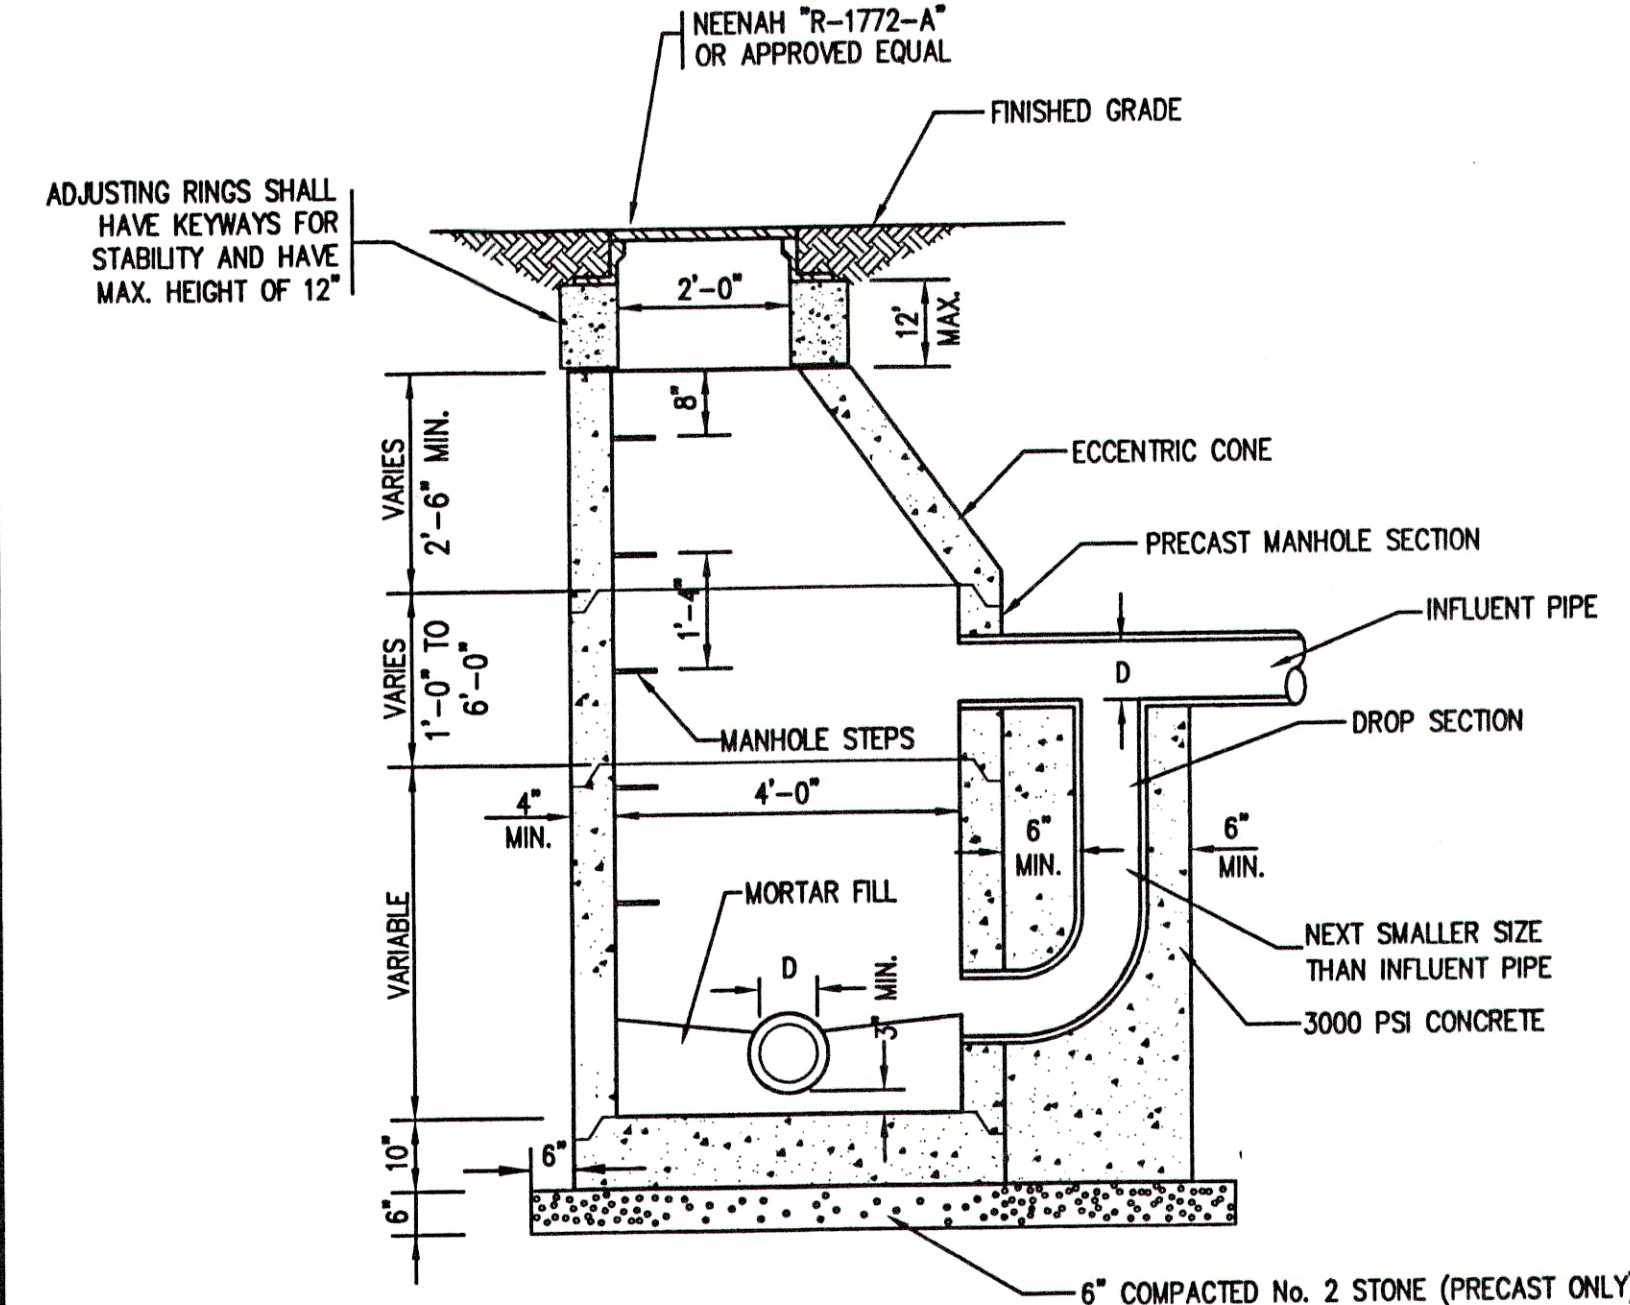


4 DROP MANHOLE
SCALE: N.T.S.

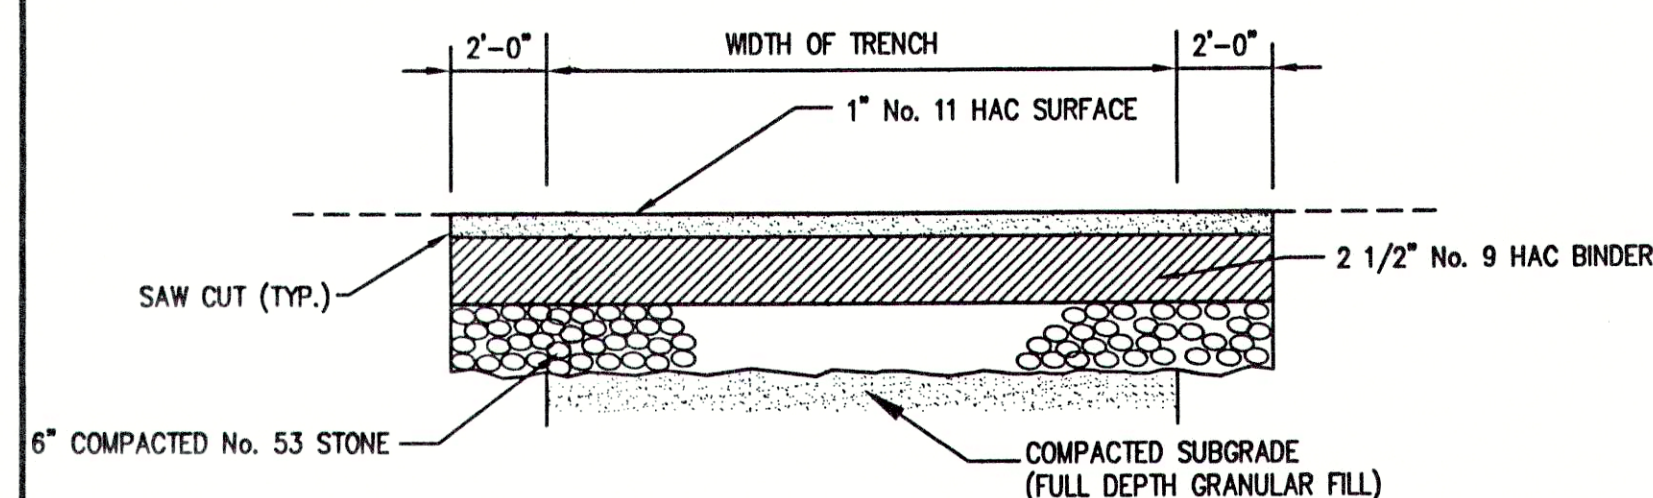


5 ASPHALT DRIVE REPAIR DETAIL
SCALE: N.T.S.

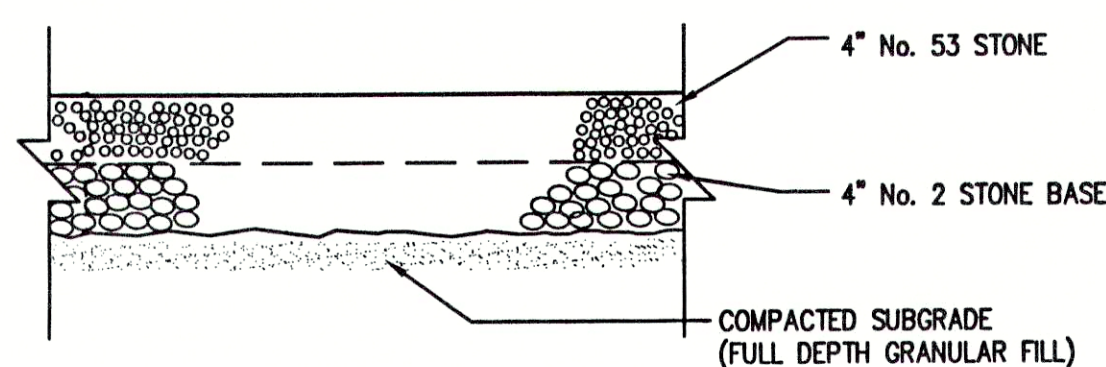


6 STONE DRIVE REPAIR DETAIL
SCALE: N.T.S.

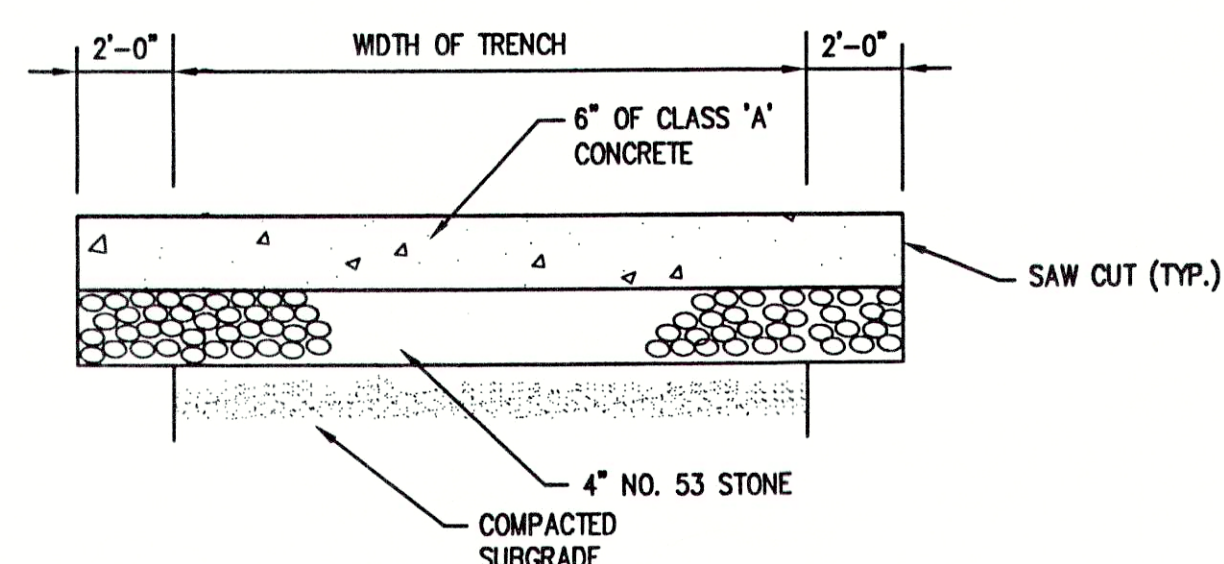


7 CONCRETE DRIVE REPAIR DETAIL
SCALE: N.T.S.

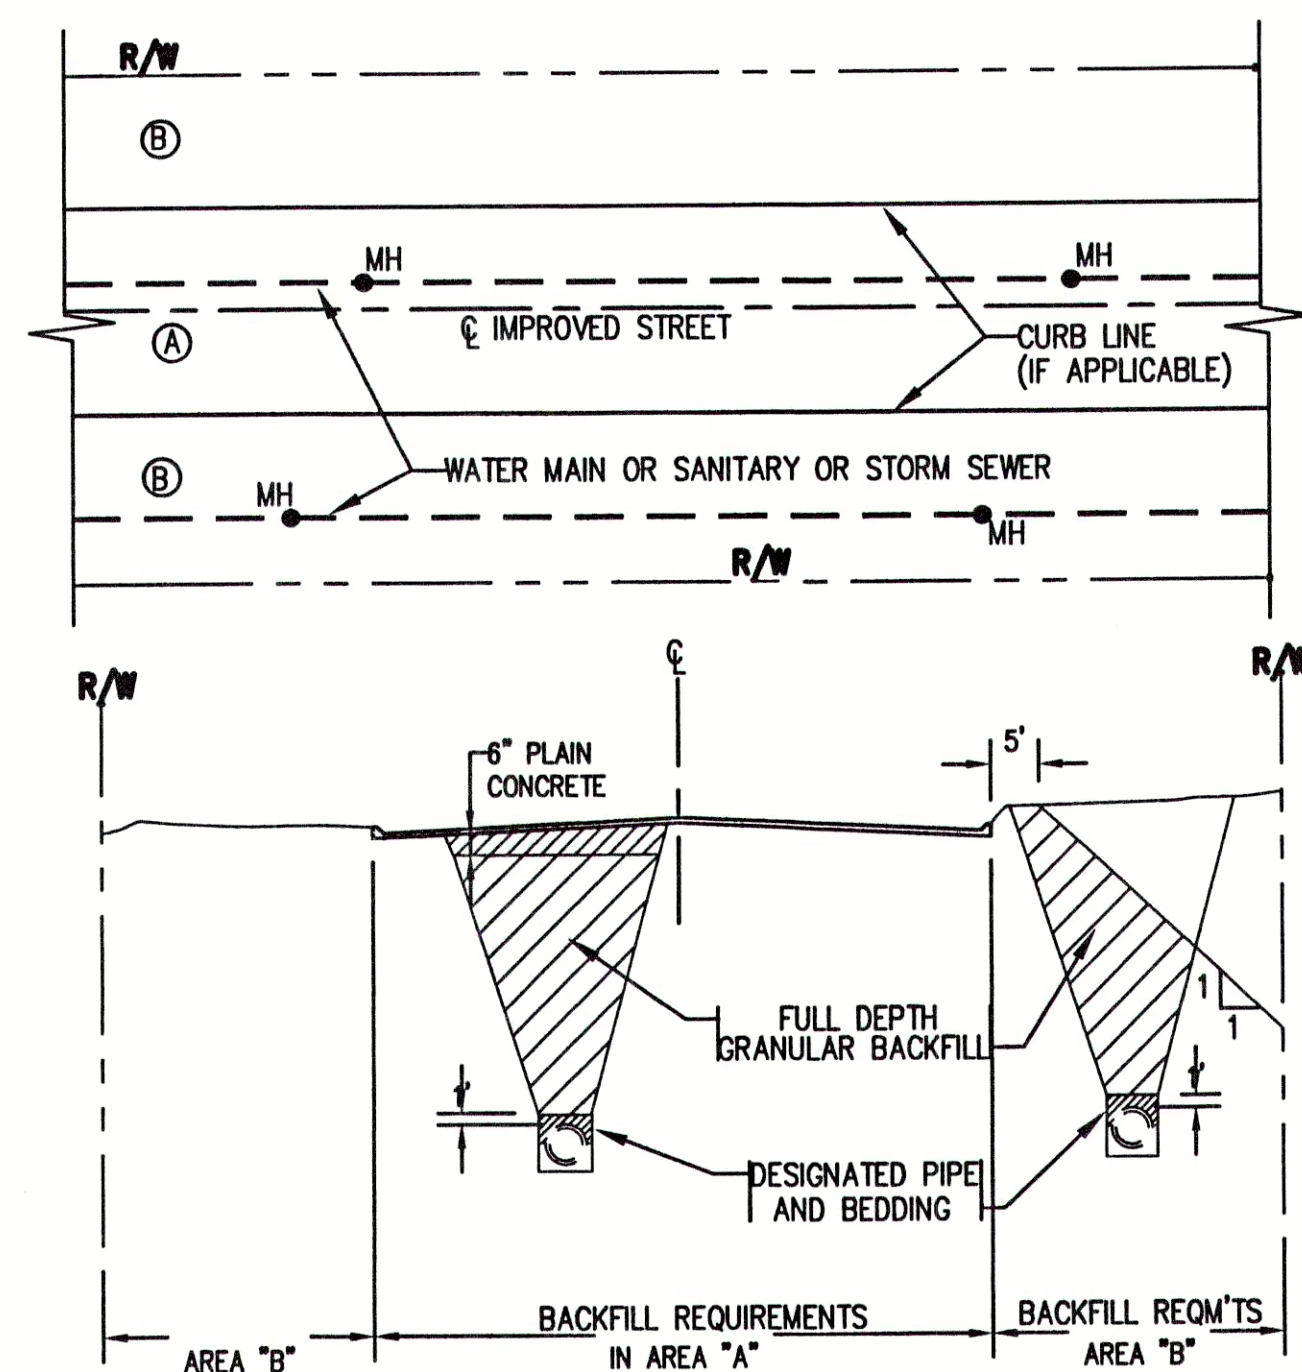

8 BACKFILL REQUIREMENTS
(FOR PIPELINES WITHIN RIGHT-OF-WAY FOR IMPROVED STREETS)

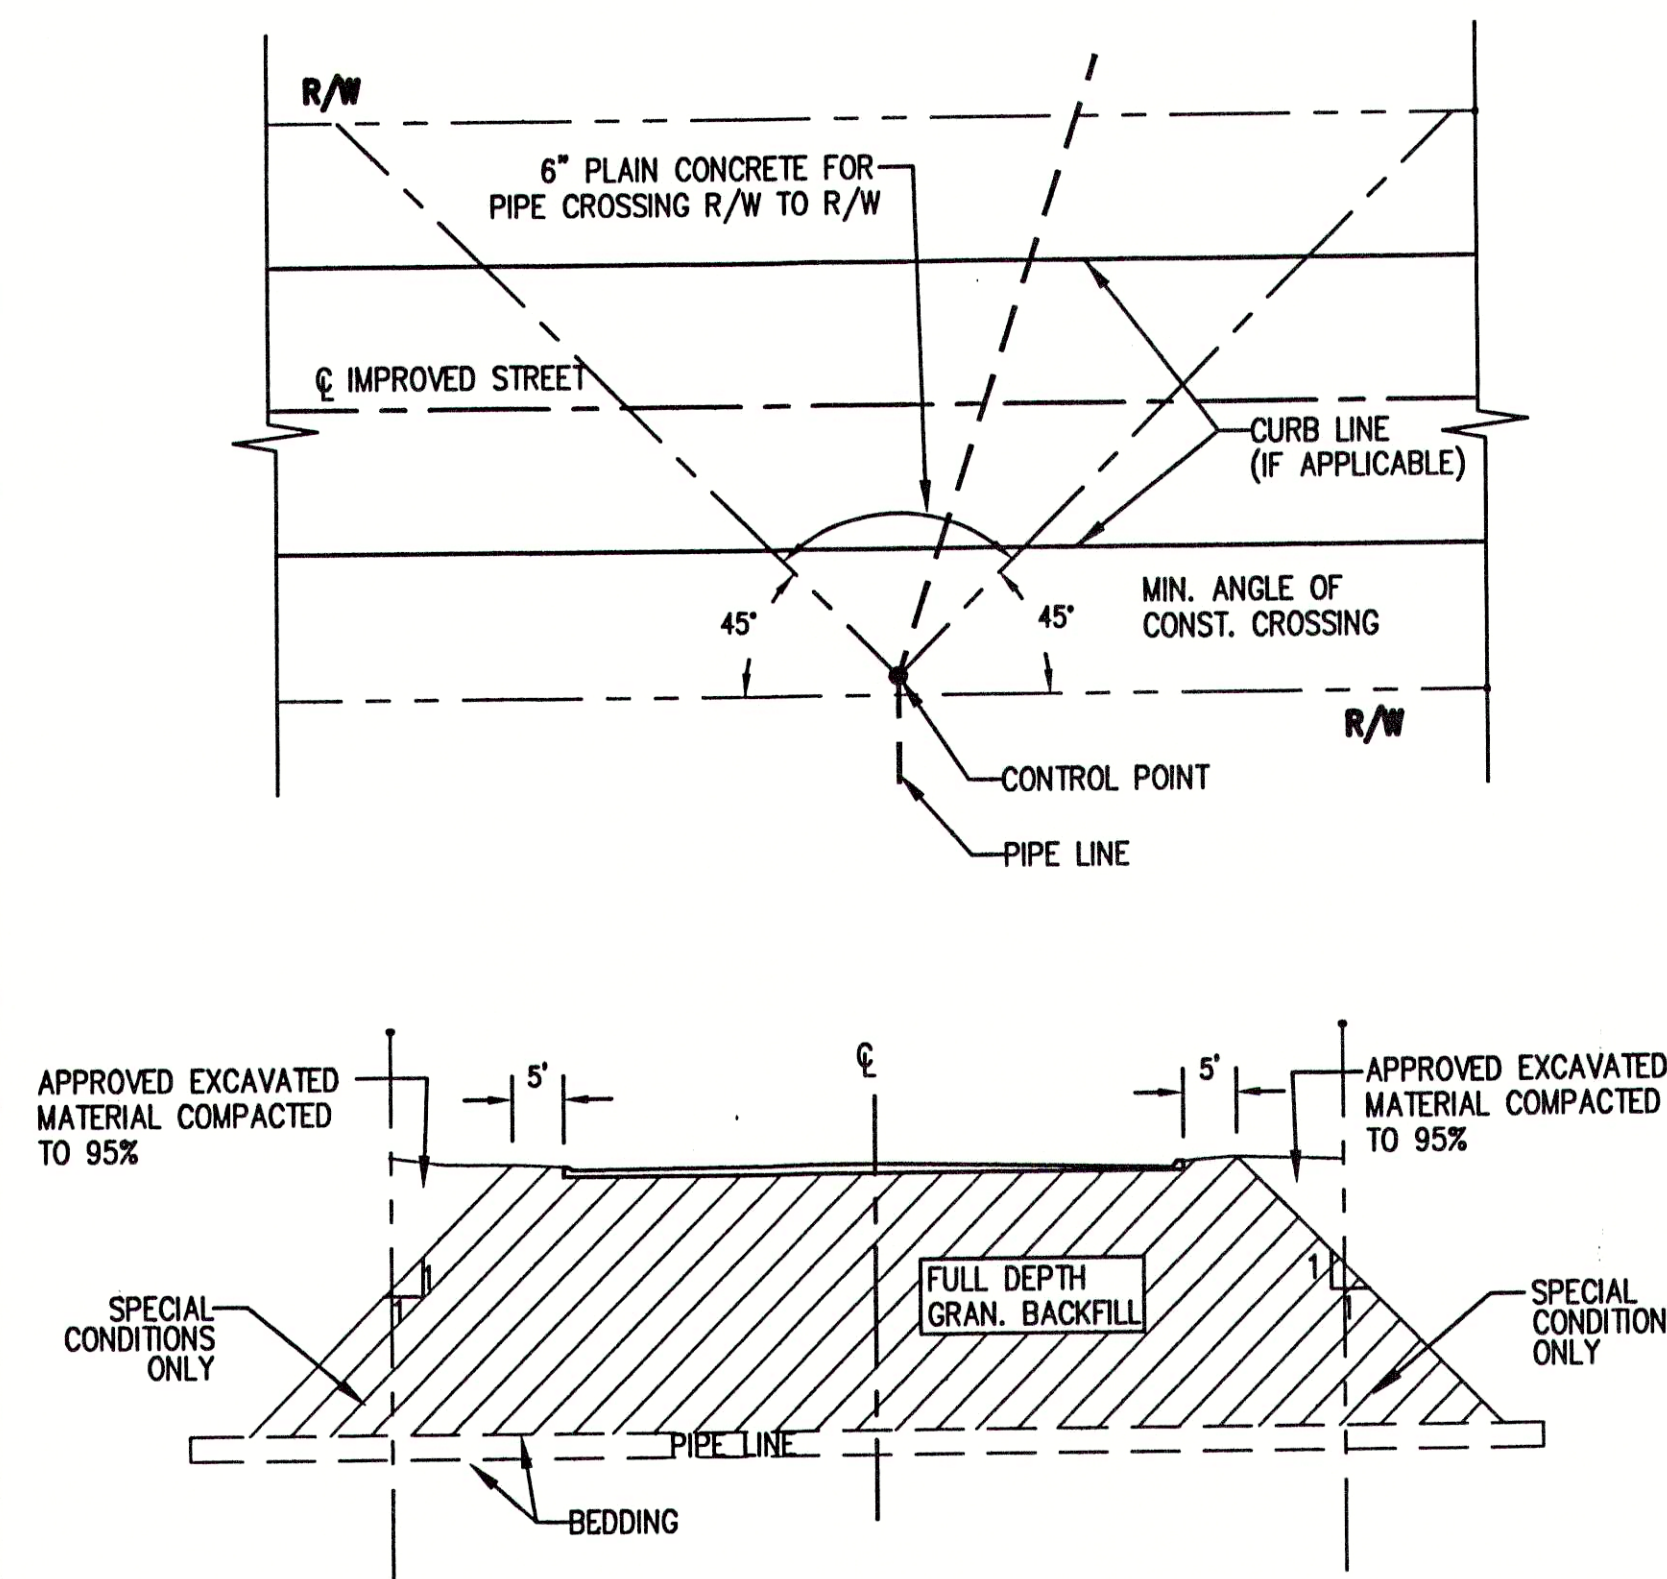

9 BACKFILL REQUIREMENTS
(FOR PIPELINES CROSSING RIGHT-OF-WAY FOR IMPROVED STREETS)

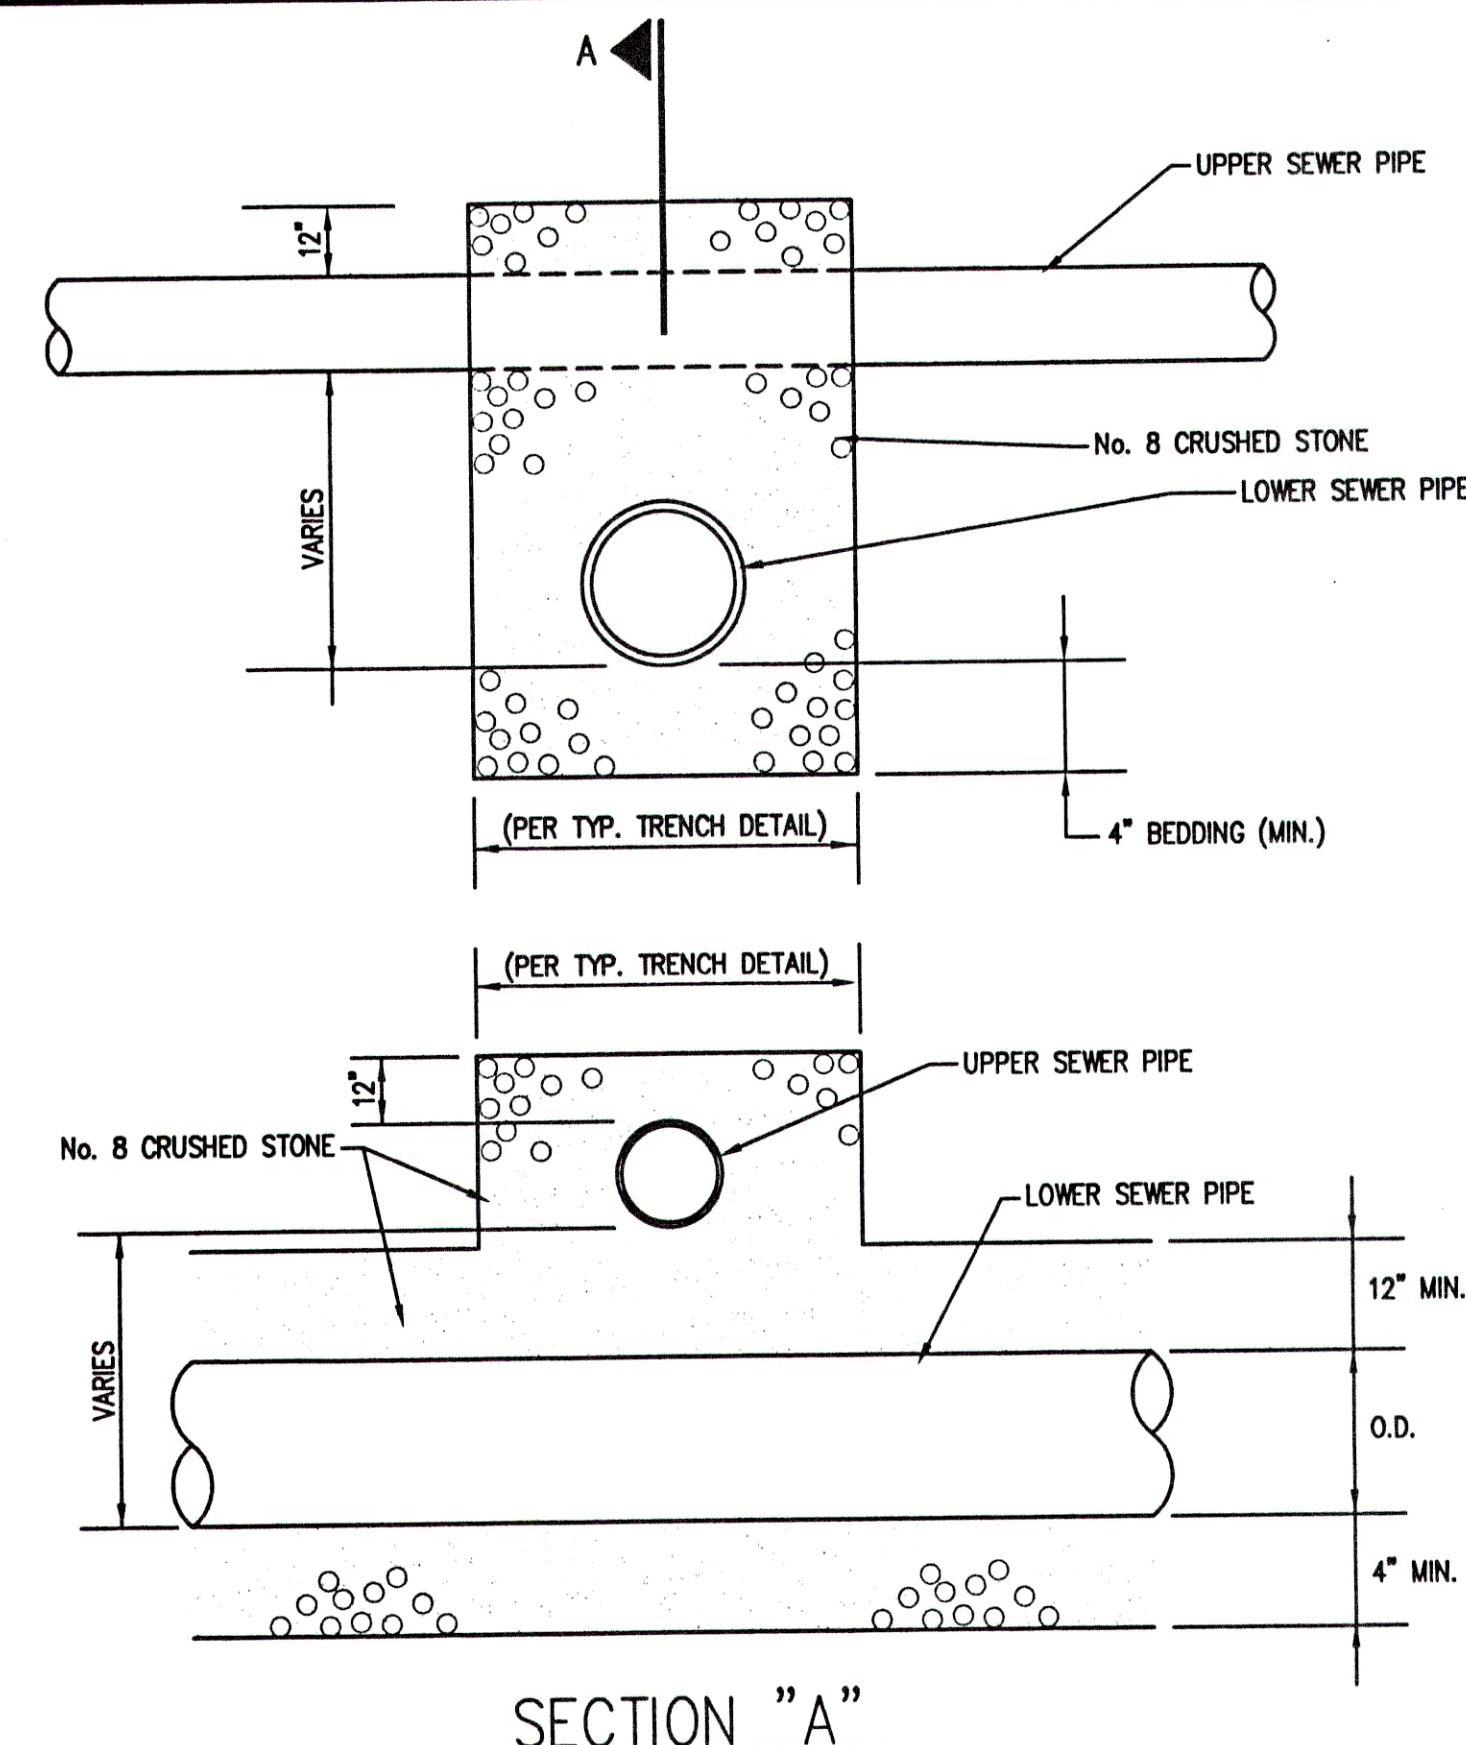

10 STORM SEWER/SANITARY SEWER CROSSING DETAIL
SCALE: N.T.S.

RECORD DRAWING
APRIL 2001

FILE NAME:	JP_D1-REC	PLOT SCALE:	1=1	PLOT DATE:	04/05
NO.	DATE	DESCRIPTION	BY		

TRIAD ASSOCIATES INC.
INDIANAPOLIS, INDIANA

APPROVED
THOMAS M. SCHUBERT
No. 15614
STATE OF INDIANA
PROFESSIONAL ENGINEER

JEFFERSON PL., CO. RD. 600W & CO. RD. 675W
FALL CREEK REGIONAL WASTE DISTRICT
STANDARD SANITARY SEWER DETAILS
DRAWN BY: DATE 04/12/98 PROJECT No. 98008A SHEET No. 19
SCALE AS NOTED
DESIGNED BY: D.A. Pauling
CHECKED BY: James W. Frazell, P.E.